

ADDENDUM NO. 2

| PROJECT: | Brooks Street Greenspace |
|----------------|---|
| OWNER: | Sheridan County |
| PROJECT NO.: | 6017.002 |
| ENGINEER: | Morrison-Maierle, Inc. 1470 Sugarland Drive, Suite 1 Sheridan, WY 82801 |
| ADDENDUM DATE: | April 3, 2023 |

BID DATE: 10:00 AM – April 5, 2023

The Contract Documents for the work are modified by the following and become a part of the original Project Manual and Drawings, taking precedence over the items which may conflict. The bidder shall note receipt and make acknowledgment of this Addendum on the Bid Proposal, incorporating these provisions in the bid.

BIDDER QUESTIONS

1. Insulation for snow melt. Please clarify the detail for R15 perimeter insulation. Are there specific dimensions for the perimeter insulation? Notes on details 3 & 4 sheet M-4.

Response:

- New detail attached.

2. Is the pergola intended to be a specific material? Metal or Wood.

Response:

- The overhead structure is to be metal, refer to L-3 General Note #8 for finish requirements.
- 3. Would it be possible to get an additional 45 days for mechanical work inside during the winter shut down outside?

Response:

- Yes, see updated language below.

4. Can the 6" flue from the boiler be run out the west wall?

Response:

- The exhaust for the new boiler can be vented out the west wall. Locate as needed to avoid negatively impacting the existing air intake system and other existing County infrastructure. New detail is attached.
- 5. Are there any drawings that show the existing heated area at the Burkitt approach? Project note 7, C-1

Response:

- The extent of the existing heated area is near the edge of the proposed removal shown on page C-1. This will need to be confirmed in the field with the County prior to concrete removal.
- 6. Are there any drawings that show the area with existing T sections? Key note 9, C-1

Response:

- As-Built plans for the Sheridan County Courthouse have been included for reference. See details 3/15 & 4/15 on sheet A15 and others as needed for details of the existing building sections.
- 7. Would it be possible to get a cross section detail of the stairs?

Response:

- See stair detail on sheet C-10. The intent of this is to have a gap between the thickened edges of the sidewalk to allow for backfill and insulation to be placed.
- 8. Can an initial NTP be given to allow materials to be ordered before work begins?

Response:

- Yes, see updated language below.
- 9. Are the proposed site furnishings (benches, trash cans, etc) meant to be Owner or Contractor provided?

Response:

- All site furnishings are meant to be provided and installed by the contractor, see updated language in below.

<u>PLANS</u>

- Item 1: Plan Sheet M-2
 - Replace Note 9 of RESPONSIBILITY with the following:

9. THE CONTRACTOR SHALL GUARANTEE THAT ALL WORK EXECUTED UNDER THEIR CONTRACT SHALL BE FREE OF

DEFECTS OF MATERIALS AND WORKMANSHIP FOR A PERIOD OF ONE (1) YEAR FROM THE DATE OF **FINAL** COMPLETION.

- Item 2: Mechanical Plan Sheets M-4 & M-5
 - Replace Sheets M-4 and M-5 in their entirety with the attached updated plan sheets.
- Item 3: Plan Sheet G-1
 - Add the following Project Note:

7. WORK INSIDE THE COUNTY COURTHOUSE SHALL BE DURING REGULAR BUSINESS HOURS (8 AM to 5 PM, M-F) UNLESS SCHEDULED AND APPROVED BY THE COUNTY AND ENGINEER. ANY PLANNED SHUT-DOWNS OR INTERRUPTIONS TO THE EXISTING COUNTY INFRASTRUCTURE SHALL BE COORDINATED WITH AND APPROVED BY THE COUNTY PRIOR TO PROCEEDING WITH THE WORK."

PROJECT MANUAL

Item 4: <u>SECTION 00100 – INSTRUCTIONS TO BIDDERS</u>

Replace sub-section 10.0 – CONTRACT TIME in its entirety with the below:

Substantial Completion of the Work is to be completed within 160 calendar days from the issuance of the Second Notice to Proceed. An initial Notice to Proceed (NTP) may be issued to the Contractor within 10 days of the Contract Award. This initial NTP will not start the Contract Time, but is intended to direct the Contractor to begin the process for the Retaining Wall Design, shop drawing preparation and submittal review, ordering and approval process for any equipment and materials that may require greater delivery time. The Second notice to proceed will be given on or after July 17, 2023 and Substantial Completion shall be reached no later than July 31, 2024. Final completion is to be reached within 14 days of Substantial Completion. A suspend work order can be issued at CONTRACTOR's request at the end of 2023 to break for the winter months, then shutdown until weather allows remaining work to resume in 2024. To allow for work inside the County Courthouse to proceed during winter months, the contractor can request 45 calendar days for Interior Work during the winter shut-down period. This time will not count towards or add to the 160 calendar day window for the entire project. Final Payment will not be made until Final Completion is reached and all closeout documents acceptably submitted.

For the purposes of this project, Substantial Completion is defined as the time at which all pay items have been completed and the contractor is ready for final inspection of the project.

Item 5: <u>SECTION 00500 – AGREEMENT</u> Replace sub-section 3.1 of ARTICLE 3. CONTRACT TIME in its entirety with the below:

> Substantial Completion of the Work is to be completed within 160 calendar days from the issuance of the Second Notice to Proceed. An initial Notice to Proceed (NTP) may be issued to the Contractor within 10 days of the Contract Award. This initial NTP will not start the Contract Time, but is intended to direct the Contractor to begin the process for the Retaining Wall Design, shop drawing preparation and submittal review, ordering and approval process for any equipment and materials that may require greater delivery time. The Second notice to proceed will be given on or after July 17, 2023 and Substantial Completion shall be reached no later than July 31, 2024. Final completion is to be reached within 14 days of Substantial Completion. A suspend work order can be issued at CONTRACTOR's request at the end of 2023 to break for the winter months, then shutdown until weather allows remaining work to resume in 2024. To allow for work inside the County Courthouse to proceed during winter months, the contractor can request 45 calendar days for Interior Work during the winter shut-down period. This time will not count towards or add to the 160 calendar day window for the entire project. Final Payment will not be made until Final Completion is reached and all closeout documents acceptably submitted.

For the purposes of this project, Substantial Completion is defined as the time at which all pay items have been completed and the contractor is ready for final inspection of the project.

Item 6: SECTION 129300 – SITE FURNISHINGS


Replace the first paragraph of sub-section 2.2 SITE FURNISHINGS in its entirety with the following:


All site furnishings including trash receptacles, benches, and picnic tables are to be provided and installed by the Contractor in locations indicated on the plans.


Attachments:

- Updated Mechanical Plan Sheet M-4 & M-5
- Sheridan County Courthouse As-Built Drawings (89 Pages)

End of Addendum No. 2

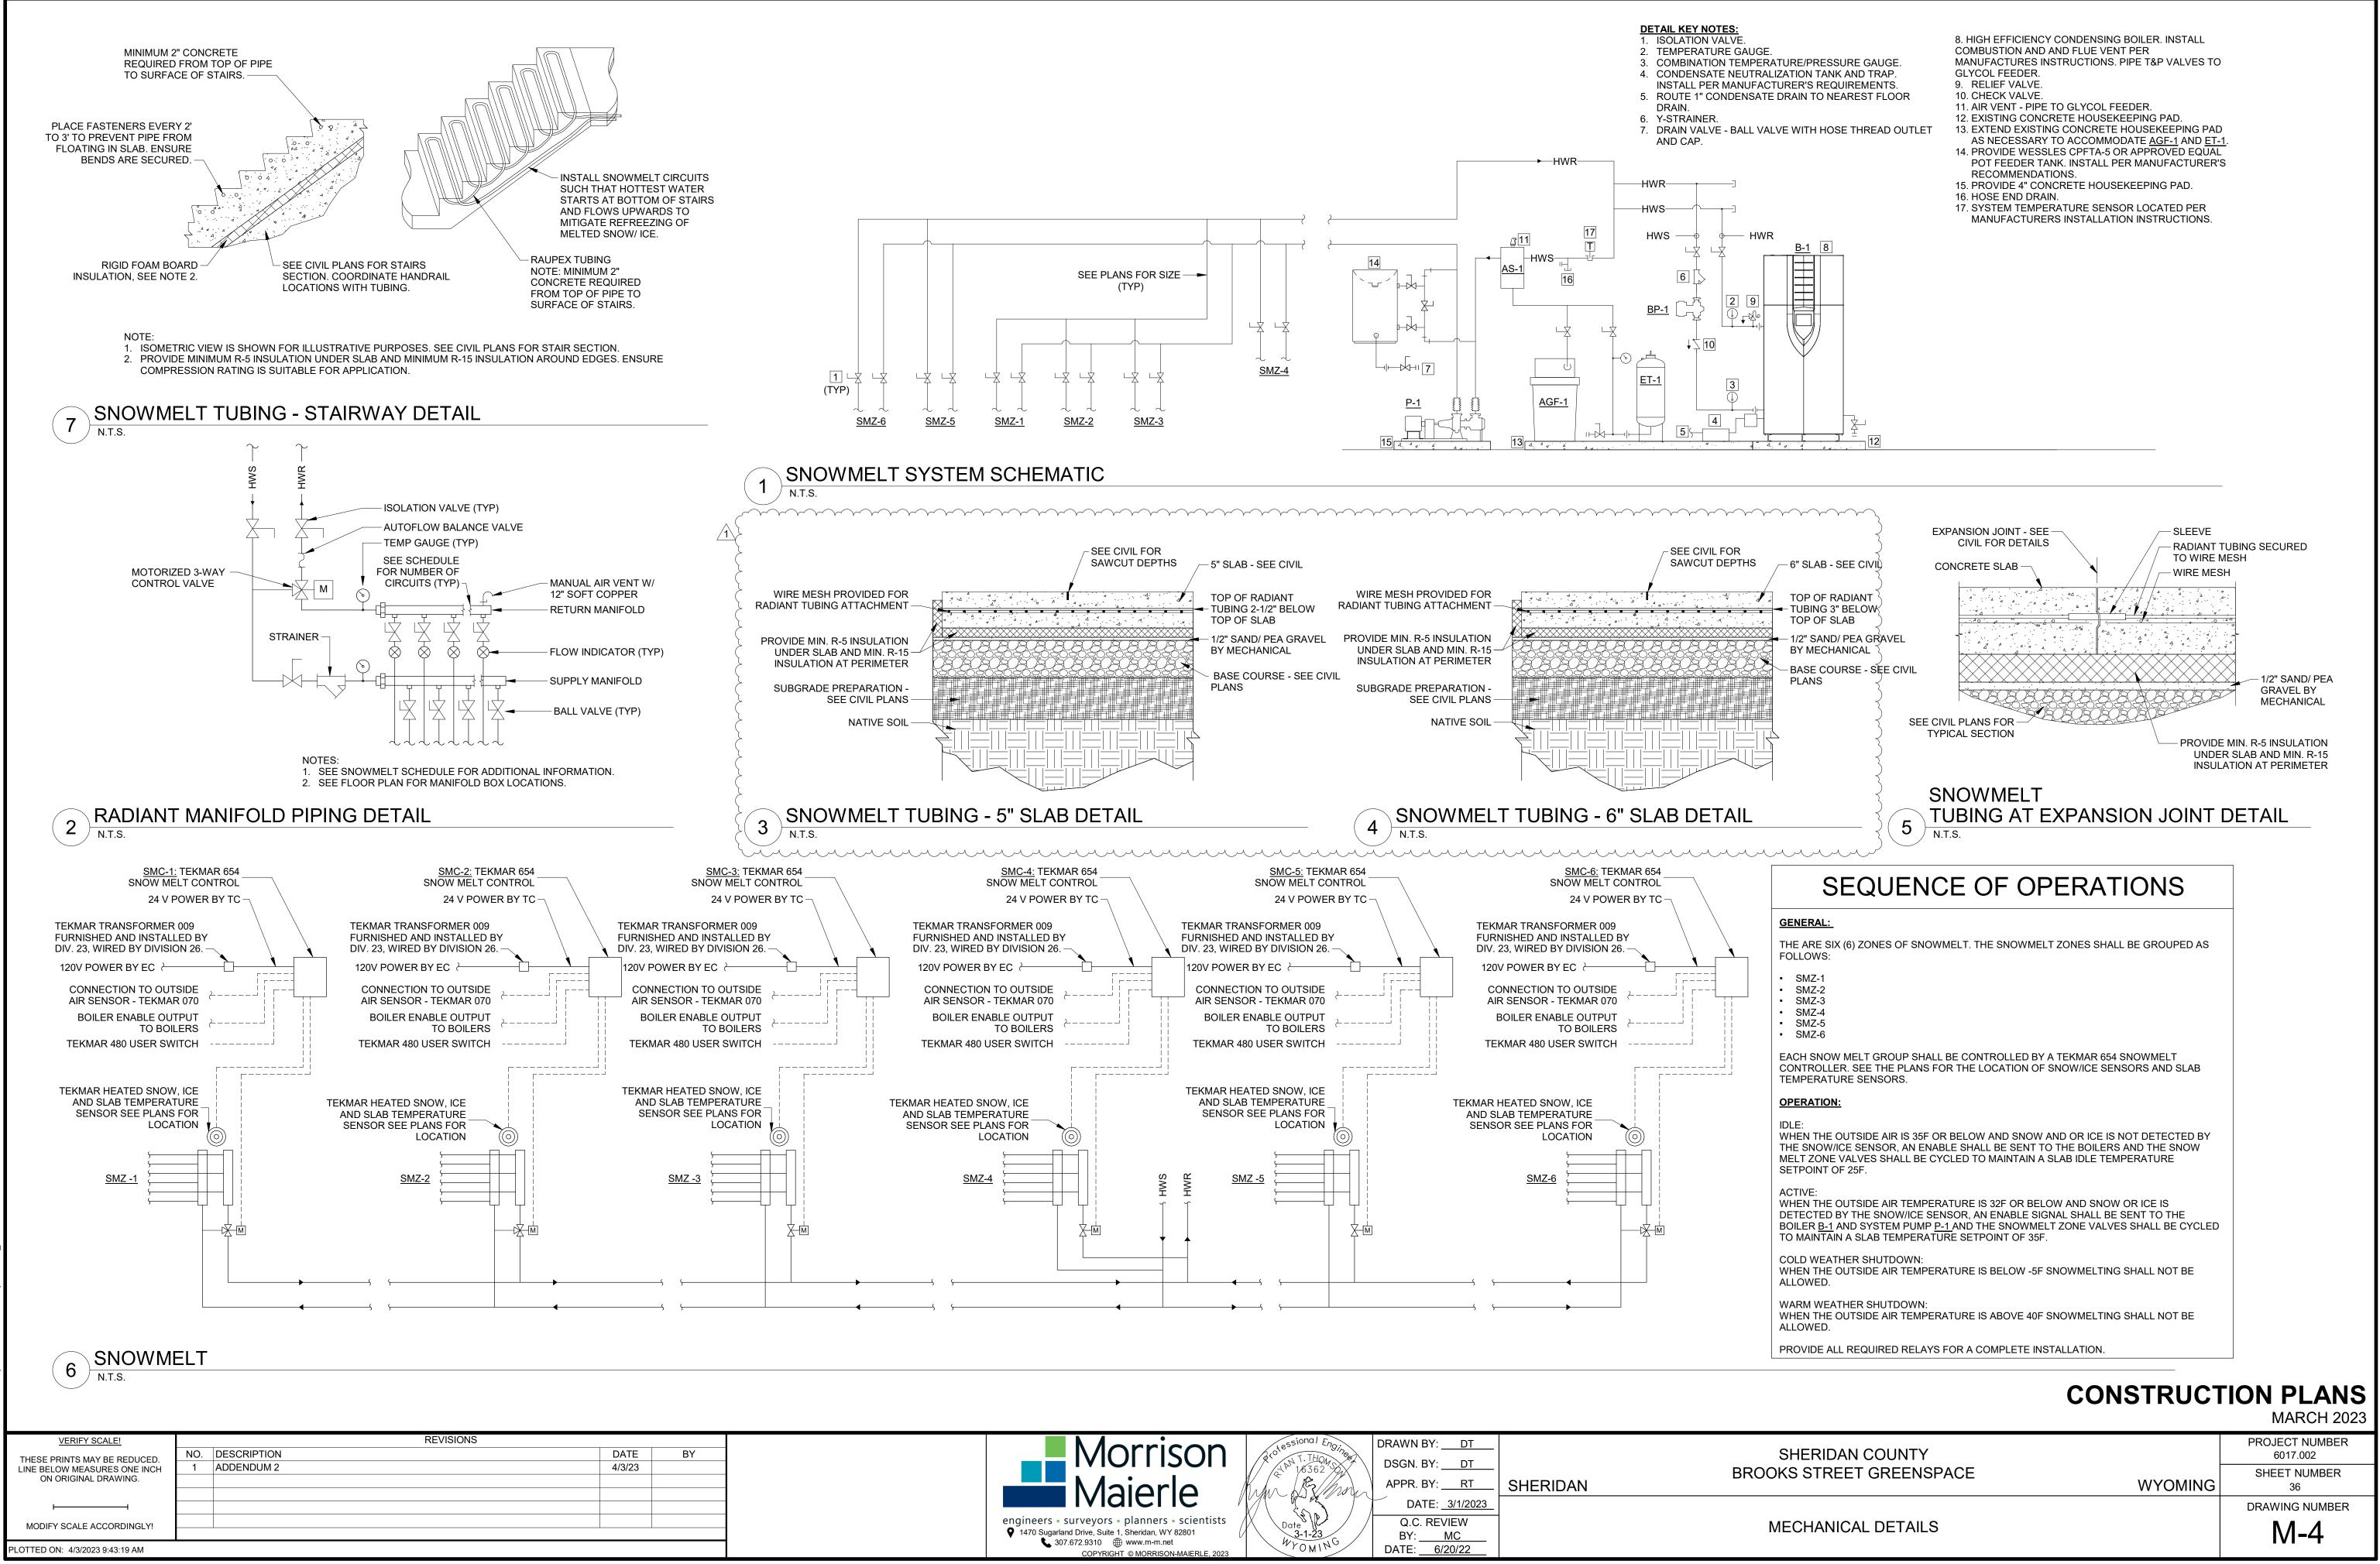

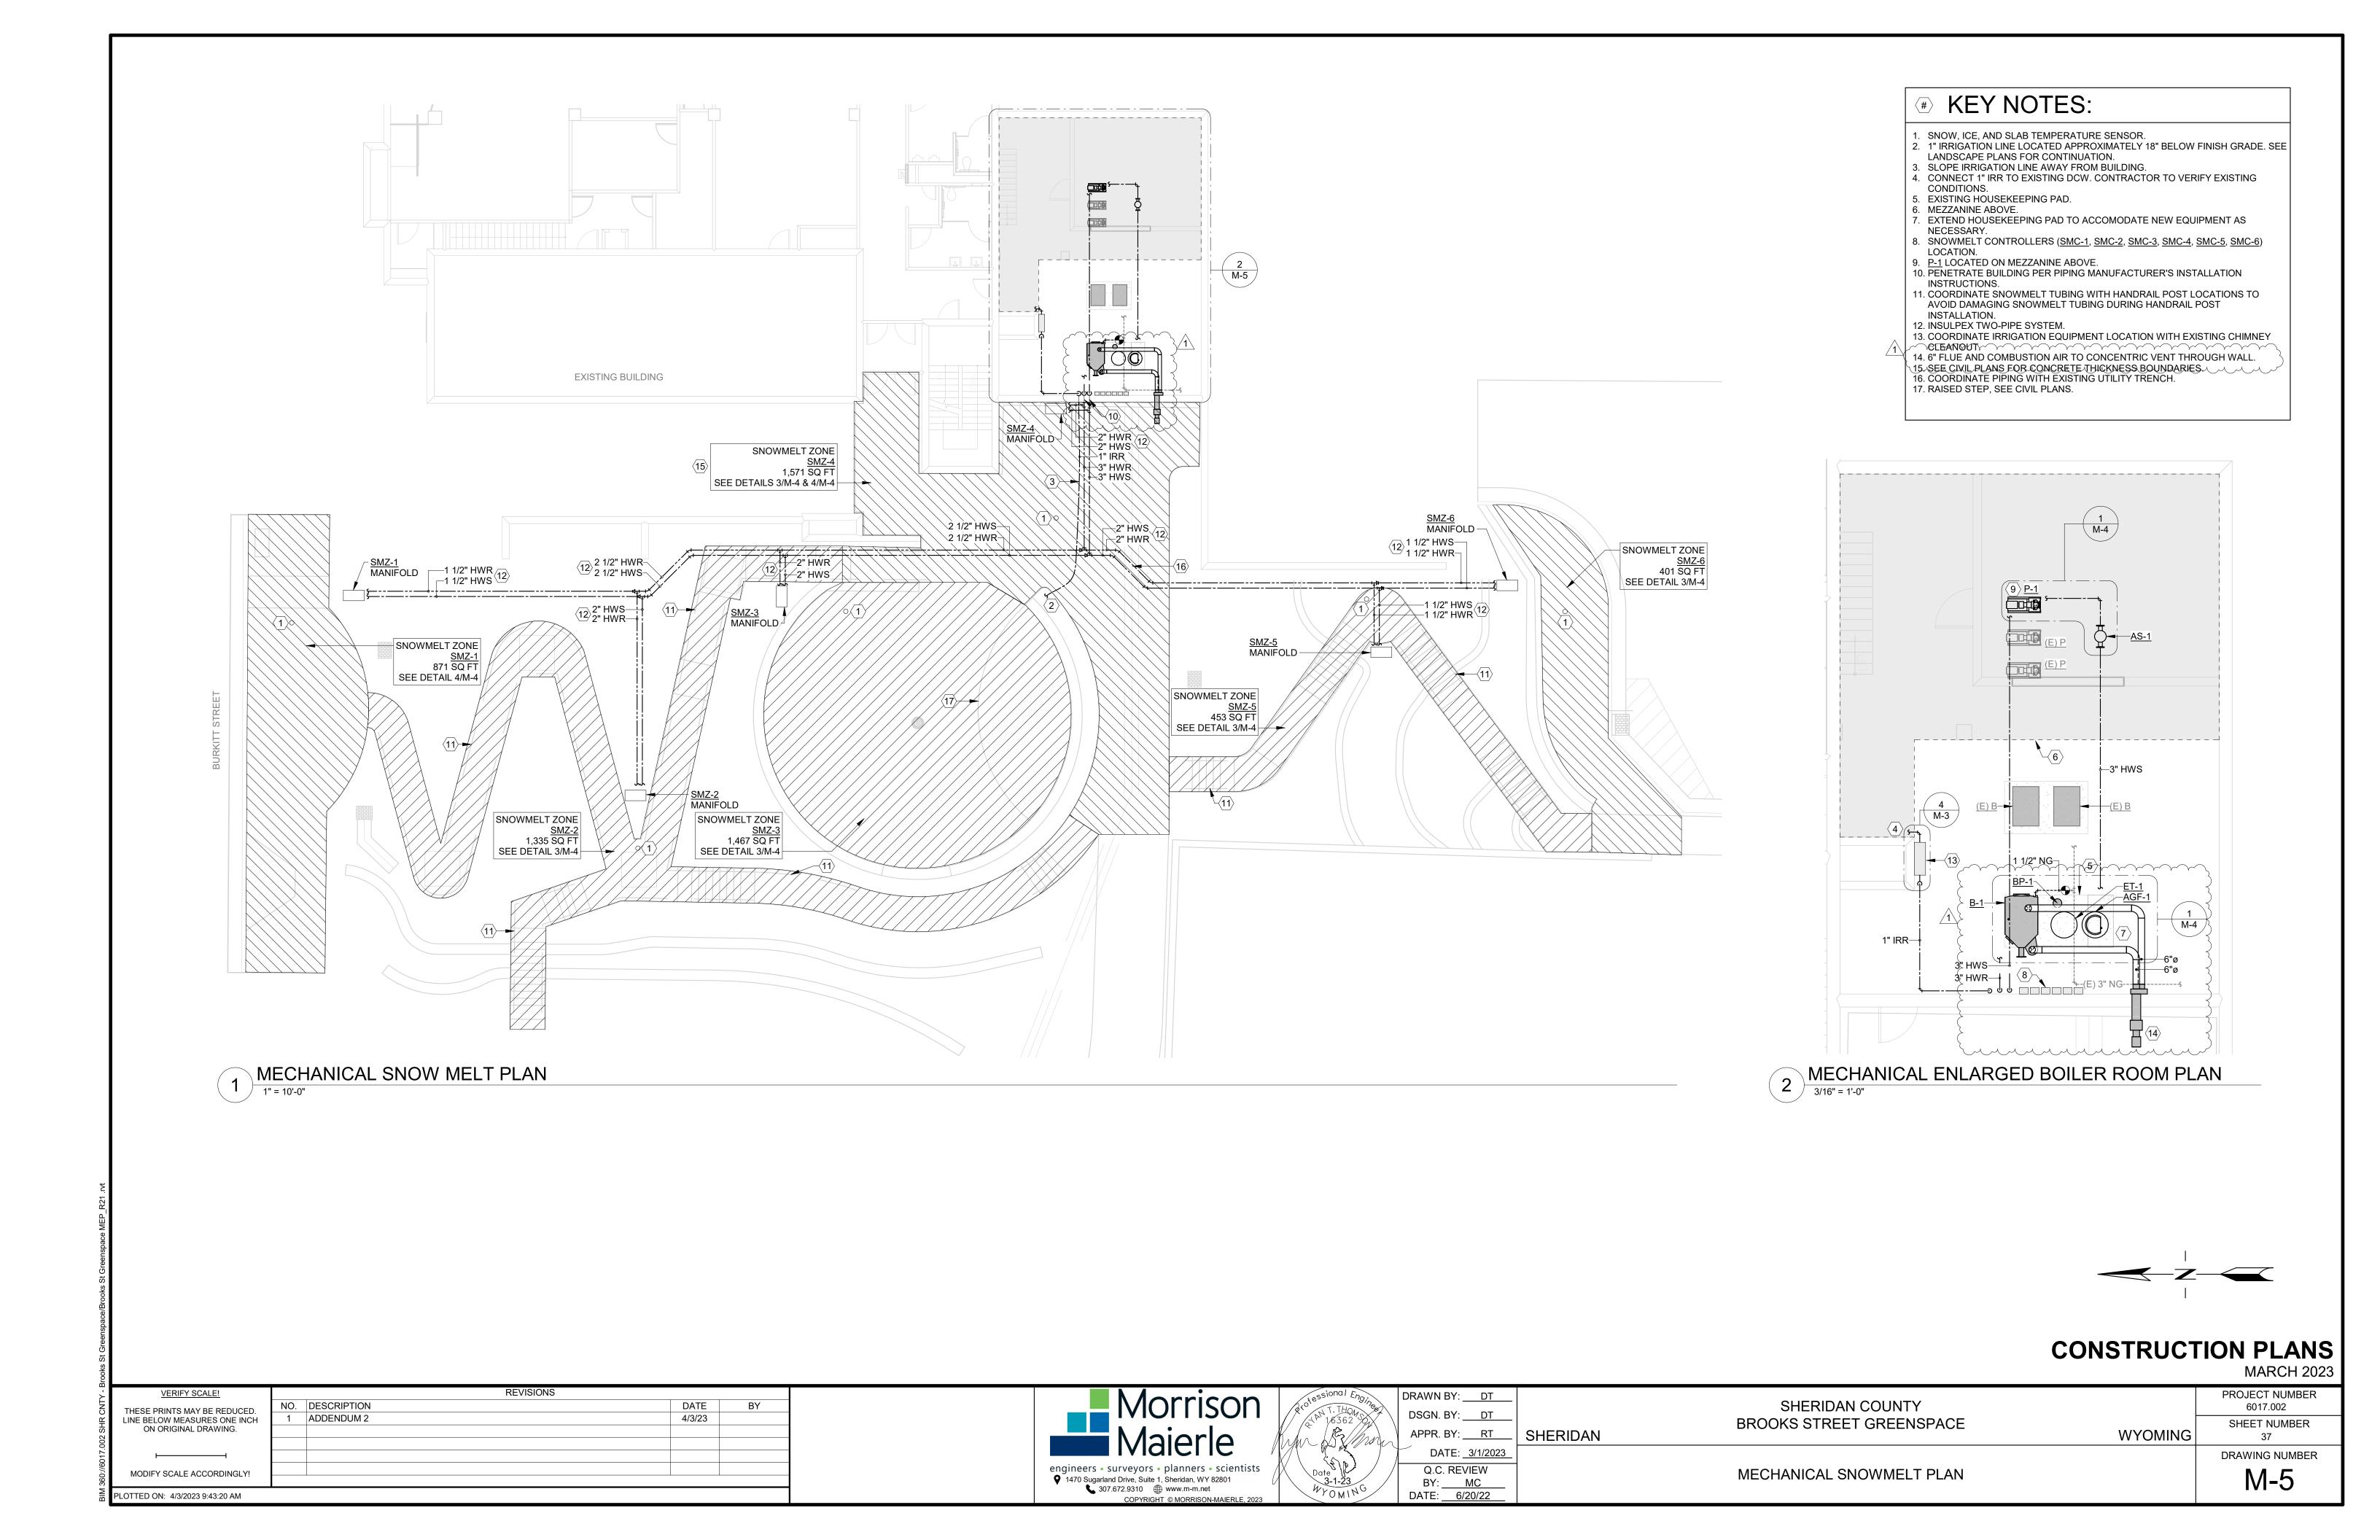


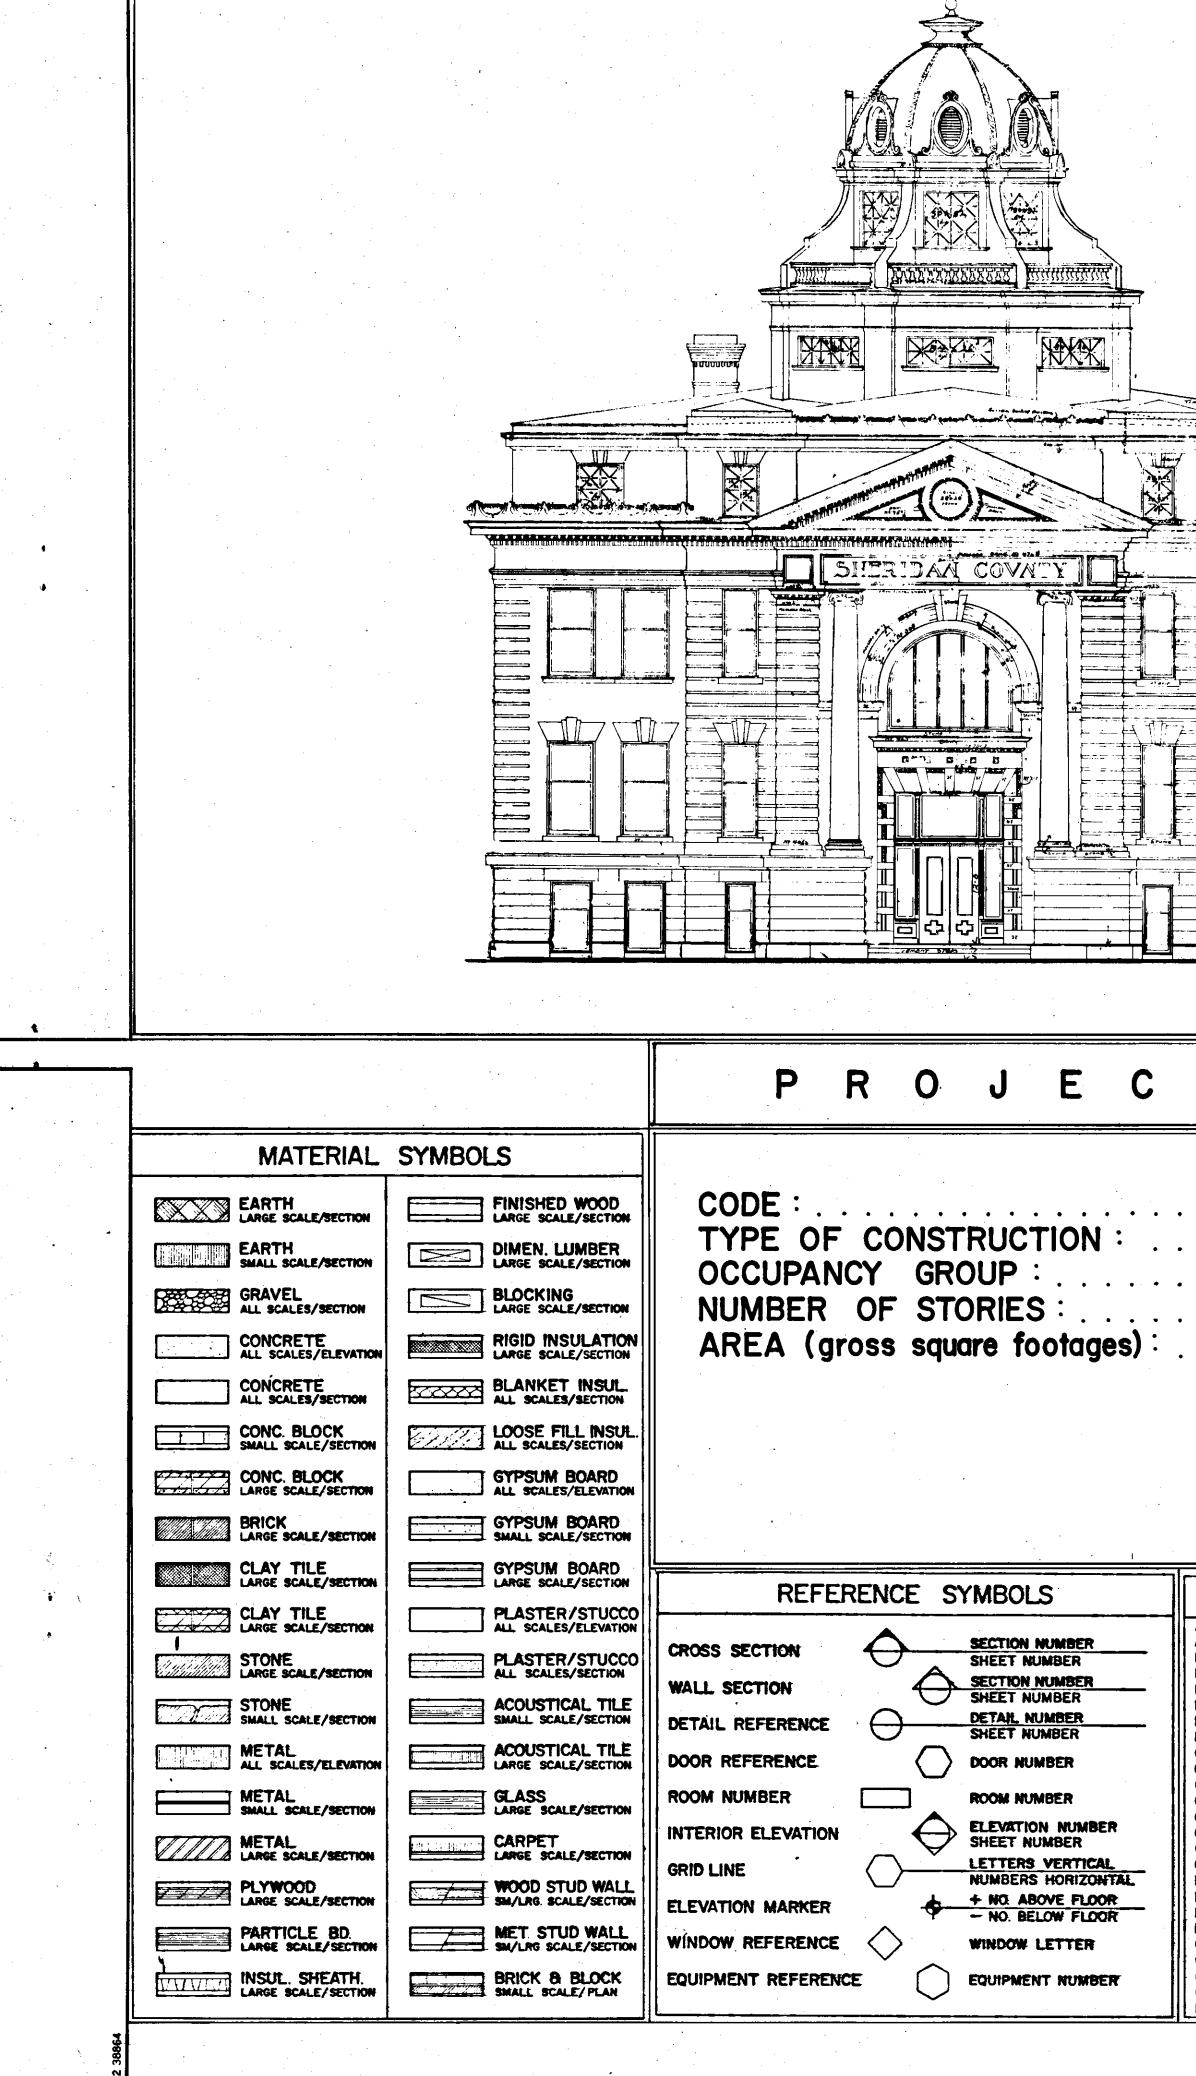



•

•

| | SHER Cou Cour | | PHONING ALIO-BI |
|---|---|--|--|
| ΤΟΑΤΑ | SHER VYOI | IDAN | SHERIDAN, SHERIDAN, Joe No. 2000 |
| | COVER SHEET L-1 EXISTING SITE & DEMOLITION PLAN L-2 NEW SITE PLAN & DETAILS A-1 FIRST FLOOR PLAN A-2 SECOND FLOOR PLAN A-3 THIRD FLOOR PLAN A-4 FOURTH FLOOR PLAN A-5 ROOM FINISH SCHEDULE / ROOF PLAN A-6 DOOR & HARDWARE SCHEDULES A-7 EXTERIOR ELEVATIONS A-8 BUILDING SECTIONS A-9 BUILDING SECTIONS A-10 BUILDING SECTIONS A-10 BUILDING SECTIONS A-10 BUILDING SECTIONS A-13 WALL SECTIONS A-14 WALL SECTIONS A-15 WALL SECTIONS A-16 TOILET ROOMS, STAIR & ELEVATOR PLANS A-17 STAIR & ELEVATOR SECTIONS A-18 CHIMNEY, STAIR & RAMP SECTIONS A-19 EXTERIOR OPENING DETAILS A-20 EXTERIOR OPENING DETAILS A-21 EXTERIOR OPENING DETAILS A-22 DOOR & WINDOW FRAME DETAILS A-23 INTERIOR ELEVATIONS A-24 INTERIOR ELEVATIONS A-24 INTERIOR ELEVATIONS A-25 INTERIOR ELEVATIONS A-26 INTERIOR ELEVATIONS A-29 INTERIOR ELEVATIONS A-29 INTERIOR ELEVATIONS A-30 INTERIOR ELEVATIONS A-31 INTERIOR ELEVATIONS A-32 INTERIOR ELEVATIONS A-32 INTERIOR ELEVATIONS A-29 INTERIOR ELEVATIONS A-30 INTERIOR ELEVATIONS A-31 INTERIOR ELEVATIONS A-32 INTERIOR ELEVATIONS A-33 INTERIOR ELEVATIONS A-34 INTERIOR FLEVATIONS A-34 INTERIOR FLEVATIONS A-35 INTERIOR ELEVATIONS A-30 INTERIOR ELEVATIONS A-30 INTERIOR ELEVATIONS A-31 INTERIOR FLEVATIONS A-32 INTERIOR FLEVATIONS A-34 INTERIOR FLEVATIONS A-35 INTERIOR FLEVATIONS A-34 INTERIOR FLEVATIONS A-35 INTERIOR FLEVATIONS A-36 INTERIOR FLEVATIONS A-37 INTERIOR FLEVATIONS A-36 INTERIOR FLEVATIONS A-36 INTERIOR FLEVATIONS A-37 INTERIOR FLEVATIONS A-36 INTERIOR FLEVATIONS A-36 INTERIOR FLEVATIONS A-36 INTERIOR FLEVATIONS A-36 INTERIOR FLEVATIONS A-36 INTERIOR FLEVATIONS A-36 INTERIOR FLEVATIONS A-37 INTERIOR FLEVATIONS A-36 INTERIOR FLEVATIONS A-36 INTERIOR | S-1 FOUNDATION PLAN S-2 FIRST FLOOR PLAN S-3 SECOND FLOOR FRAMING PLAN S-4 THRD FLOOR FRAMING PLAN S-5 FOURTH FLOOR FRAMING PLAN S-6 ROOF FRAMING PLAN S-7 COLUMN SCHEDULE & DETAILS S-8 BEAM SCHEDULE S-9 JOIST SCHEDULE S-10 STRUCTURAL DETAILS S-11 STRUCTURAL DETAILS S-12 STRUCTURAL DETAILS S-13 STRUCTURAL DETAILS S-14 STRUCTURAL DETAILS S-15 STRUCTURAL DETAILS S-15 STRUCTURAL DETAILS S-15 STRUCTURAL DETAILS S-16 STRUCTURAL DETAILS S-17 FIRST FLOOR PLBG & HTG PLAN M-2 FIRST FLOOR VENT & AC. PLAN M-3 SECOND FLOOR PLBG & HTG PLAN M-4 SECOND FLOOR VENT & AC. PLAN M-5 THIRD FLOOR VENT & AC. PLAN M-6 THIRD FLOOR VENT & AC. PLAN M-7 FOURTH FLOOR VENT & AC. PLAN M-7 FOURTH FLOOR VENT & AC. PLAN M-7 FOURTH FLOOR VENT & AC. PLAN M-9 SECTIONS & DETAILS M-10 SECTIONS & DETAILS M-11 SECTIONS & DETAILS ME-1 MECH & ELECT. SITE PLAN E-1 FIRST FLOOR PLBG ITAILS ME-1 MECH & ELECT. SITE PLAN E-2 FIRST FLOOR POWER PLAN E-3 SECOND FLOOR LIGHTING PLAN E-4 SECOND FLOOR PLAN E-5 THIRD FLOOR PUEM PLAN E-6 THIRD FLOOR PLAN | DRAKE, GUSTAFSON & ASSOCIATES Architects · Planners · Designers eleven east airport roai billings montana 59101 tel: 245-648 drawn by checked by |
| GAGE GA TYPICAL TYP GALVANIZED GALY VINYL ASBESTOS TILE VAT GALVANIZED IRON GI VINYL WALL COVERING VWC GYPSUM BOARD GB WITH W/ INTERIOR INT WOOD WD | A-35 FIRST FLOOR REFLECTED CEILING PLAN, LUM. CEILING DETAILS A-36 SECOND FLOOR REFLECTED CEILING PLAN, LUM. CEILING DETAILS A-37 THIRD FLOOR REFLECTED CEILING PLAN A-38 FOURTH FLOOR REFLECTED CEILING PLAN, OAK PANELING DET. | E-7 FOURTH FLOOR LIGHTING PLAN E-8 FOURTH FLOOR POWER PLAN E-9 FIRST FLOOR UNDERFLOOR DUCT PLAN E-10 THIRD FLOOR UNDERFLOOR DUCT PLAN E-11 ELECTRICAL ROOM ELEVATIONS E-12 PANEL SCHEDULES E-13 PANEL SCHEDULES E-14 DETAILS E-15 DETAILS | |

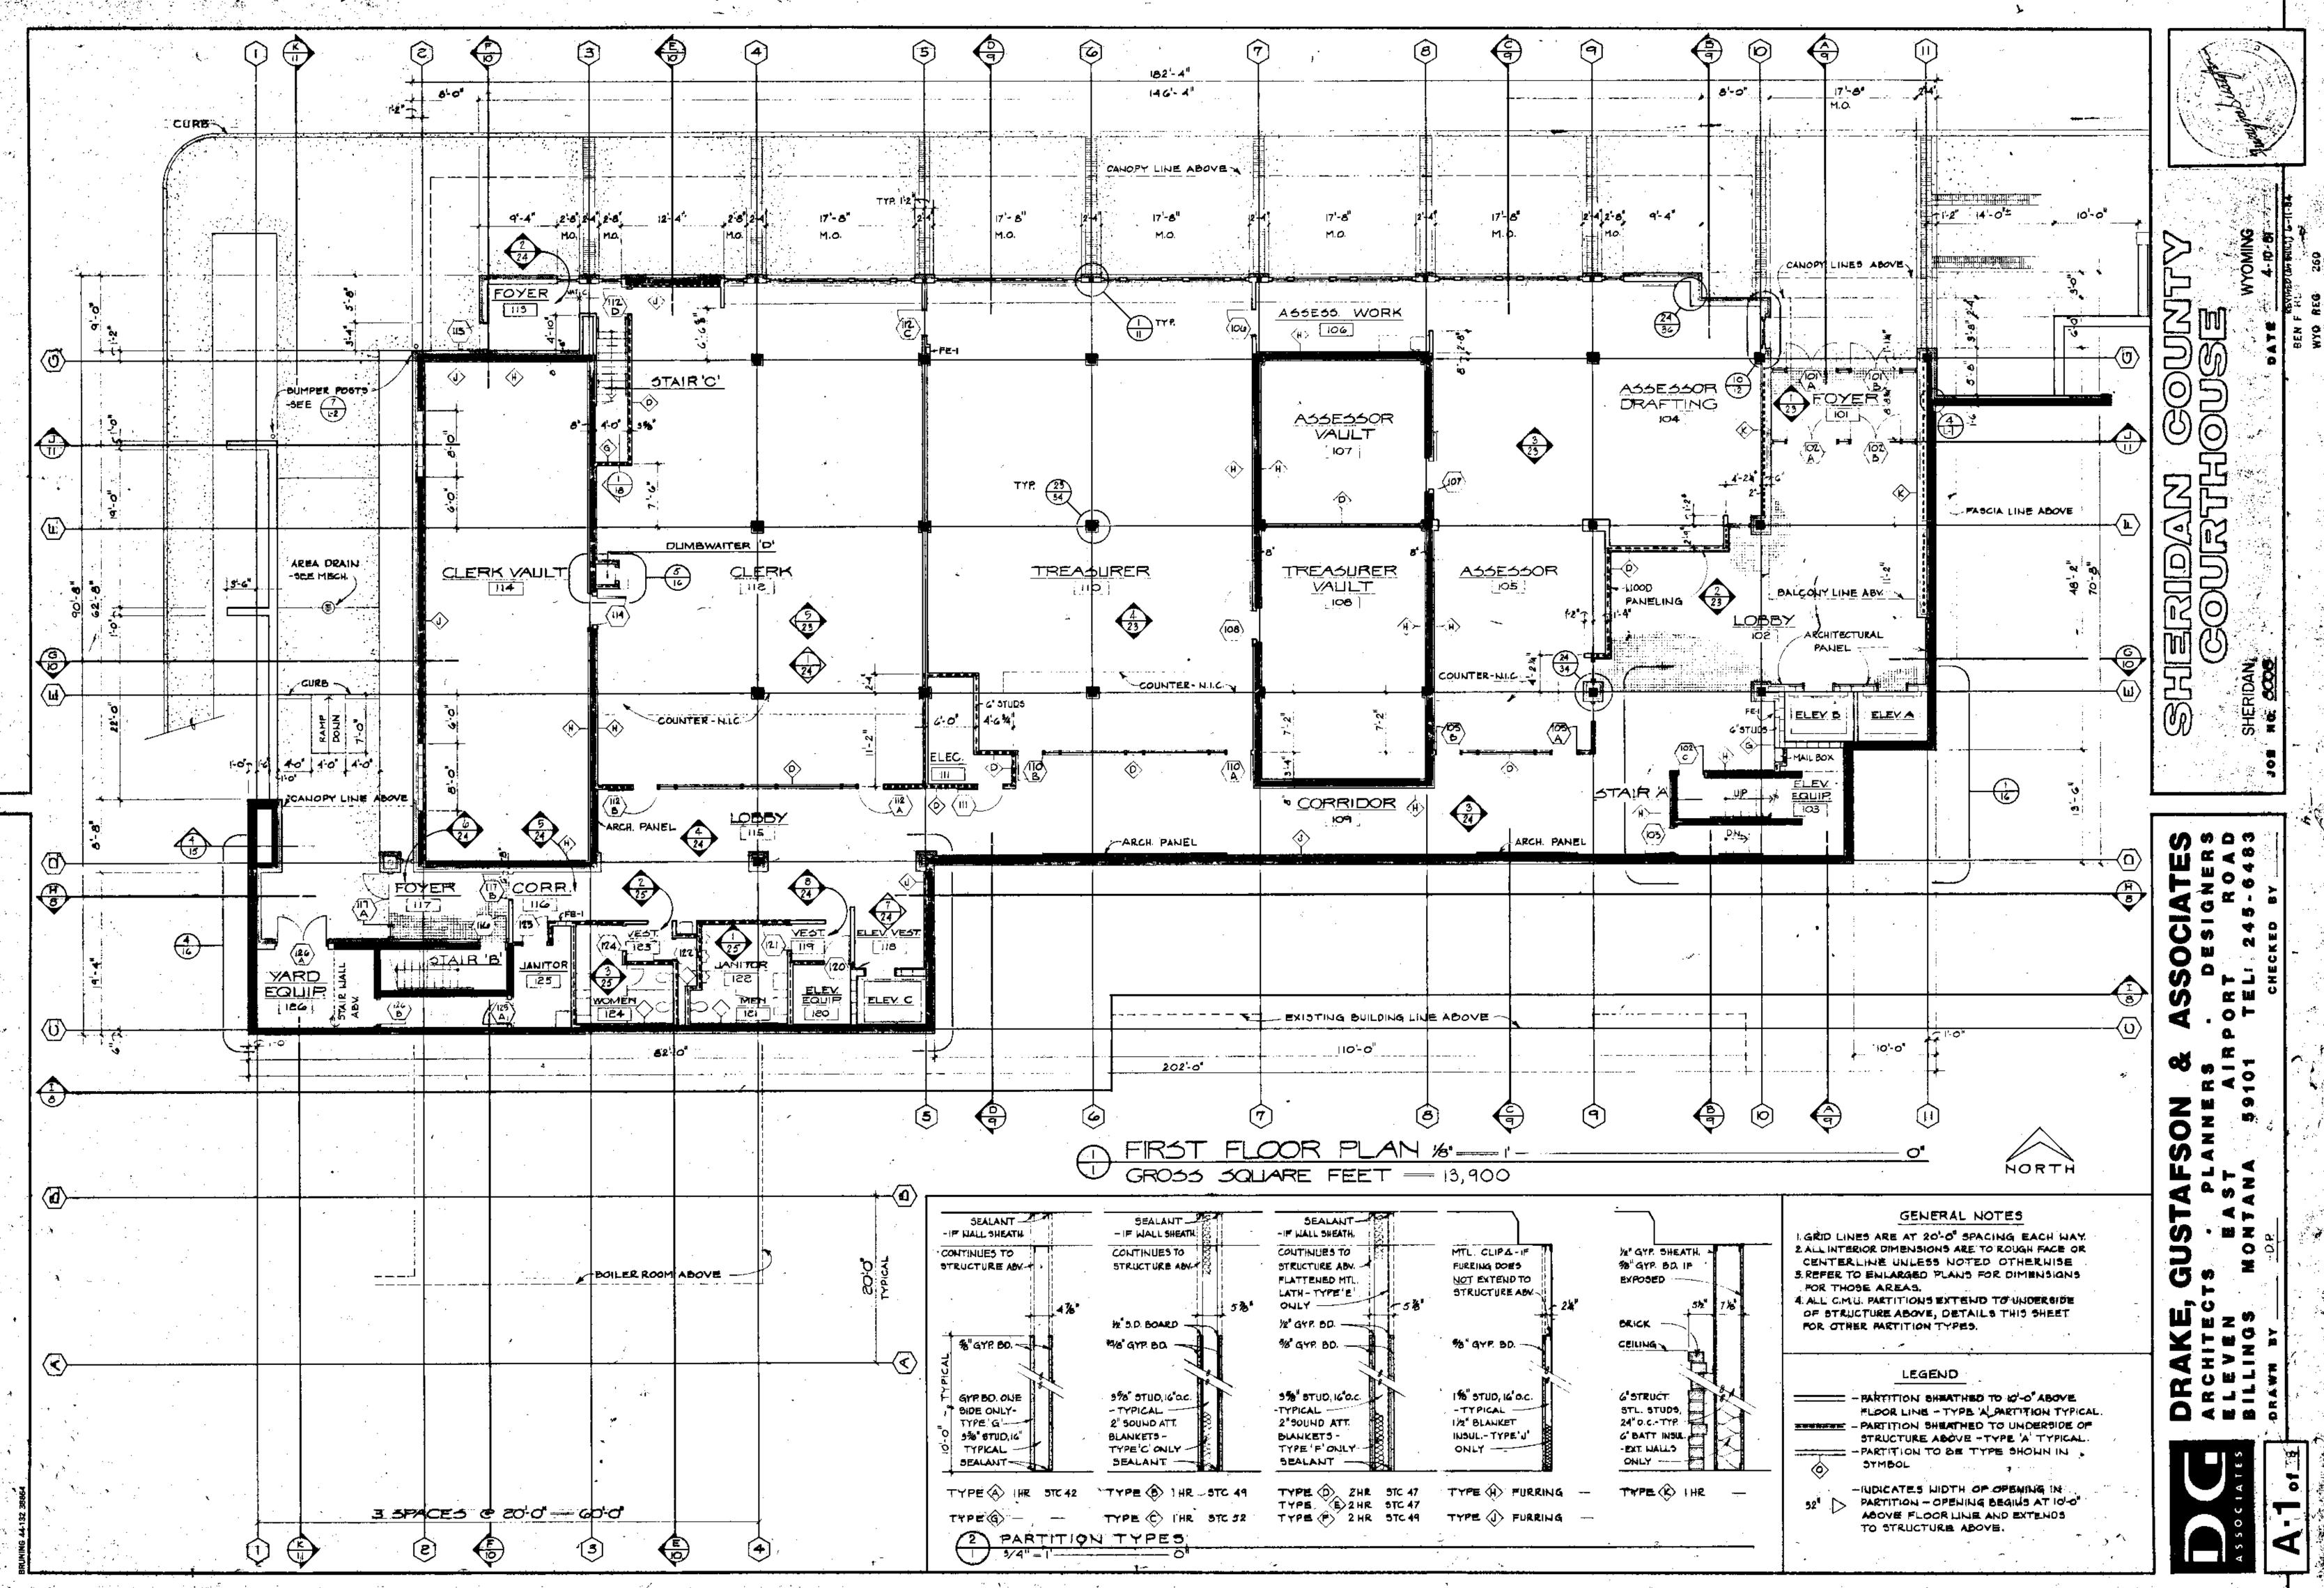


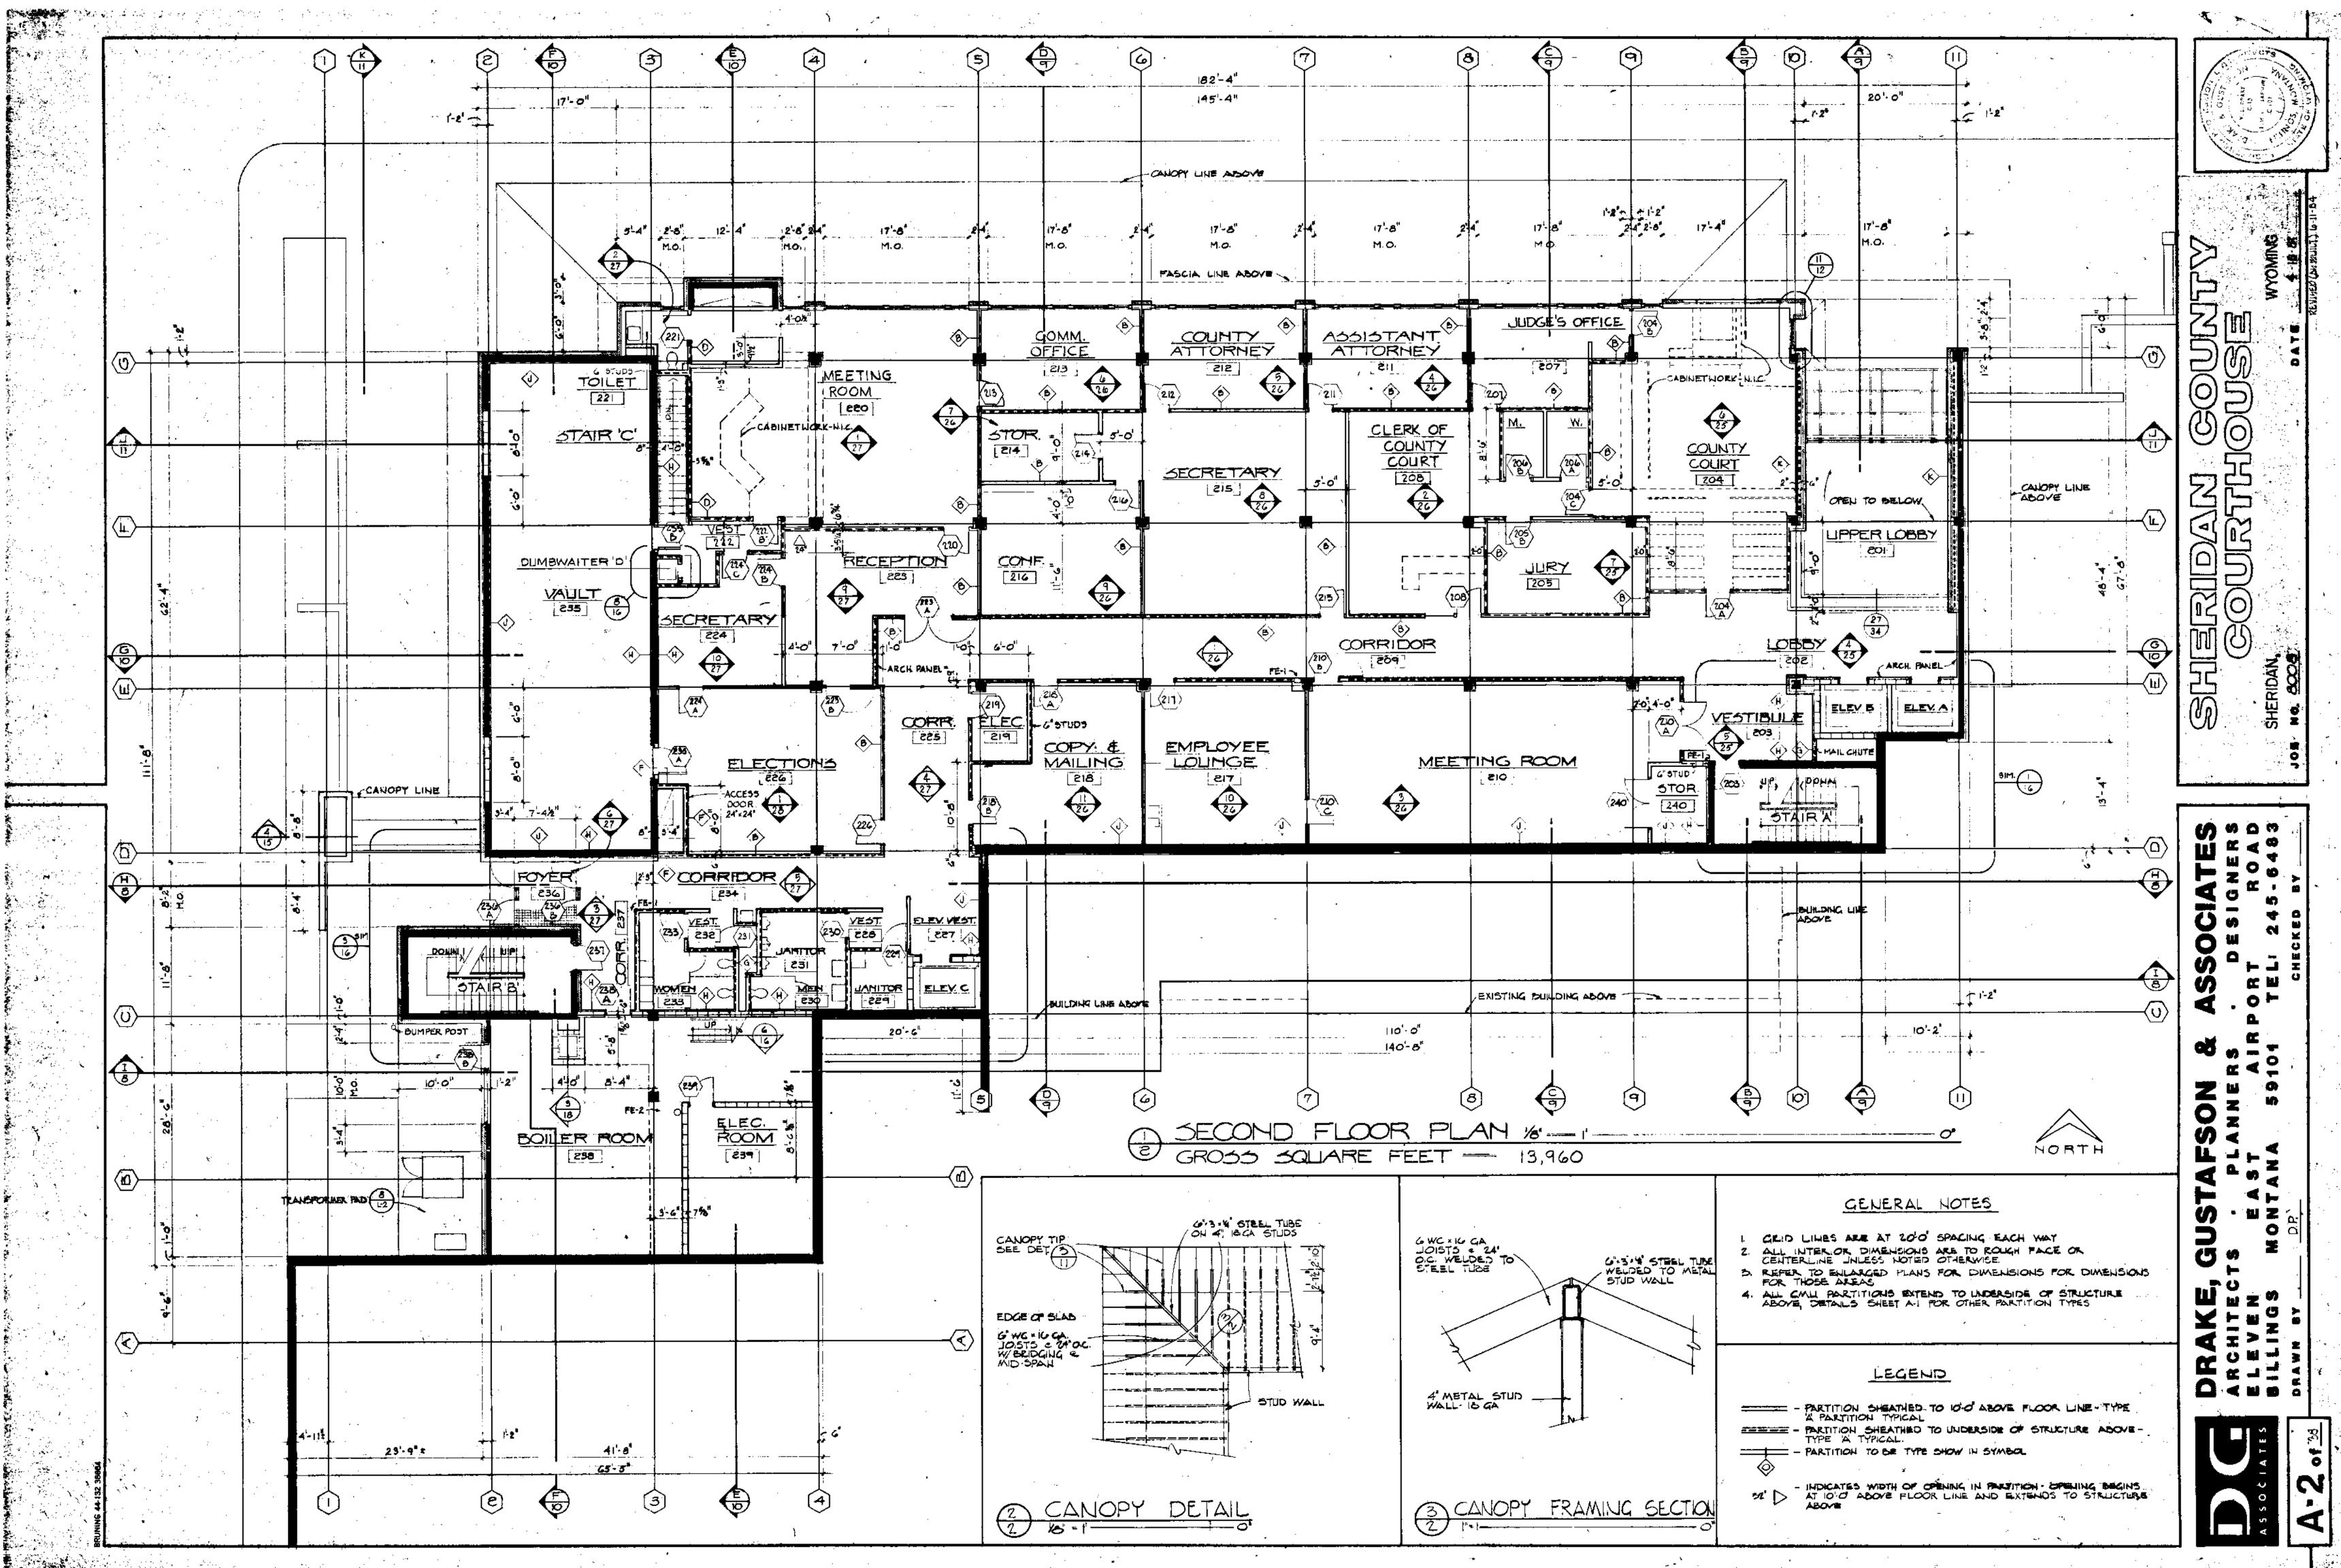

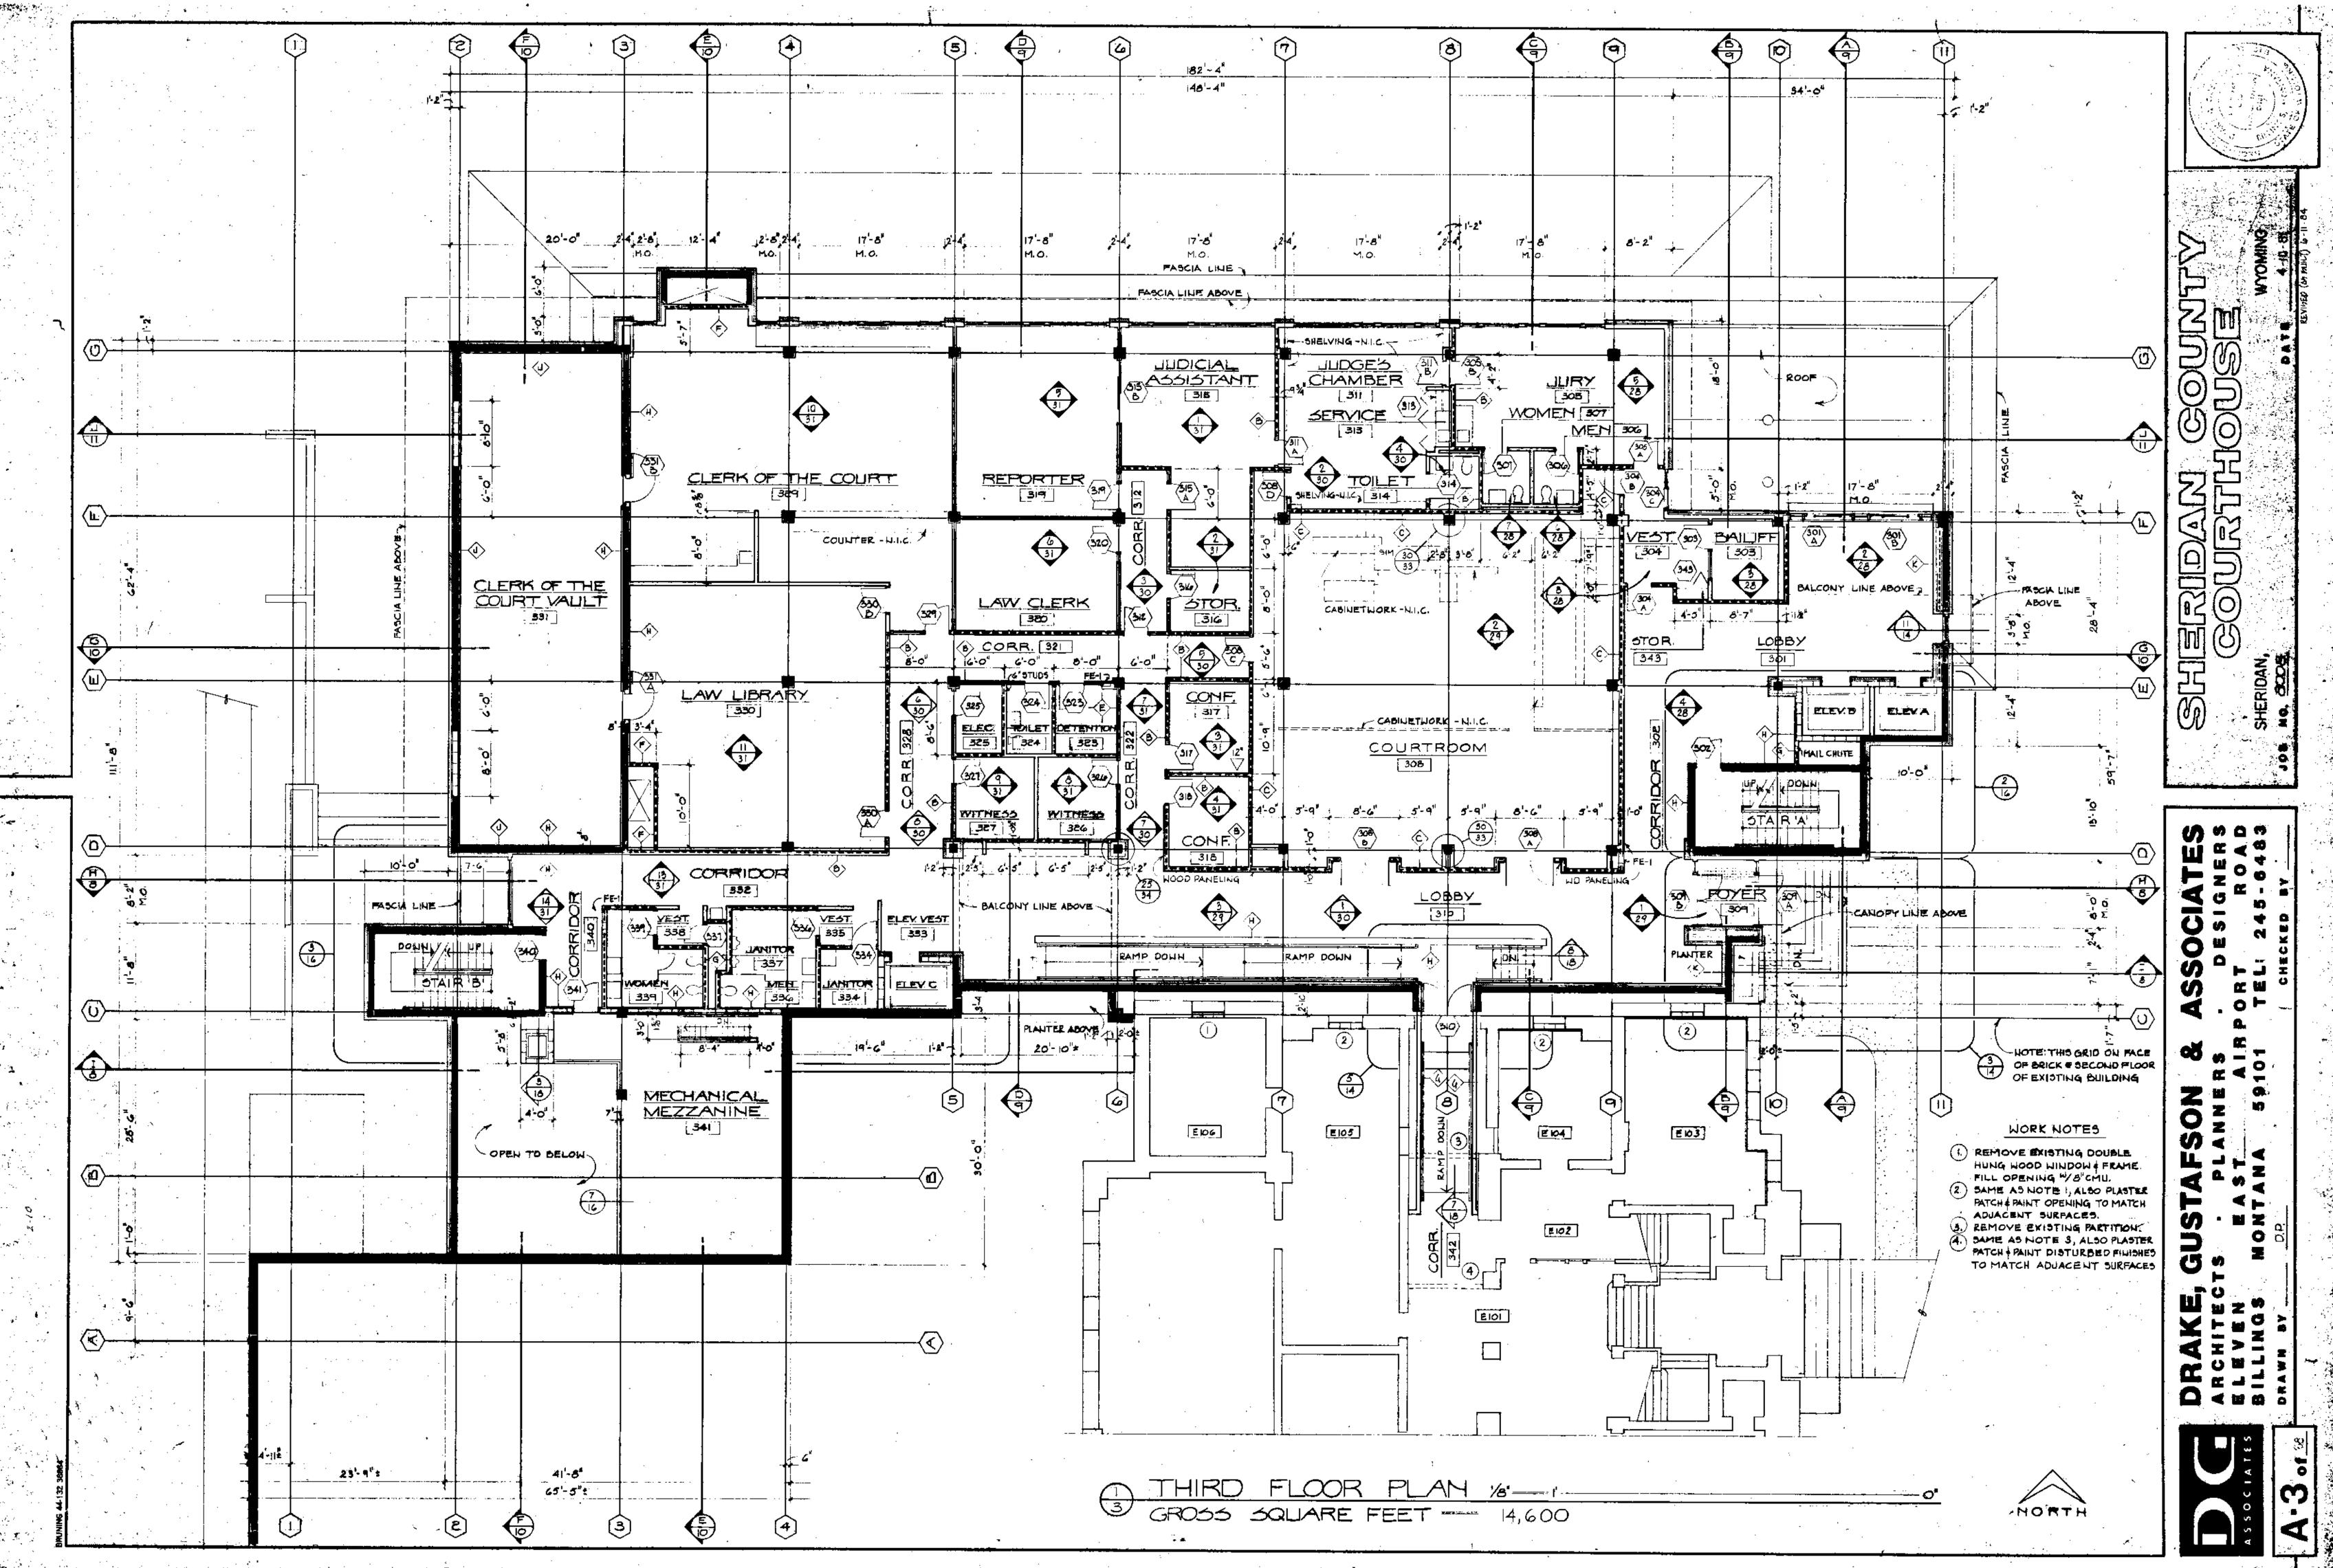


A MARINE A CARACTER AND A CARACTER A

and a star of the star of the

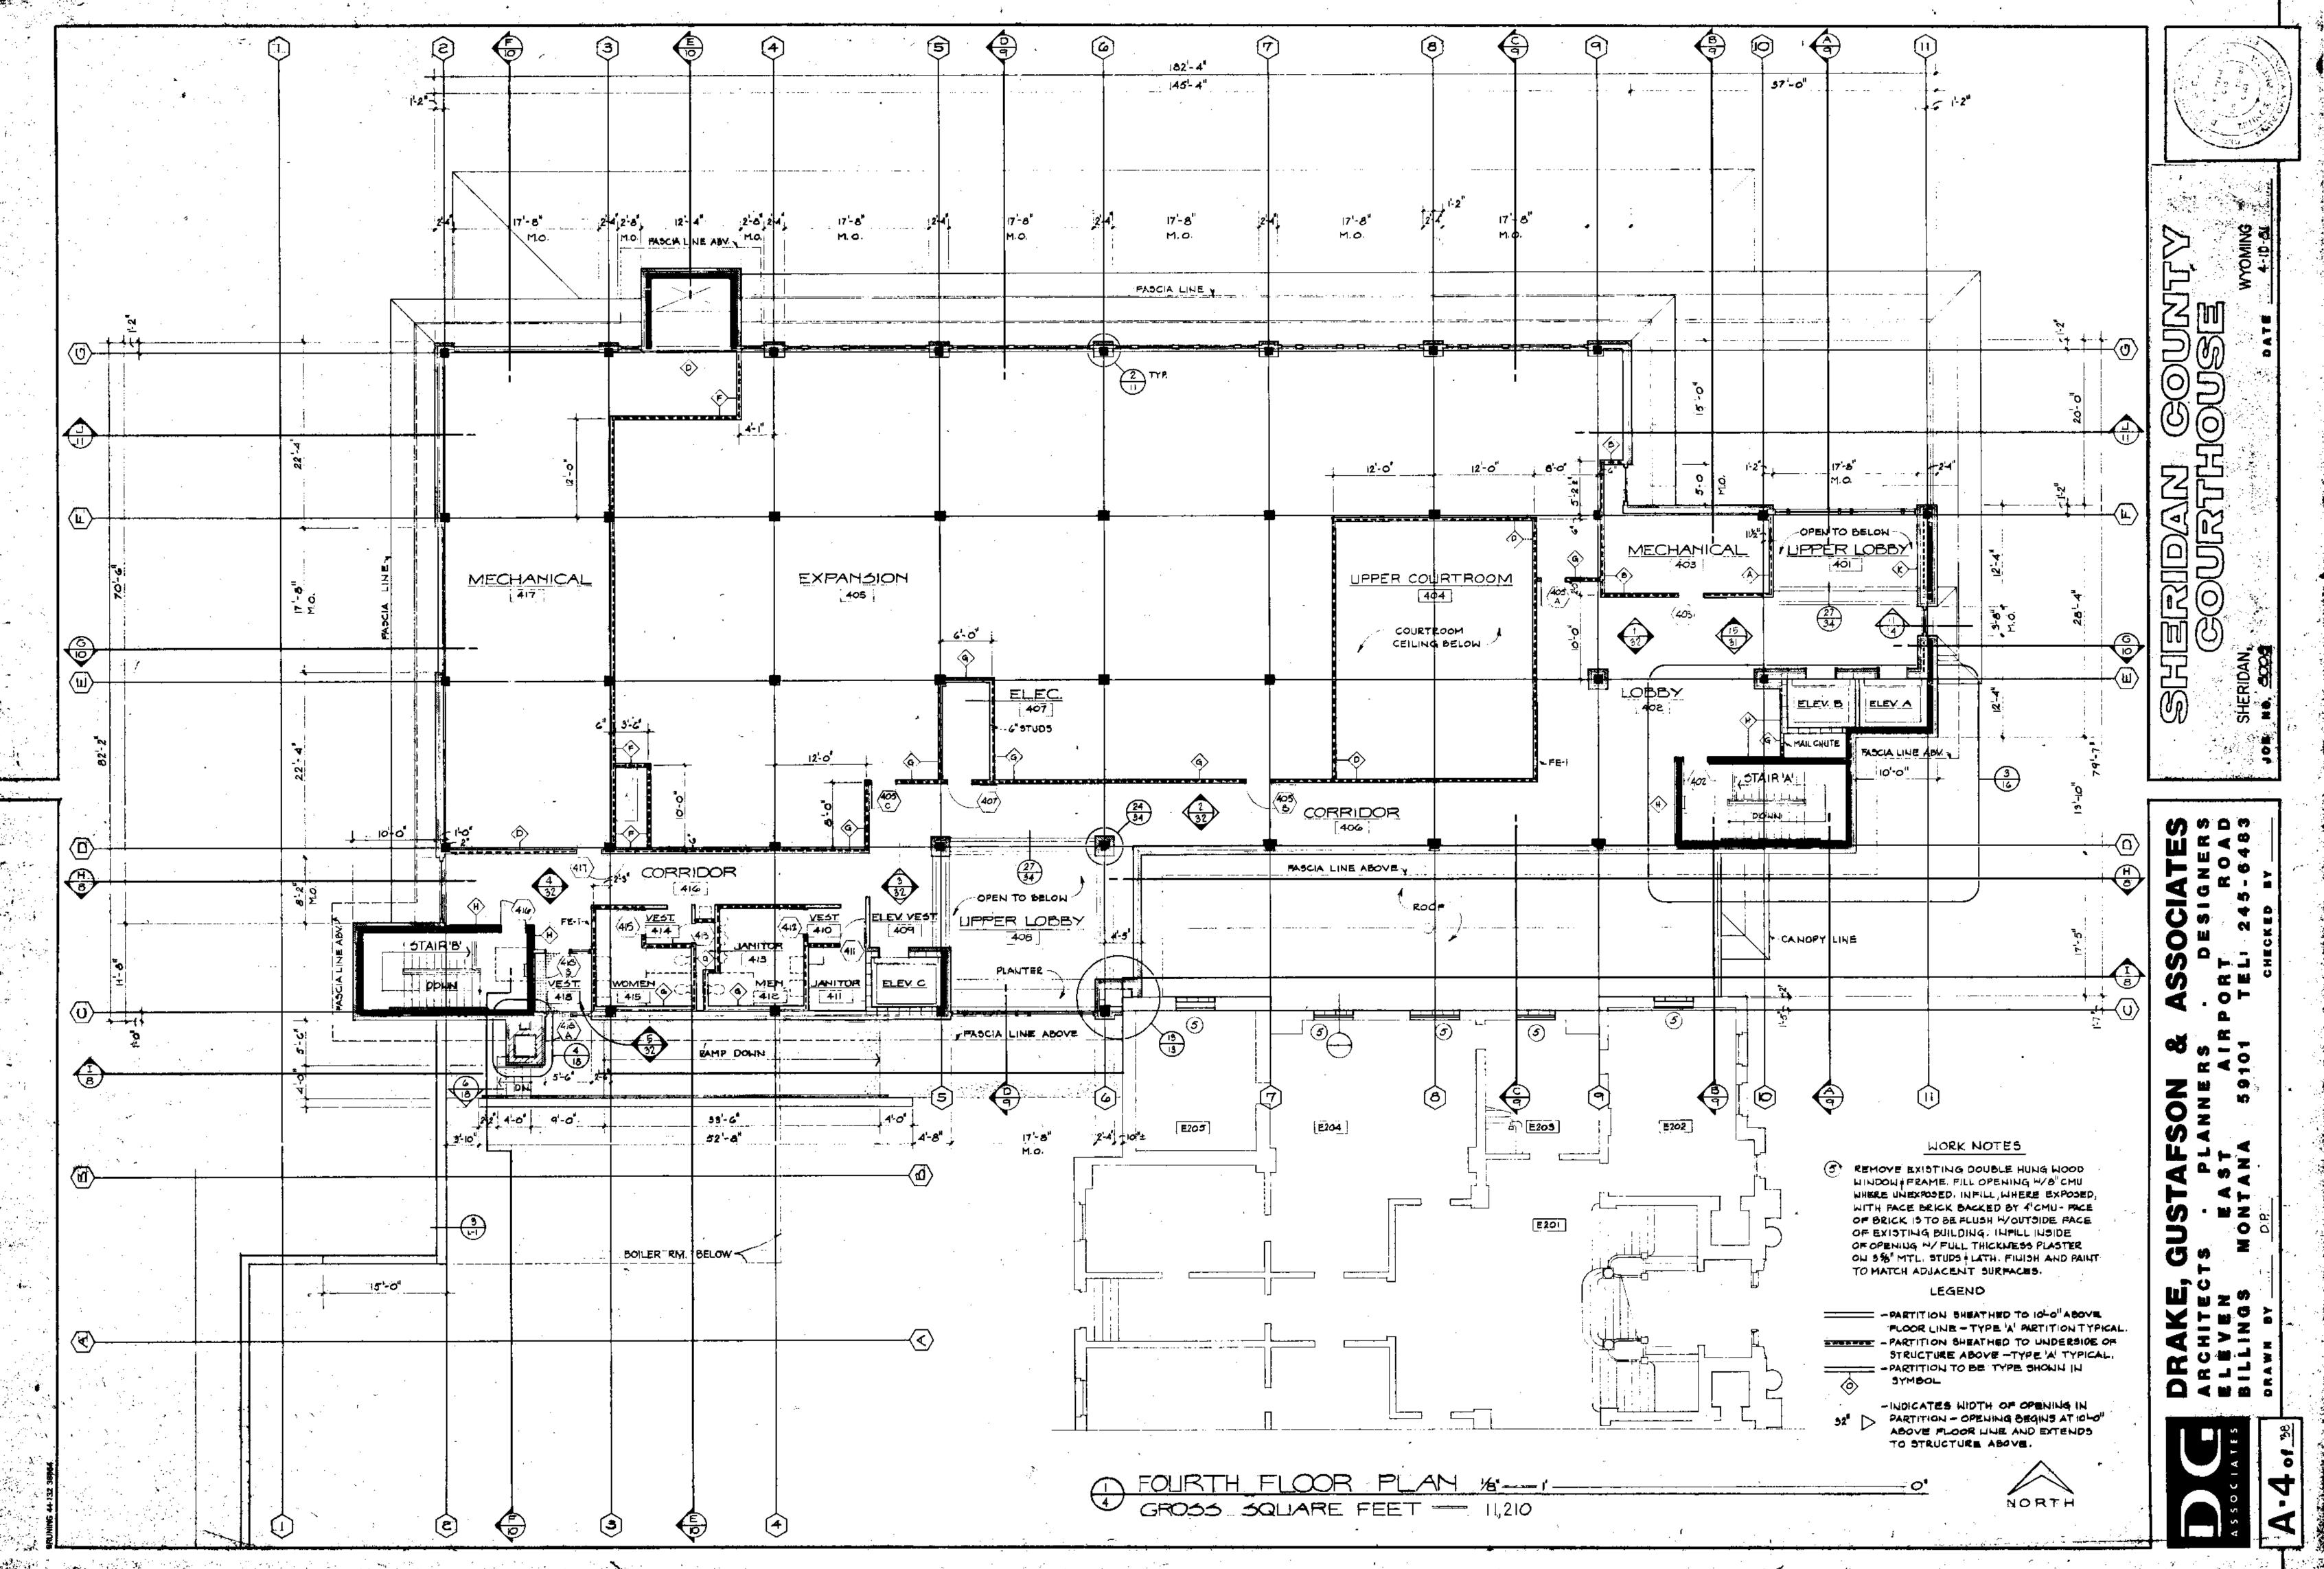

3.00

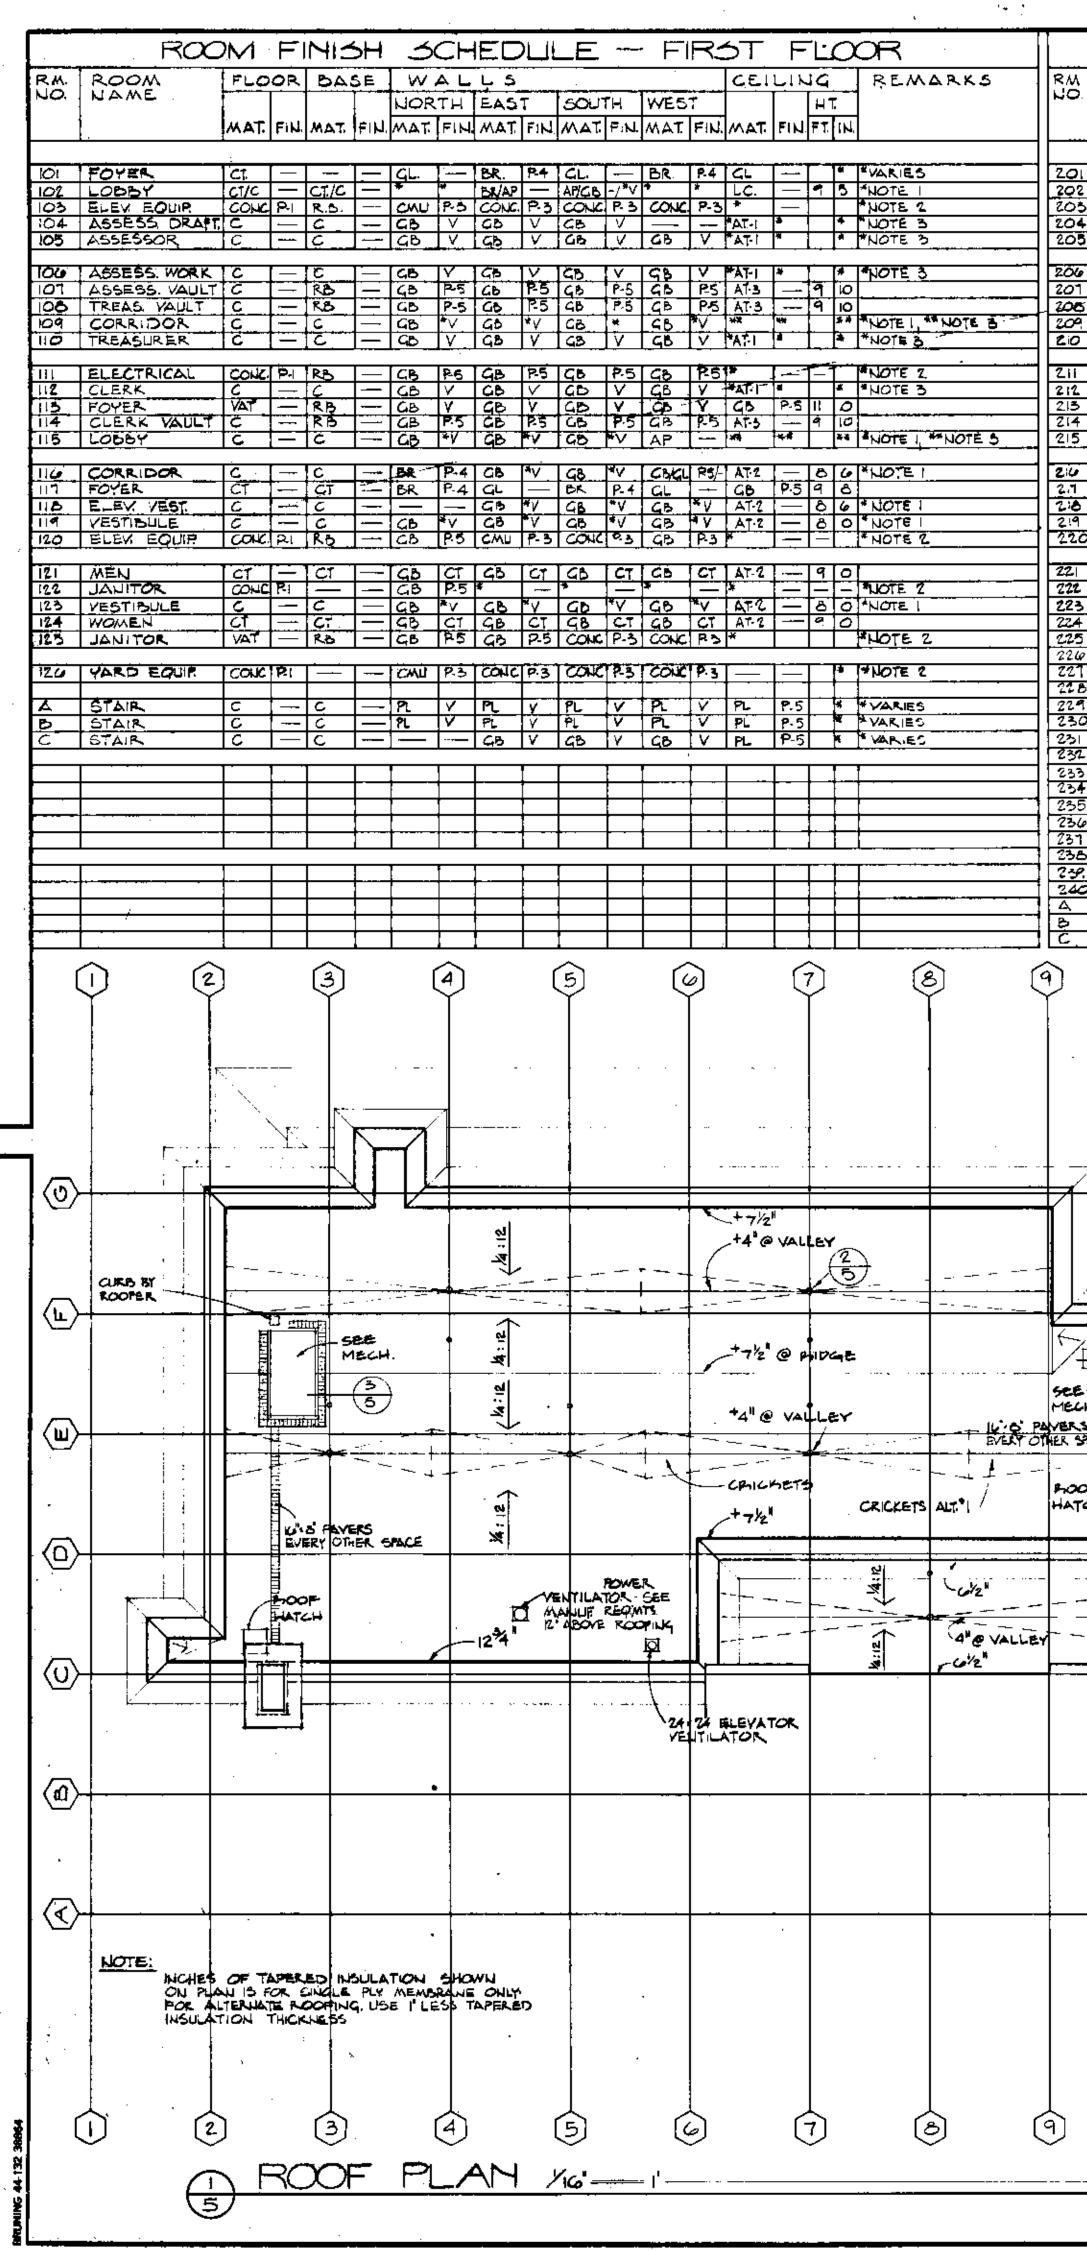

•


•

--

_

| | and the second sec | |
|--|--|---------------------------------|
| ROOM FINISH SCHEDULE SECOND FLOOR | ROOM FINISH SCHEDULE THIRD FLOOR | |
| AM ROOM FLOOR DAGE WALLS CEILING REMARKS | RM. ROOM PLOOR BASE WALLS CEILING REMARKS NO. NAME NORTH BAST SOUTH WEST HT - GEE NOTE G MAT. FIN. MAT. FIN. MAT. FIN. MAT. FIN. MAT. FIN. MAT. FIN. FT. IN. | |
| ZOI UPPER LOBBY | 301 LODBY C C GLKB-/*V BR P4 BK/GB #V #* #* # #NOTE + **NOTE 3 | |
| 202 LOBBY C C GB *V AP - AP/BL -/R4 GB *V ** - ** *. WOTE I, **NOTE 2 203 VESTIBULE C - C - BR P.4 GB *V GB *V AT-2 - 8 6 204 J.P. COURT C - C - GB P-4 GB V GB V GB * AT-2 - *4 *NOTE I, **NOTE 3 | 302 CORRIDOR C - C - GB V BKGB PH/V GB WD AT 2 - 8 6 NOTE I 303 BAILIFF C - C - GB V GB V GB V AB V AT 2 - 8 0 304 VESTIBULE C - C - GB V GB V GB V GB V AT 2 - 8 0 | |
| 205 CONF C - C - GB V GB V GB V GB V AT 2 - BO | 305 JURY C - C - GO V GO V GO V AT-2 - 80 | |
| 201 J. R. CHAMBERS G - C - GB V GB V GB V GB V AT2 - 6 0 205 J. R. OFFICE C - C - GB V GB V GB V GB V AT2 - 8 0 209 CORRIDOR C - C - GB V GB V GB V GB WD AT2 - 80 | 300/mext SV GB V GB V GB P.5 BO 301 Wamen 5V 6V GB V GB V GB P.5 BO 308 COUNTROOM C CB * GB * G *** - *NOTE 3 308 COUNTROOM C CB * GB * G *** - *NOTE 3 309 FOYER C1 - BK P.4 GL/GB 7/85 BR P.4 GL/GB 7/95 GB P.5 B G | |
| CIO MEETING ROOM C - C - GB V GB V GB V GB V ATA - 9 0 | 3:0 LOBBY C - C - GB WO BR P4 BR P4 BR P4 AT 2 ** ** ** ** NOTE 1, ** NOTE 3 | |
| 212 COUNTY ATTORNEY C - C - GD V GD V GD V GD V ATZ - 80 213 ASST ATTORNEY C - C - GB V GB V GB V GB V ATZ - 80 | 312 CORRIDOR C - C - GB V GB C GB V GB V AT C - 8 6 NOTE I 313 SERVICE C - C - GB V GB V GB V - GB P5 7 4 | |
| 214 STORAGE C C GB P.5 GD P5 GB P5 GB P5 AT2 80 215 SECRETARY C C GB V GD V GD V GD V AT2 80 | 314 TOILET C - C - CB V GB V GB V GB V GB P5 80 315 Judical Assist C - C - GB V GB V GB V GB V AT2 - 80 316 STORAGE C C GB P5 GB P5 GB P5 G3 P5 AT2 - 80 | |
| 210 CONF. C - C - GB V GB V GB V GB V AT.2 - 80 211 EMPLOY LOUNGE C - C - GB V GB V GB V GB V AT.2 - 80 218 COPY & MAILING C - C - GB V GB V GB V GB V AT.2 - 80 | 317 CONFERENCE C - CB V GB V GB V AT-2 - BO 318 CONFERENCE C - C - GB V GB V GB V AT-2 - BO 319 REPONTER C - C - GB V GB V GB V AT-2 - BO | |
| 219 ELECT CONCPI RO GB PS GB PS GB PS GB PS AT2 * * EXPOSED STRUCT. 220 COMMISSIONERS C C GB V GB V GB V GB V AT2 ** **NOTE 2. NOTE 3 | 320 Law CLERK C - C - CB V CB V CB V AT*2 - 8<0 321 CORRIDOR C - C - CB V CB V CB V AT*2 - 8<0 | |
| 221 TOILET 5V - SV - GB V GB V GB V GB V GB P5 80 222 VESTIBULE C - C - GB V GB V GB V GB V AT2 - 80 223 RECEPTION C - G - GB V GB V GB V GB V AT2 - 80 | 323 DETENTION C - C - CB V CB V CB V CB P5 CD 323 DETENTION C - C - CB V CB V CB V CB P5 CD 324 TOILET SV - SV - CB V CB V CB P5 CD 325 ELECTRICAL CONC P-1 RB - CB P5 CB P5 CD | 06 |
| 224 SECRETARY C - C - GB V GB V GB V GB V AT2 - 80 225 CORRIDOR C - C - GB V GB V GB V GB V AT2 - 86 "NOTE I 226 ELECTIONS C - C - GB V GB V GB V GB V AT2 - 80 | 326 W.TNESS C - C - CS V GB V GB V GB V AT2 - 80 327 WITNESS C - C - GB V GB V GB V GB V AT2 - 80 328 CORR.DOR C - C - GB *V GB *V GB *V GB *V AT2 - 80 *NOTE I | |
| 221 BLEV VEST. C C GB *V GB *V GB *V AT2 - 86 *NOTE ! 228 VESTIBULE C C GB *V GB *V GB *V G5 *V AT2 - 80 *NOTE ! 229 JANITON VAT - RD - GB PS CAU P3 COMC P3 GD P5 AT3 - 80 | 529 Cleak of court C CB V CB | えた |
| 230 MEN CT - CT - GB CT GB CT GB CT GB CT AT2 - 90 231 JANITOR CONC PI - GB P5 * - * - * - * - * - * - * NOTE 2 232 VEST BULE C - C - GB *V GB *V GB *V GB *V AT2 - 80 *NOTE 1 | 332 CORRIDOR C - CD *V - - GB P5 AT2 - B 6 *NOTE 1 333 ELEV. VEST C - C - - - BR P4 CB *V AT2 - B 6 *NOTE 1 333 ELEV. VEST C - C - - - BR P4 CB *V AT2 - B 6 *NOTE 1 334 JANITOR VAT - RB - GB P5 GB P5 AT3 - B 0 | |
| 233 WOMEN CT - CT - GB CT GB CT GB CT GB CT AT 2 - 9 0 234 CORRIDOR C - C - GB *V GB *V GB *V - AT 2 - 8 6 *NOTE I | 335 VESTIBULE C C GB V GB V GB V GB V AT2 8 0 NOTE I 336 MEN CT CT GB CT GB CT GB CT GB CT ATC 9 0 | |
| 236 FOYER CT - CT - BR P4 CL/CB-/P5 BR P3 CL/CB-/P5 CB P5 8 6 231 CORR.DON C - C - BR P4 CB *V CB V BR/CB 24/P5 AT2 - 8 6 *NOTE 1 | 338 VESTIBULE C - C - CB *V CB *V CB *V CB *V AT 2 - B 0 *NOTE I 338 WOMEN CT - CT - CB CT CB CT CB CT CB CT AT 2 - 9 0 | |
| 239. ELECTRICAL CONC P.1 CAU P-3 CONC P-3 CONC P-3 CAU P-3 * MOTE 2 240. STORAGE C RB GB P-5 GB P-5 GB P-5 GB P-5 AT2 BO | 340 CORRIDOR C C CB V CB V AT2 8 6 * NOTE 2 341 MECH METZ CONC P3 CONC P3 CONC P3 * P3 7 6 * NOTE 2 341 MECH METZ CONC P3 CONC P3 CONC P3 * P3 7 6 * NOTE 2 342 CORRIDOR C - C - - GB V - - GB V AT2 - * * VARIES | |
| $\begin{array}{c ccccccccccccccccccccccccccccccccccc$ | 343 6TORAGE C RB GB P5 GB P5 GB P GB P.5 7 4 A 5TAIR C C PL V PL V PL PL P5 **VARIAS B STAIR C C PL V PL V PL PL V PL PL PS **VARIAS | |
| | ROOM FINISH SCHEDULE - FOURTH FLOOR | SHERIDAN, |
| TAPER INSUL BACK | RA ROOM FLOOR BASE WALLS CEILING REMARKS | (h) |
| - ROOF DRAIN GRAVEL SURFACE ROOFING MEMBRANE | MAT FIN FT IN | |
| | 40. LIPPER LOBBY GLCB-RS BR P.4 CB P.5 BR P.4 LC P P S S P LC P P S S P LC P P S S P P LC P P S S P P S D P S D P S D P S D P S D P S D P S D P S D P S D <thd< th=""> <thd< th=""> D</thd<></thd<> | |
| | 404 UFFER COURT | () v D m |
| (4" @ VALLEY CLAMP 2 ROOF DRAIN DET | 406 CORRIDOR COUC PI GB P-5 CB P-5 | |
| | 409 ELEV VEST CONC PI CB PS BR P4 CB P5 AT2 - 86 410 VESTIBULE CONC PI - CB P5 CB P5 CB P5 CB P5 AT2 - 80 | |
| ROOFING MEMBRANE STEEL STIFFENER 21'OC. | 411 JANITOR CONC P1 GB P5 GB P5 GB P5 GB P5 CB P5 X *NOTE 2 412 MEN CONC P.I GB GB GB *NOTE 2 413 JANITOR CONC P.I GB P5 * * *NOTE 2 | 5 |
| | 414 VEST.BULE CONC P.1 CB P-5 CB P5 CB P-5 CB P5 AT-2 - 80 415 WOMEN CONC P-1 - CB - | |
| HECH. A SALE OF ARISON | 410 CORRIDOR CONC P-1 GB P-5 CB P-5 GB P-5 AT-2 8 6 417 MECHANICAL CONC P-1 GB P-5 | |
| NOOF DECK | A STAIR C - C - PL V PL V PL V R5 #NOTE 2 3 STAIR C - C - PL V PL V PL V PS #NOTE 2 | |
| ATCH CANT & BASE FLASHING FOR ALT? | A ELEVATOR C ALL OTHER FINISHES BY ELEVATOR MANUE. | og 0 n <u>1</u> 2 |
| | C ELEVATOR C - ALL OTHER FINISHES BY ELEVATOR MANUE D DUMBWAITER - ALL OTHER FINISHES BY ELEVATOR MANUE | |
| | ROOM FINISH SCHEDULE - EXISTING BLDG. | |
| | RM. ROOM FLOOR BASE WALLS CEILING REMARKS | |
| | EIOI | |
| | EiO2 | S. m.s. |
| | | ມີ 🖉 👻 |
| | E201 | |
| | E203 | |
| | LEGEND ABBREVIATIONS & NOTES | |
| | NOTE : SEE ROOM ELEVATION AP ARCHITECTURAL PANEL P PAINT (SEE SECTION 0190) NOTE 2 EXPOSED STRUCTURE AT ACOUSTIC TILE (SEE PL PLASTER | |
| | NOTE 2 EXPOSED STRUCTURE AT ACOUSTIC THE (SEE PL PLASER NOTE 3 SEE REFLECTED CEILING PLAN SECTION OPSI FOR TYPE) RB RESILIENT BASE (BASE FOR (ANY GB WPS) BR BRICK CARPET NIC NOTE 4 FUTURE FINISHES-NIC CAU CONCRETE MASONRY UNIT SY SHEET VINYL | |
| | NOTE & AS REQUIRED TO PATCH C CARPET - NILC. V VINYL WALL COVERING NOTE & CEILING HEIGHTS ARE NOMINAL - CONC. CONCRETE (INCLUDES PO WALL PREP) | |
| | SEE REFLECTED CEILING PLAN FOR SPECIFIC CEILING HEIGHTS IN SELECTED AREAS GB GYPSUM BOARD GL GLAGS | |
| NORTH | LC LUMINOUS CEILING | |
| | | |


| DOOR & HARDWARE SCHEDL | | DOOR & HARDWARE SCHED | ULE - SECOND FLOOR |
|--|--|---|--|
| OR DOORS FRAMES UL REMARKS SIZE DETAIL NO LABEL W H TH TYPE ELEV FIN. MAT ELEV FIN. HEAD JAMO SILL | DOOR LOCK PUSH BUTTS KICK STOPS WEATH THRESKLOSER WISC. REMARKS | DOOR DOORS FRAMES UL REMARKS | DOOR LOCK PUSH BUTTS RICK STOPS WEATH THRES CLOSEN MISC. REMARKS NO. PULL PLATE STRIP HOLD |
| | IOLA L-1 * * ONE SAN * * | 205 5 3° 1° 14 5.C F PIOHM. 122 P1 133 1/33 | $\begin{array}{c ccccccccccccccccccccccccccccccccccc$ |
| | 103 L-3 - B-1 - S-1 - C-3 - 105A L-3 - B-2 - * - C-2 - *BY ELECTRICAL 105B L-3 - B-2 - * - C-2 - *BY ELECTRICAL 106 L-4 - B-1 - S-1 - C-2 - *BY ELECTRICAL 101* * * *ALL HOWR. BY DR. MANU 108* * * - * - * - * * * * ALL HOWR. BY DR. MANU | | $\begin{array}{c ccccccccccccccccccccccccccccccccccc$ |
| | 108* *All HOWR BY CR. MANUE 110A L-2 84 * * BY ELECTRICAL 110B L-2 84 * C-1 * BY ELECTRICAL 110B L-2 84 * C-1 * BY ELECTRICAL 111 L-3 B-4 * C-3 112 A L-2 B-4 * C-1 * BY ELECTRICAL 112 A L-2 B-4 * C-1 * BY ELECTRICAL 112 B L-2 B-4 * C-1 * BY ELECTRICAL 112 B L-2 B-4 * C-1 * BY ELECTRICAL | | $\begin{array}{c ccccccccccccccccccccccccccccccccccc$ |
| $ \begin{array}{c ccccccccccccccccccccccccccccccccccc$ | $\begin{array}{c ccccccccccccccccccccccccccccccccccc$ | $\begin{array}{c ccccccccccccccccccccccccccccccccccc$ | $\begin{array}{c ccccccccccccccccccccccccccccccccccc$ |
| | $\begin{array}{c ccccccccccccccccccccccccccccccccccc$ | | ZI9 L3 B-1 S-1 C5 C5 Z20 L-8 P1* B-1 S-1 C-1* M-2 *FOR PAIR_OF DOORS Z21 L-9 B-1 S-1 - |
| | | $\begin{array}{c ccccccccccccccccccccccccccccccccccc$ | $\begin{array}{c ccccccccccccccccccccccccccccccccccc$ |
| DOOR & HARDWARE SCHEDL | | 237 3° 1° 1% 5.C. N P.10 H.M. 15/22 P.1 4/35 4/35 | $\begin{array}{c ccccccccccccccccccccccccccccccccccc$ |
| DOORS FRAMES UL REMARK | DOOR LOCK PUSH BUTTS KICK STOPS WEATH THRESCLOSER MISC. REMARKS | DOOR DOORS FRAMES UL REMARKS S: ZE W T TH TYPE ELEV FIN. MAT ELEV FIN. HEAD JAMB SILL | DOOR LOCK PUSH BUTTS KICK STOPS WEATH THRES CLOSER MISC. REMARKS |
| | 305 B L · · · · · · · · · · · · · · · · · · | $\begin{array}{c ccccccccccccccccccccccccccccccccccc$ | $\begin{array}{c ccccccccccccccccccccccccccccccccccc$ |
| $\begin{array}{c ccccccccccccccccccccccccccccccccccc$ | 3080 L-3 - B3 - B1 C1 | 414 3° 7° 1% S.C. N P-10 H.M. V22 P-7 V33 V35 - 16 HR | $\begin{array}{c ccccccccccccccccccccccccccccccccccc$ |
| $\begin{array}{c ccccccccccccccccccccccccccccccccccc$ | | ┫╞╾╾┸╾┶╌╵╹╍╌┷╴╶╹┓╹╴╸┝╴╶╴╽╴╴┃╴╴╹╹╴╴╹╴╴╹╴╴╴╴╴╴╴╴╴╴╴╴ | 413 A L-1 * - C-1 * * - * BY ALUM. DOOR MANUE. 412.3 - * - 5.2 * - * BY ALUM. DOOR MANUE. |
| $\begin{array}{c ccccccccccccccccccccccccccccccccccc$ | $\begin{array}{c ccccccccccccccccccccccccccccccccccc$ | HARDWARE LEGEND LOCKS: SCHLAGE - US 10B: PLANET, 5' BACKSET HI 20-001 HI DITO MI DIS BN 1 305 BR | |
| $ \begin{array}{c c c c c c c c c c c c c c c c c c c $ | Bit A L-3 B-1 S-1 M-4 Bit B L-3 B-3 S-1 Bit B L-3 B-3 S-1 Bit B B-1 S-1 M-5 Bit L-3 B-1 S-1 M-5 Bit L-3 B-1 S-1 M-5 Bit L-3 B-1 S-1 M-5 Bit L-3 B-1 S-1 PAIR OF CYLINDERS Bit L-3 B-1 S-1 C-2 PAIR OF CYLINDERS Bit L-3 B-1 S-1 C-2 PAIR OF CYLINDERS Bit L-3 B-1 S-1 C-2 Bit L-3 B-1 S-1 C-2 Bit L-3 | L1 20-001 L1. D100 MAL. BISBN # BOSBR L2. 99 TP W SCHLAGE CYL. L8. BIGOP THRESHOLD: PEARO VON DUPRIN L9. D40 S THRESHOLD: PEARO L3. D53PD L9. D40 S THRESHOLD: PEARO L4. D66PD B00 B321 TP × 248 L4 W T-1. 10 A L4. D66PD Schlage CYL. VON DUPRIN MISCELLAHEOUS L5. 99 NL W/SCHLAGE CYL. L1. B33T TP × 248 L-4 W MISCELLAHEOUS VON DUPRIN SCHLAGE CYL. VON DUPRIN M-1. 454 USIOB IVES | W-2. 315 BN 305 BN 4 505 BR |
| $\begin{array}{c ccccccccccccccccccccccccccccccccccc$ | $\begin{array}{c ccccccccccccccccccccccccccccccccccc$ | L6. D.05 M-2. 256 USIOB IVES BUTTS: STANLEY-USIOB; (SOSS & LAWRENCE EQUAL) M-3. 456 USIOB IVES B-1. FBB 179 B-3 FBB 179 NRP B-2. FBB 168 B-4 FBB 166 NRP CLOSERS: NORTON-STAT: (LCN EQUAL) | -Δ <u>ς</u> ε |
| | <u>343 — Wood — — — — — — — — — — — — — — — — — — </u> | C-1. 8501 PARALLEL ARM C-4 850: H PARALLEL ARM C-2. 8501 C-5 1603 C-3. 91603 C-6 91602 <u>STOPS:</u> QUALITY-US OB; (BBW & GLYNN JOHNSON EQUAL) S-1. 302 TB S-2. 3025 S-3. HEES S-4. HEES | |
| | | <u>KJCKPLATES</u> : QUALITY-USIOB; (DBW EQUAL) K-I. *48 <u>PUSH-PULLS</u> : QUALITY-USIOB; (BBW EQUAL) PJ. 4302-1 3%*+15* | |
| F N FG-1 FG-2 | · | | |

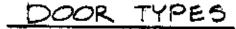



<u>k</u>ara kata k




.

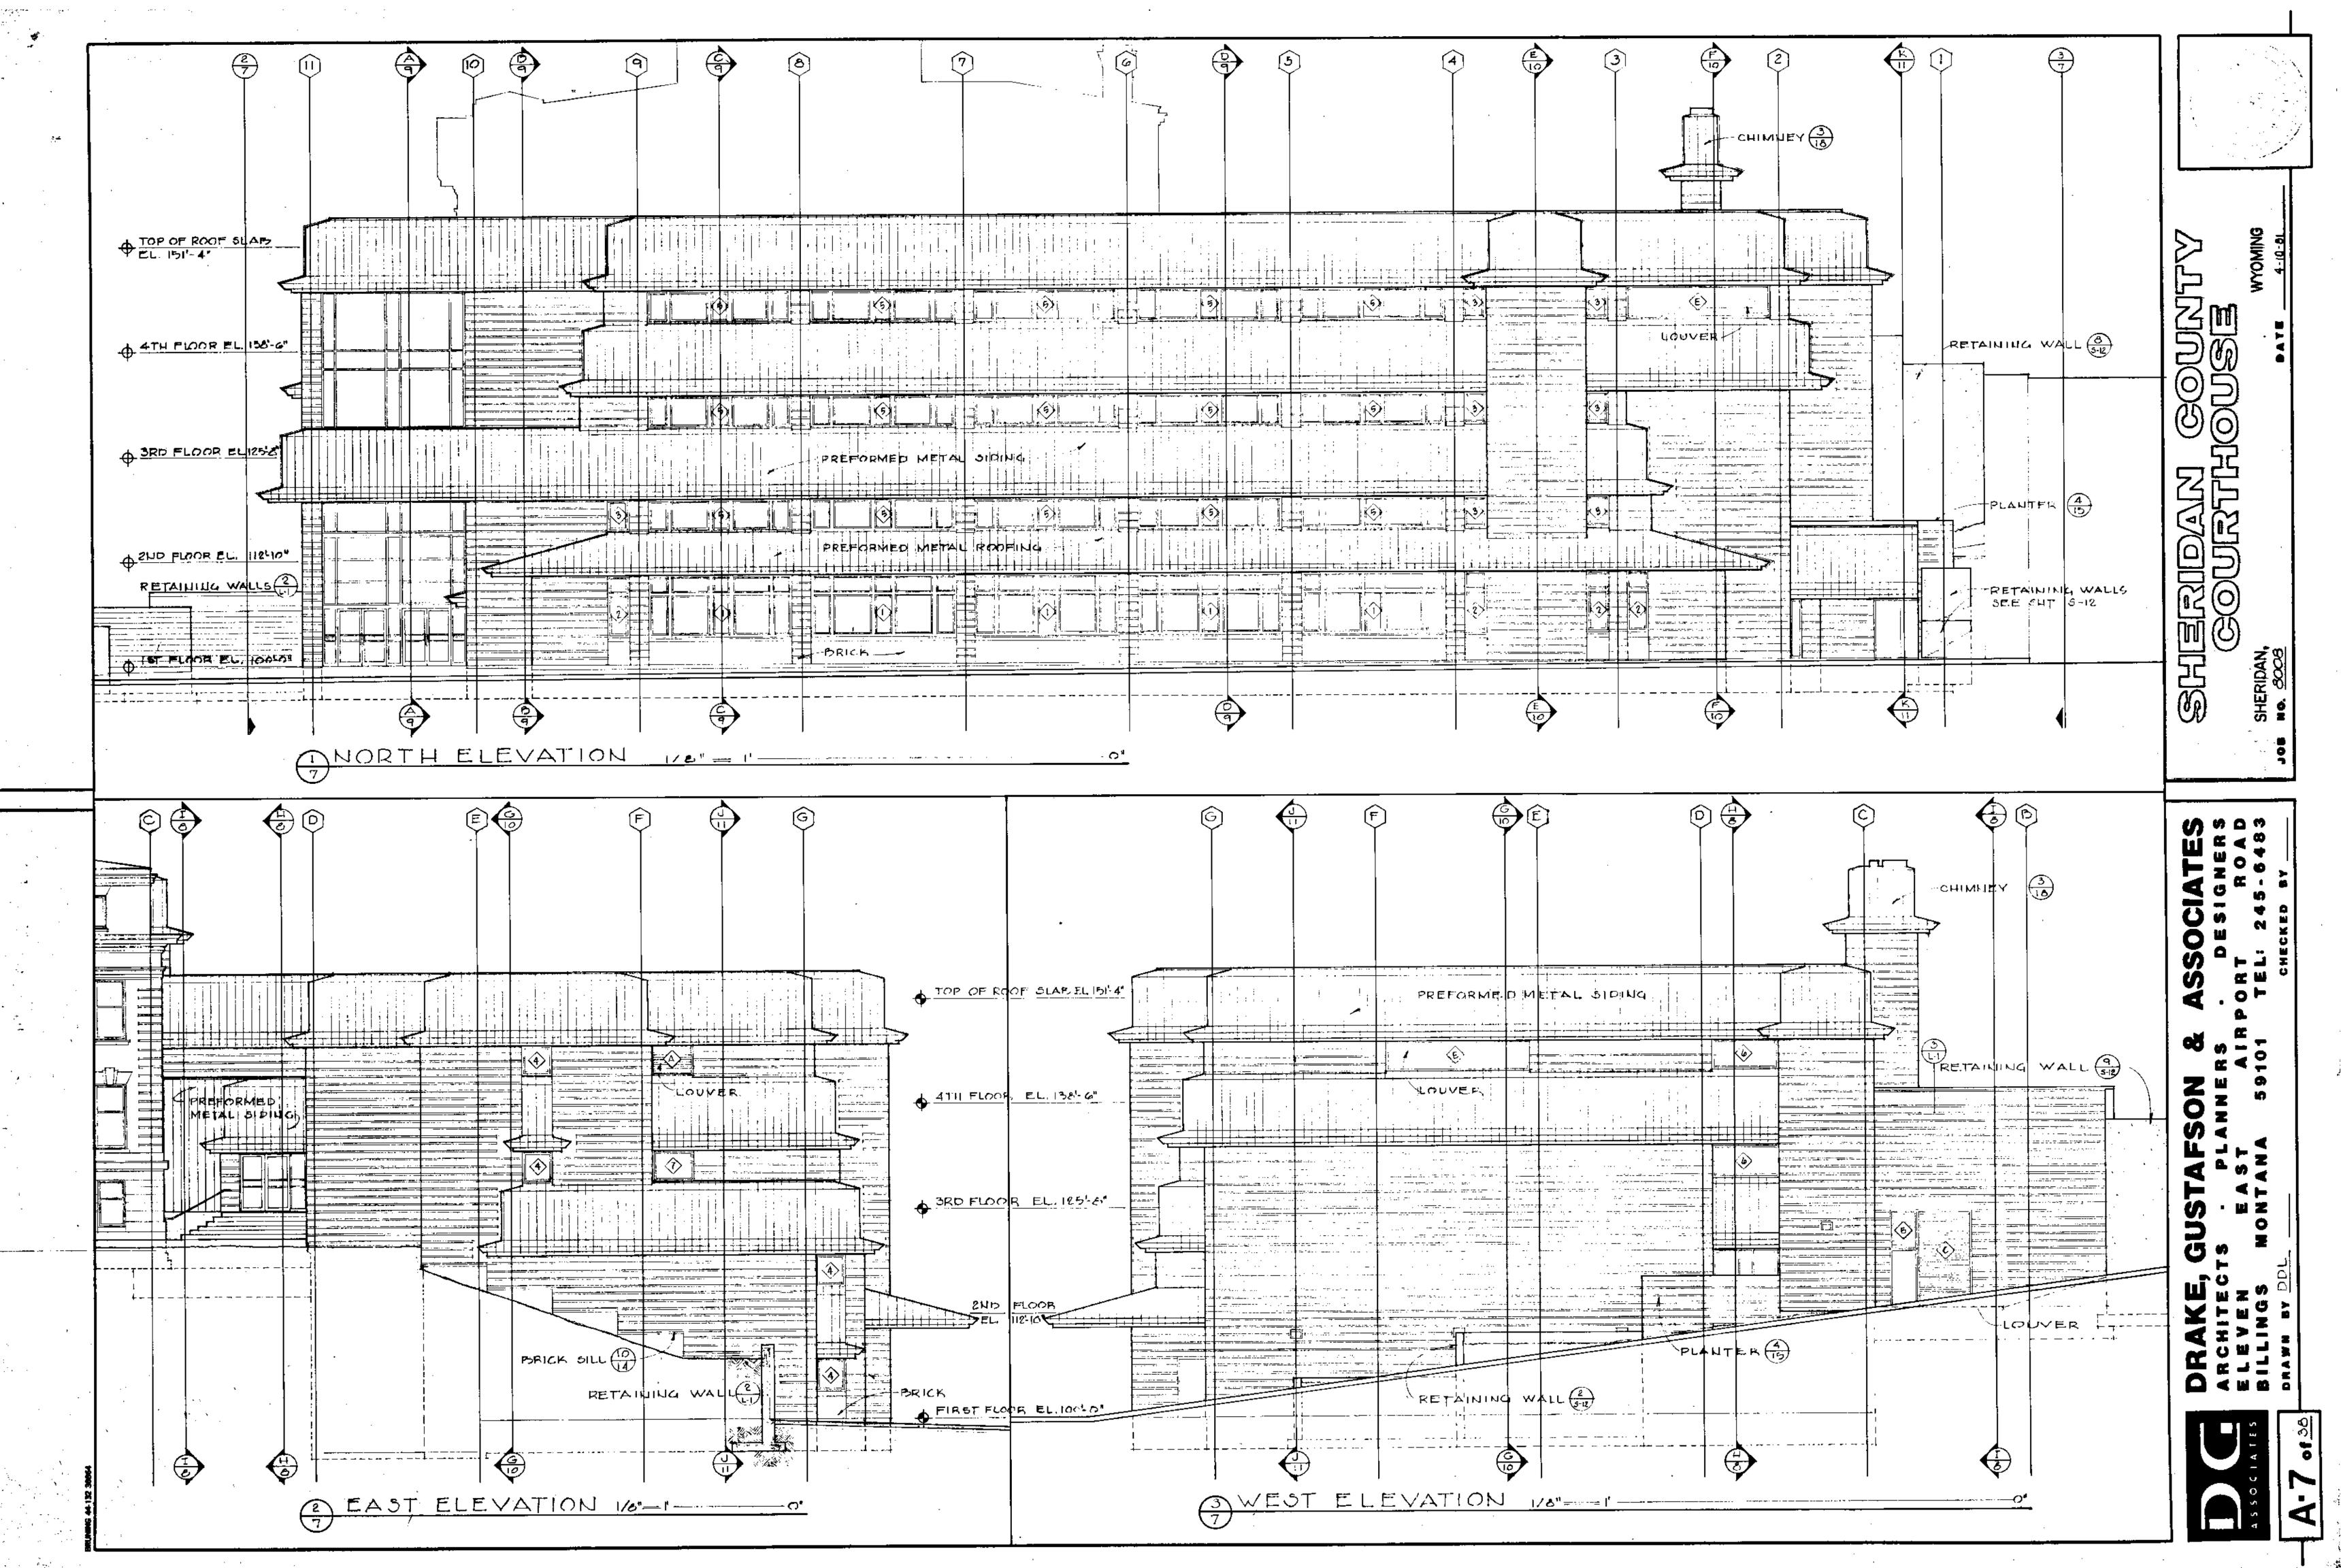

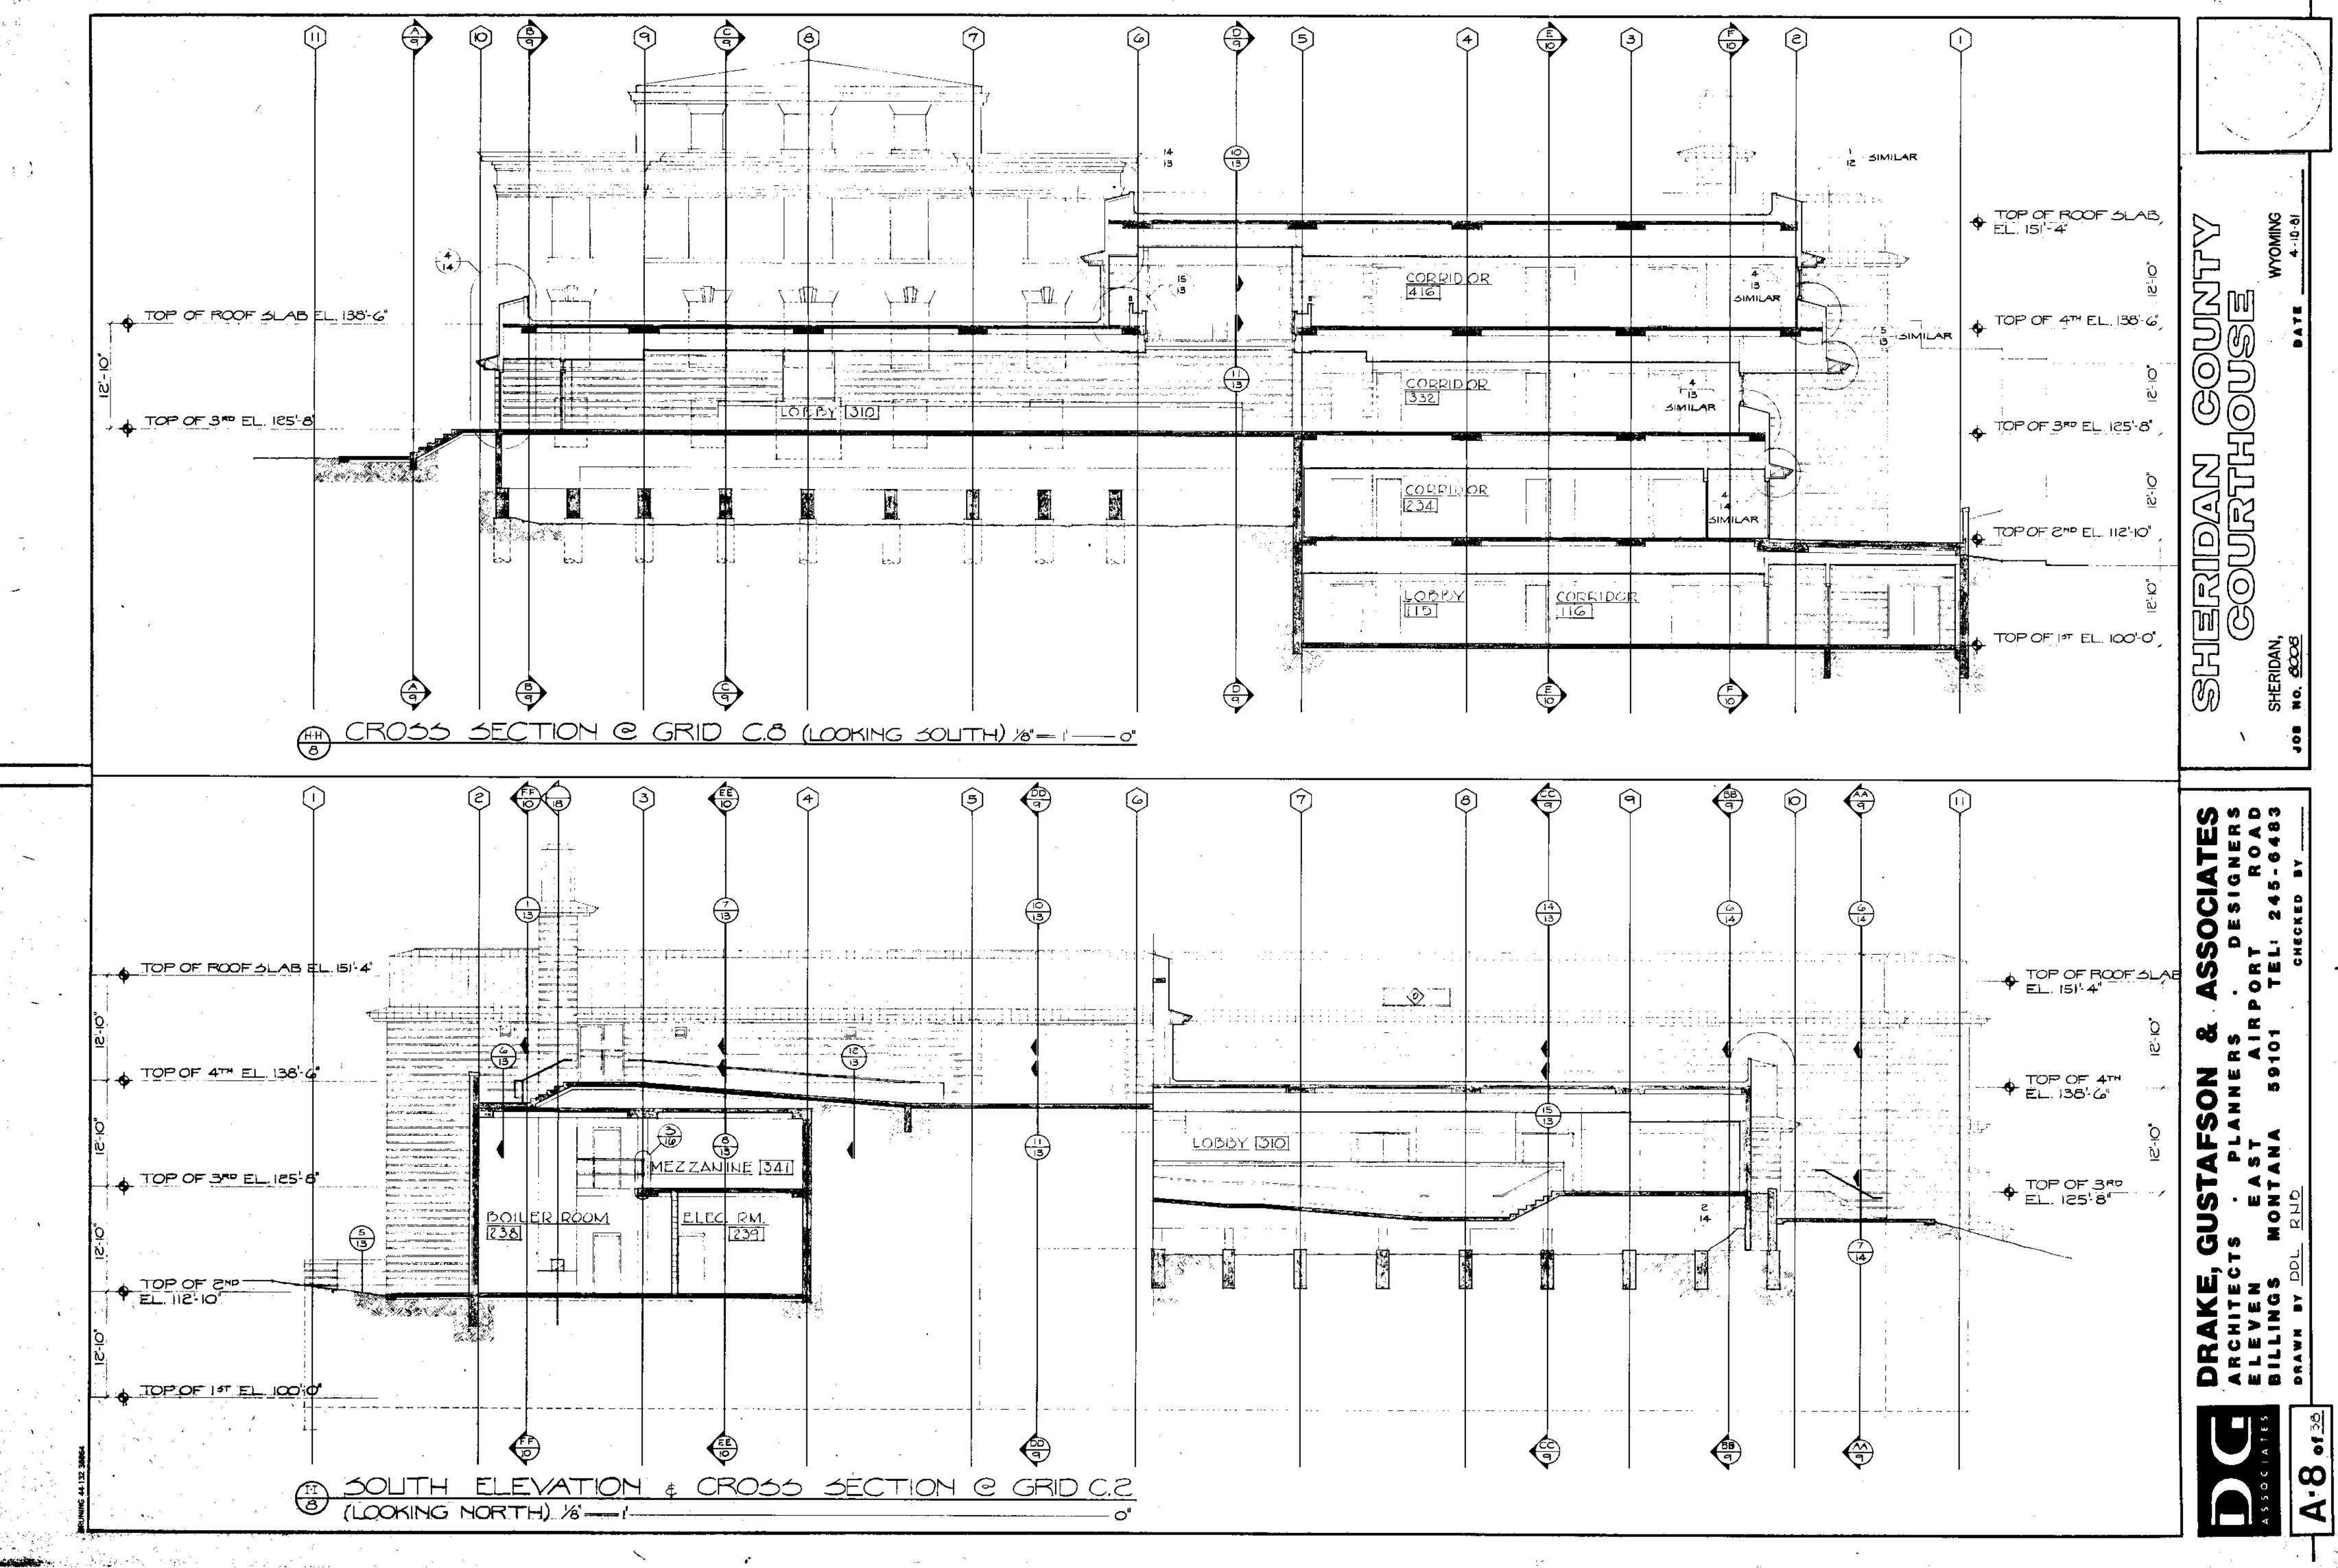


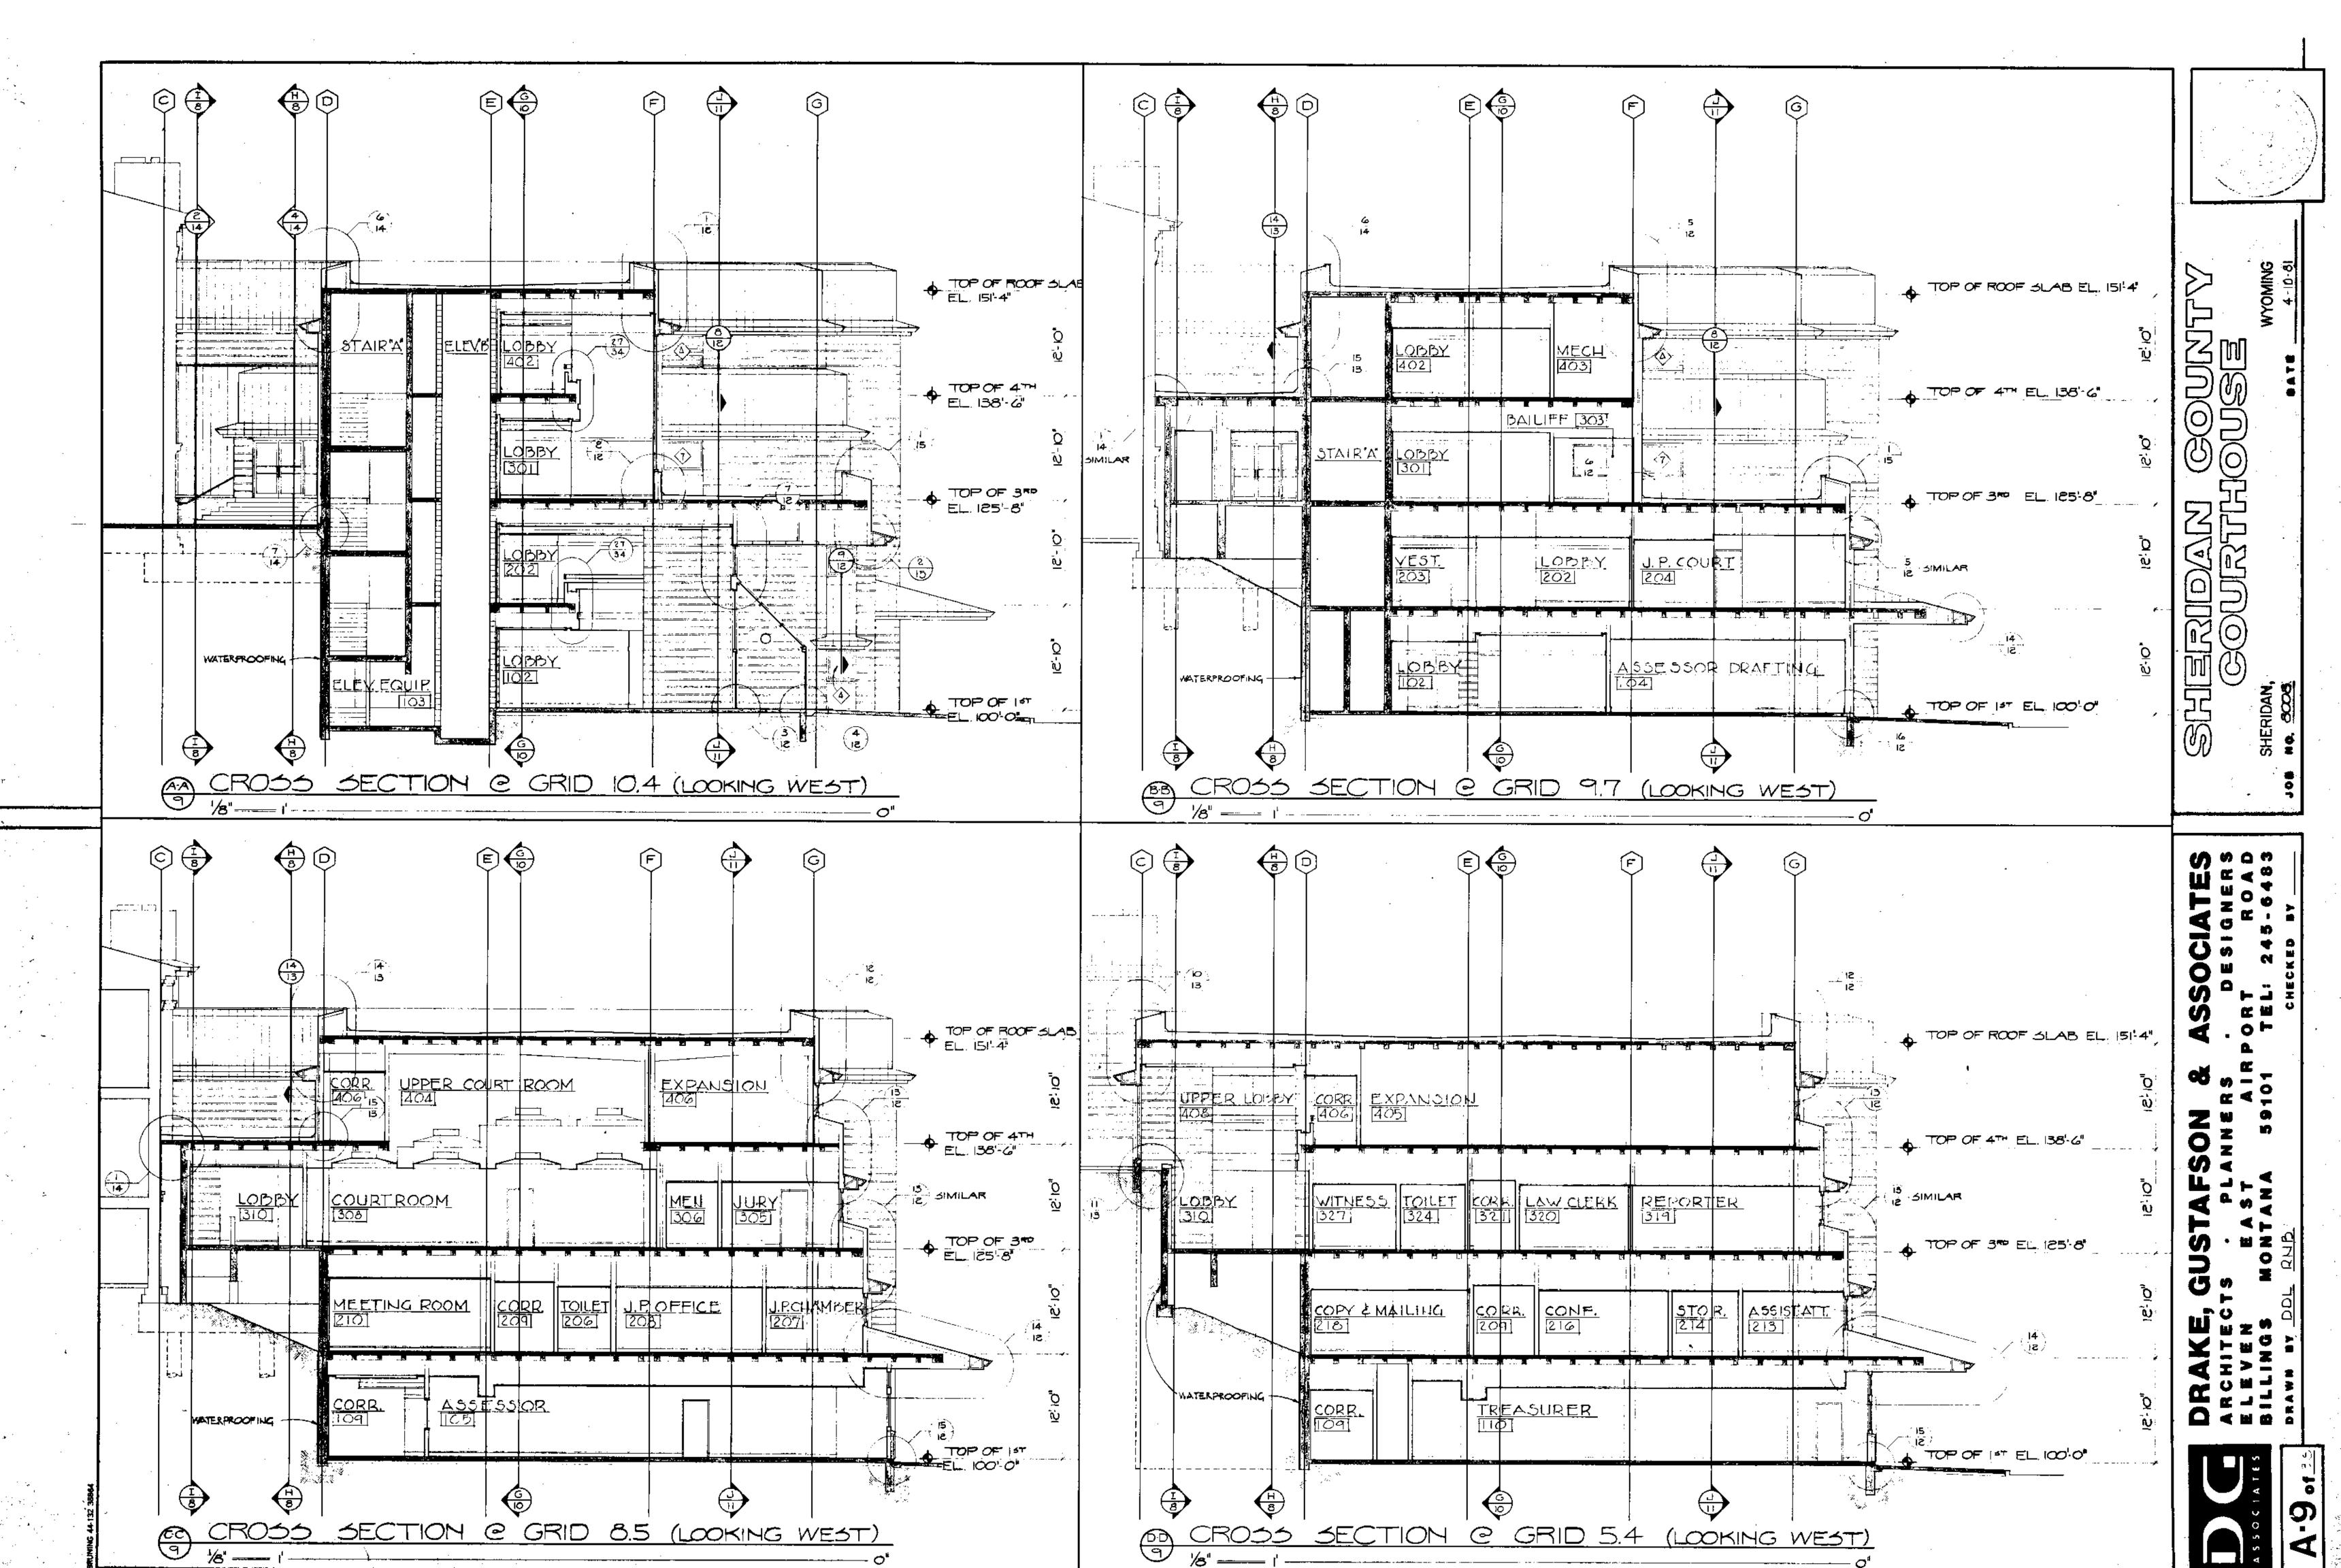

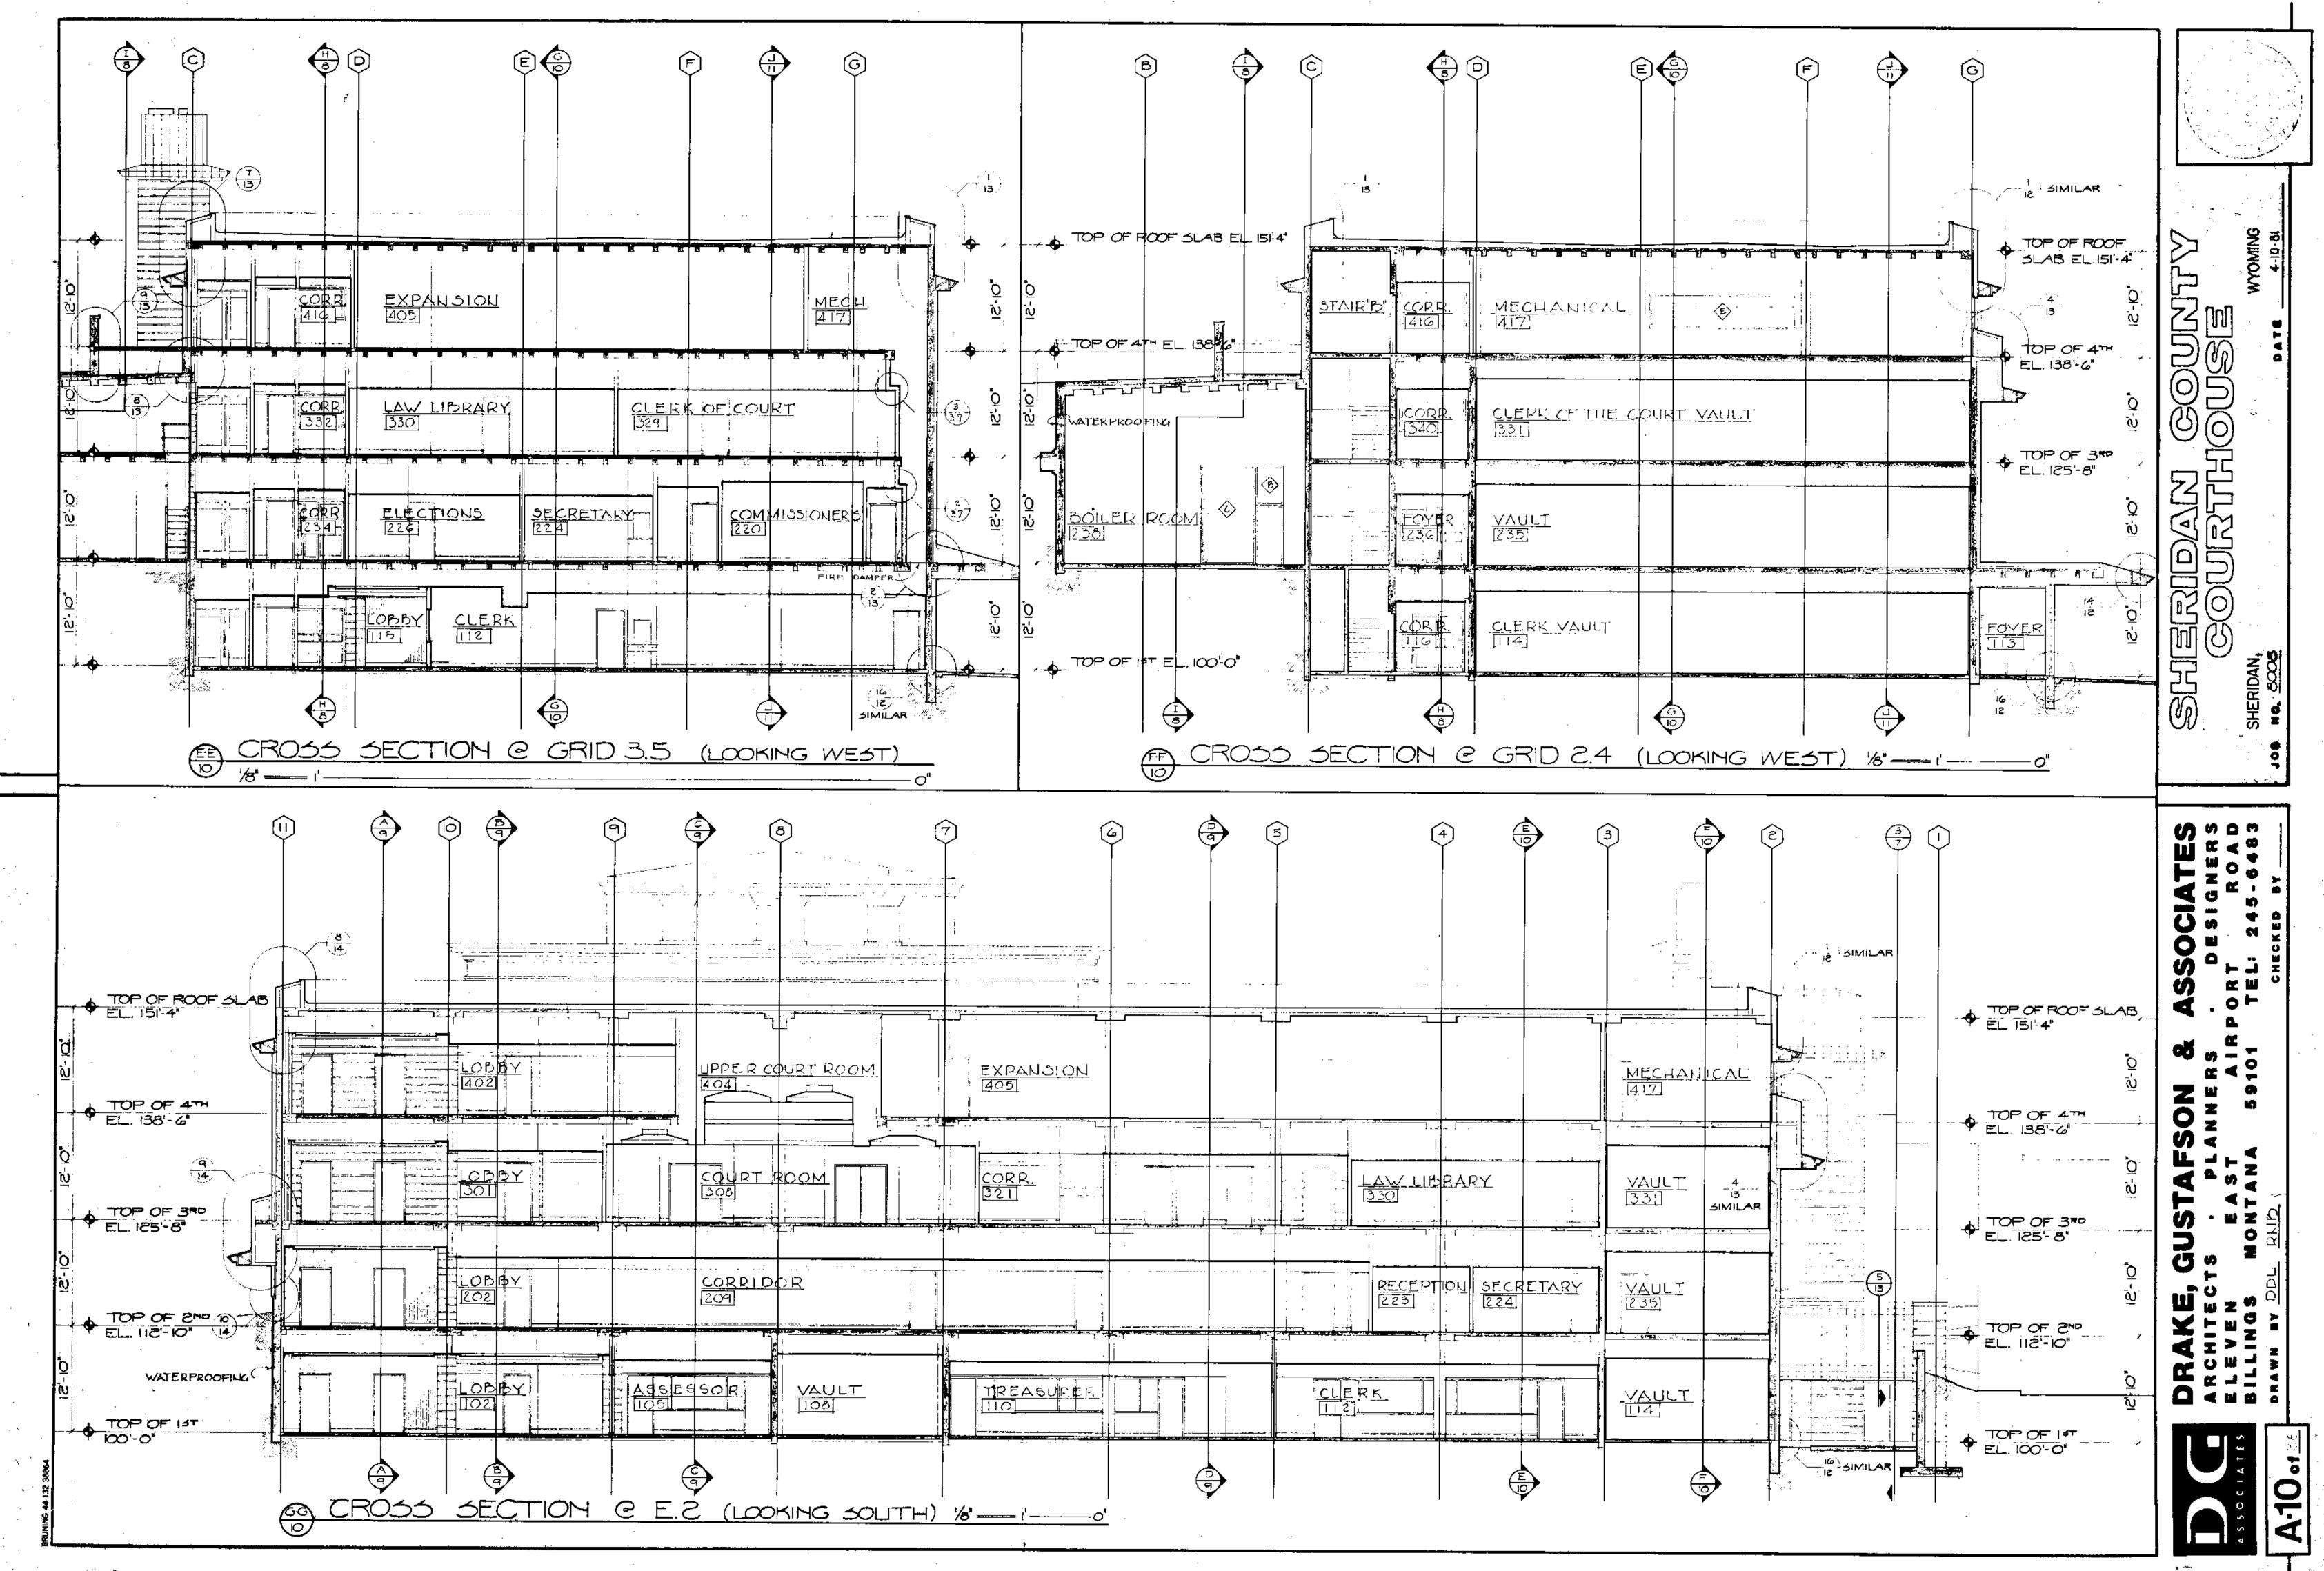



and the second second


N

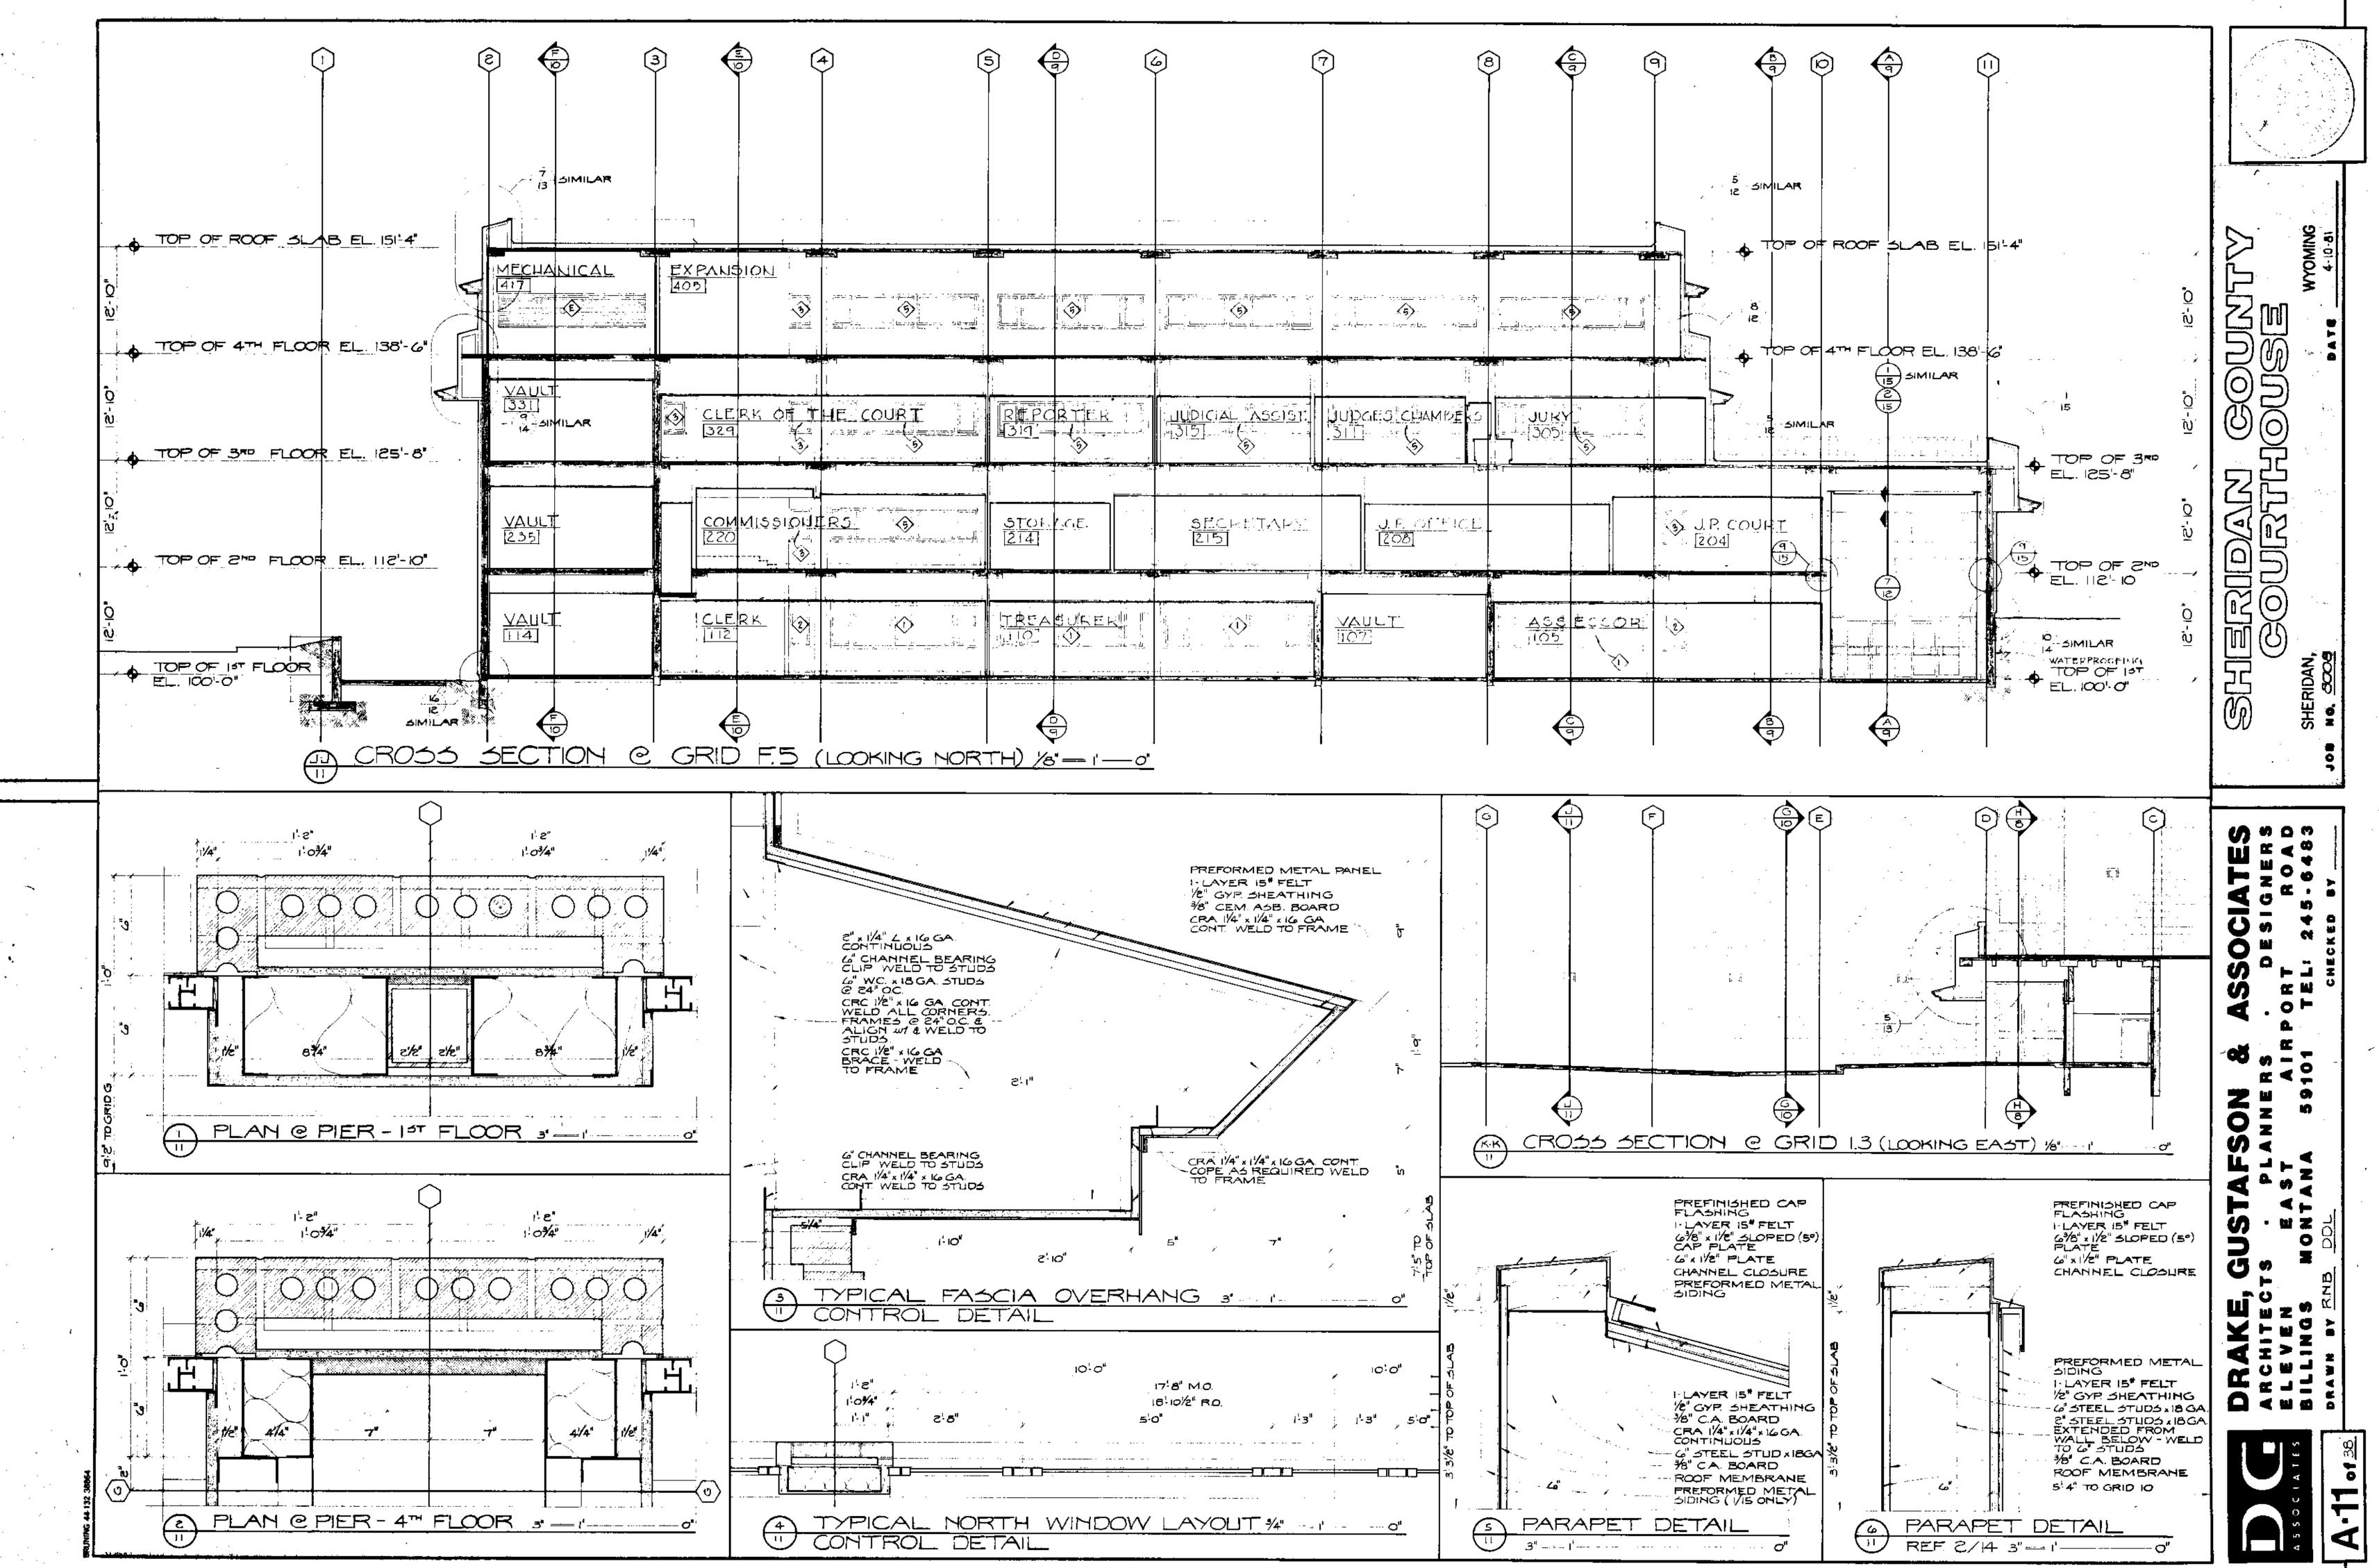


| € | 5 | | 7) (8 | | ٩) |
|--|---------------------------|---------------------------|---------------------------------------|----------------------------------|--------|
| | | | | | T. |
| | | | | | |
| | REPORTER | | | | |
| ALE AN AND AND AND AND AND AND AND AND AND | | - <u>315</u> | <u>3 </u> | JUKY | |
| | <u>STOL</u> [214] | <u>SECHUTAPS</u> [215] | <u>J. F. OF FICE</u> [<u>208]</u> | | |
| | TREASUKER | | <u>VAULT'</u> 107 | 1 : <u>AS€</u> €CCOR 105 1 | - - |
| LOOKING NOR | ТН) <u>/</u> в' — I' — о' | | | | |

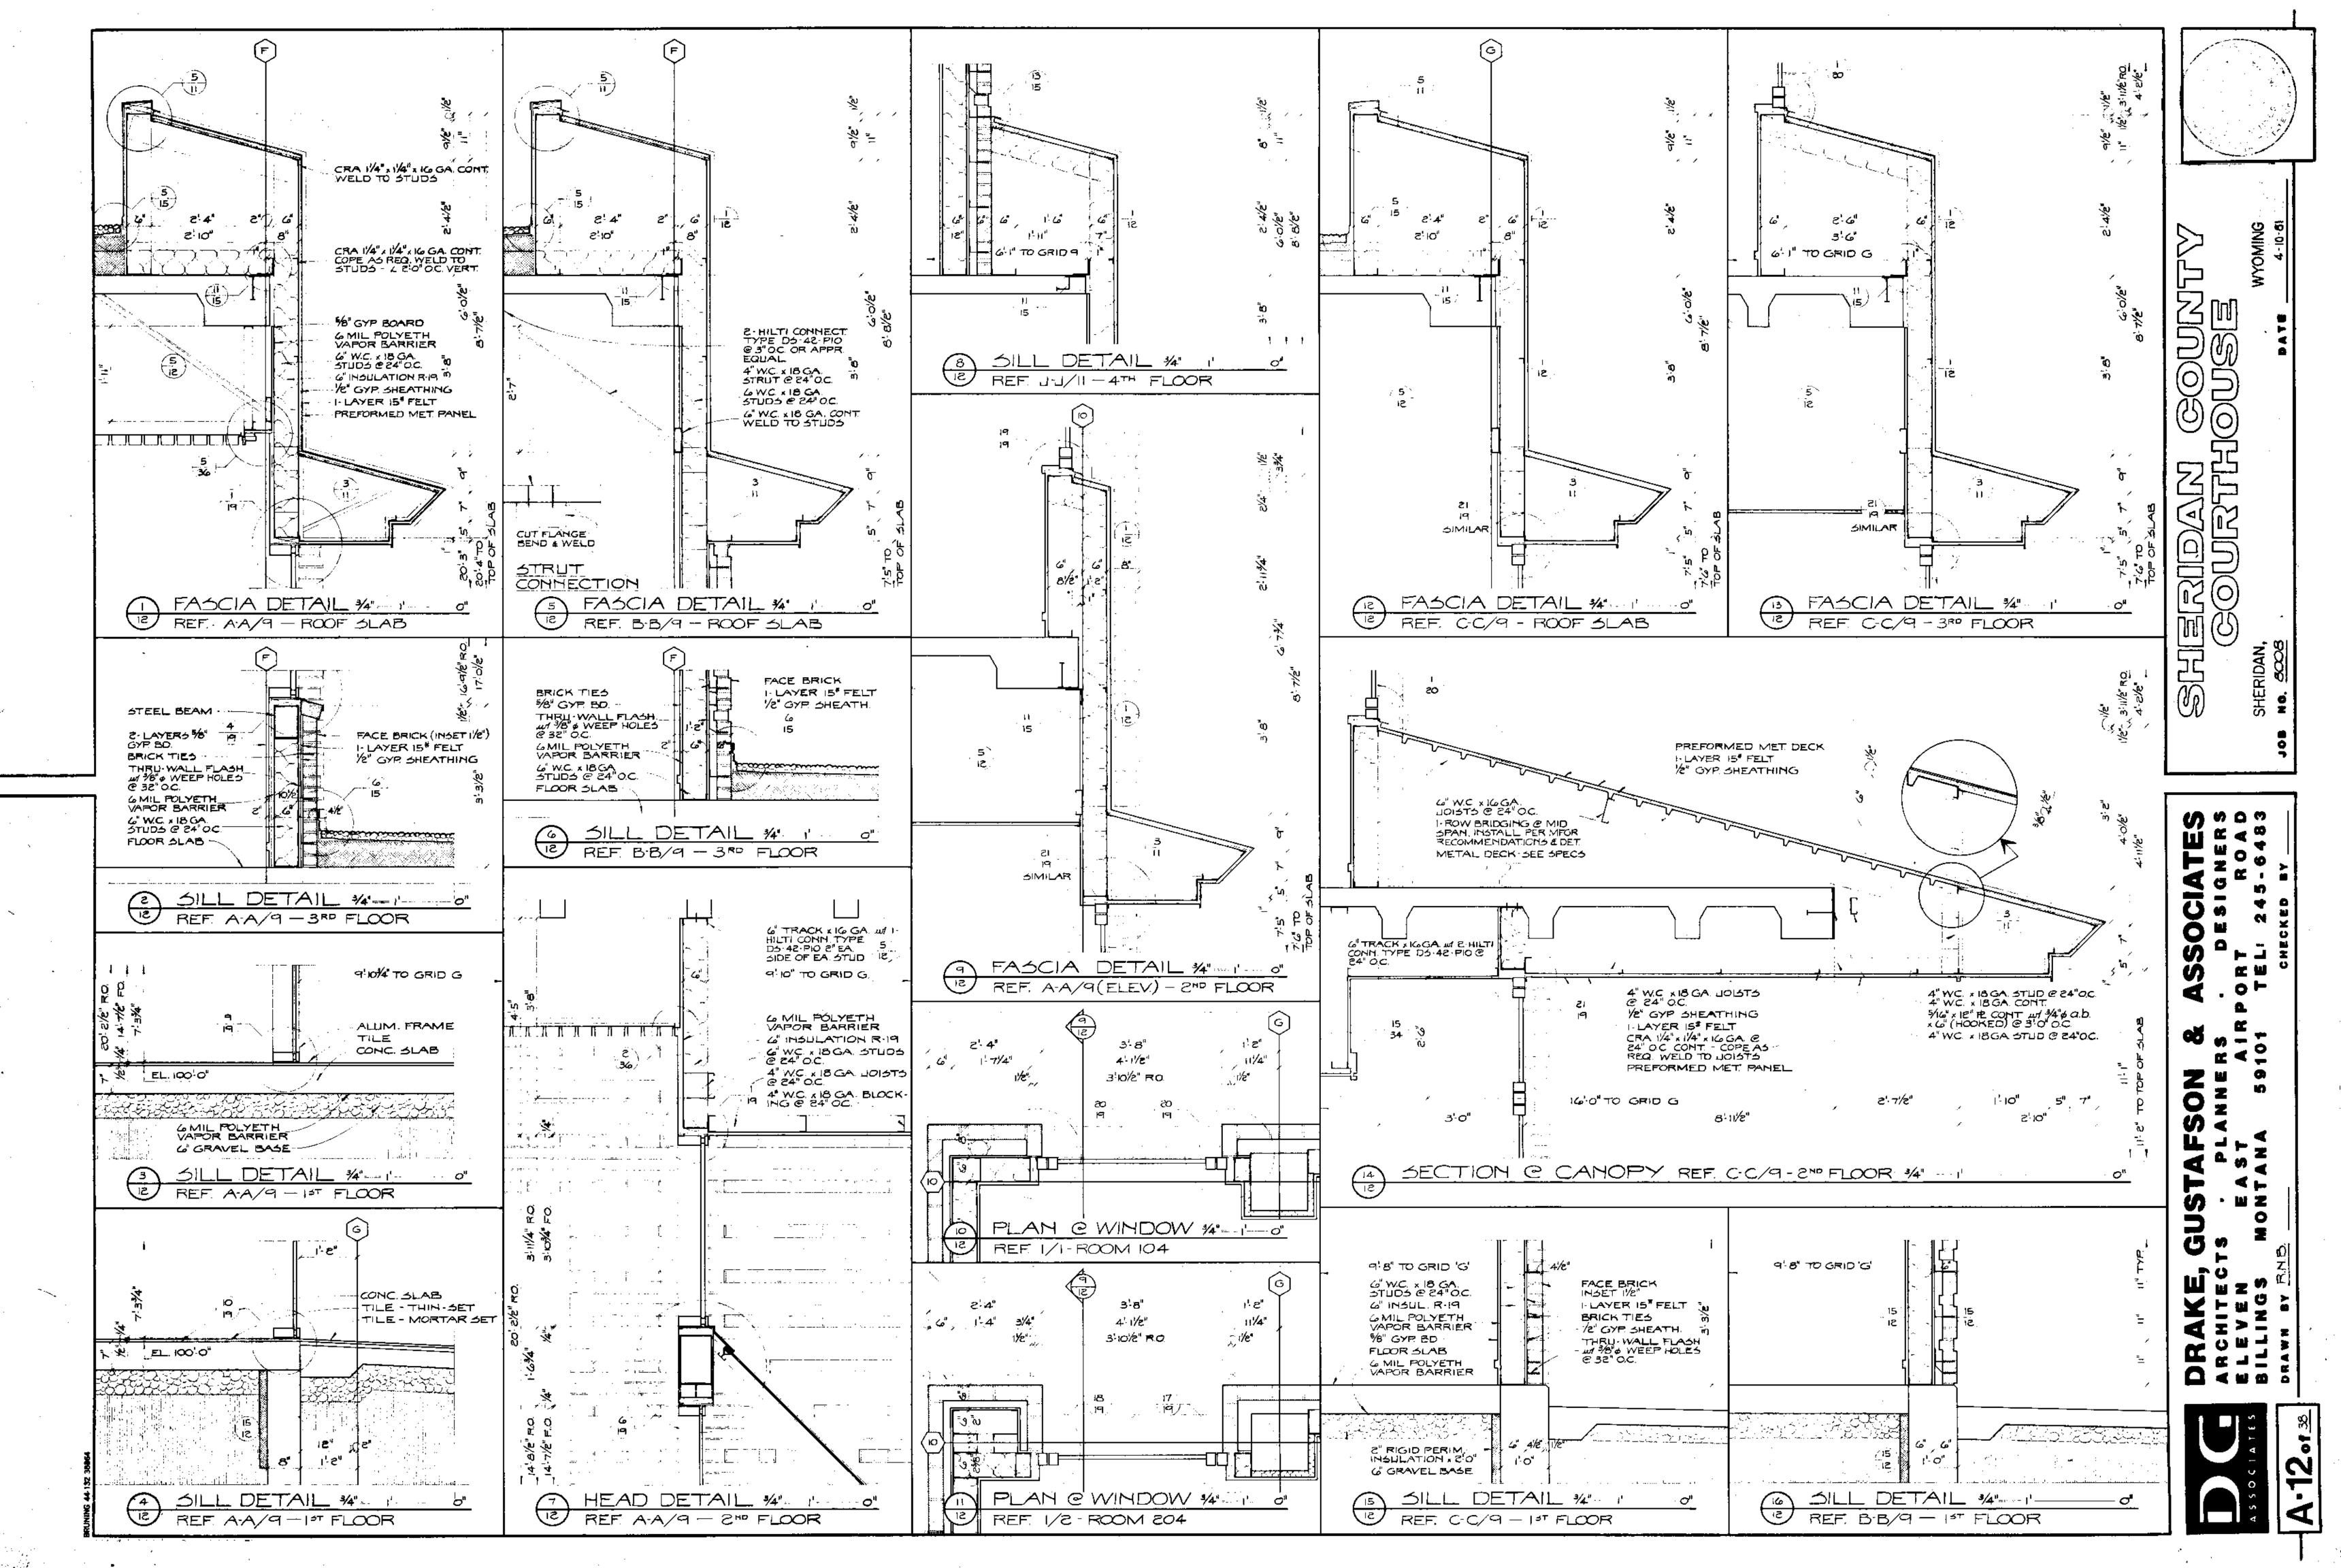


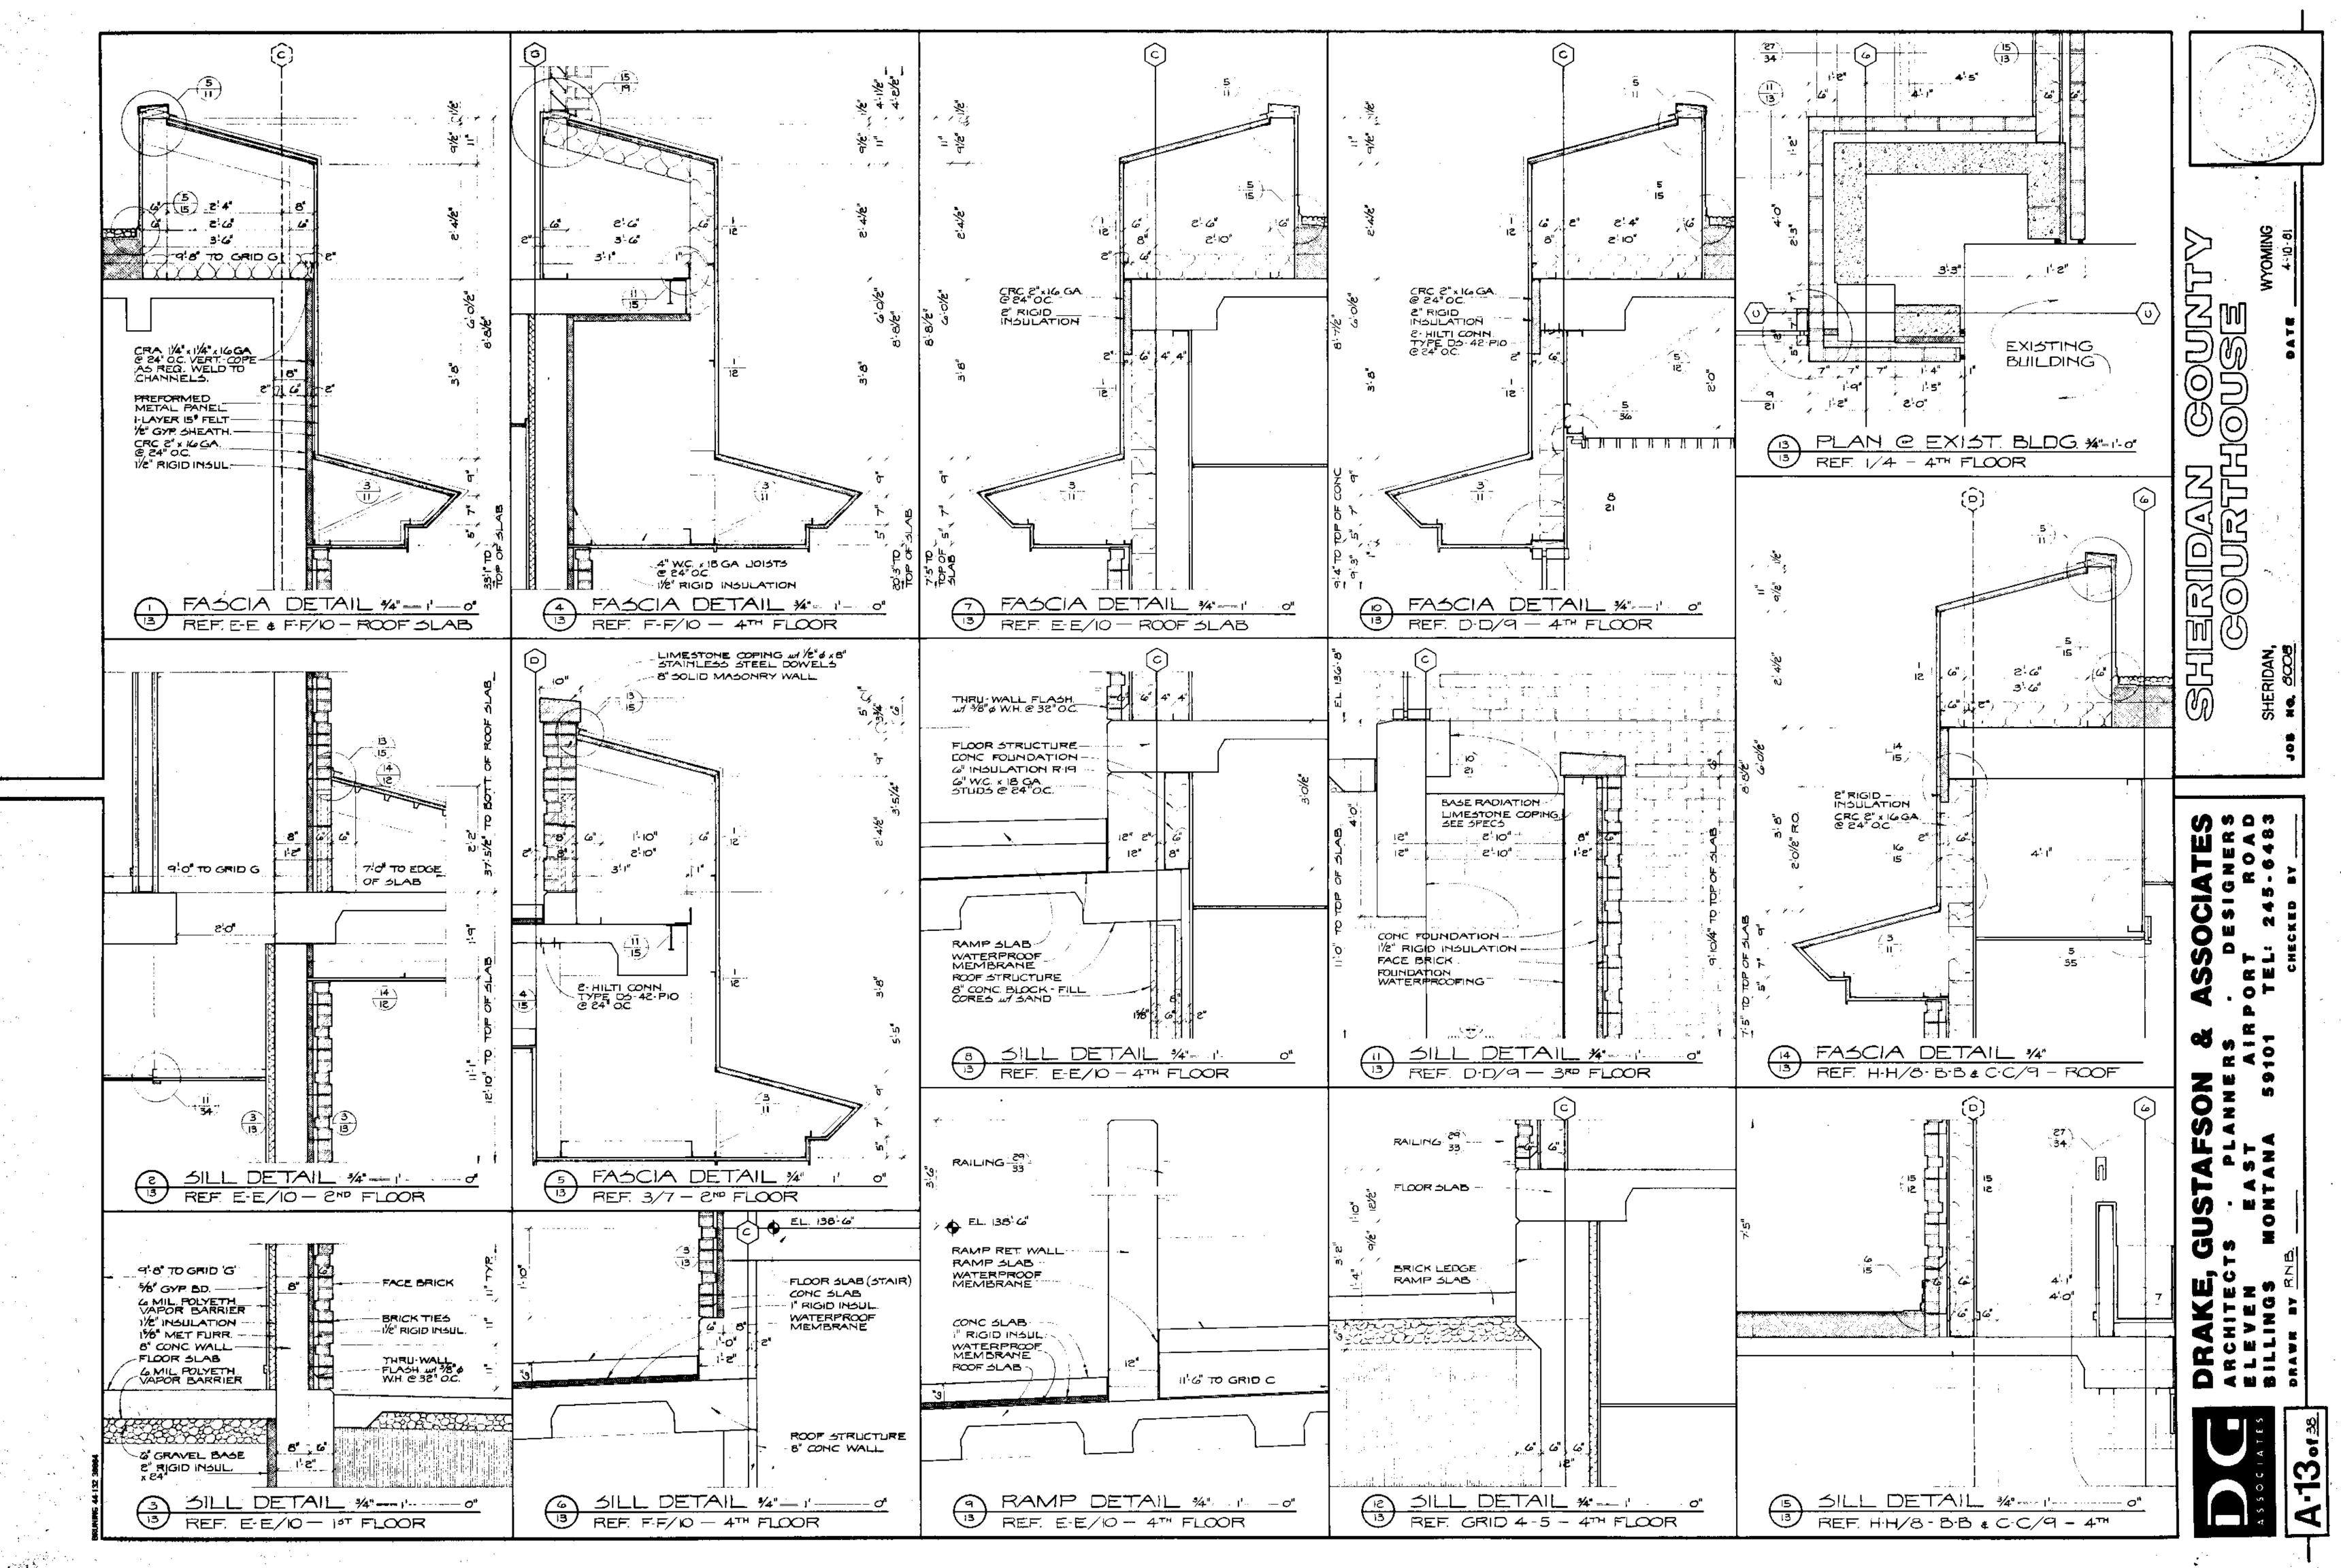


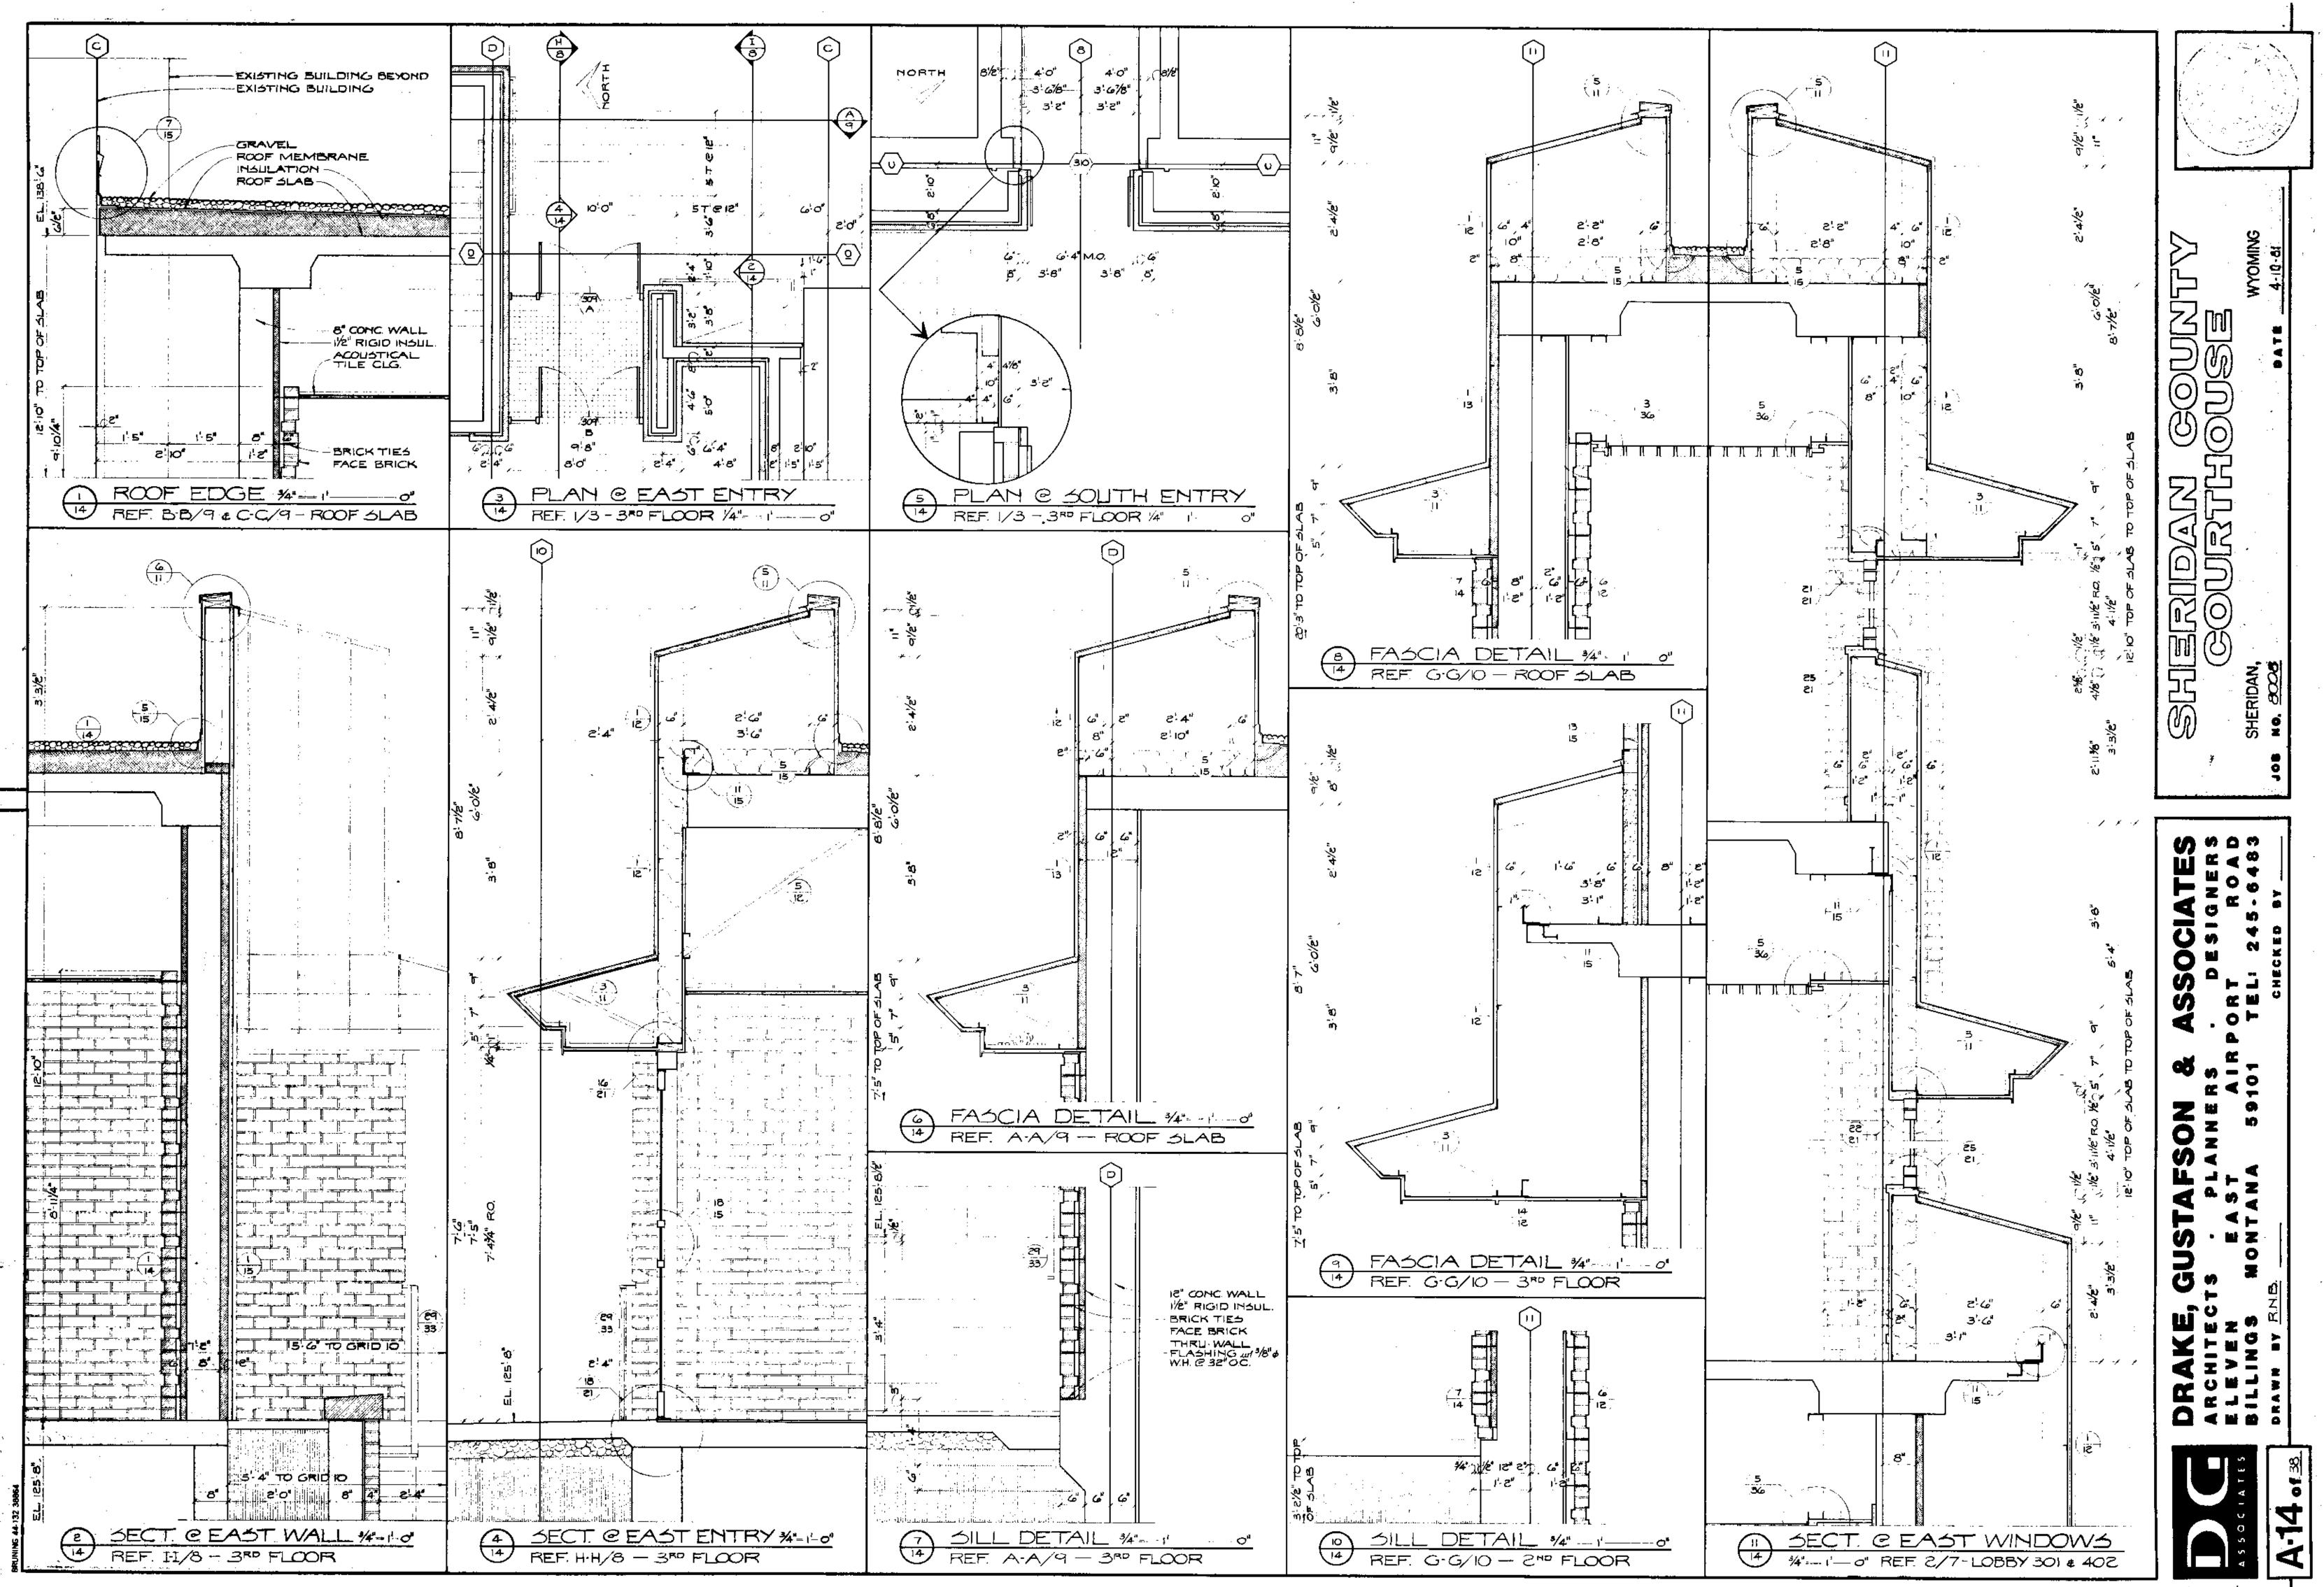


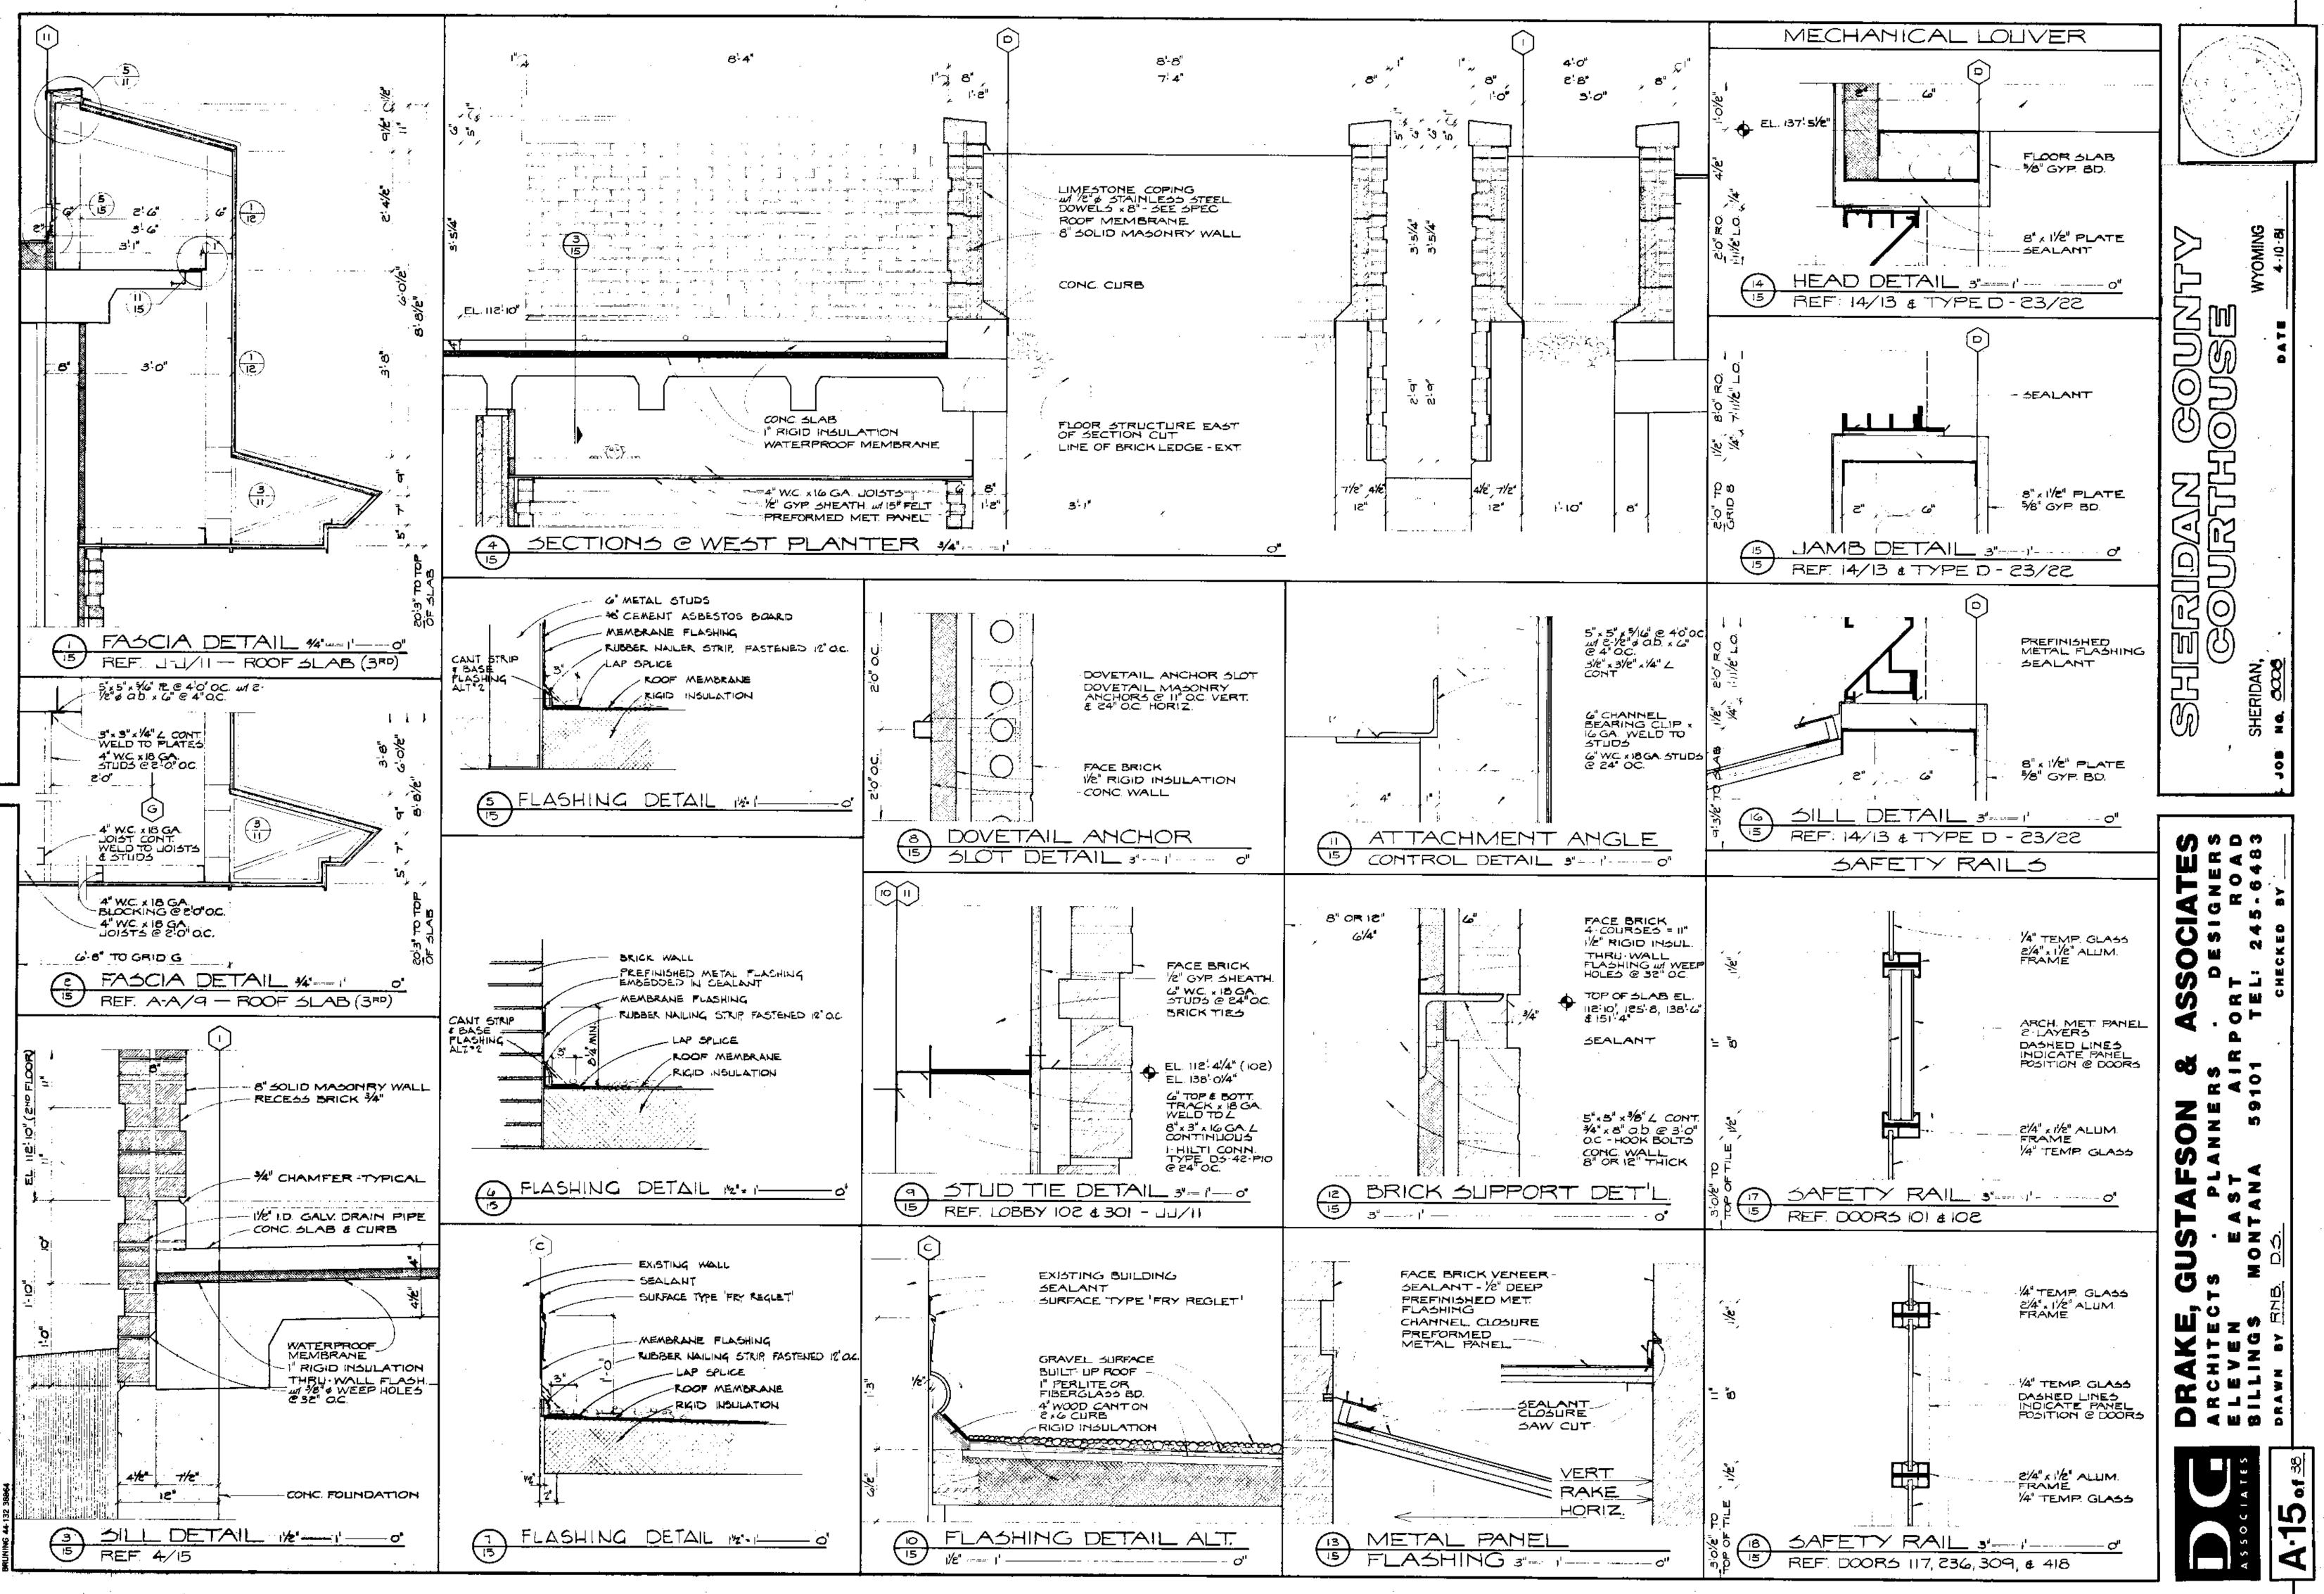





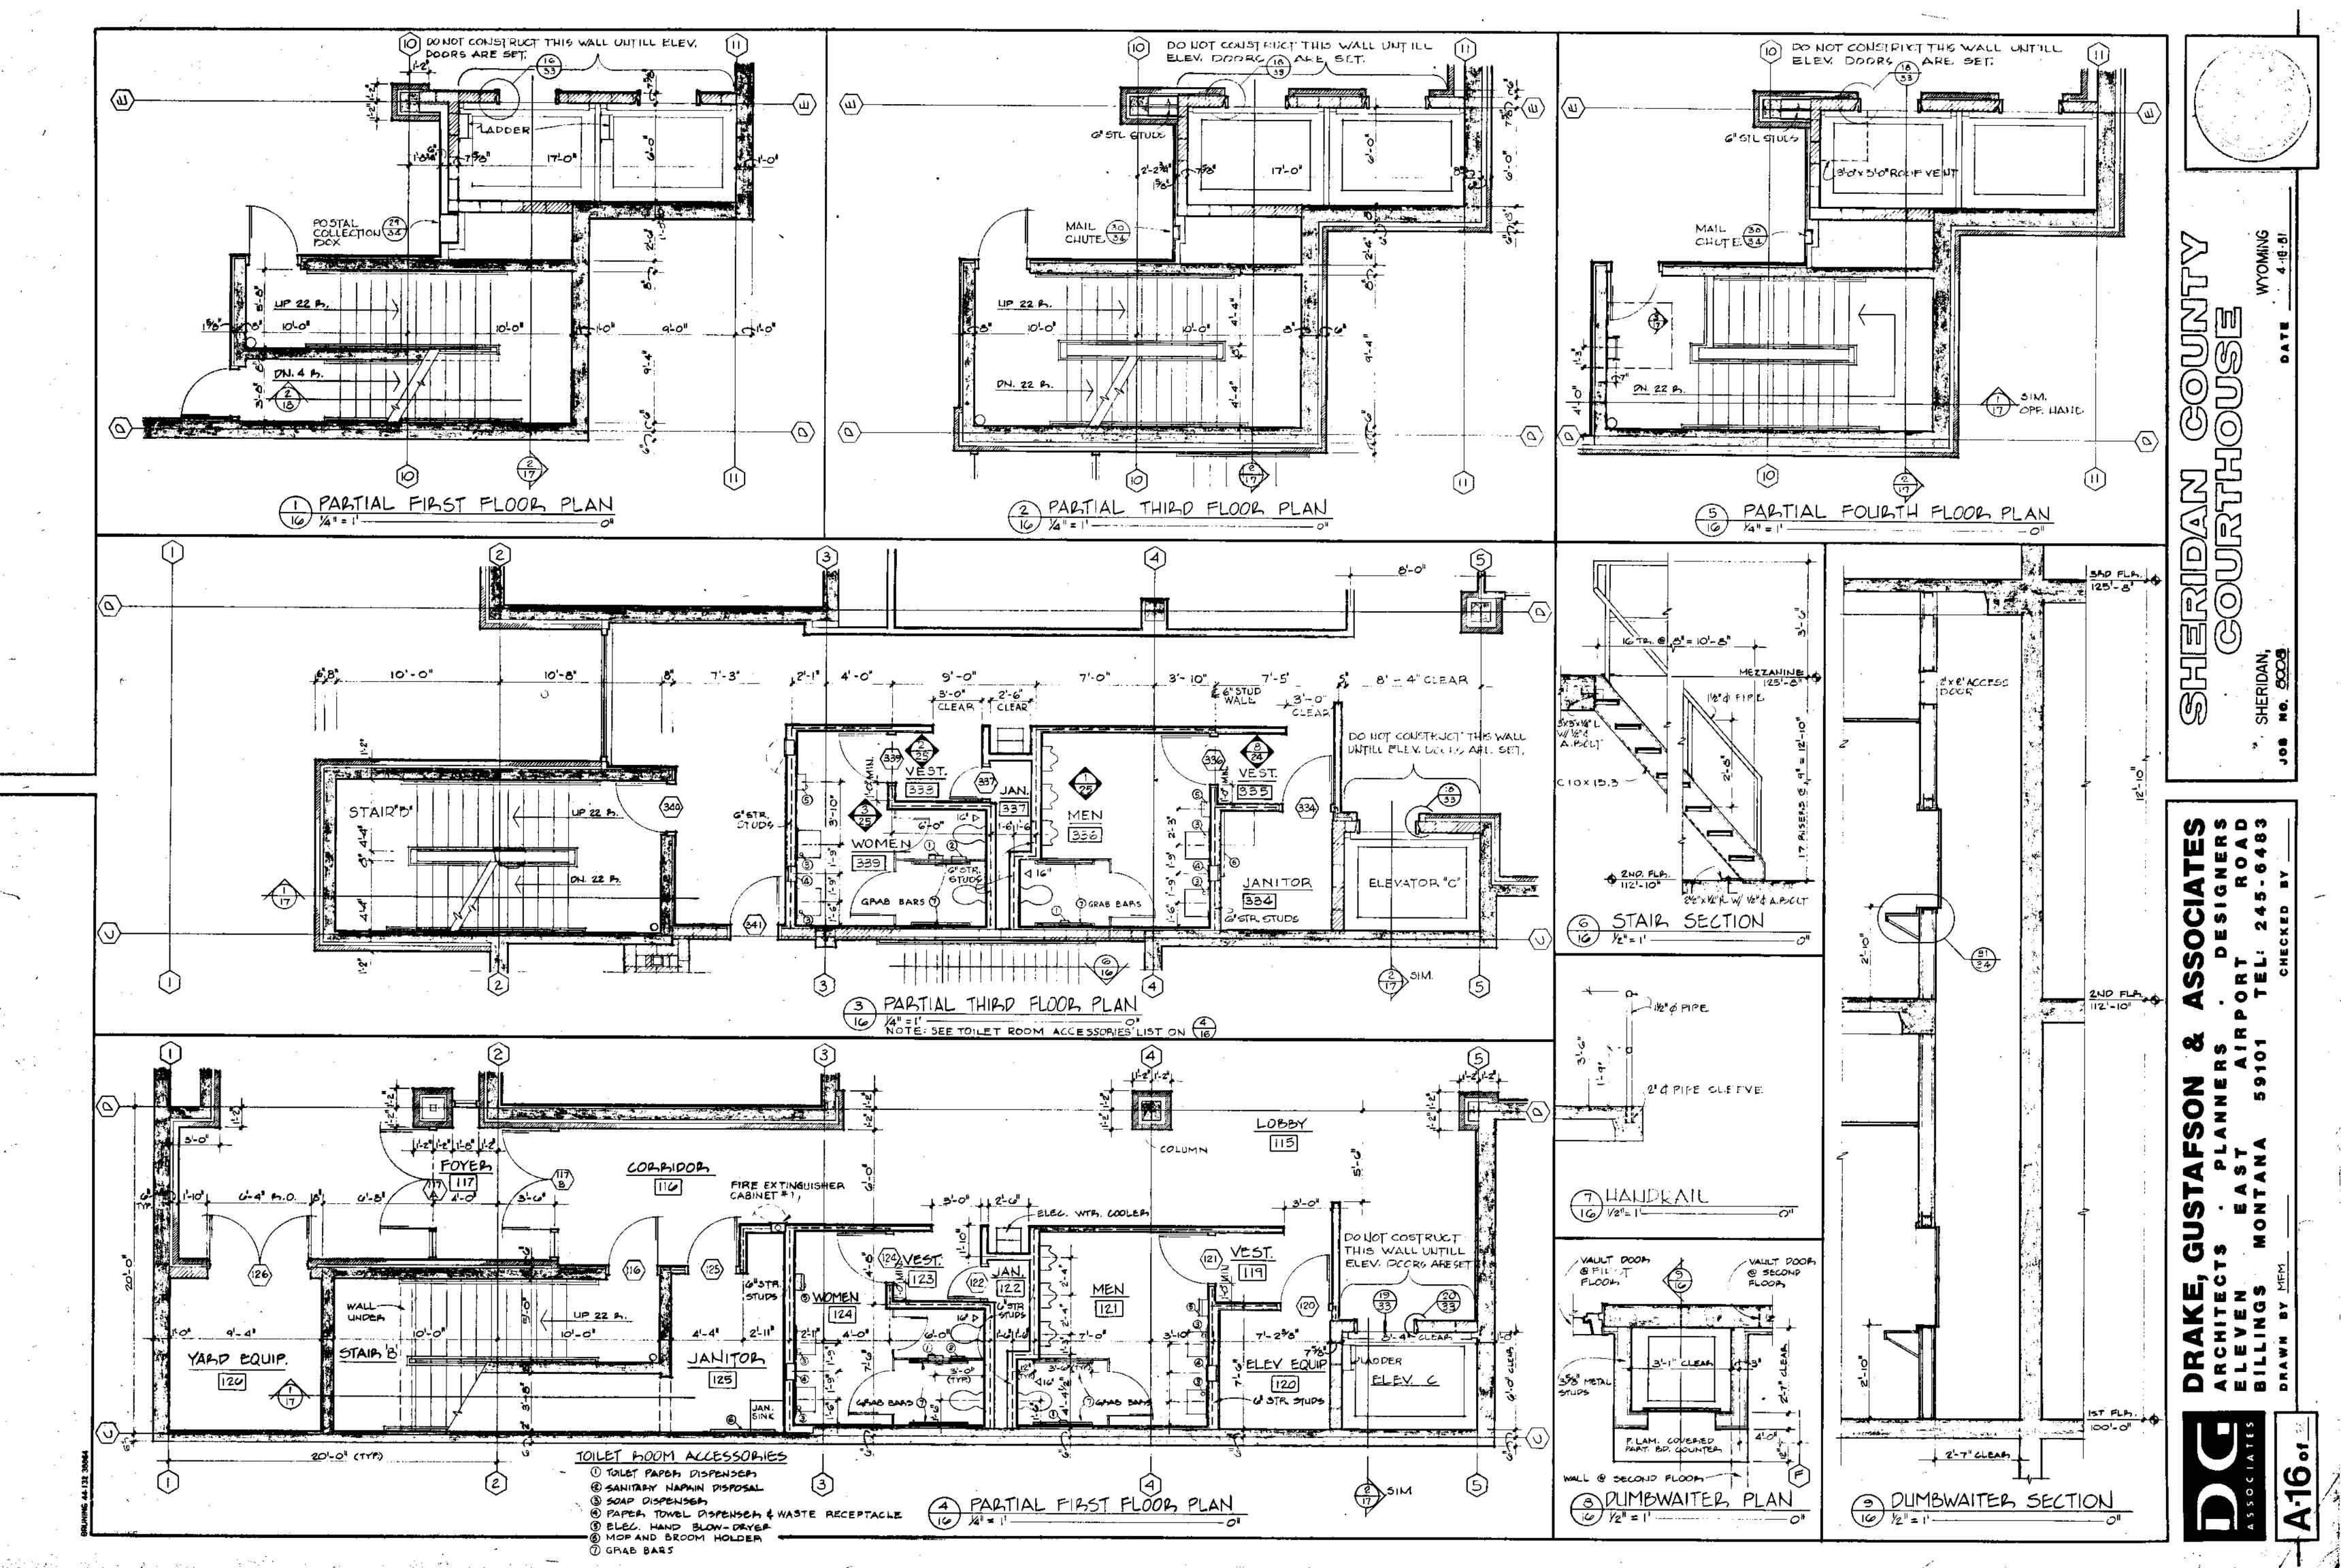


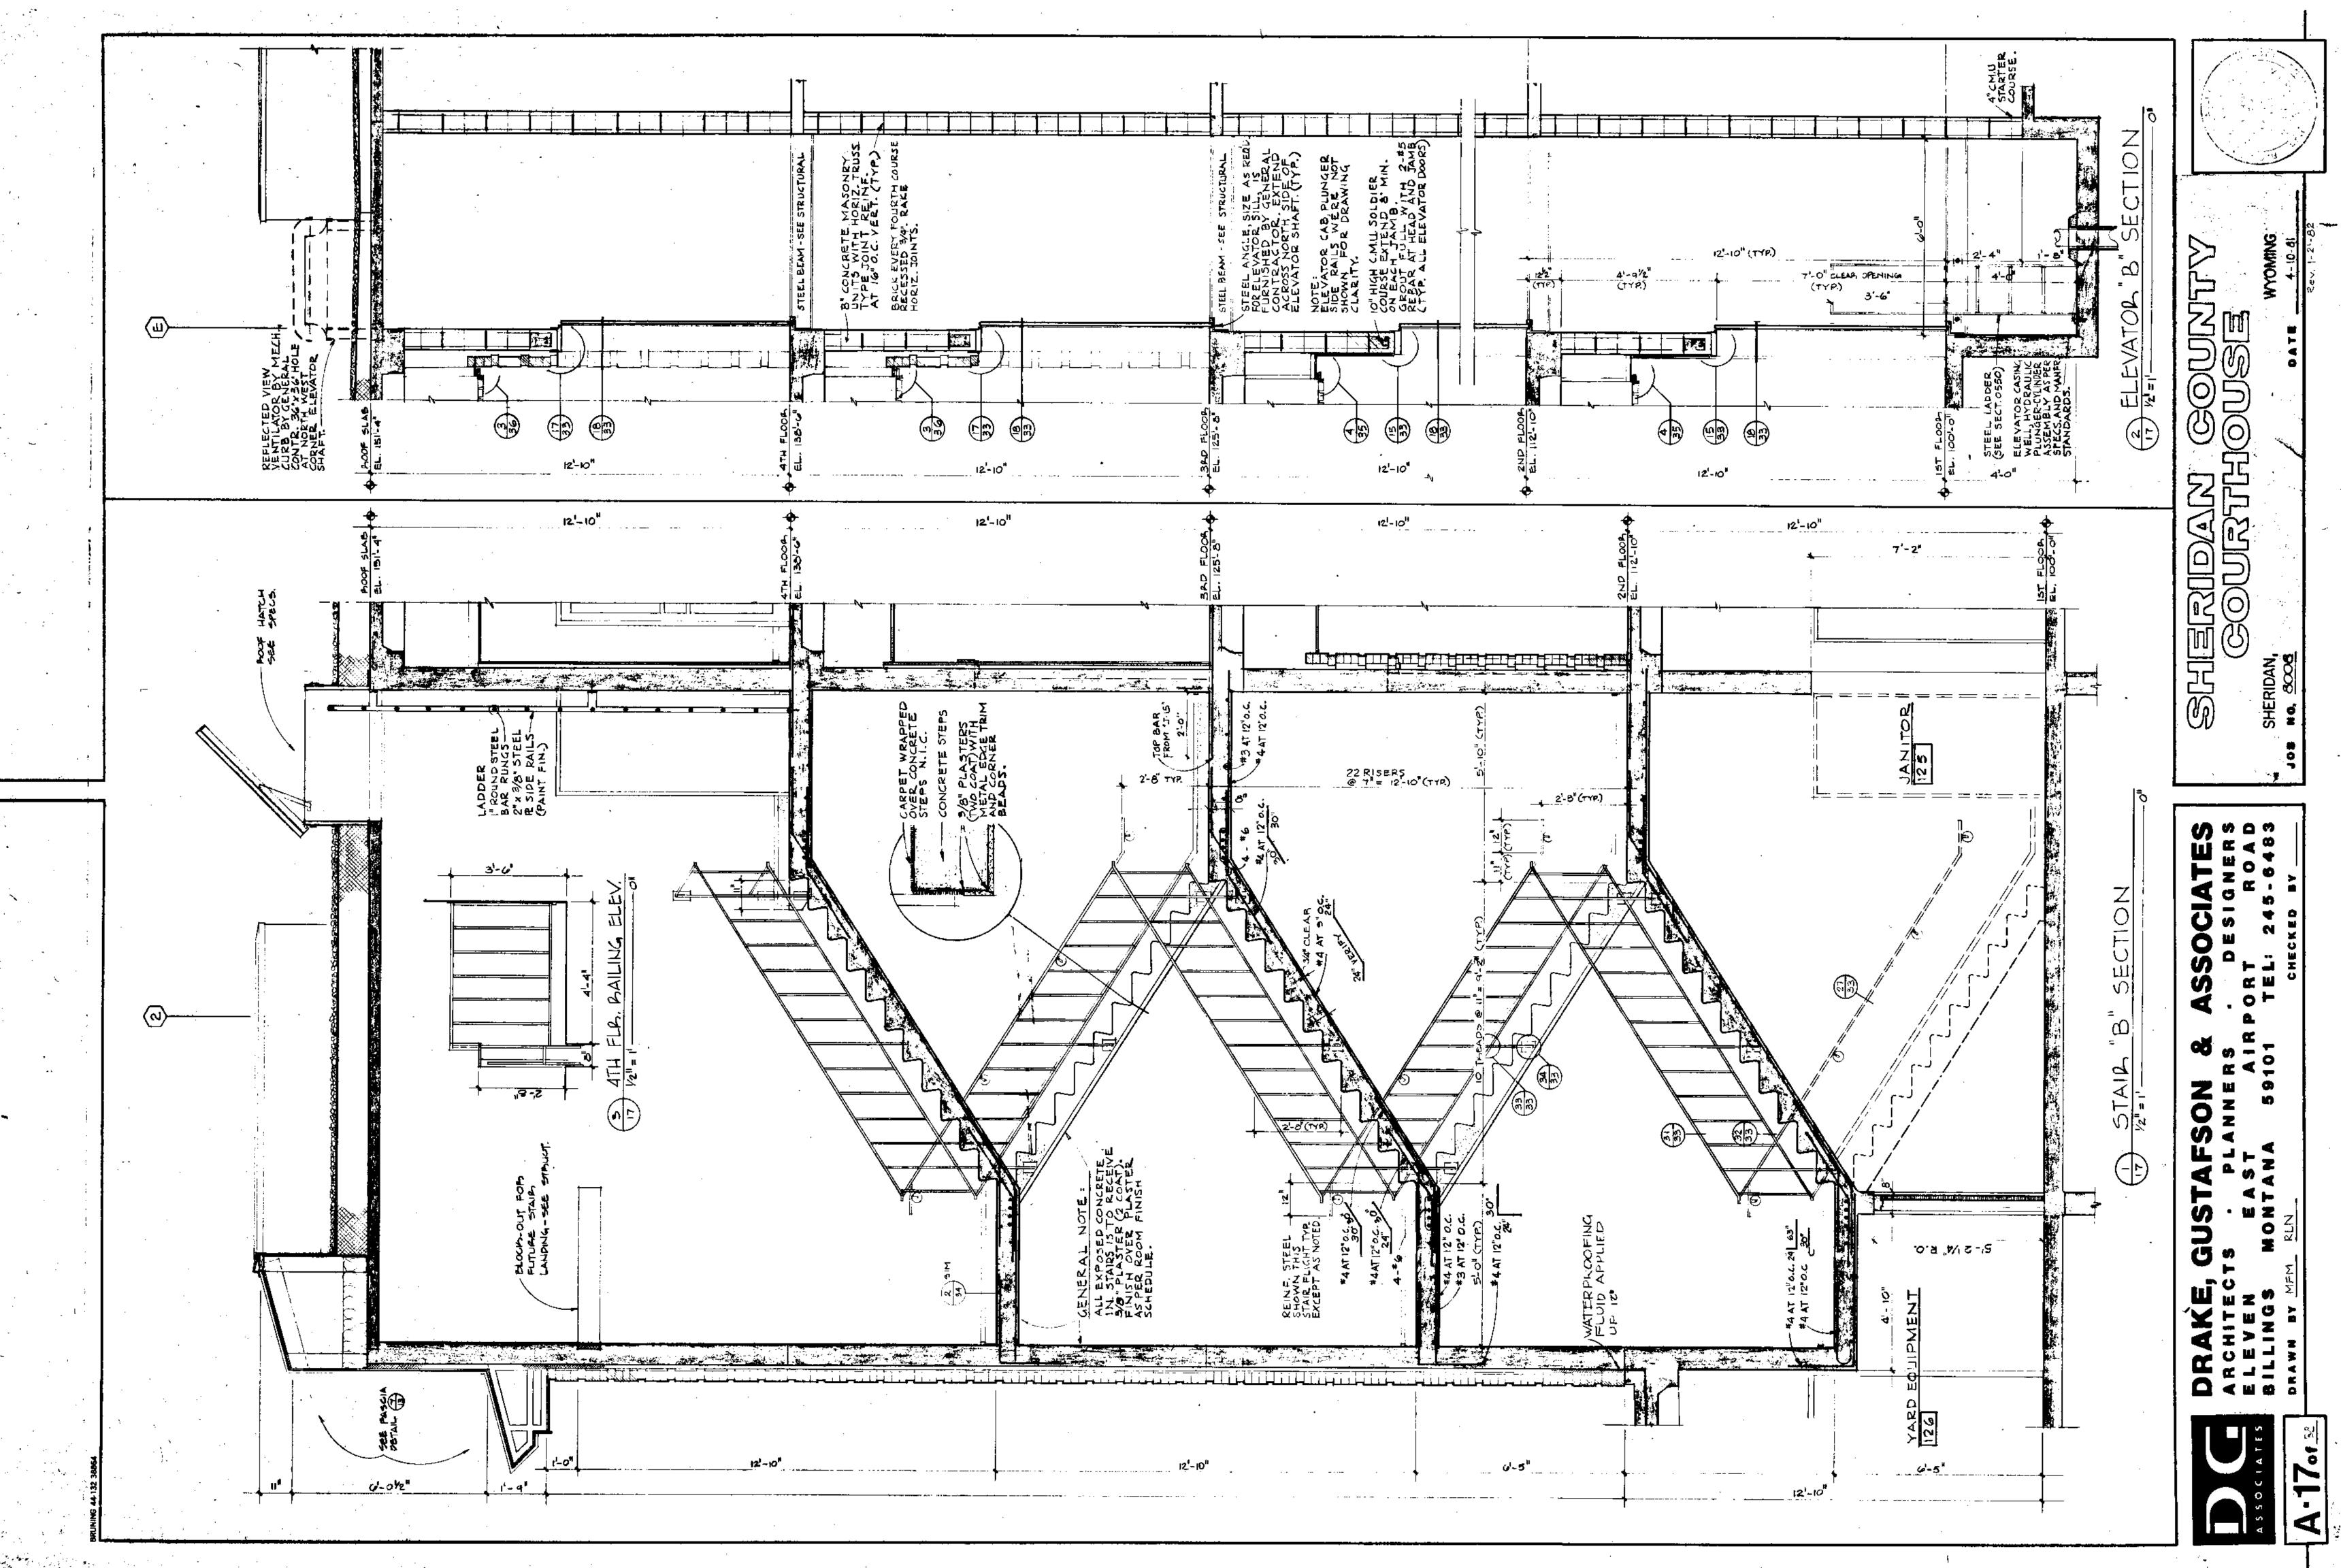


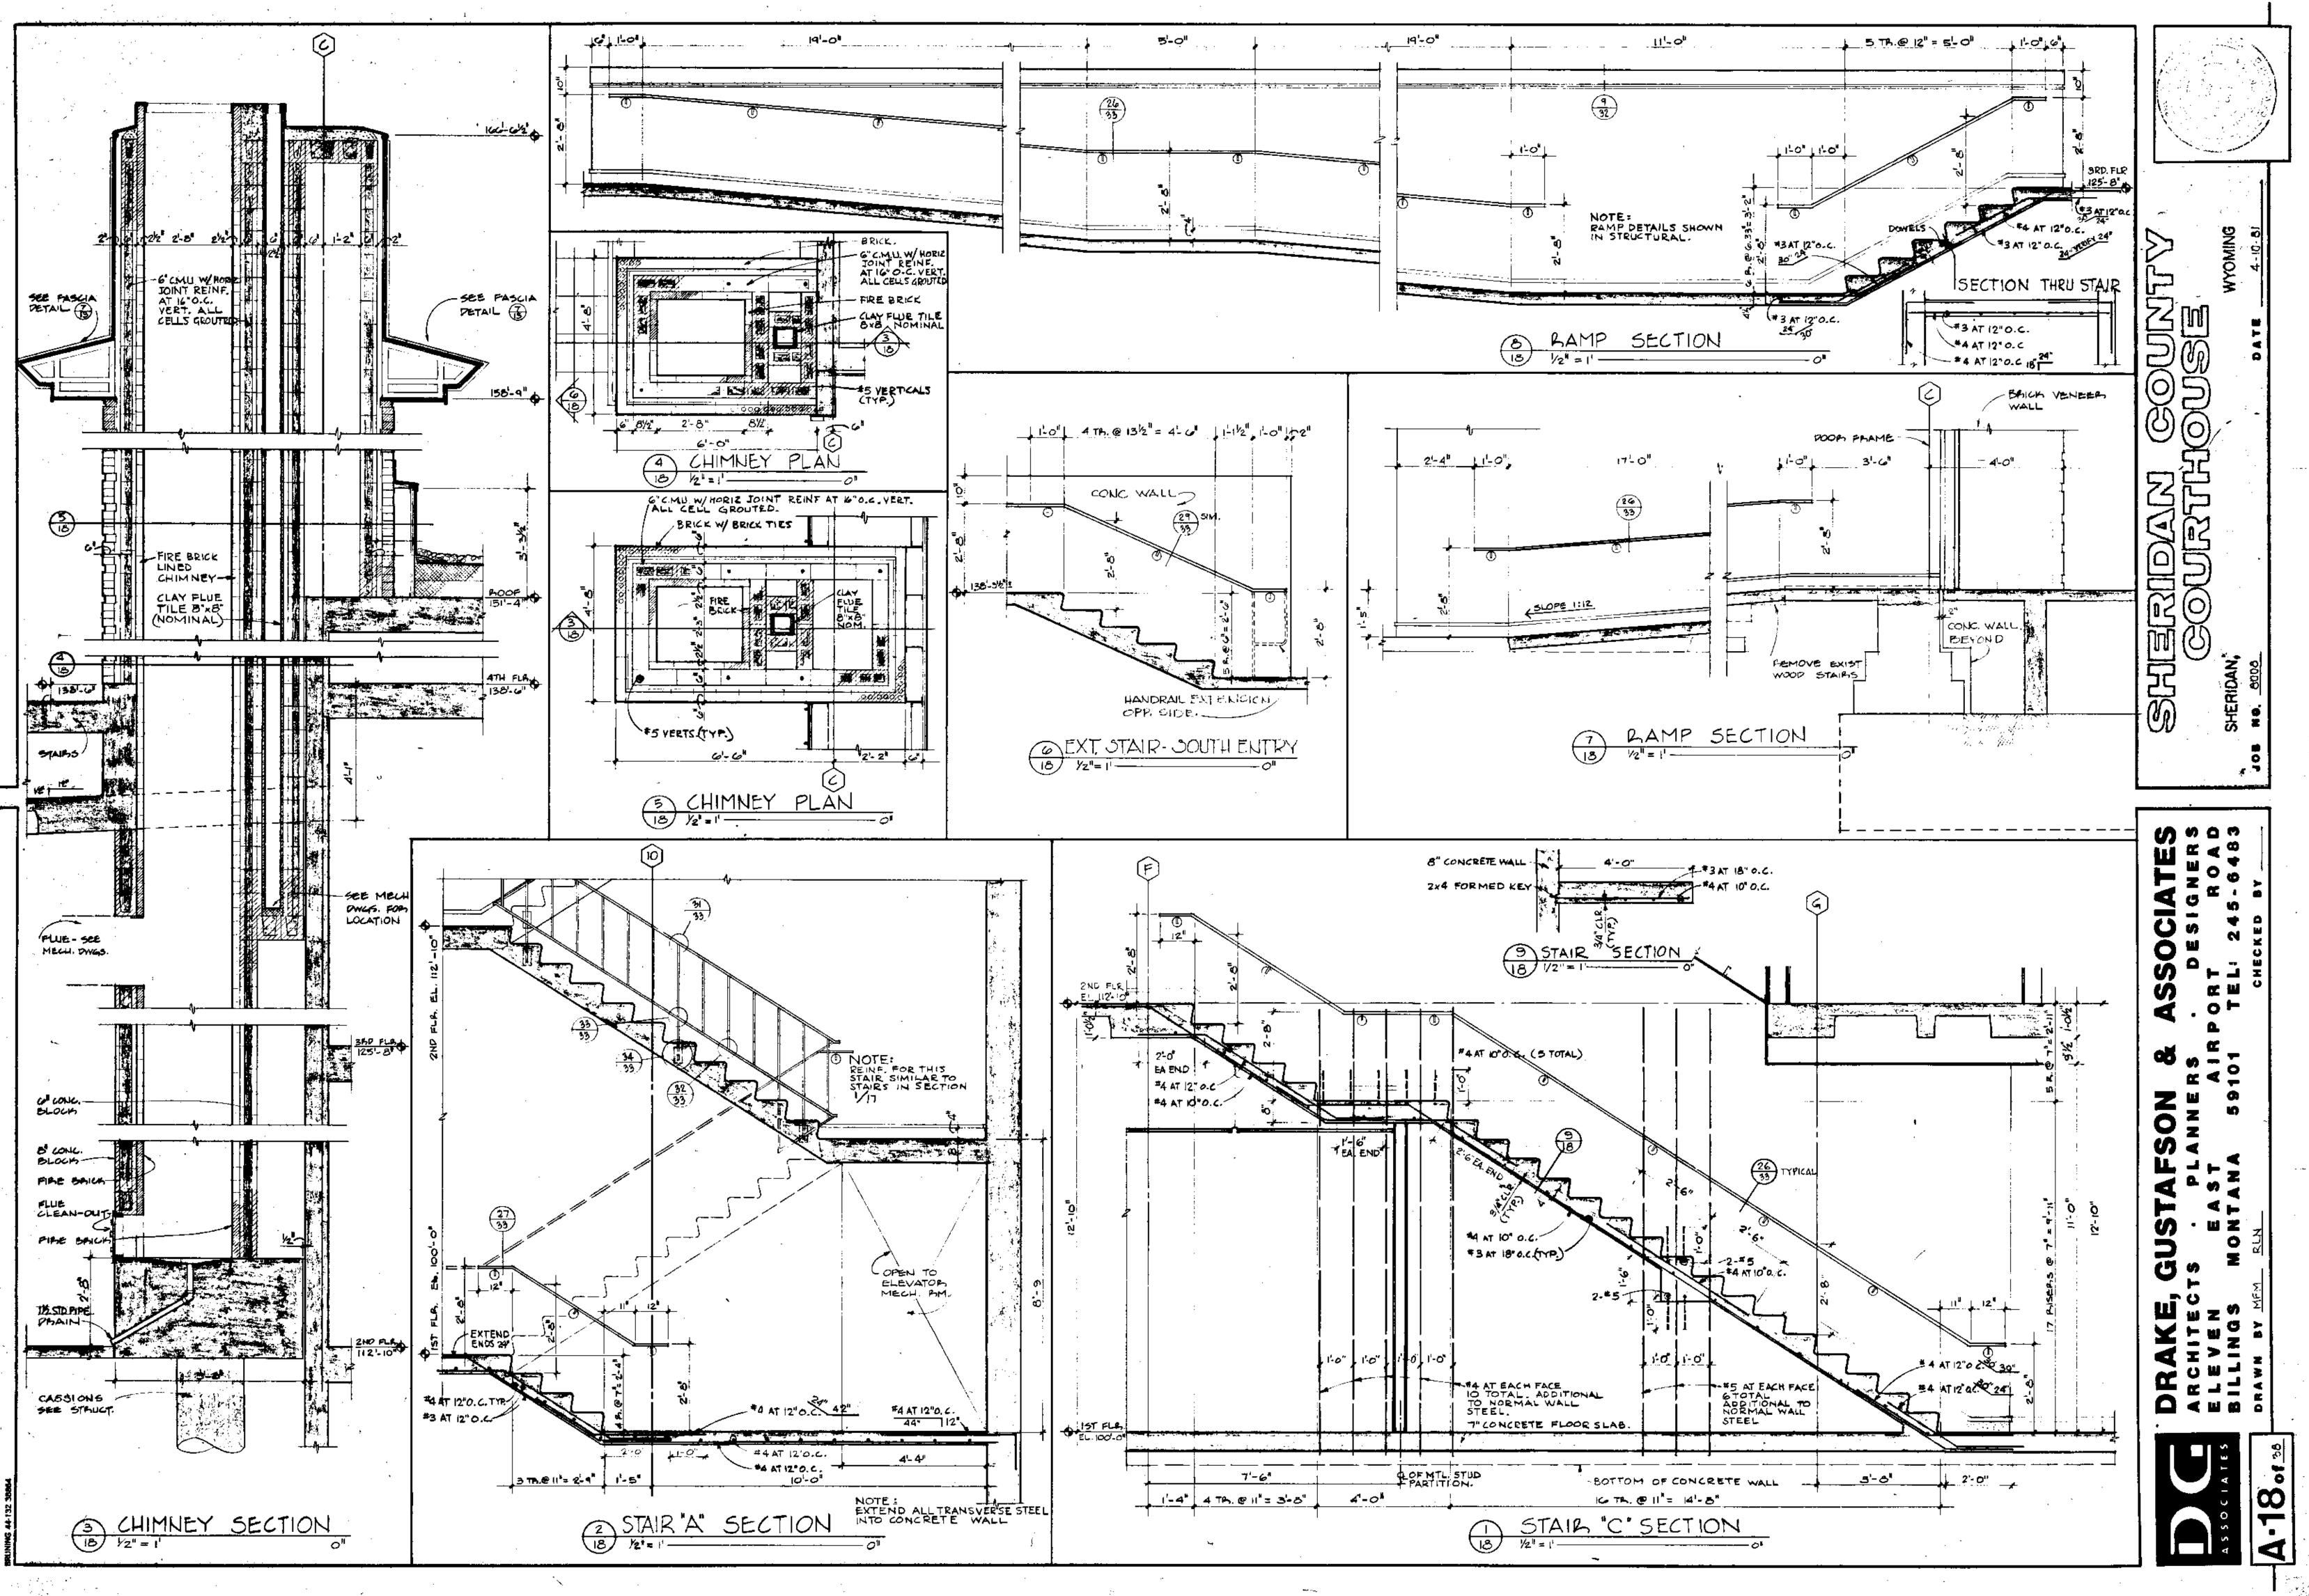


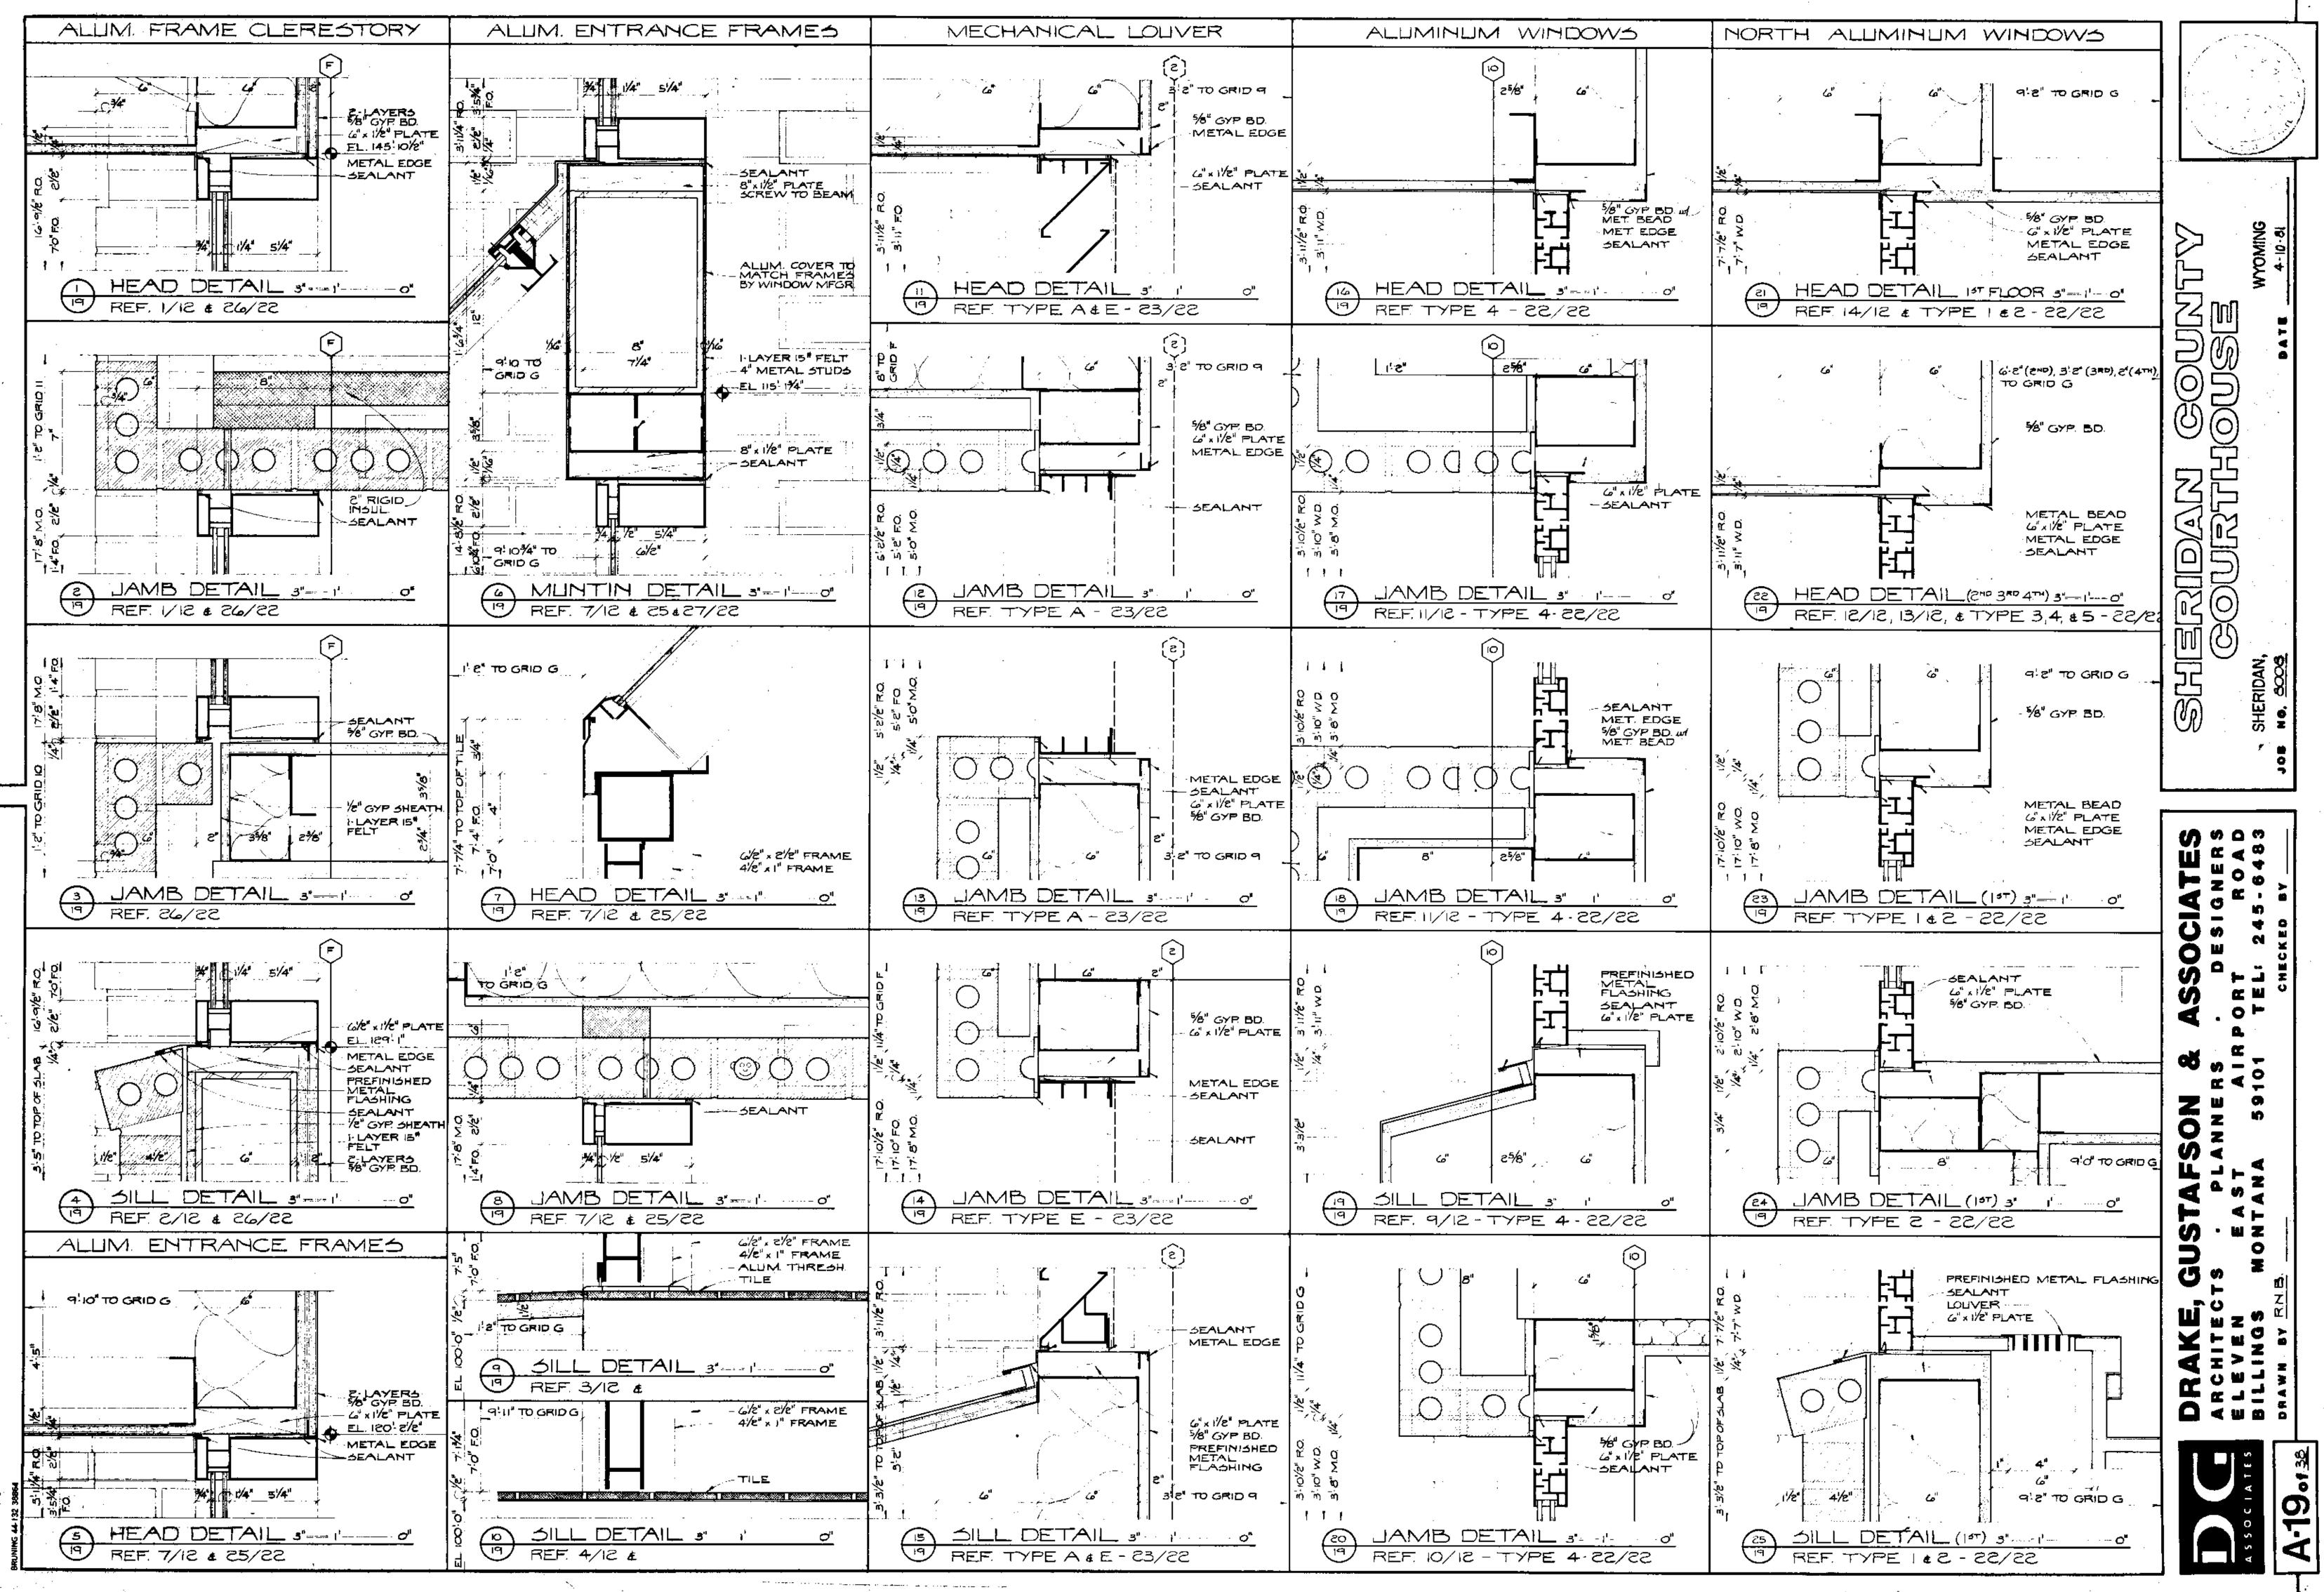


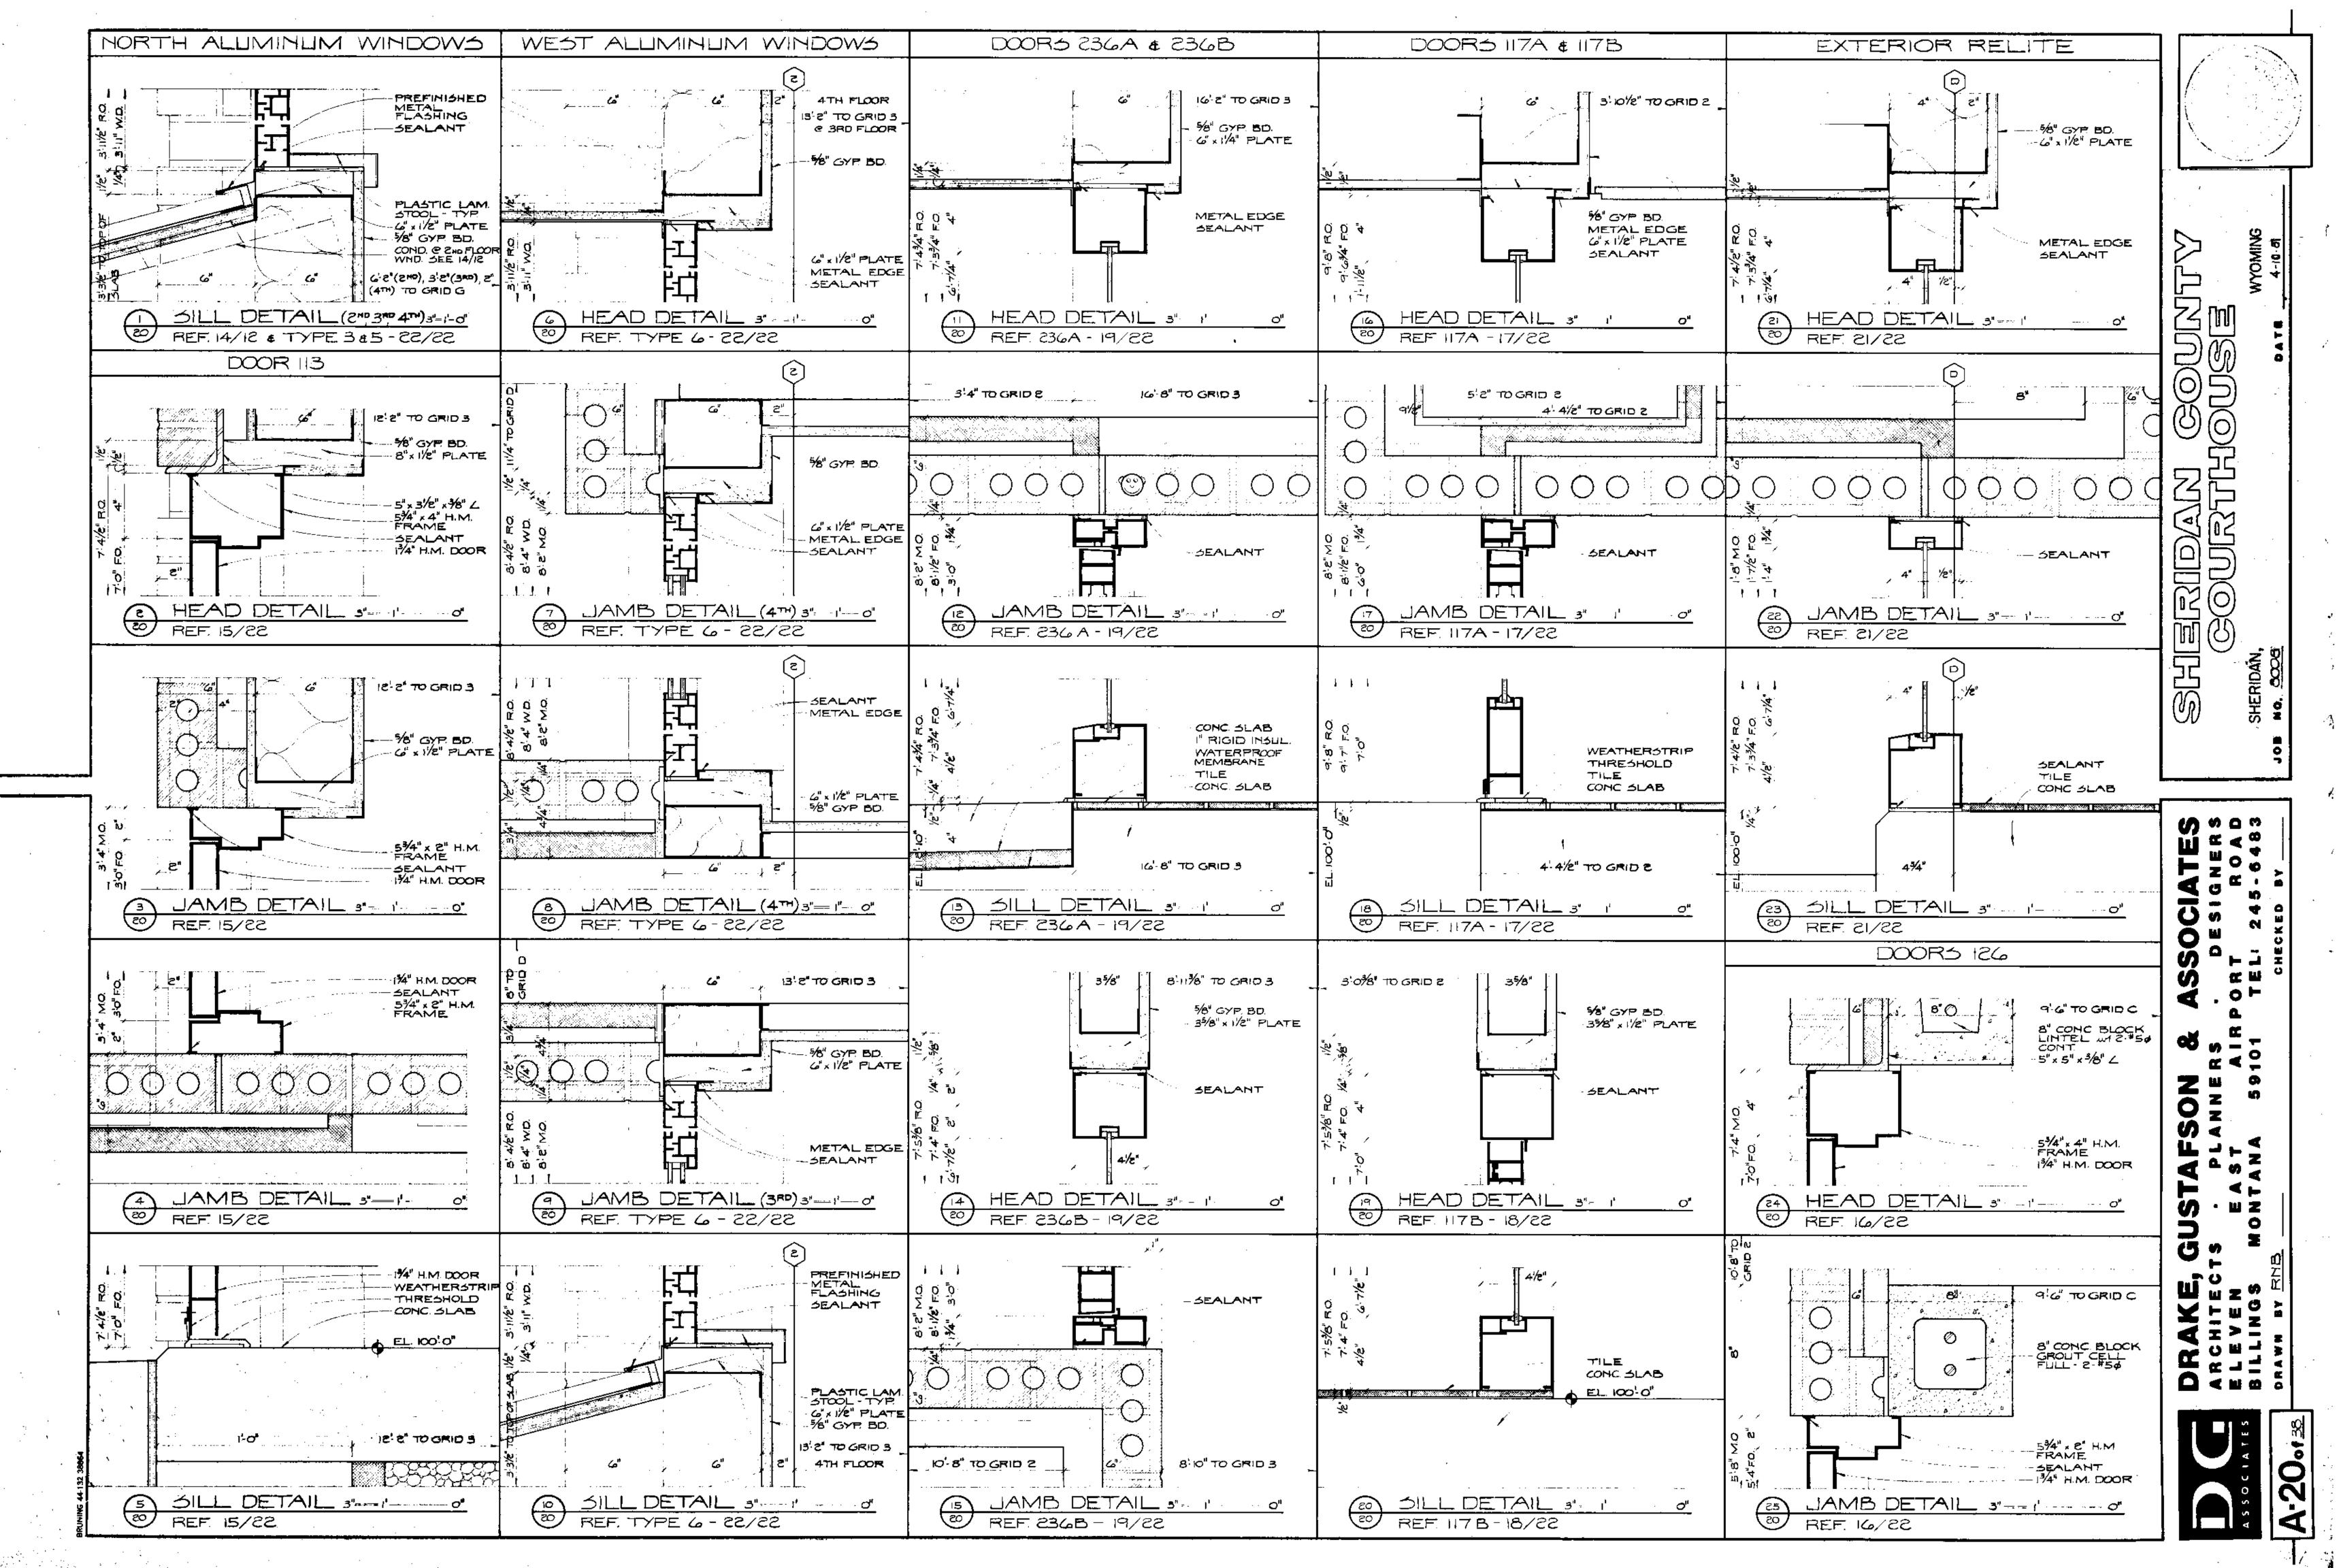


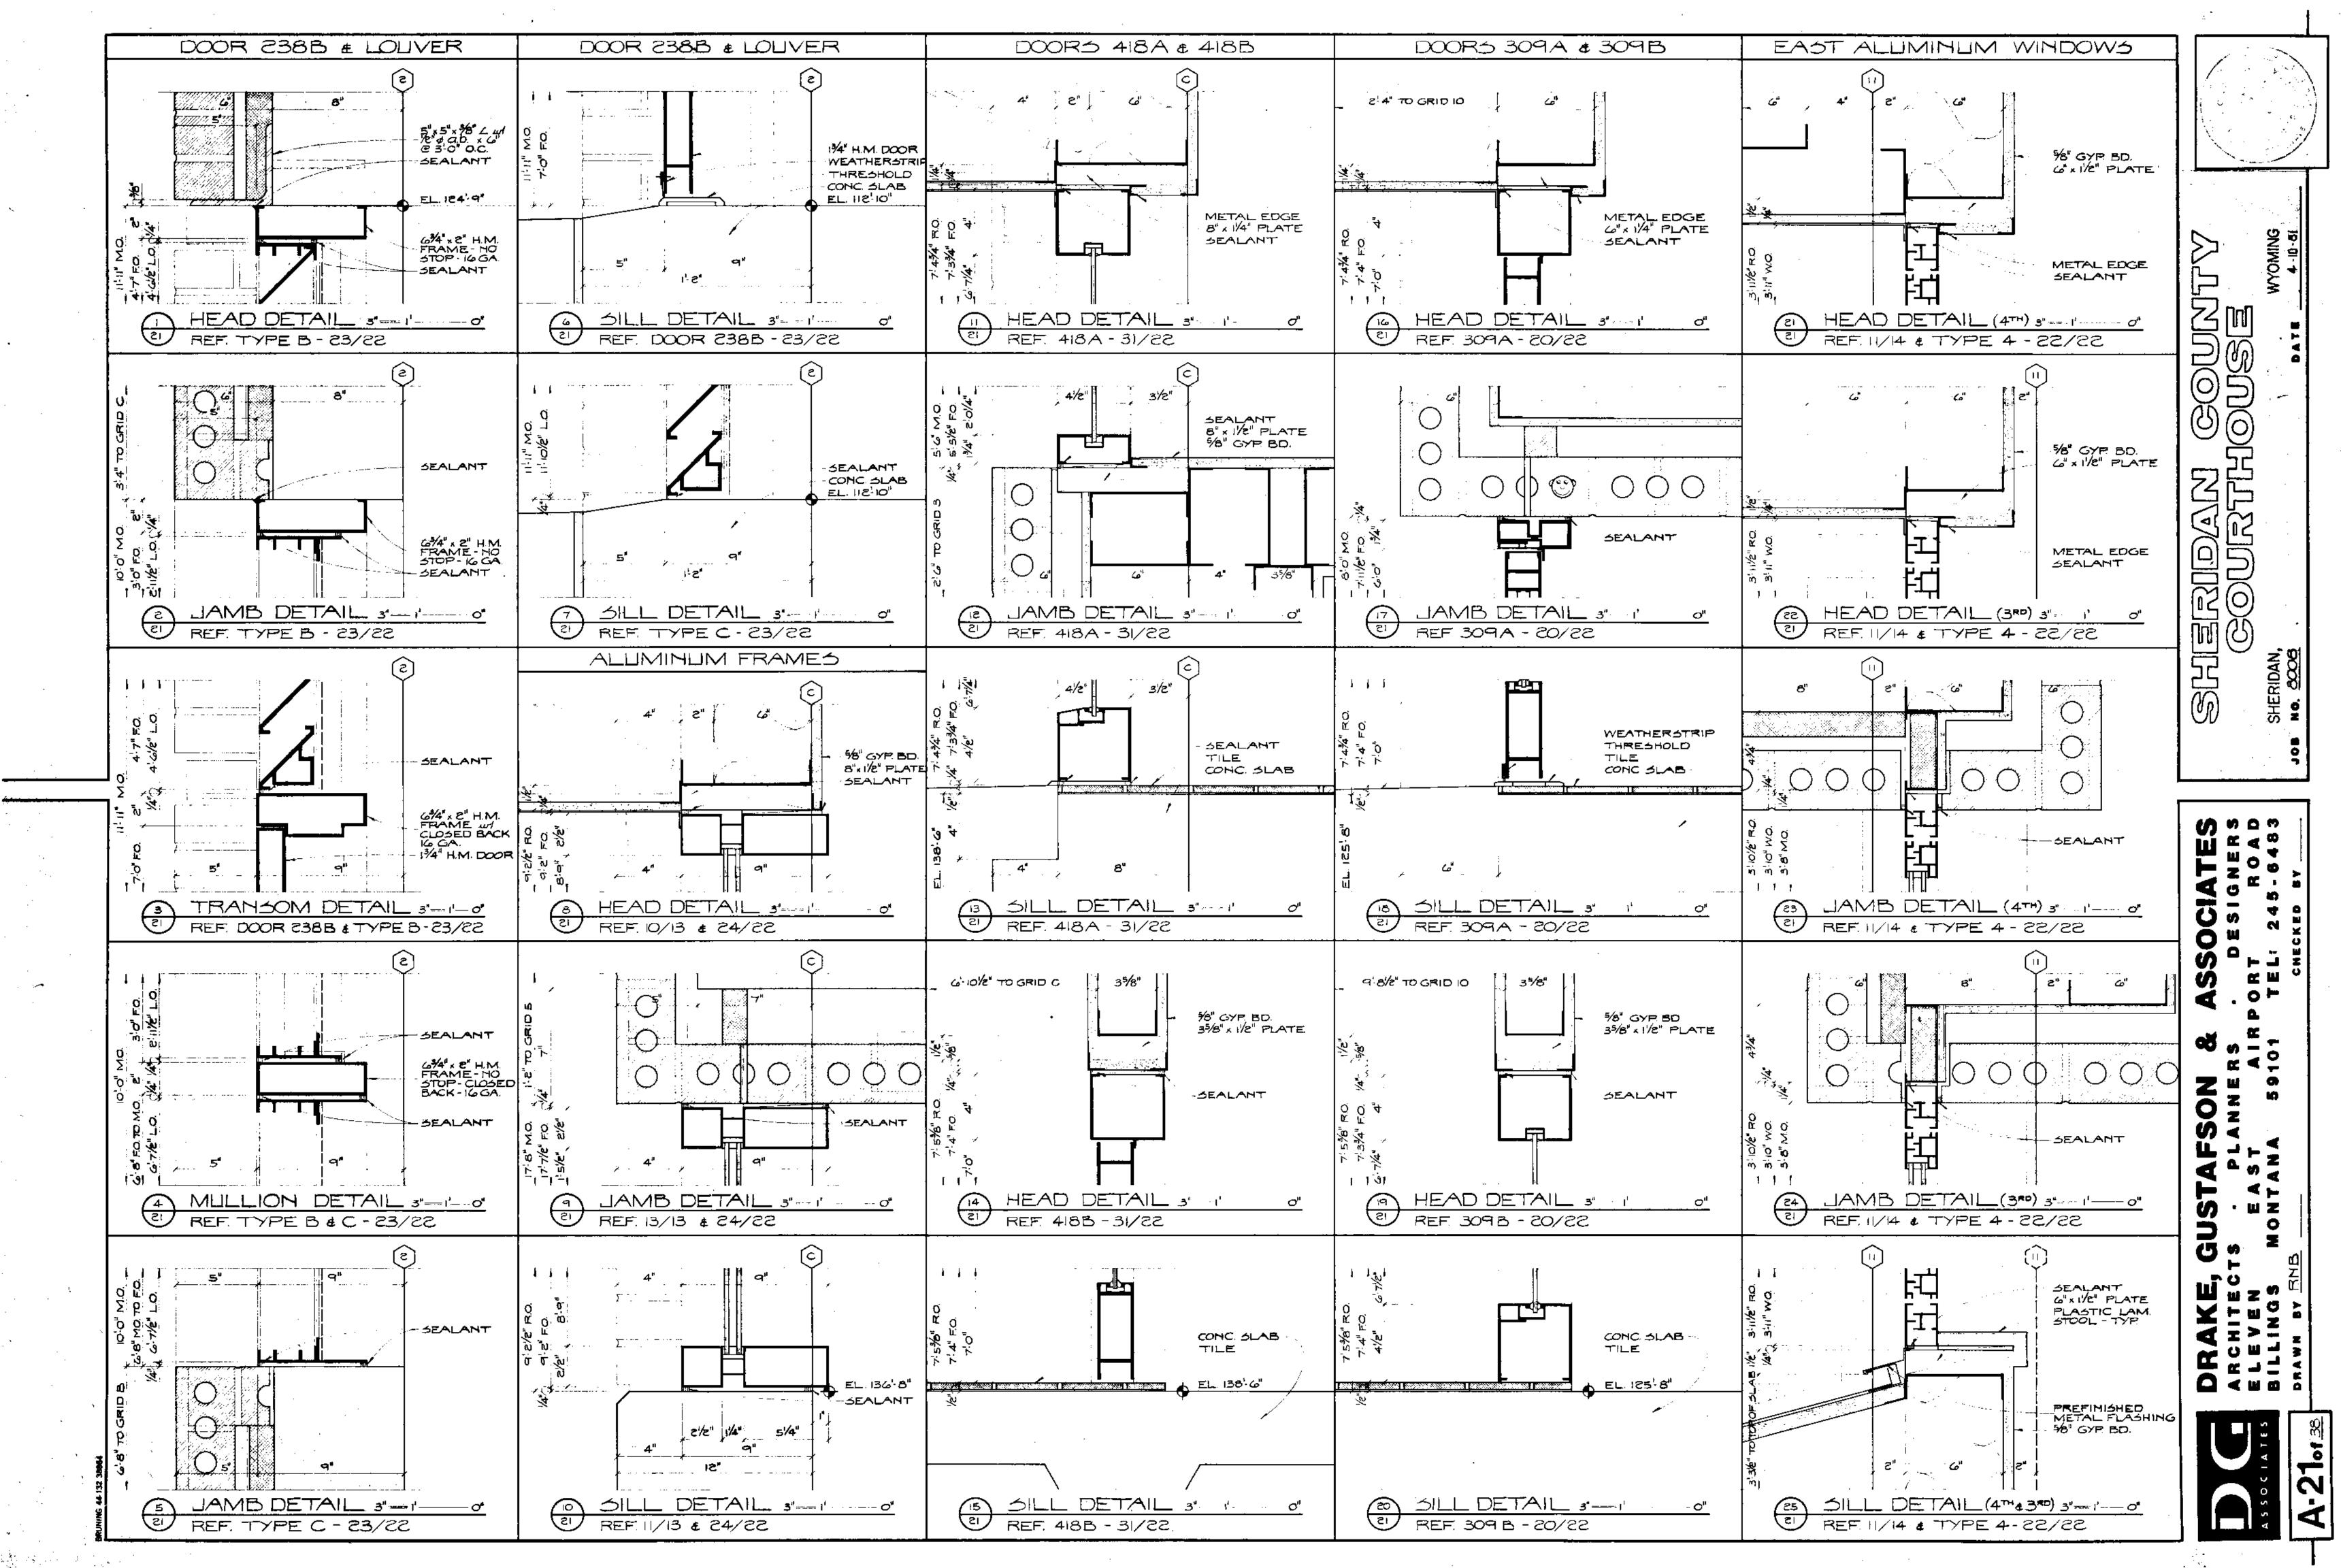


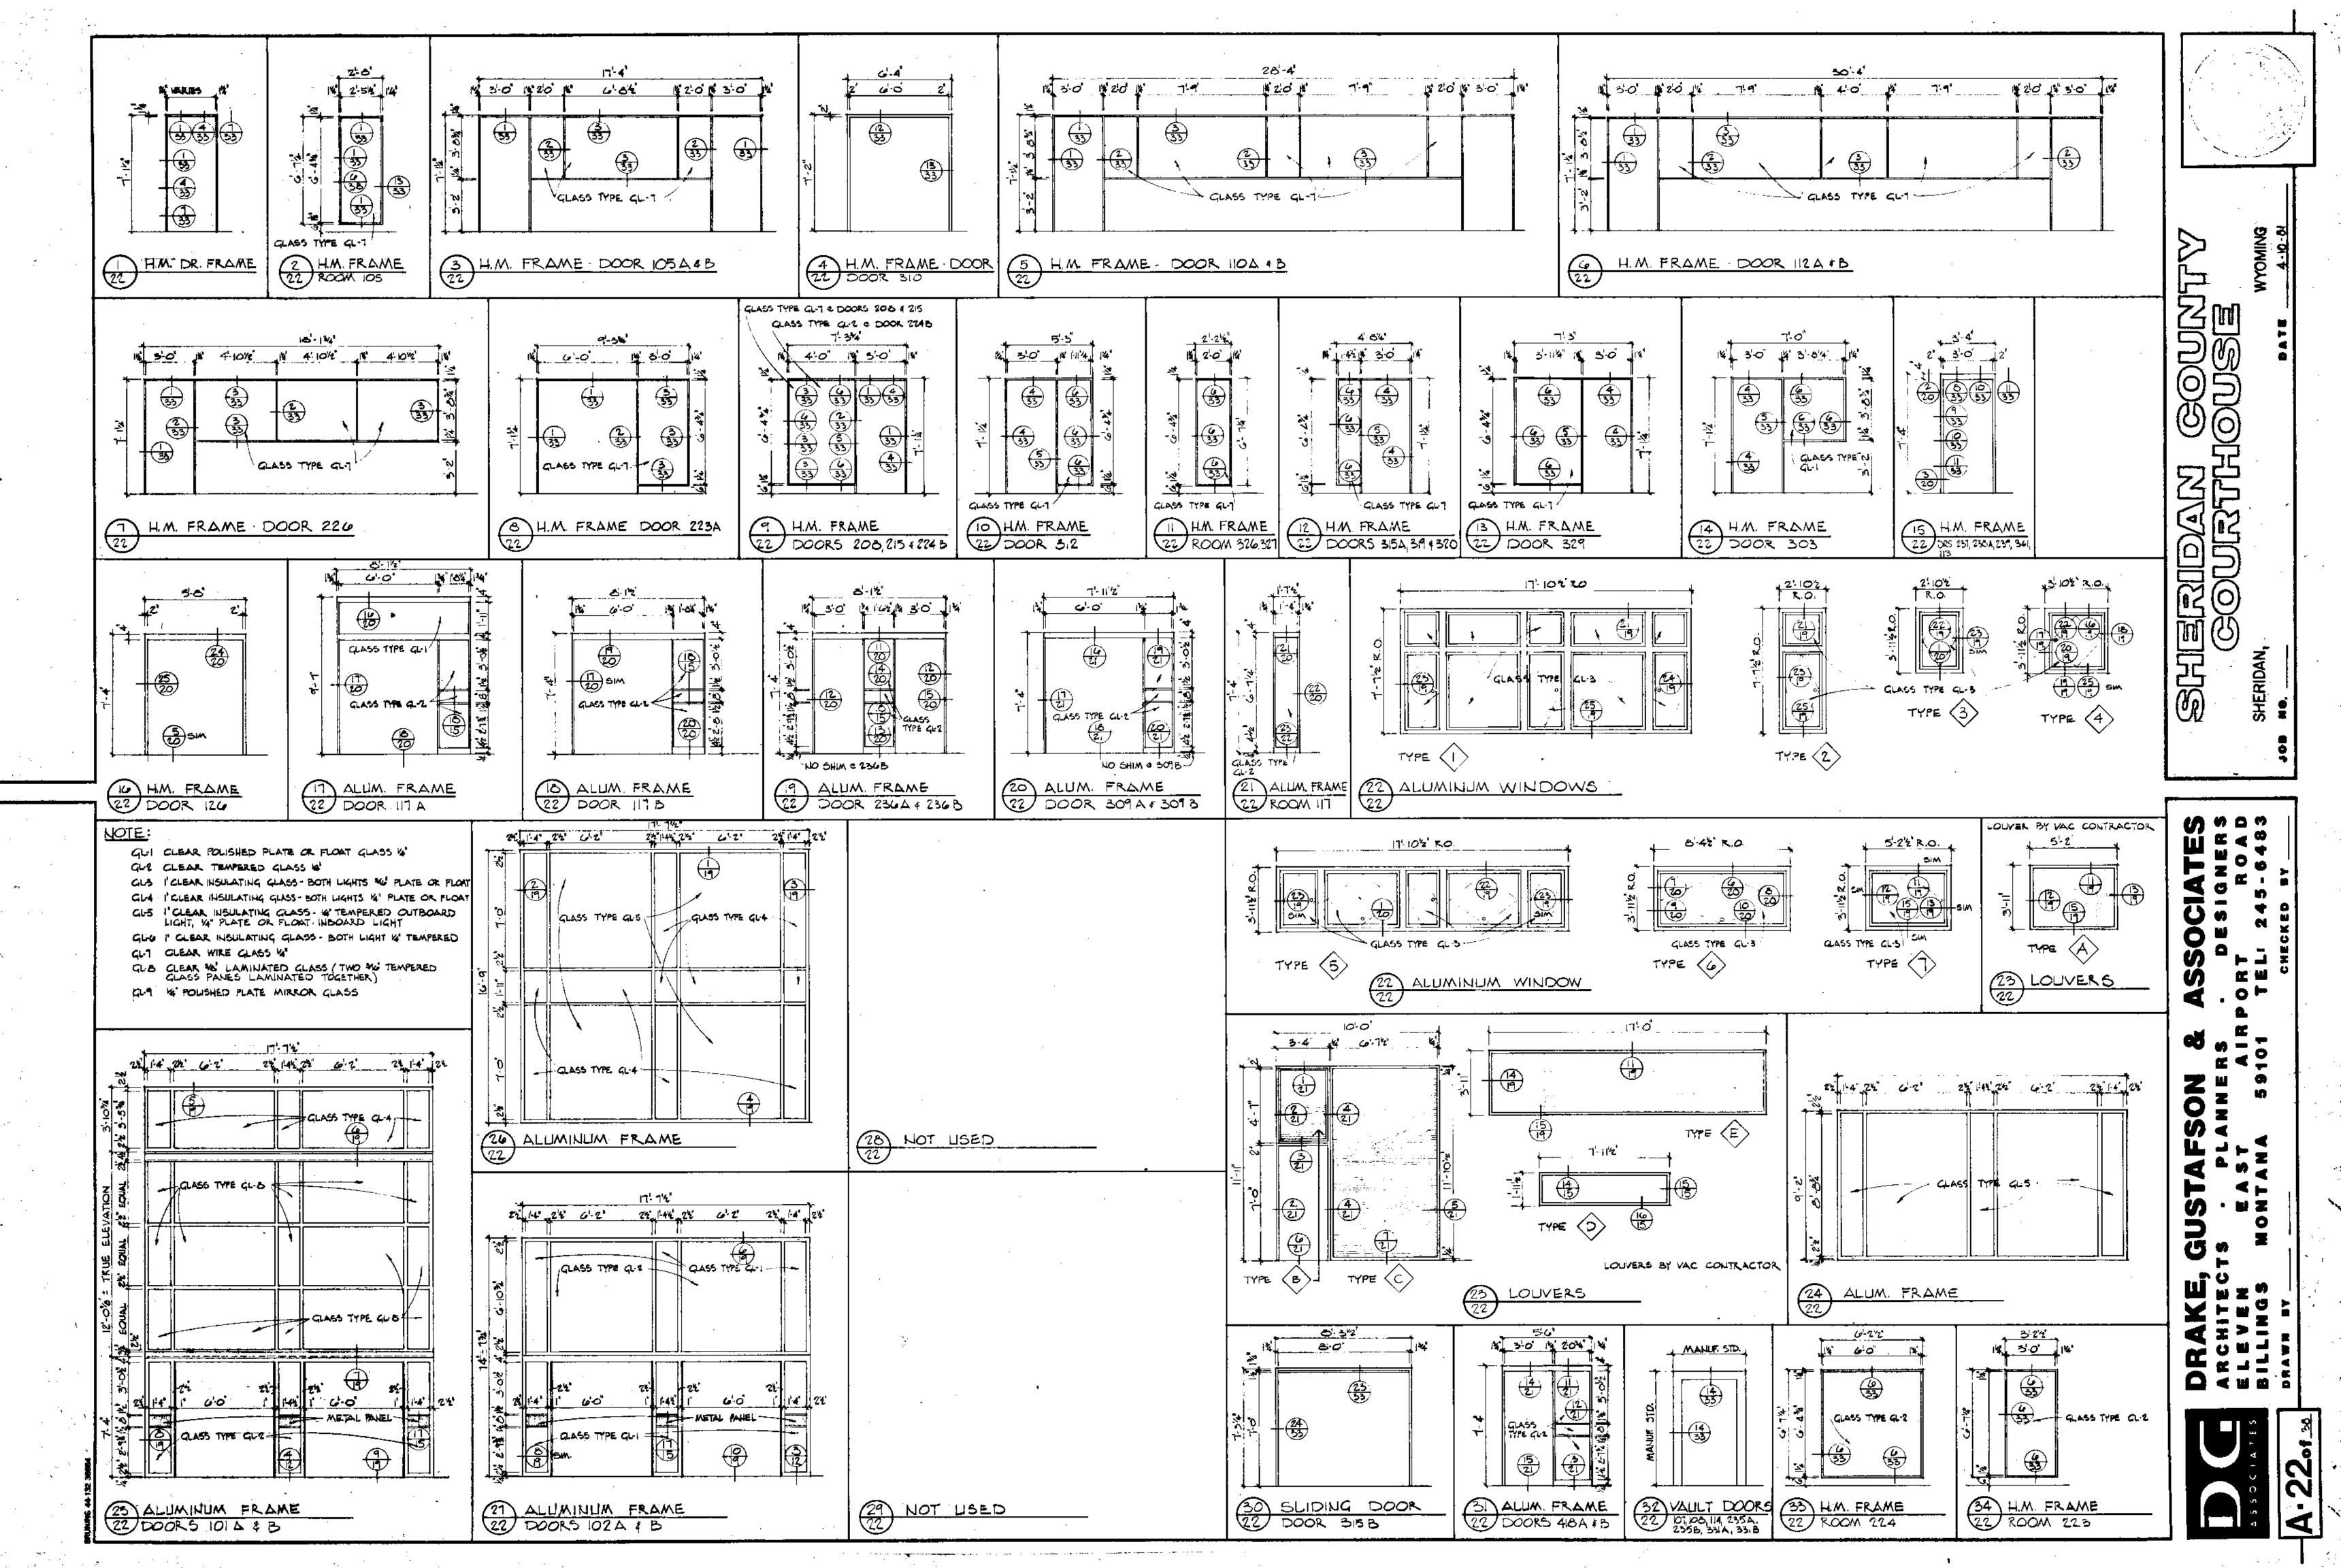


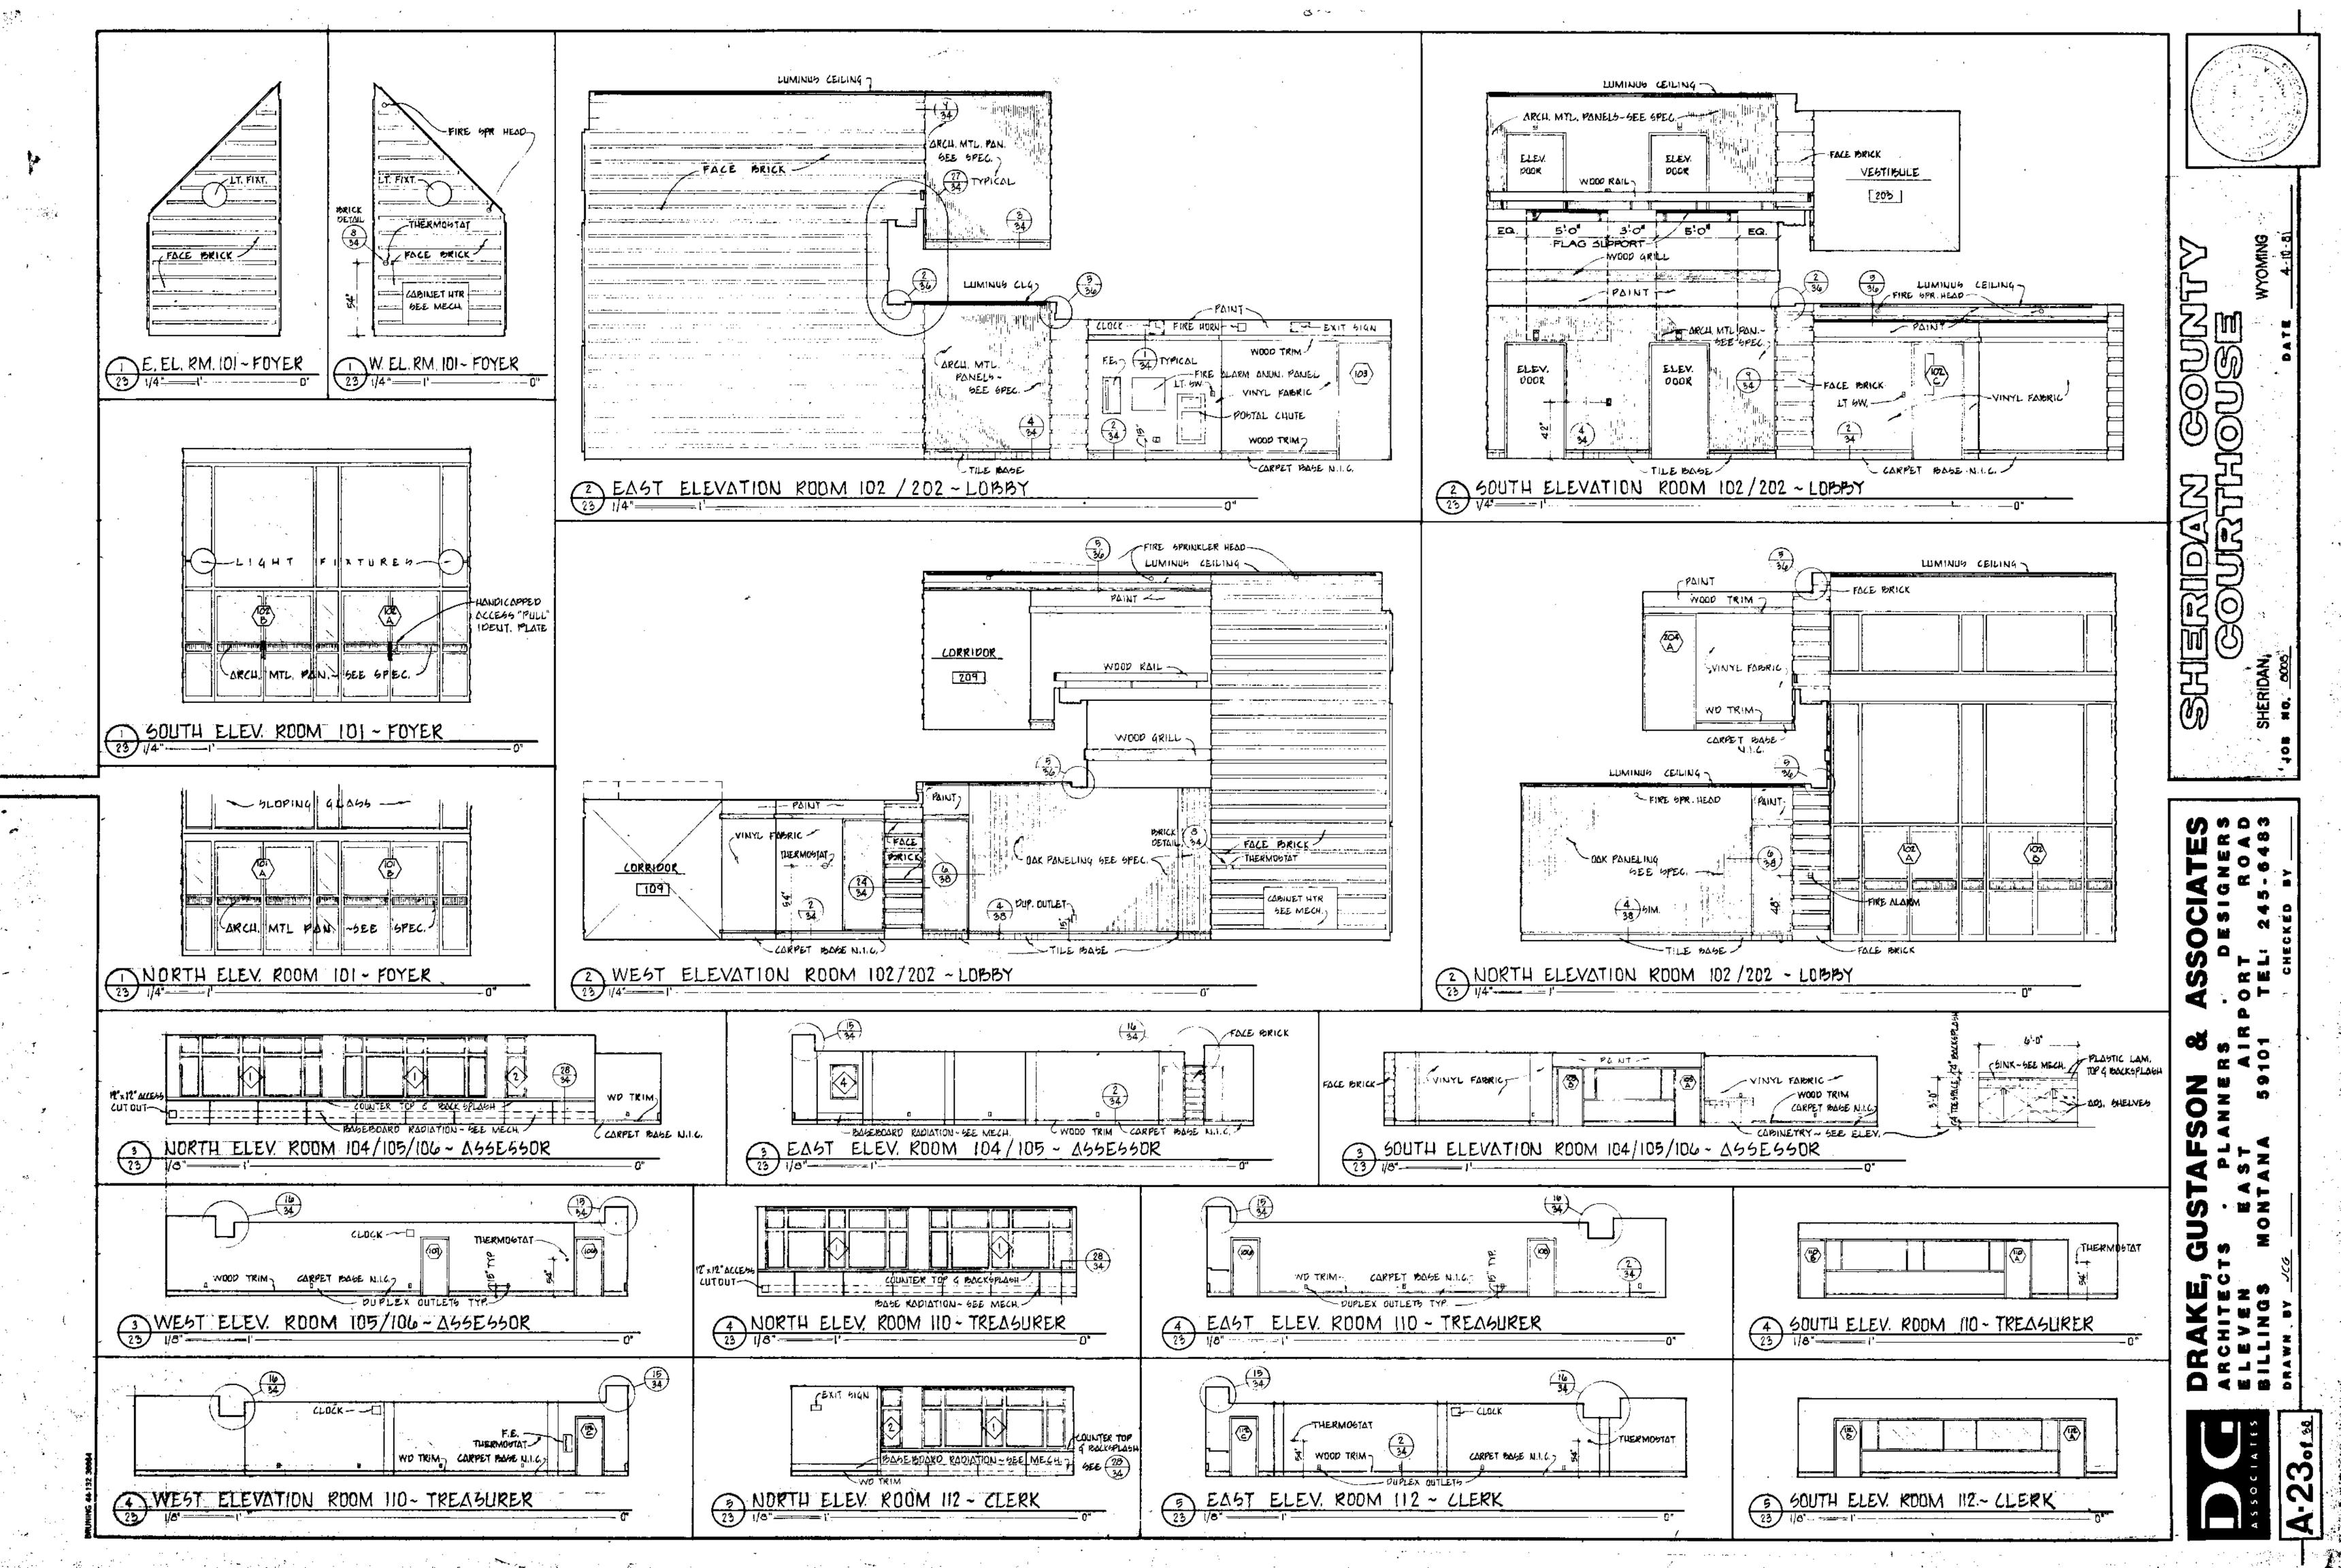


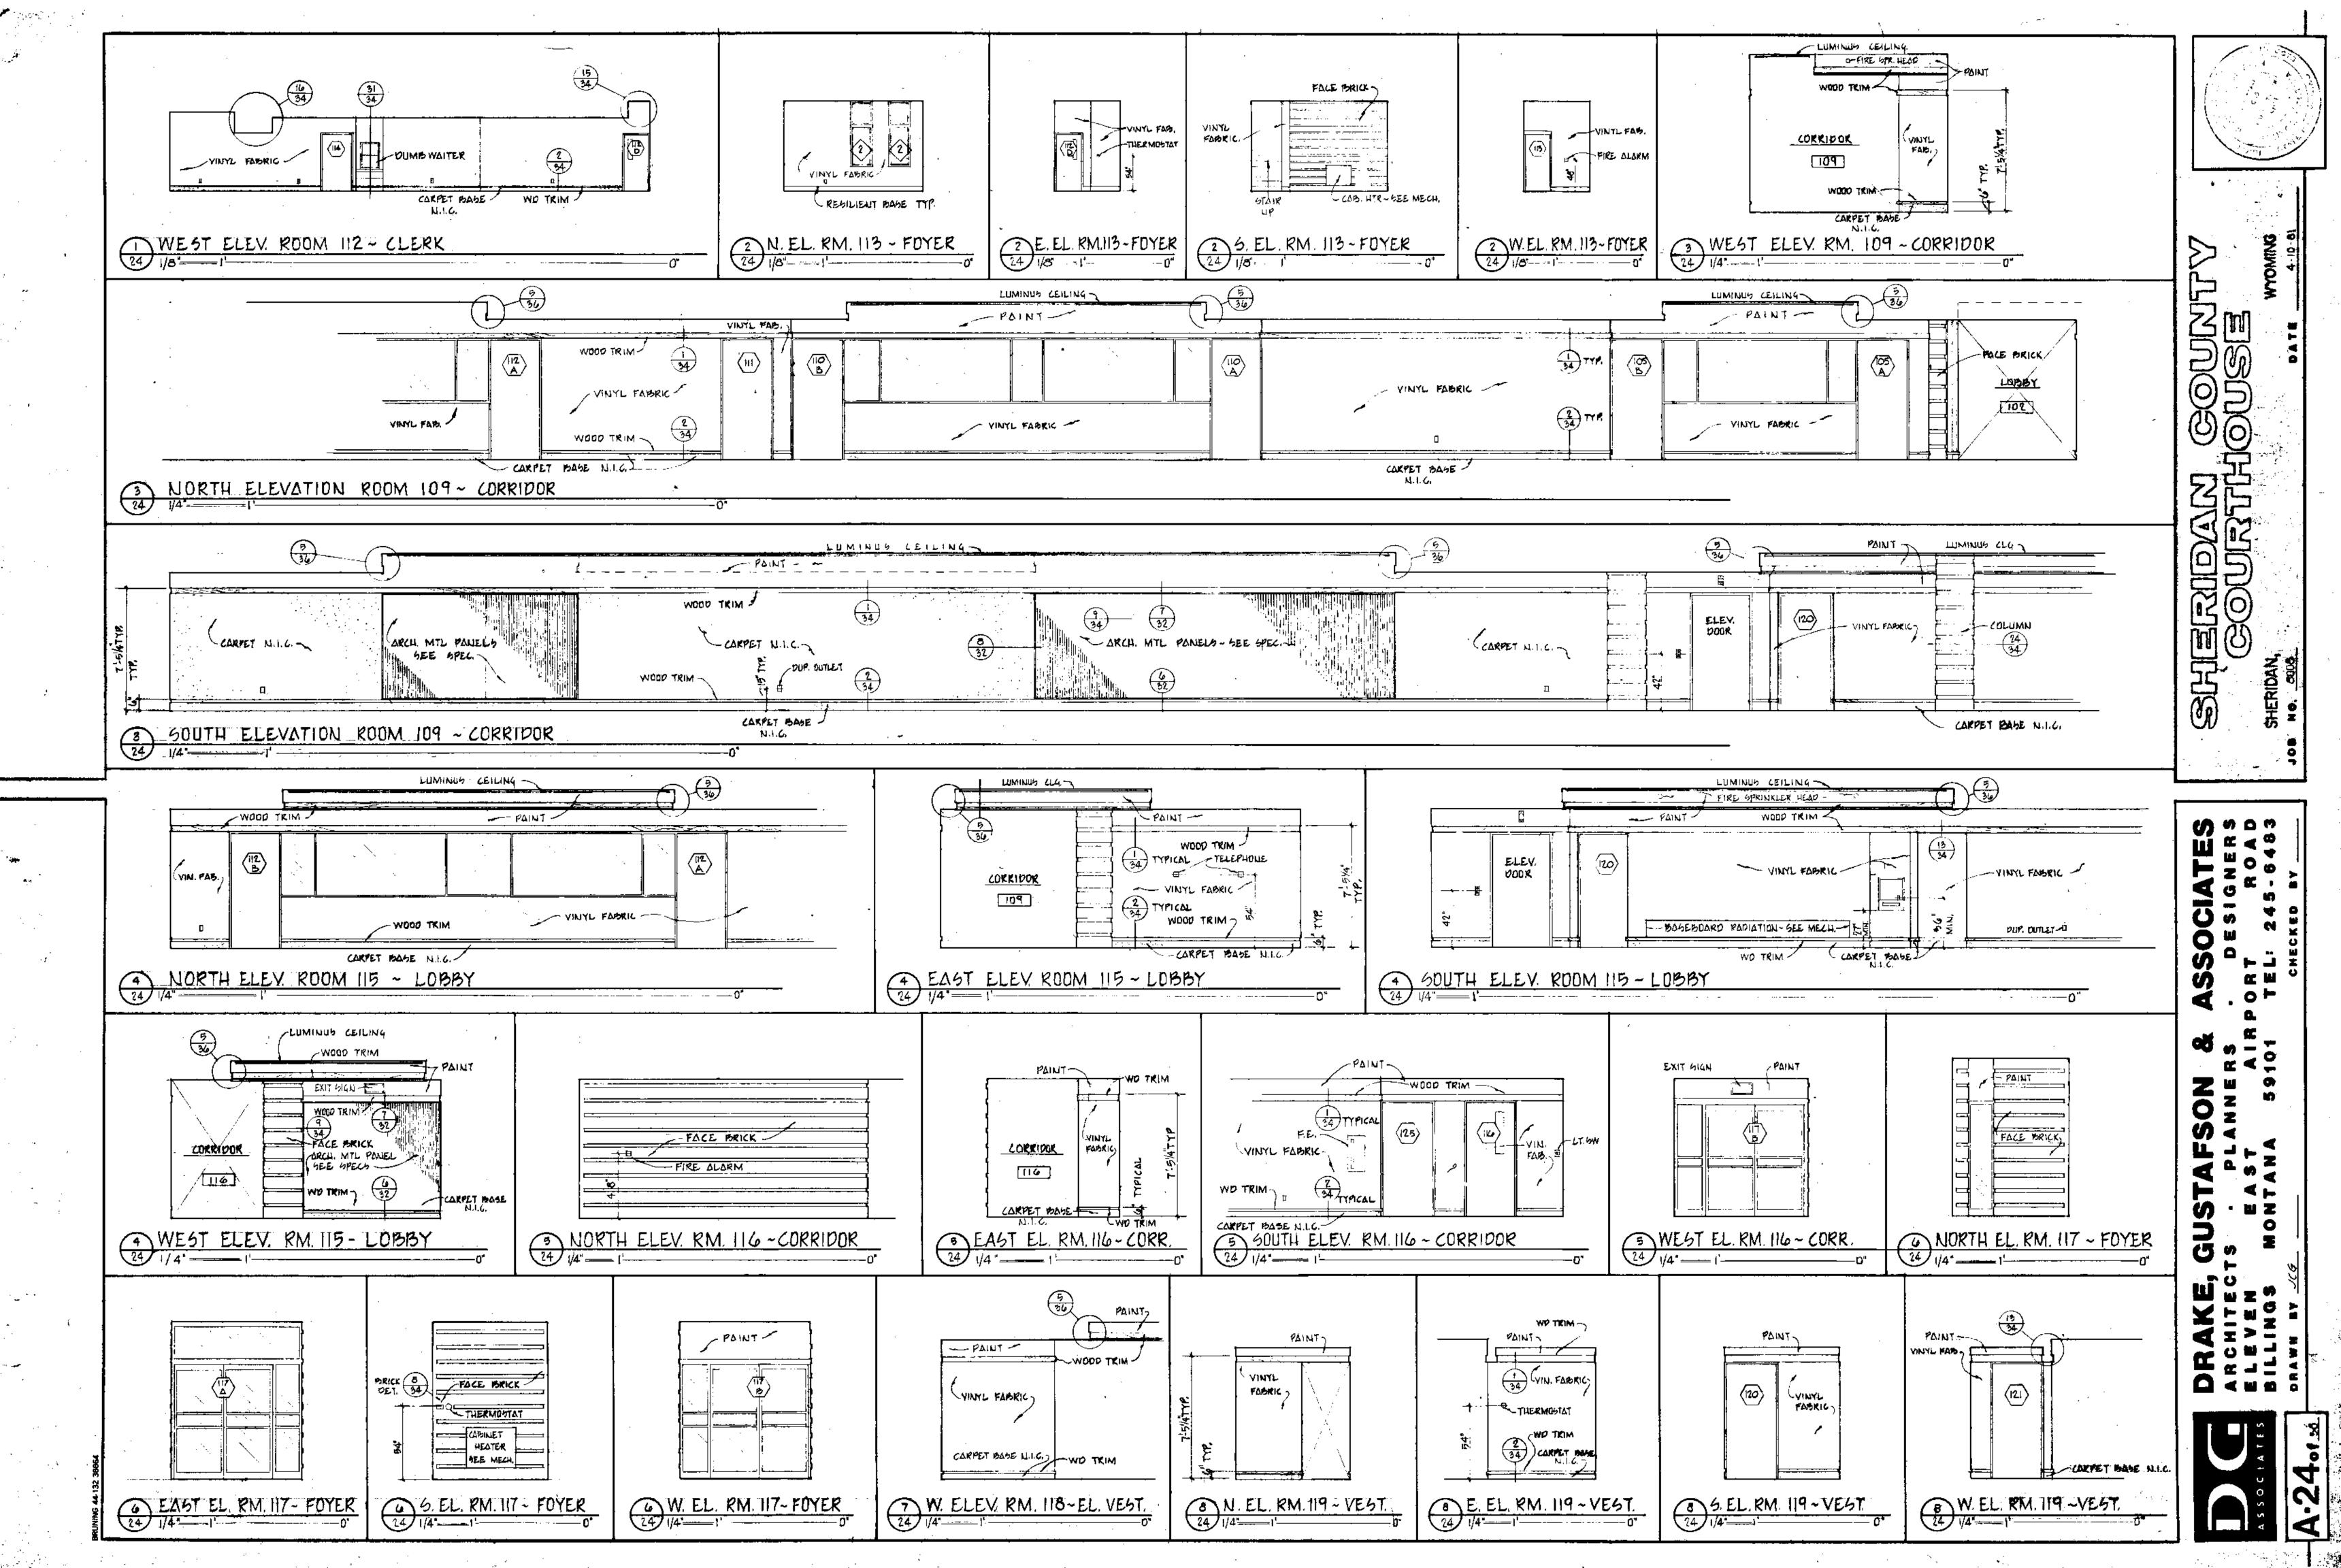


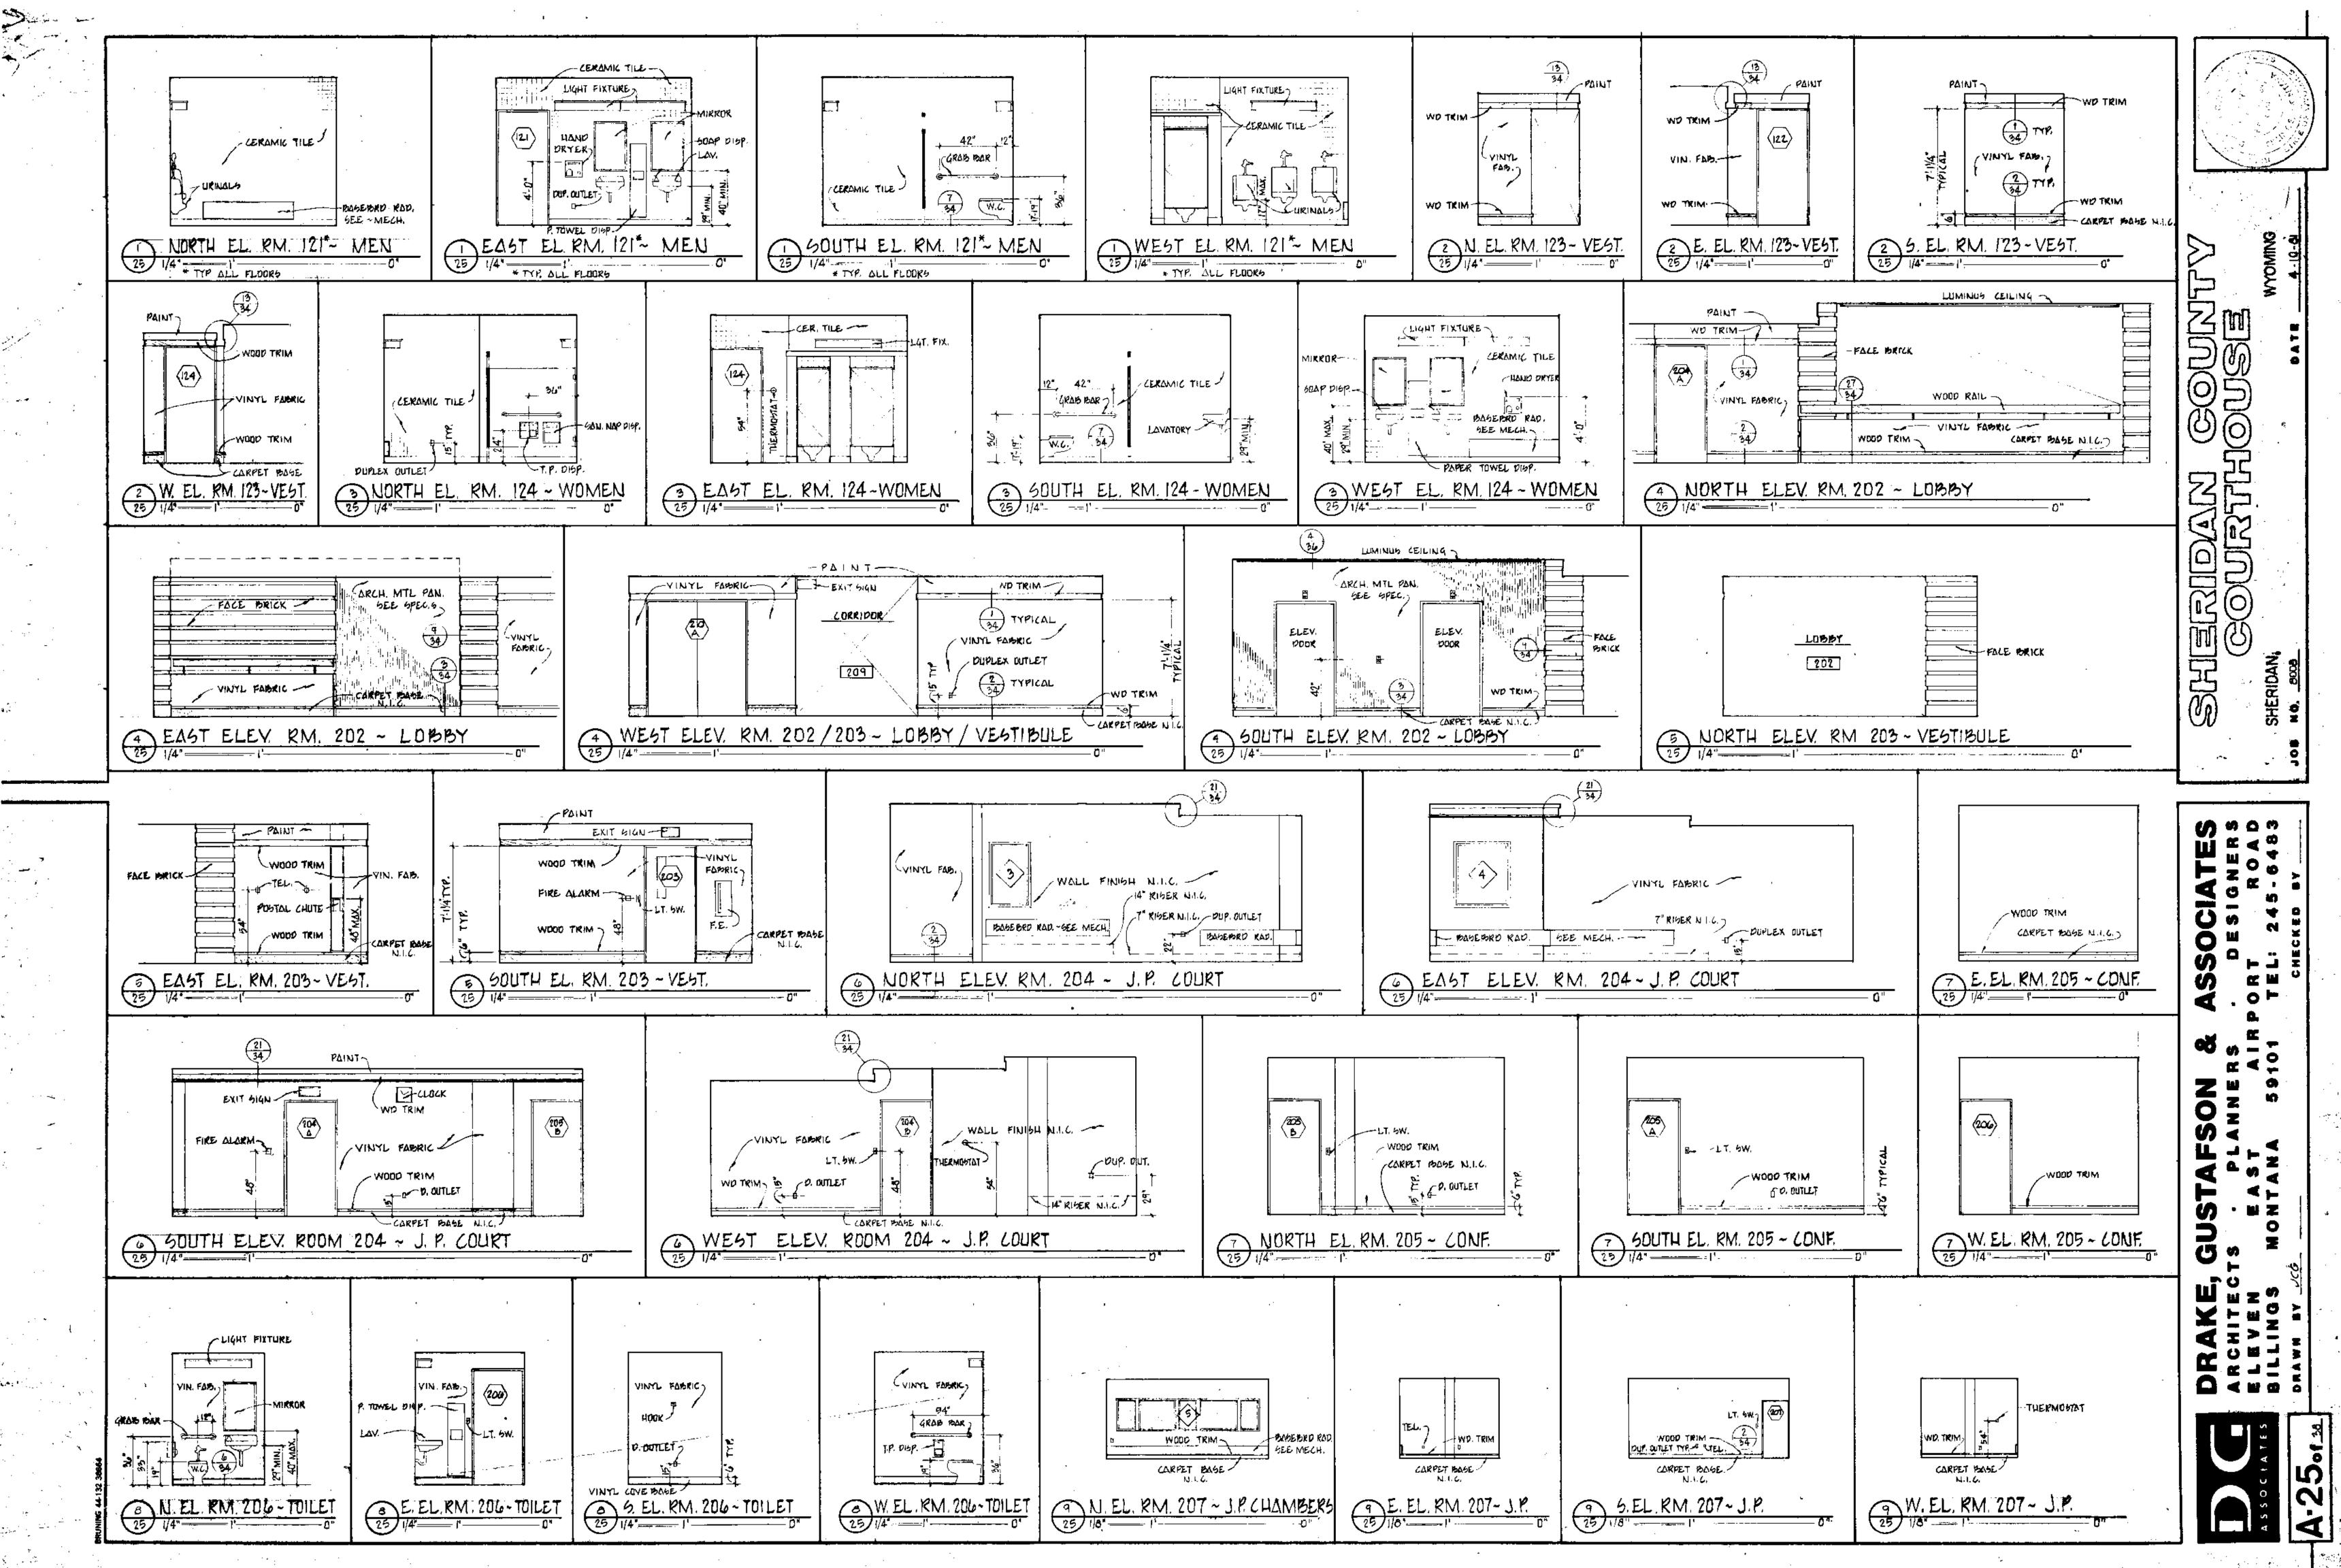


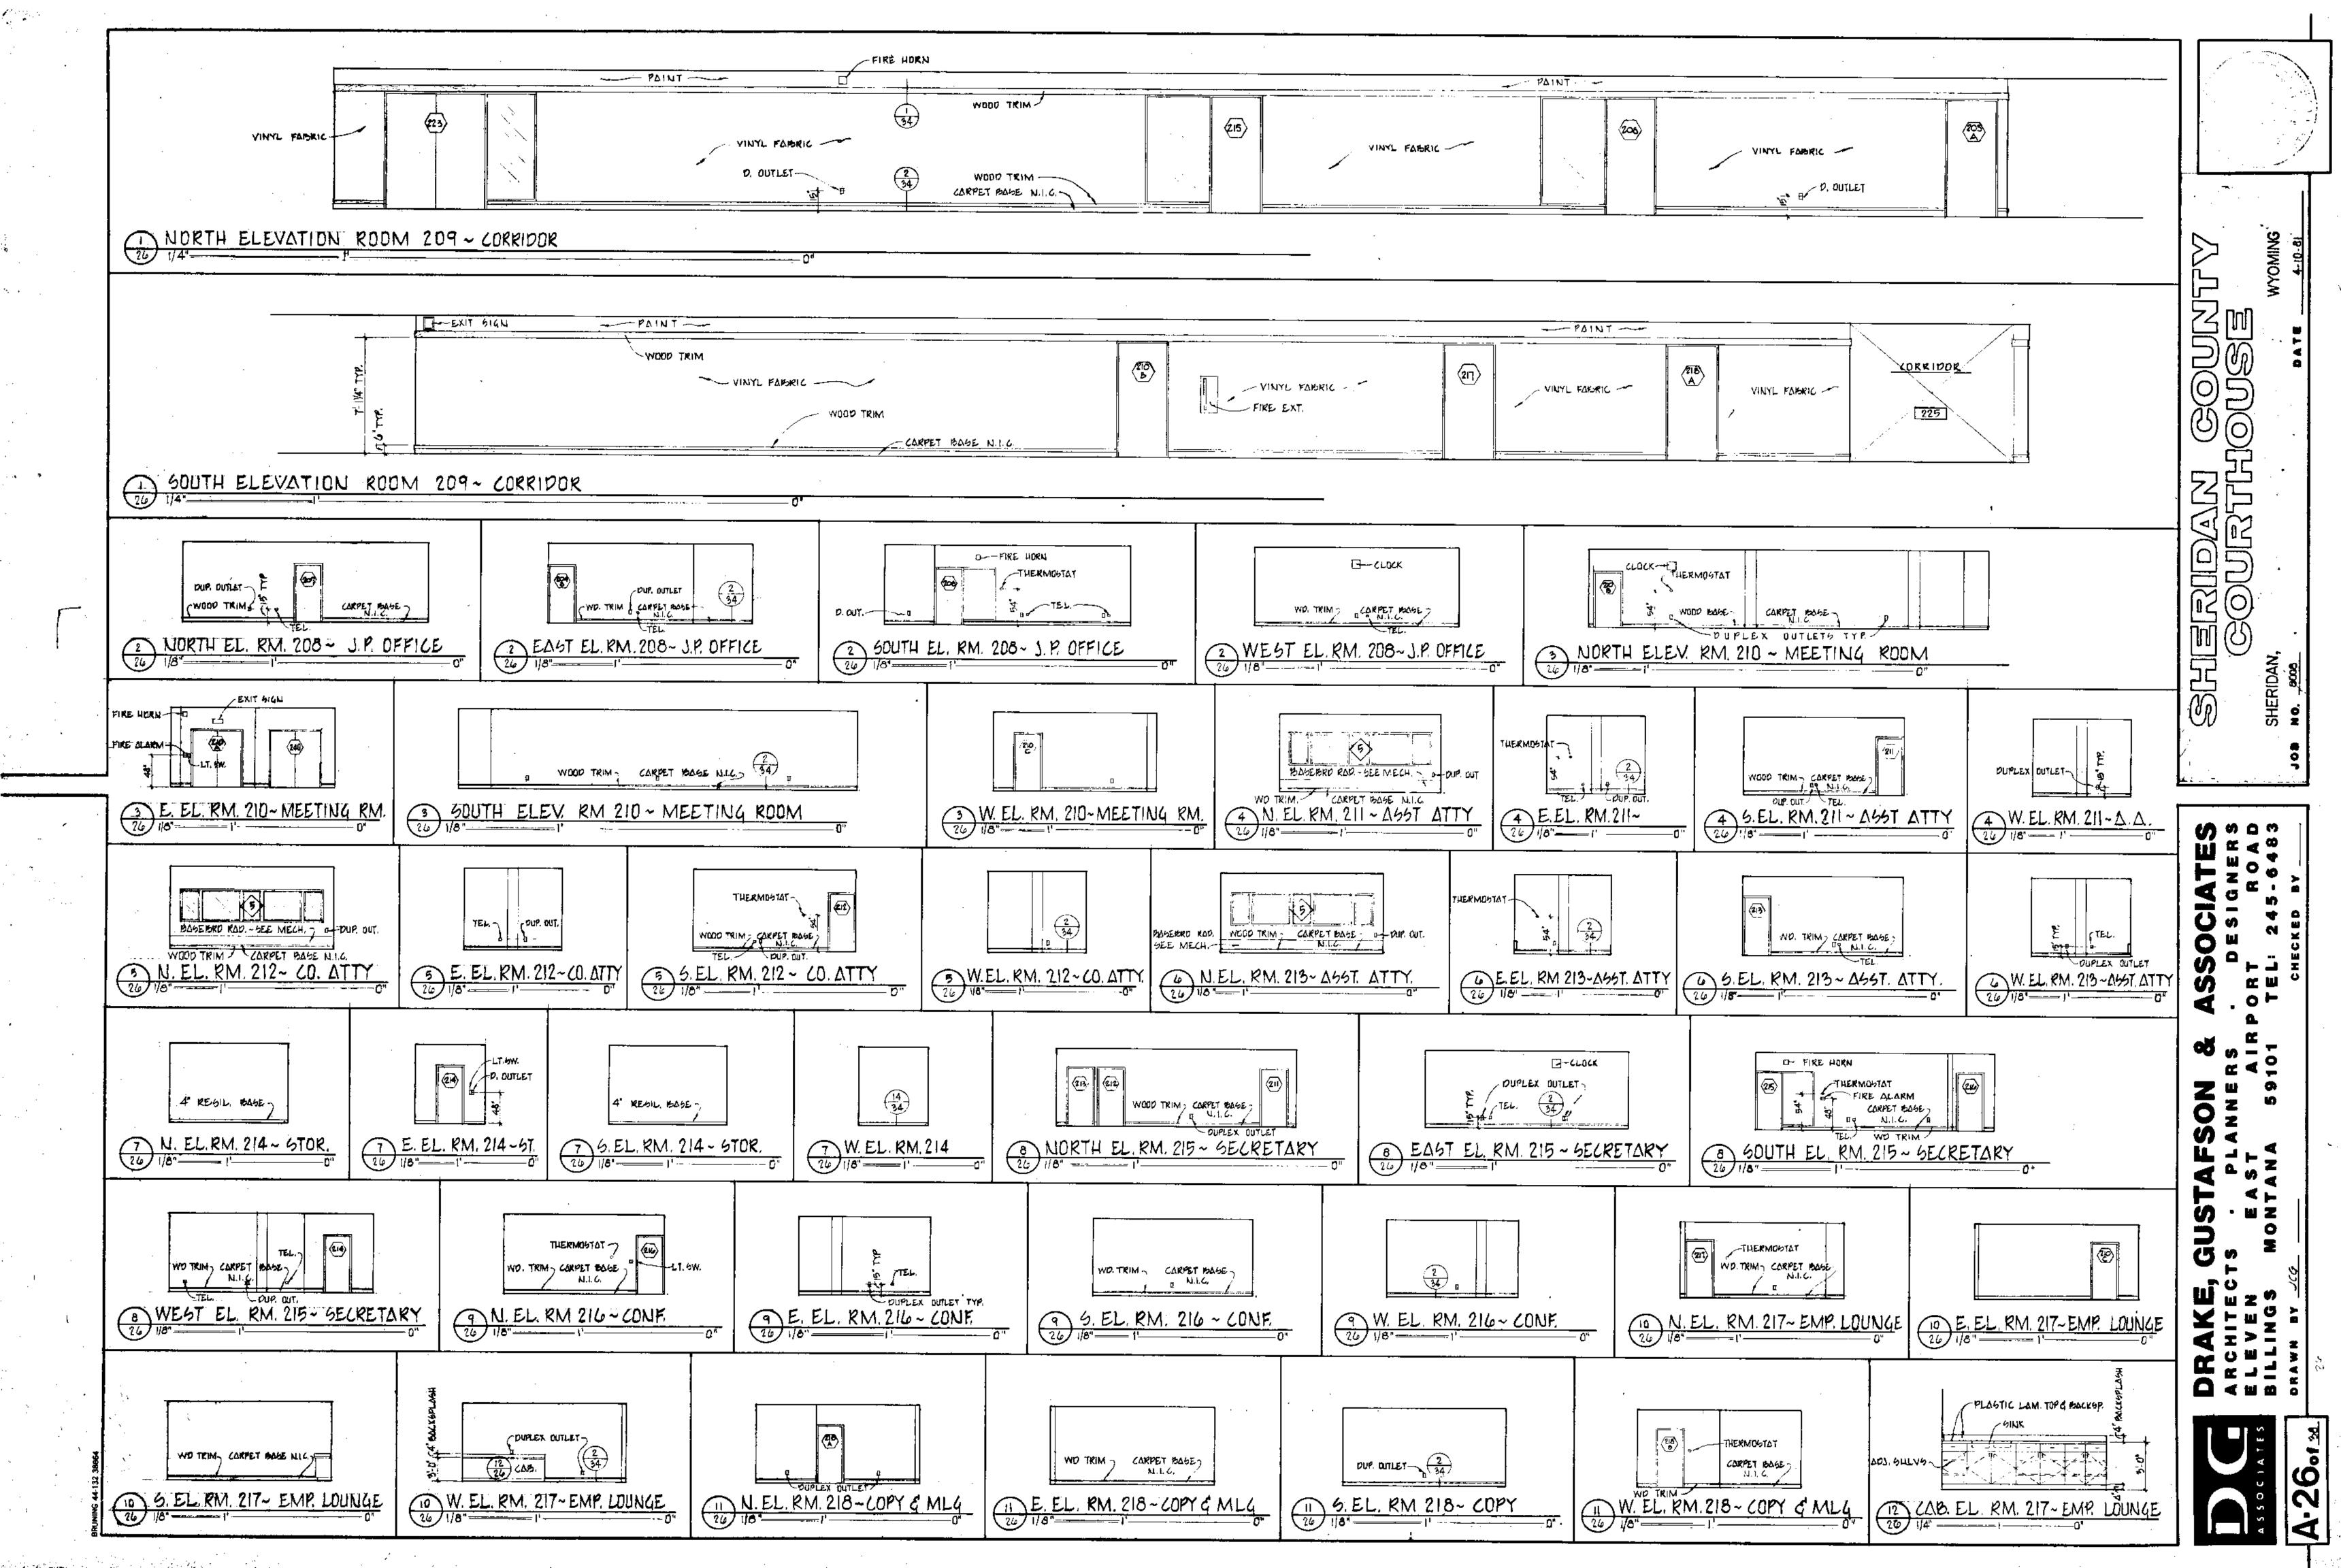


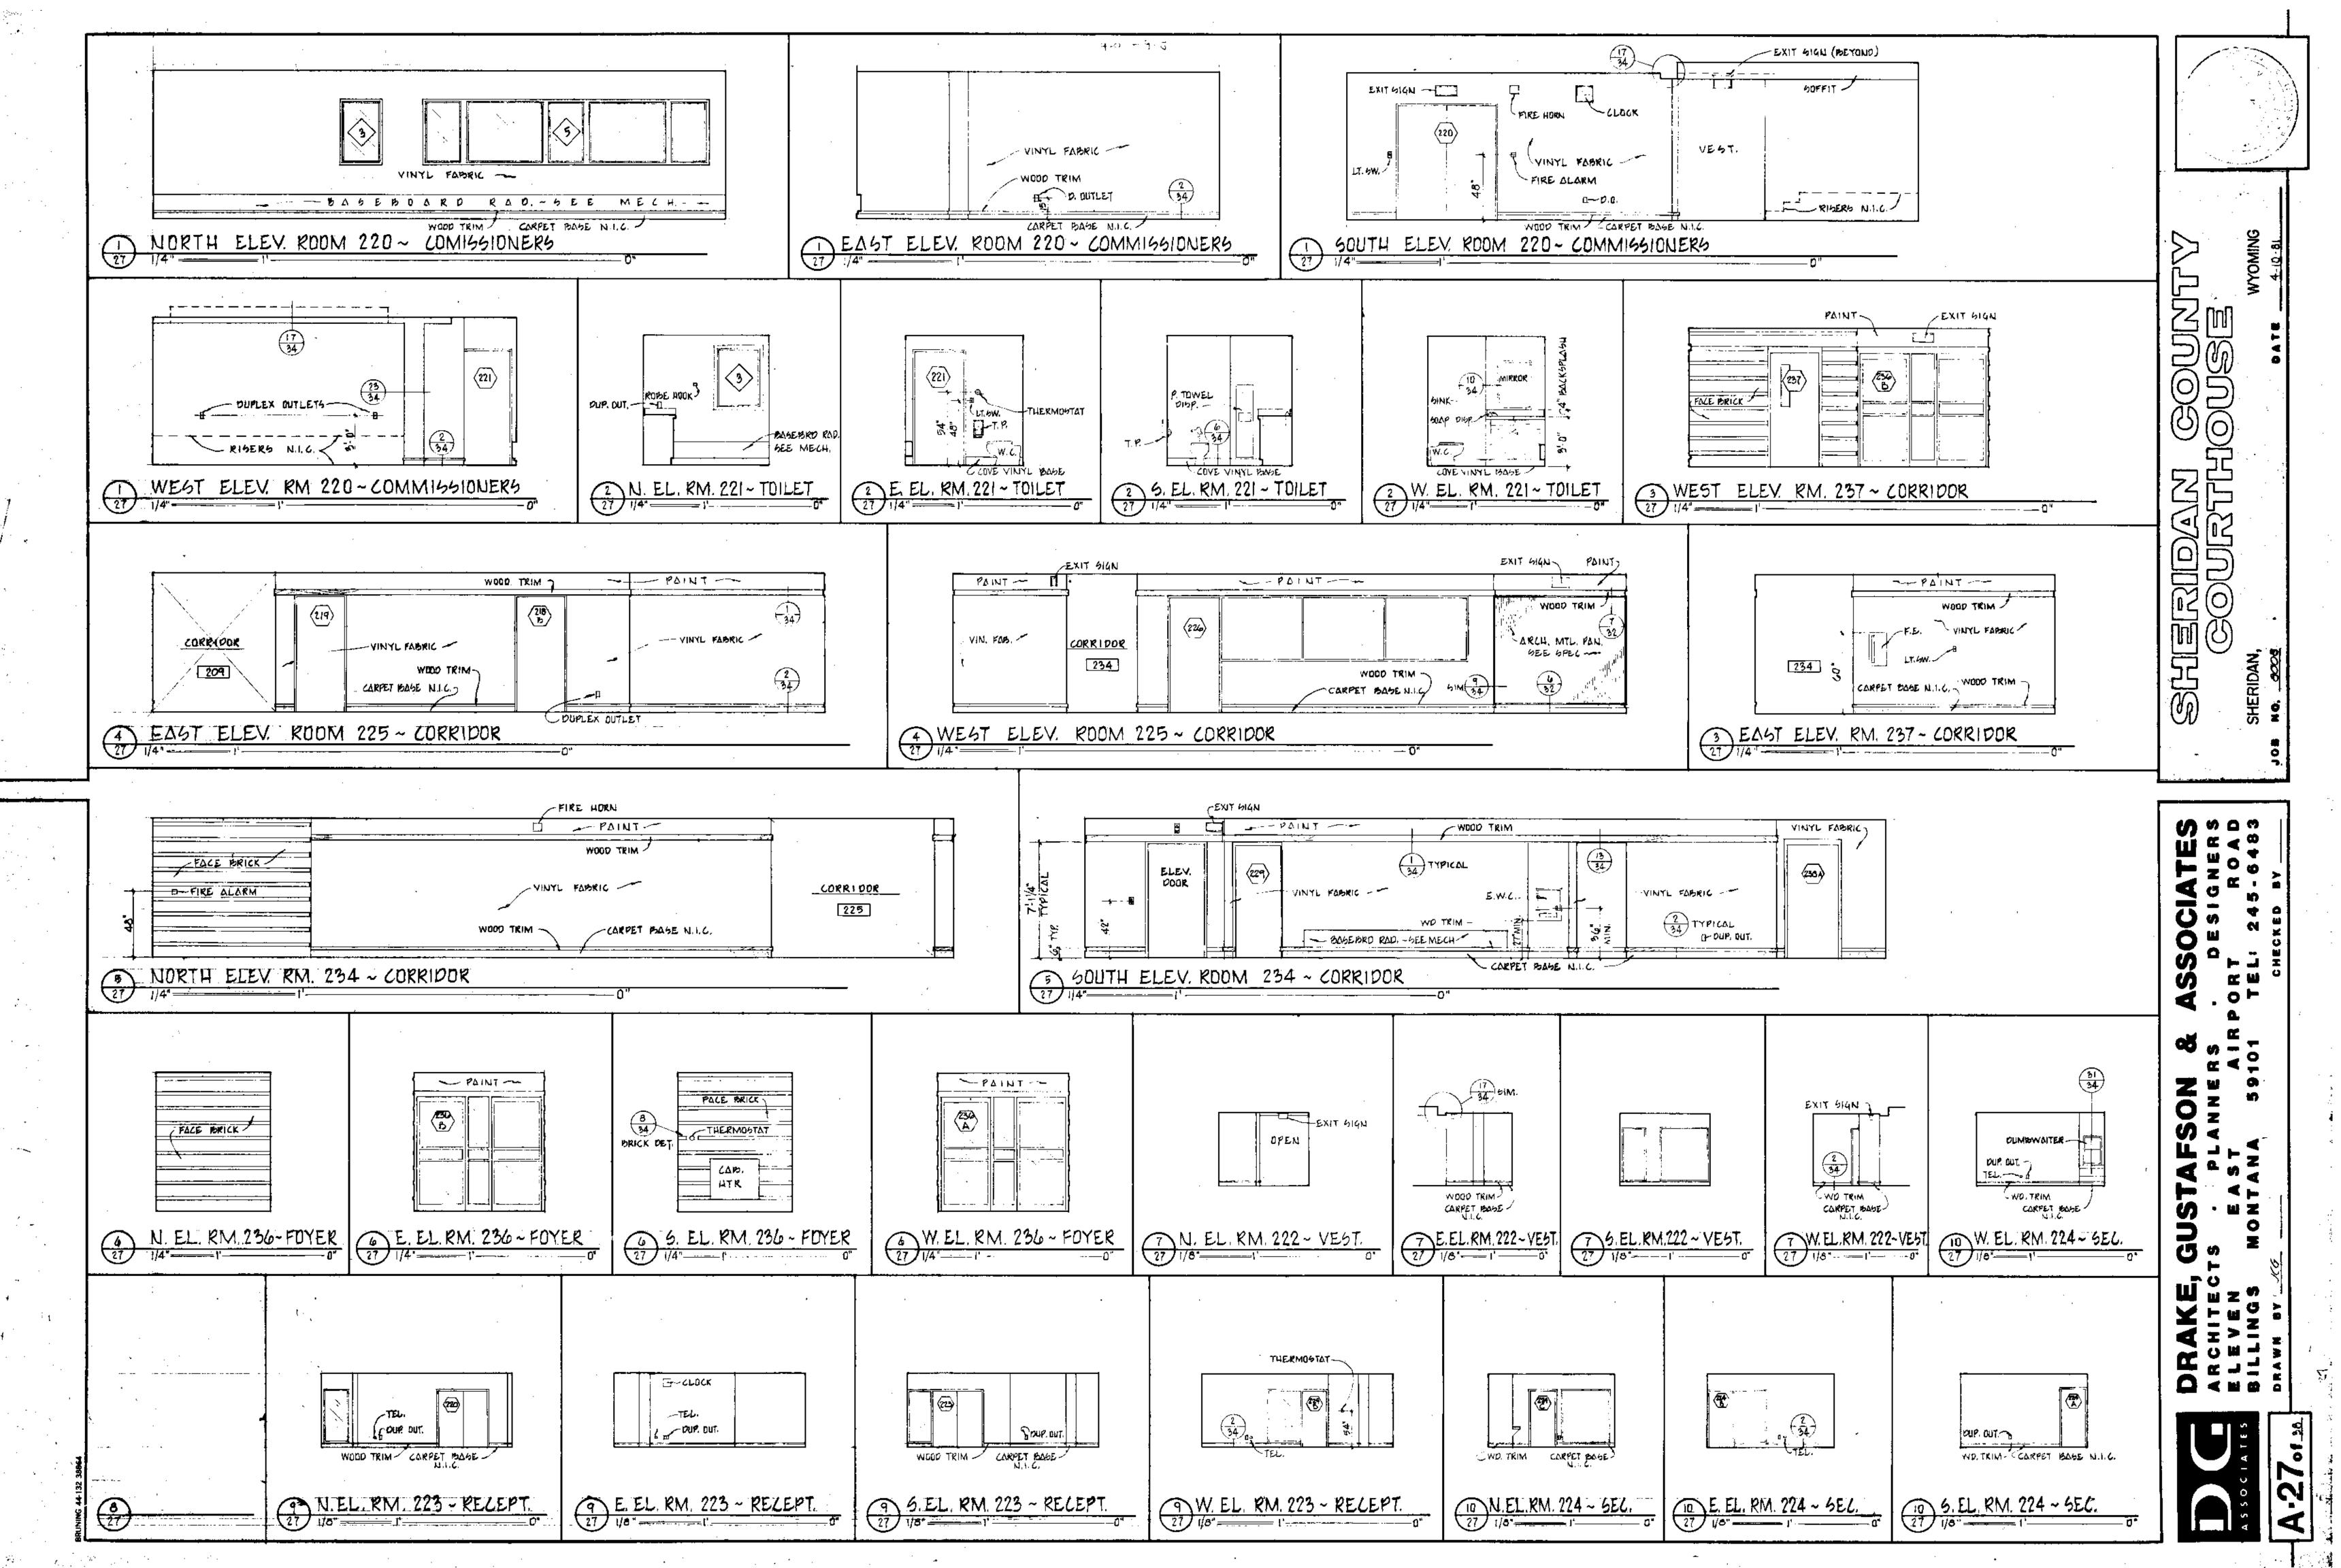


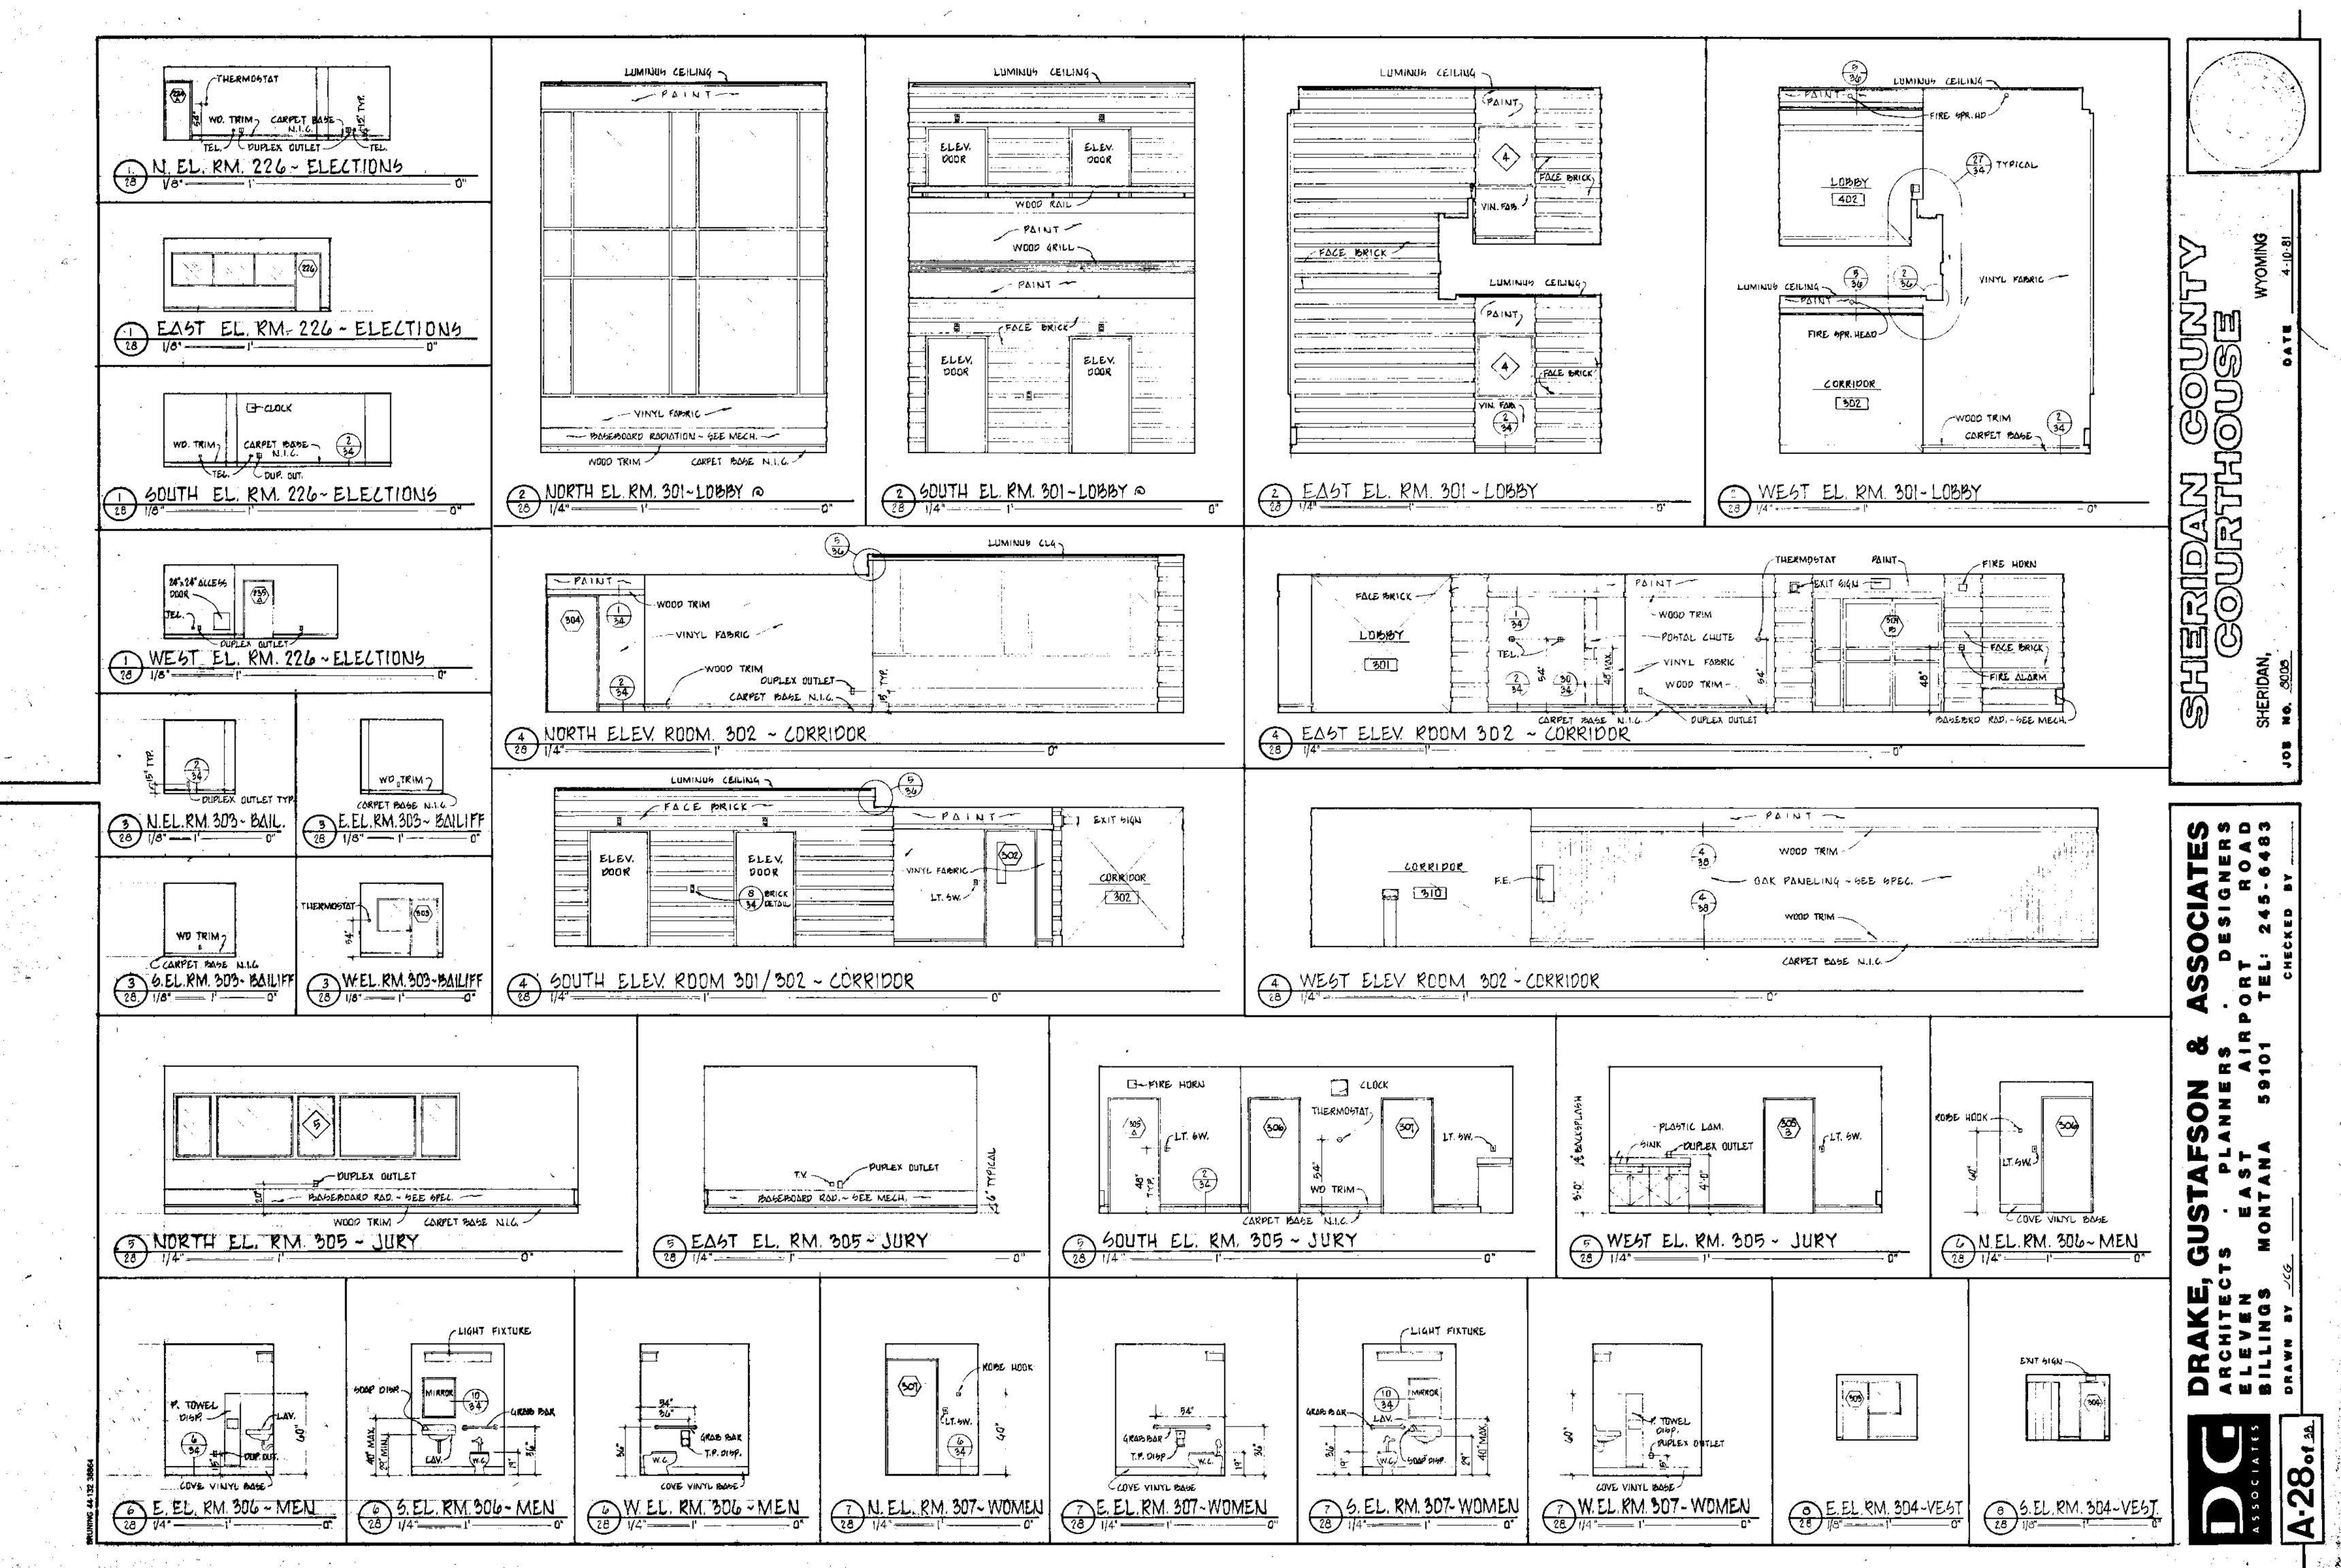


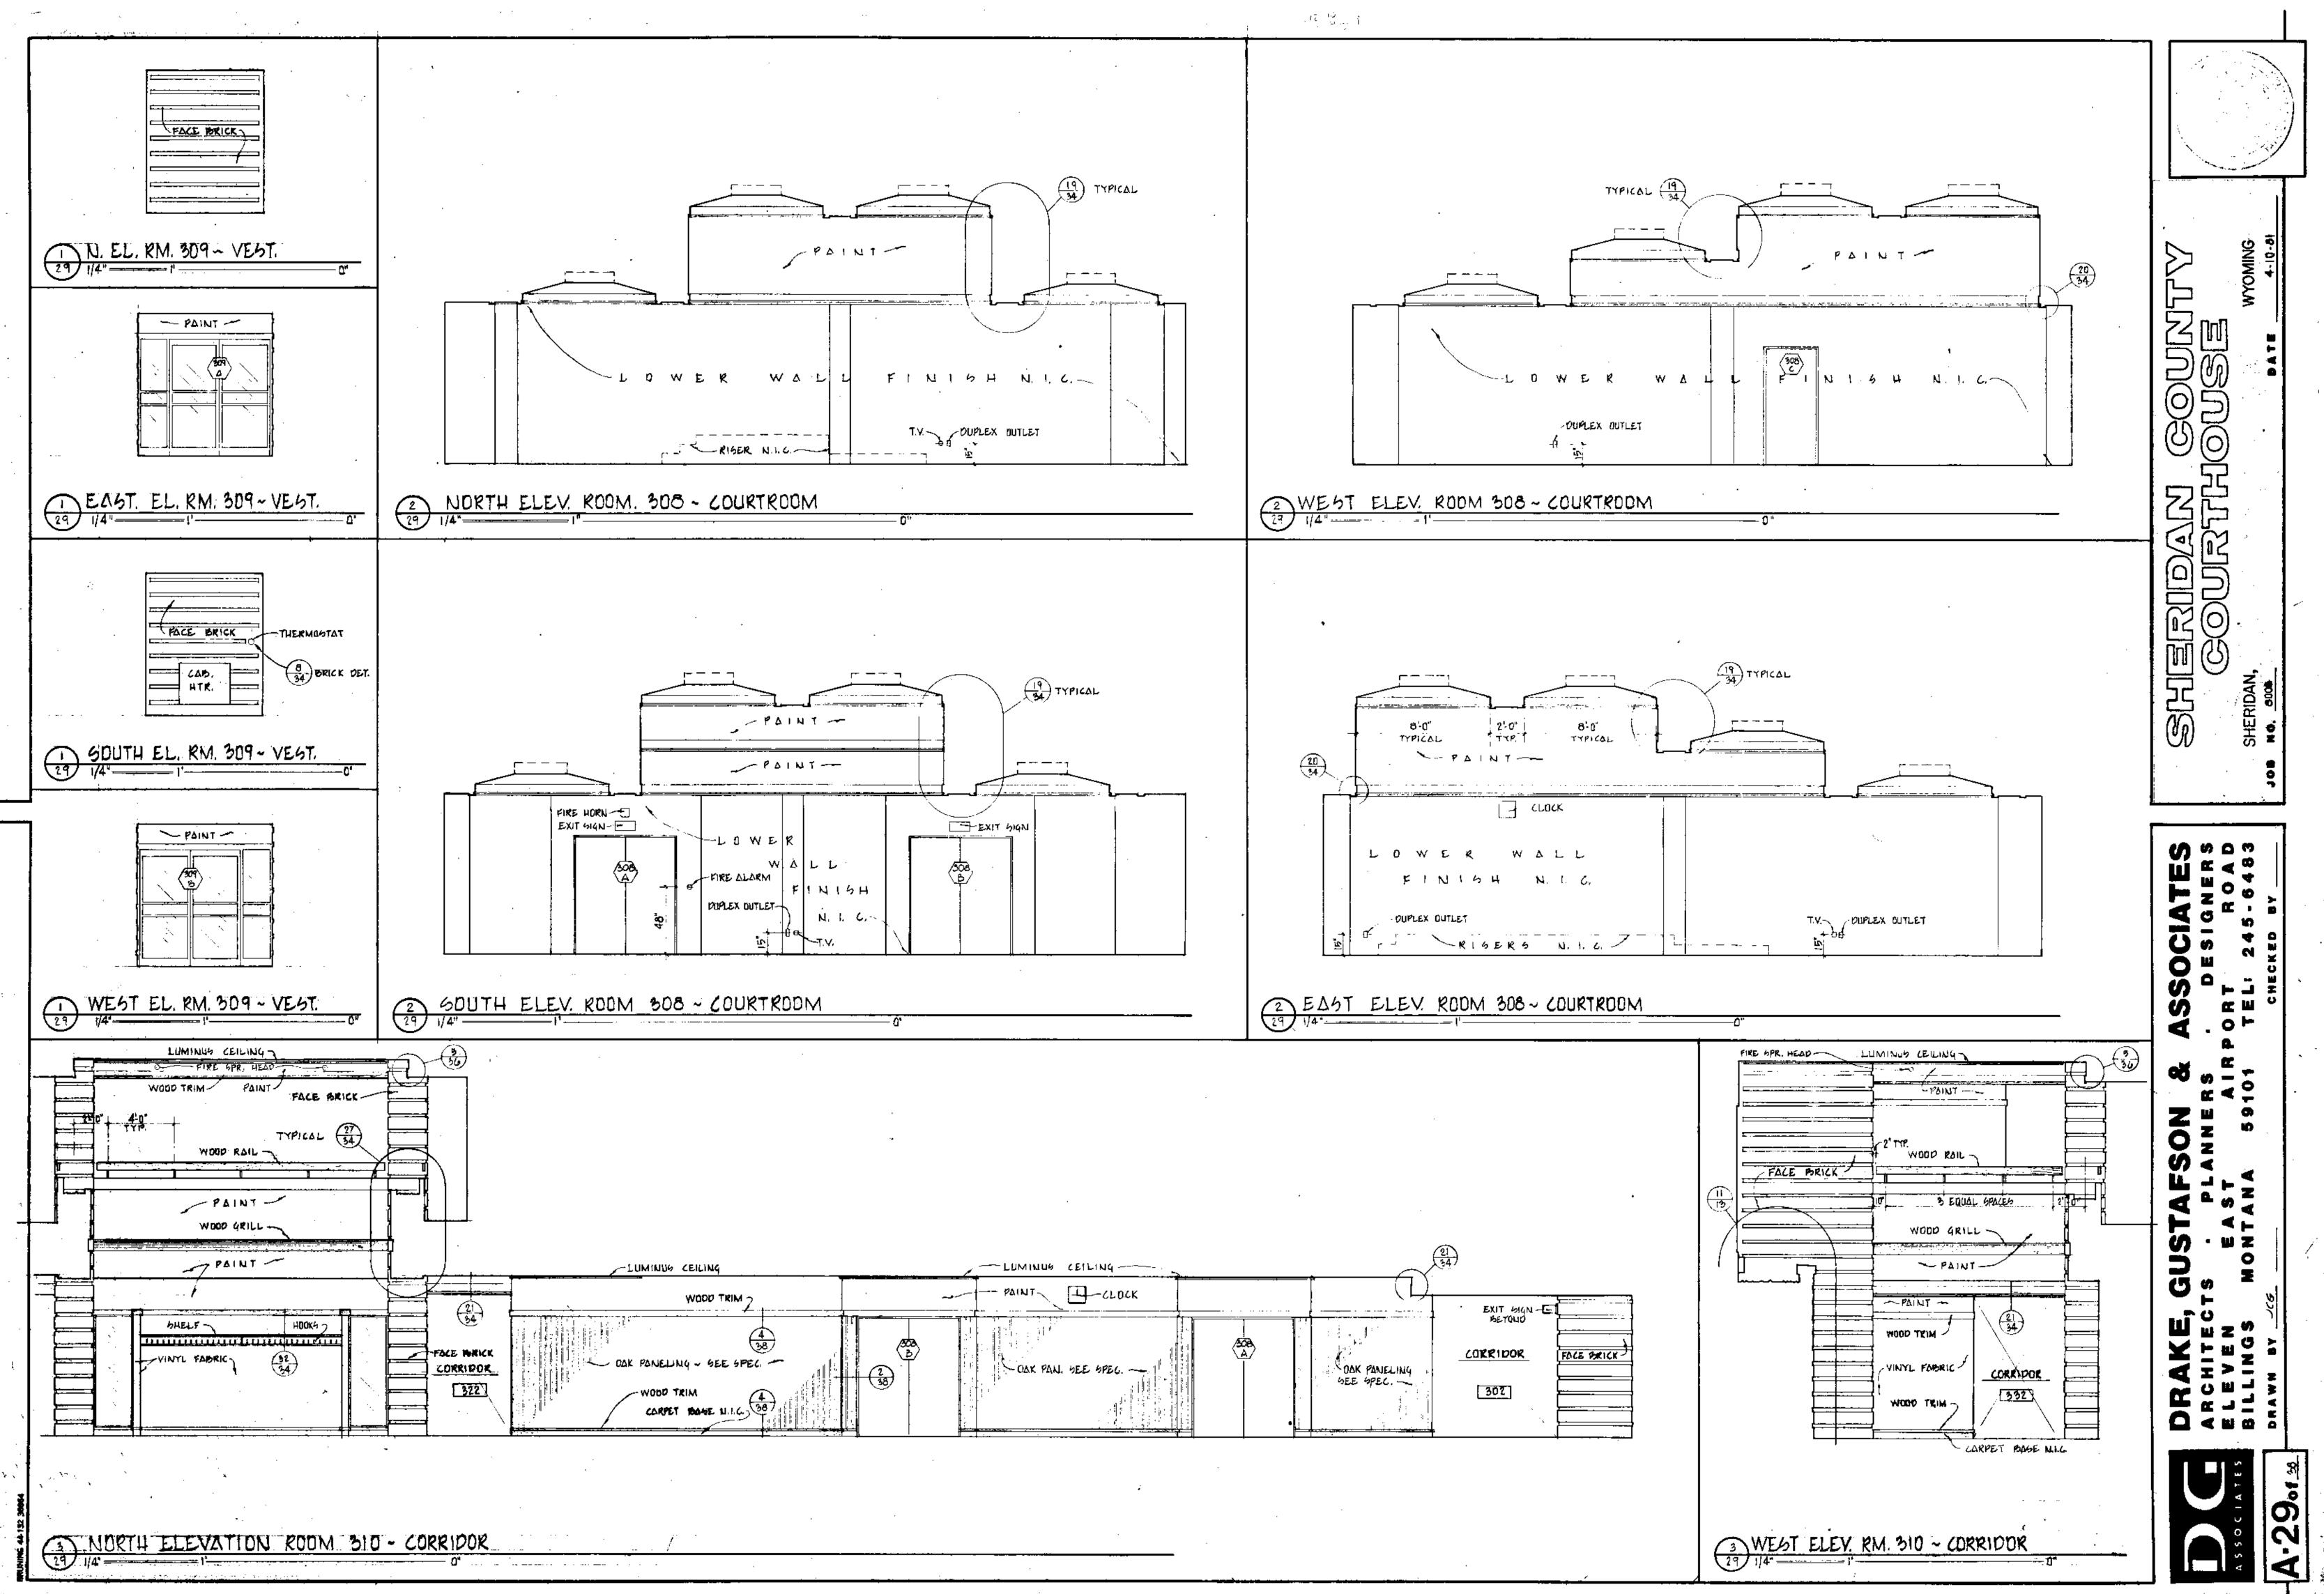


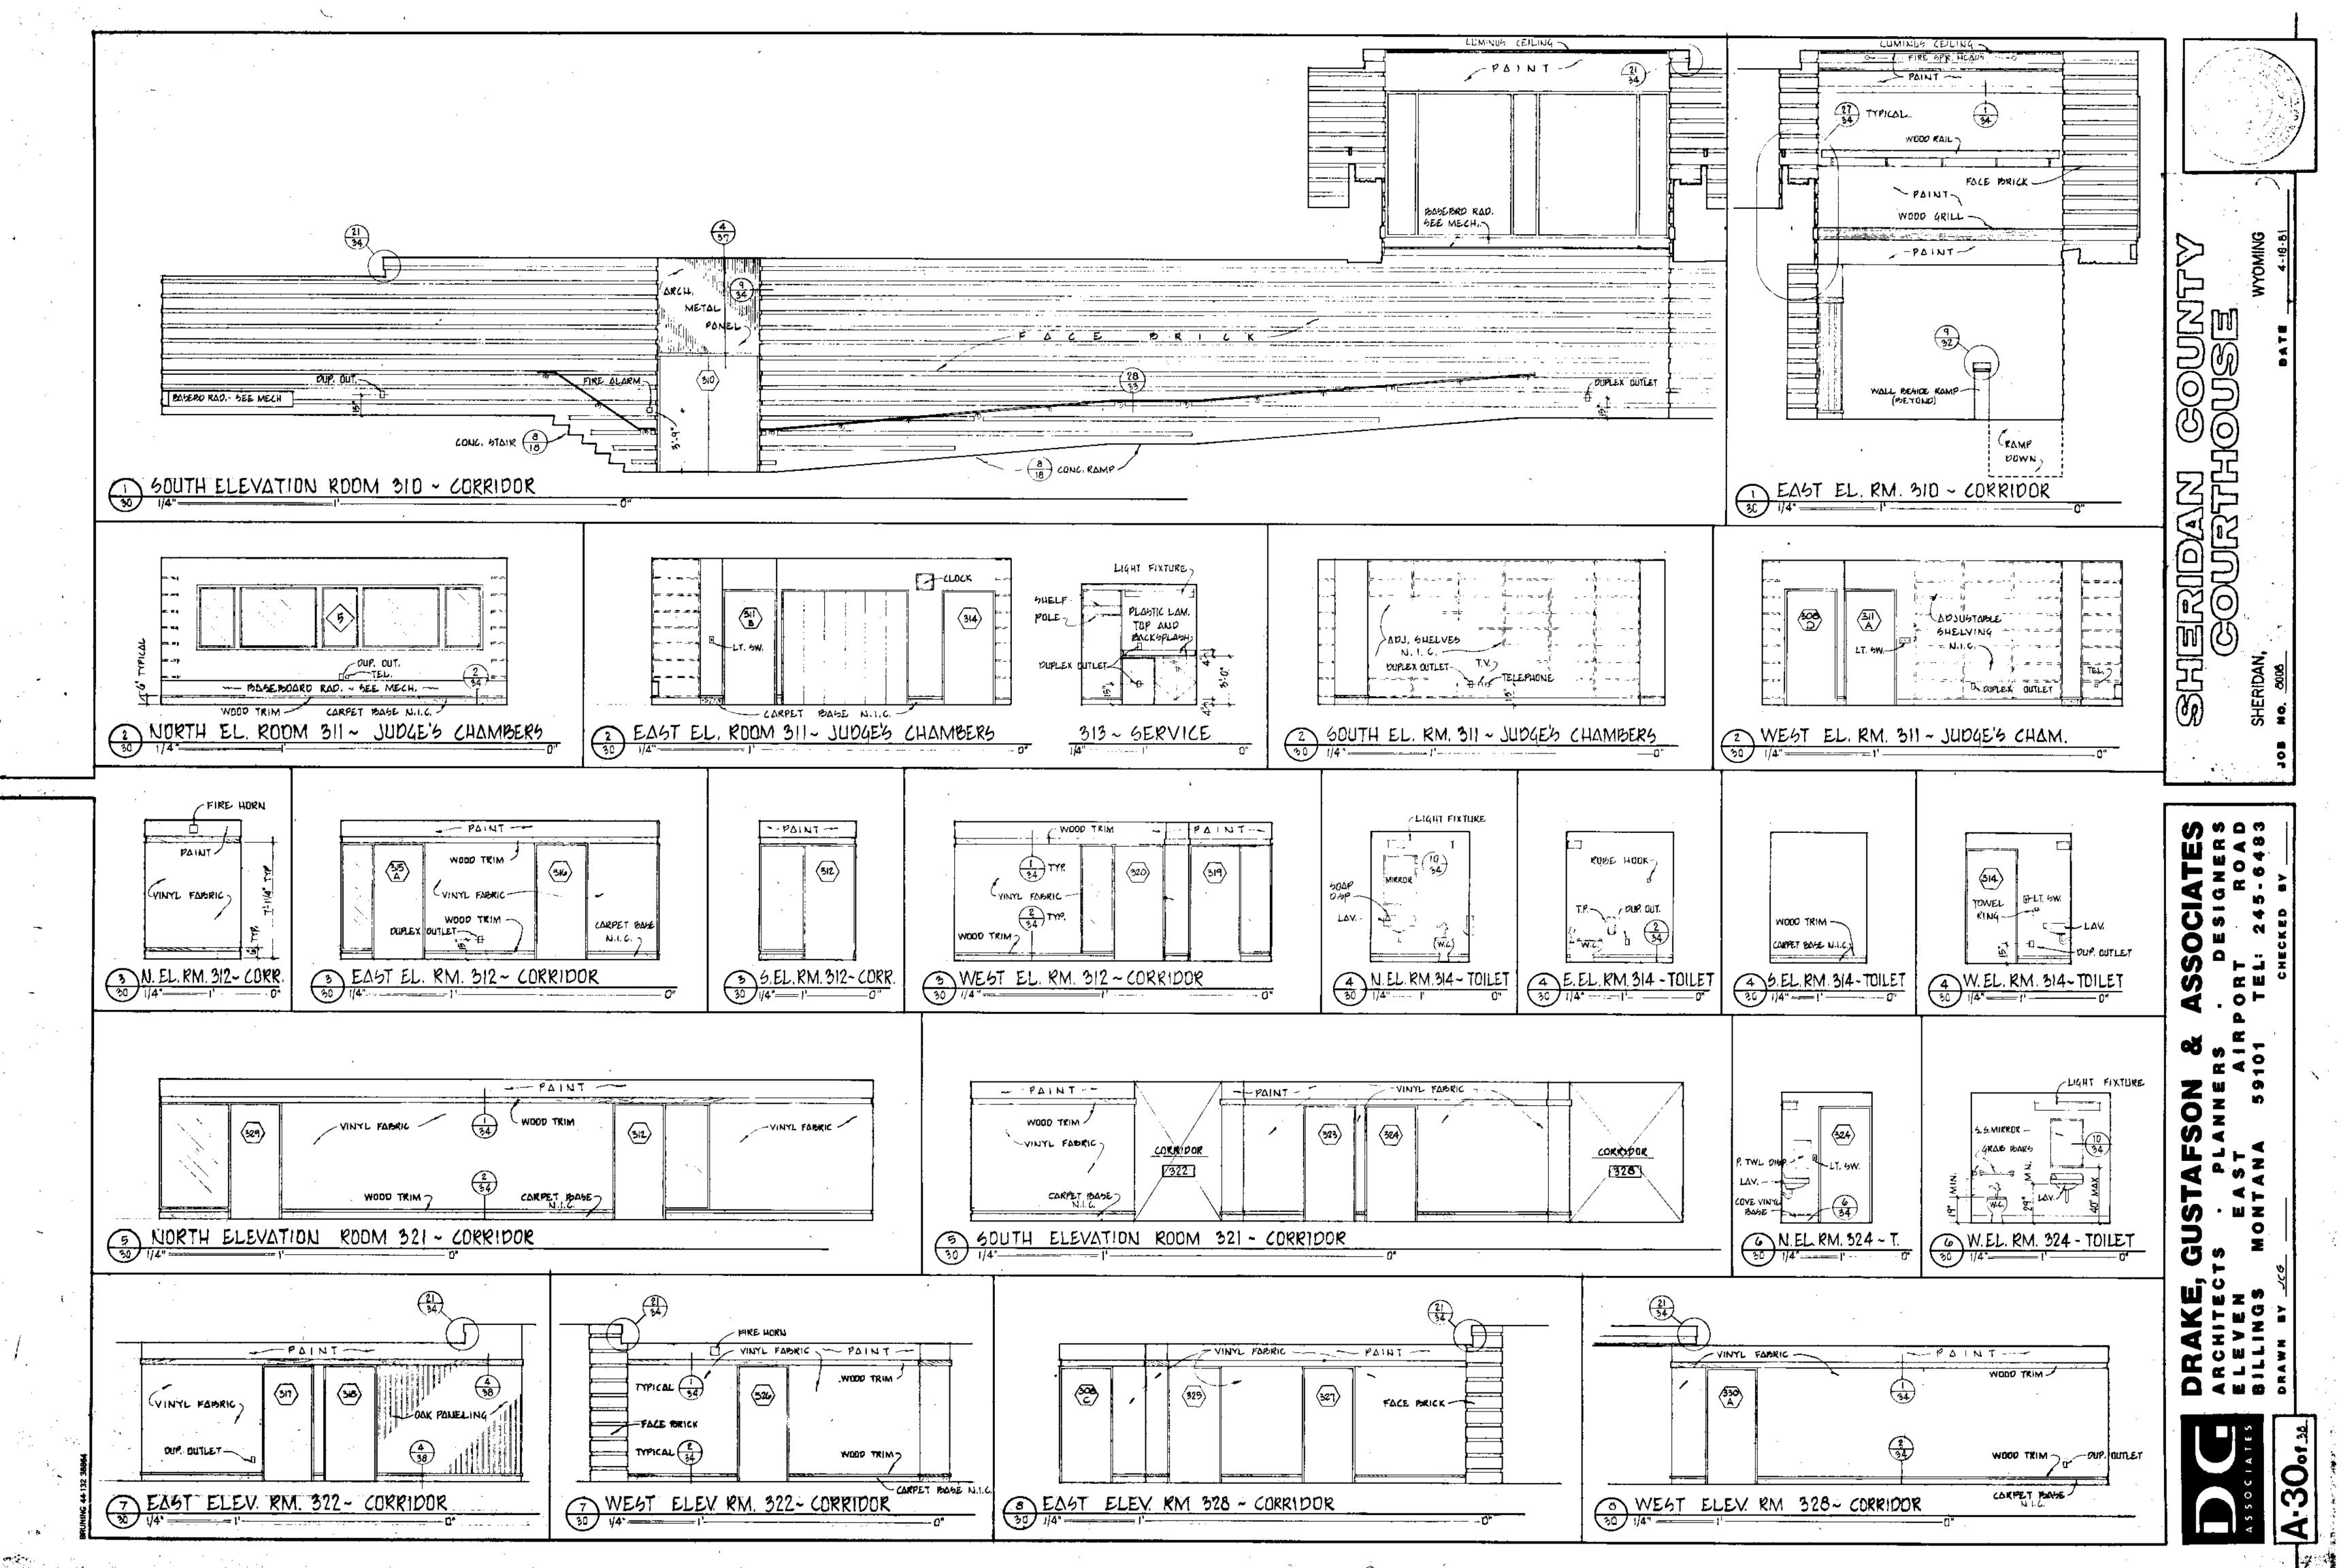

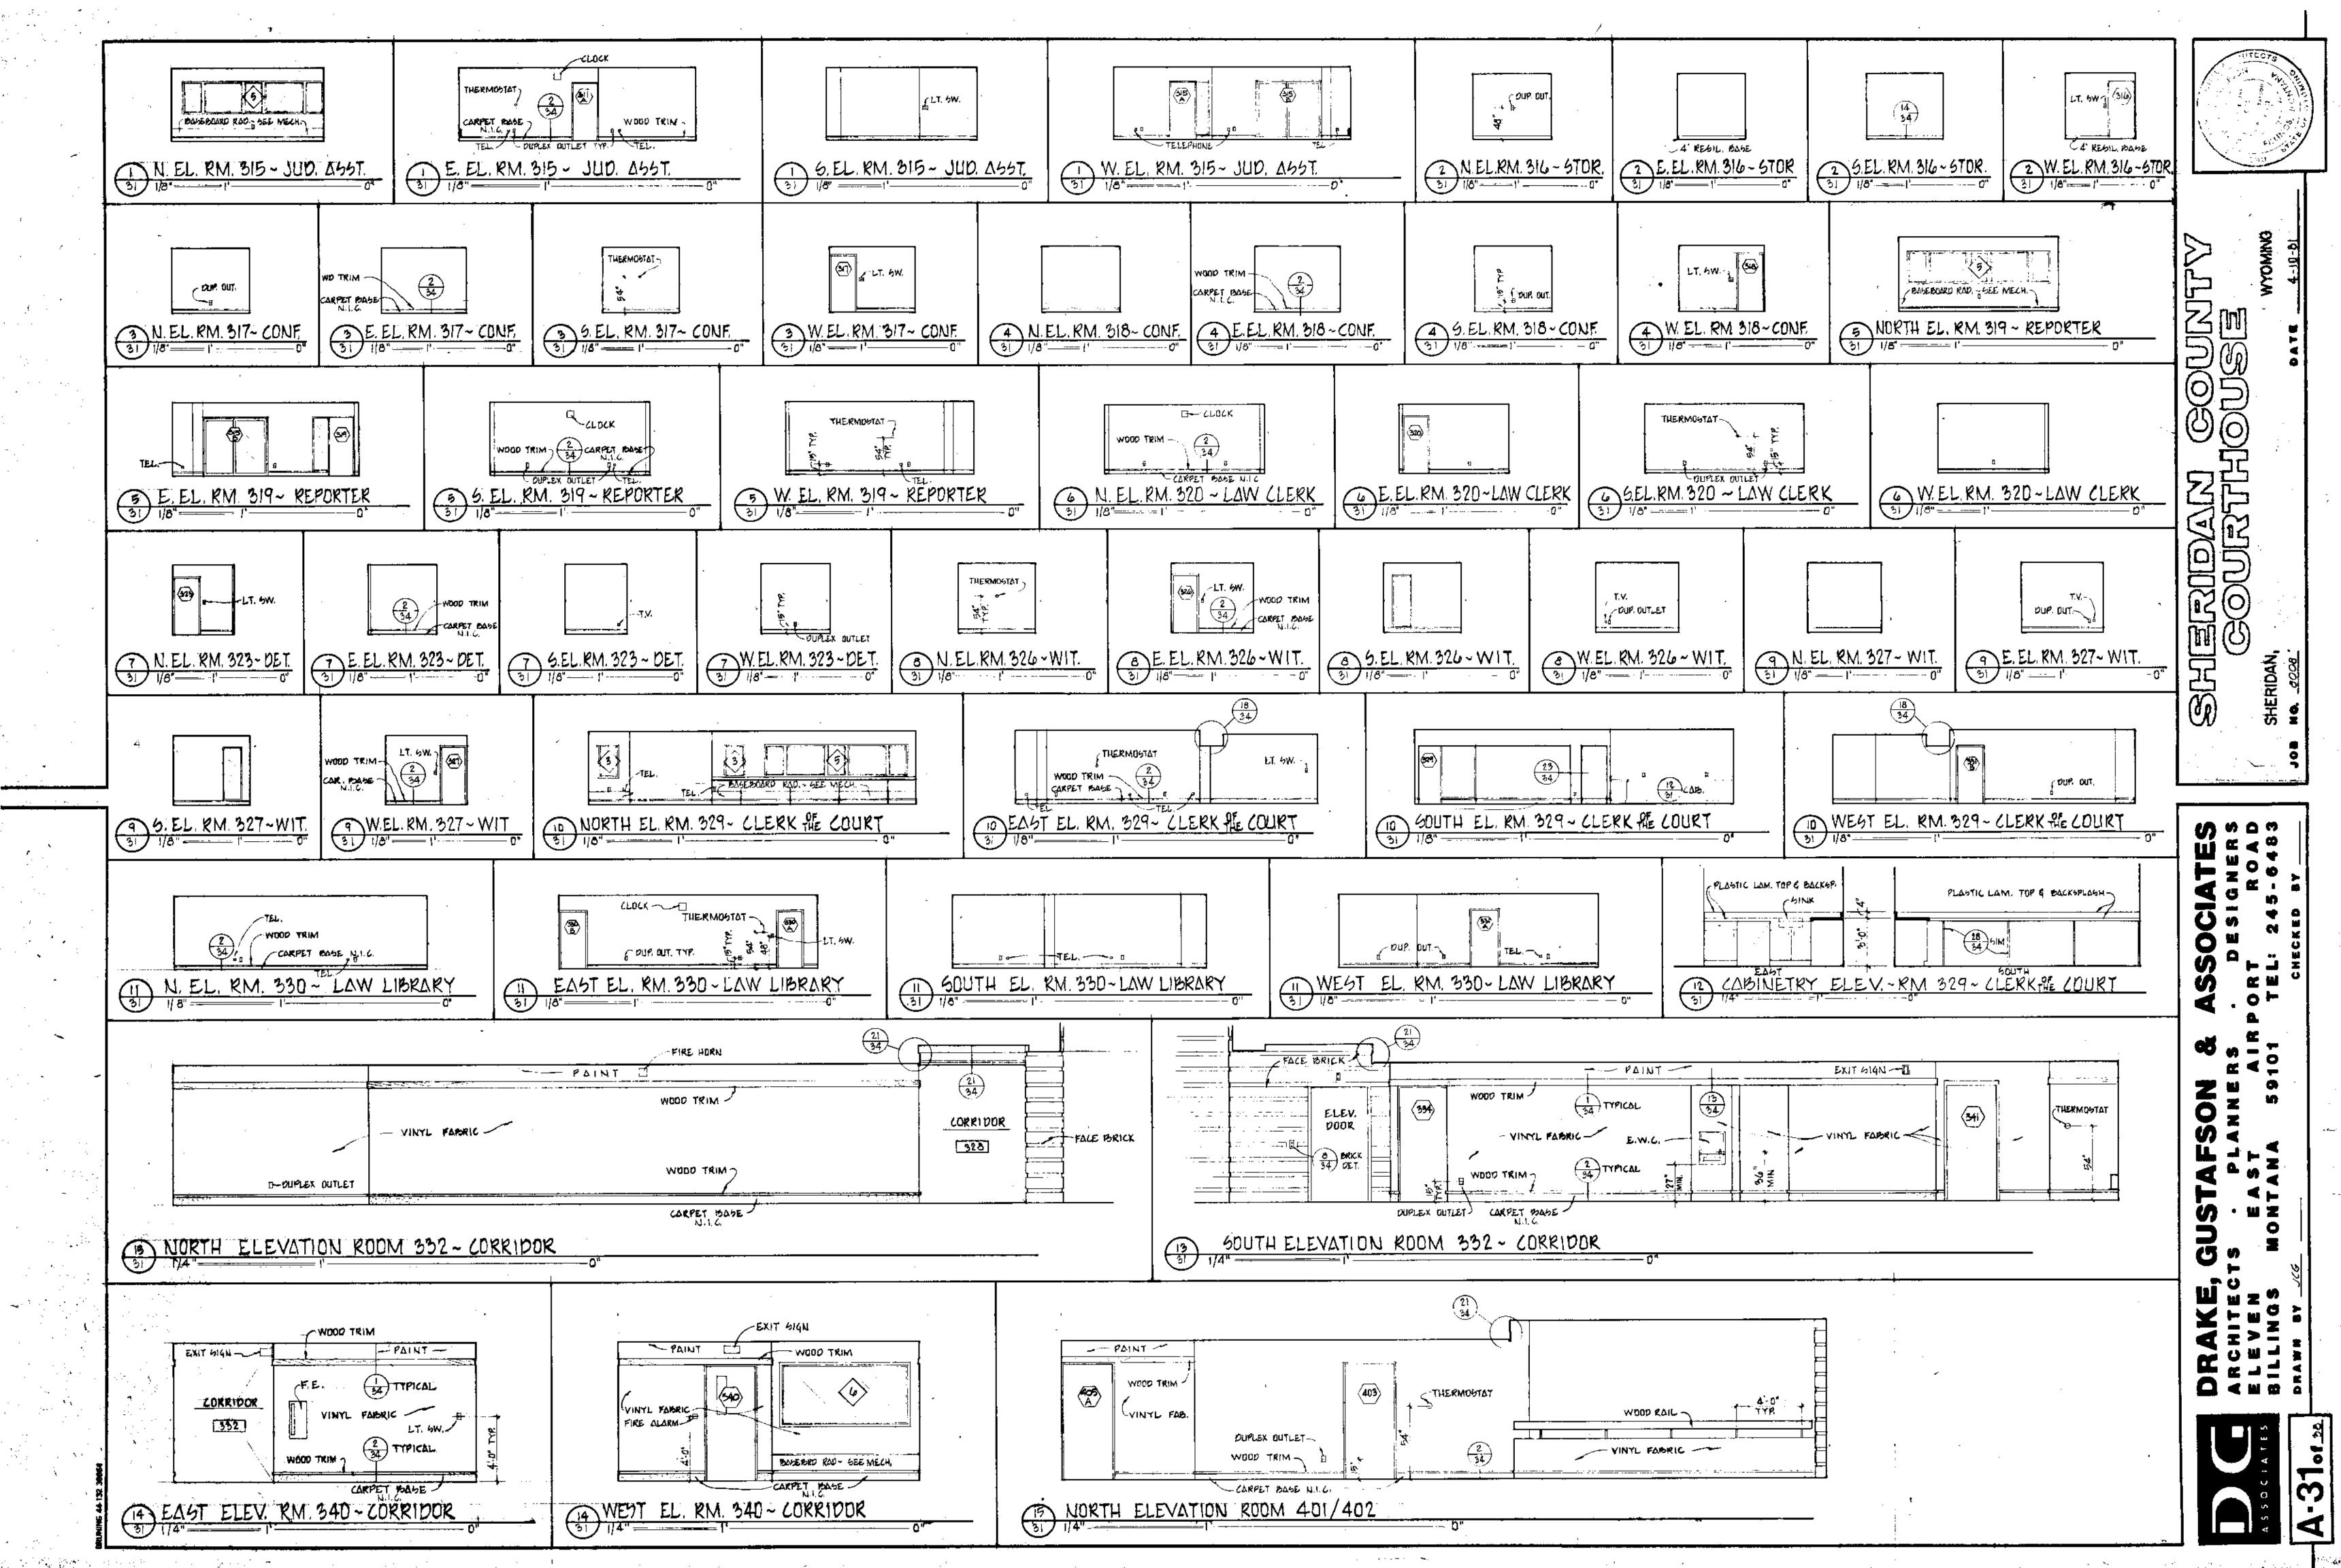

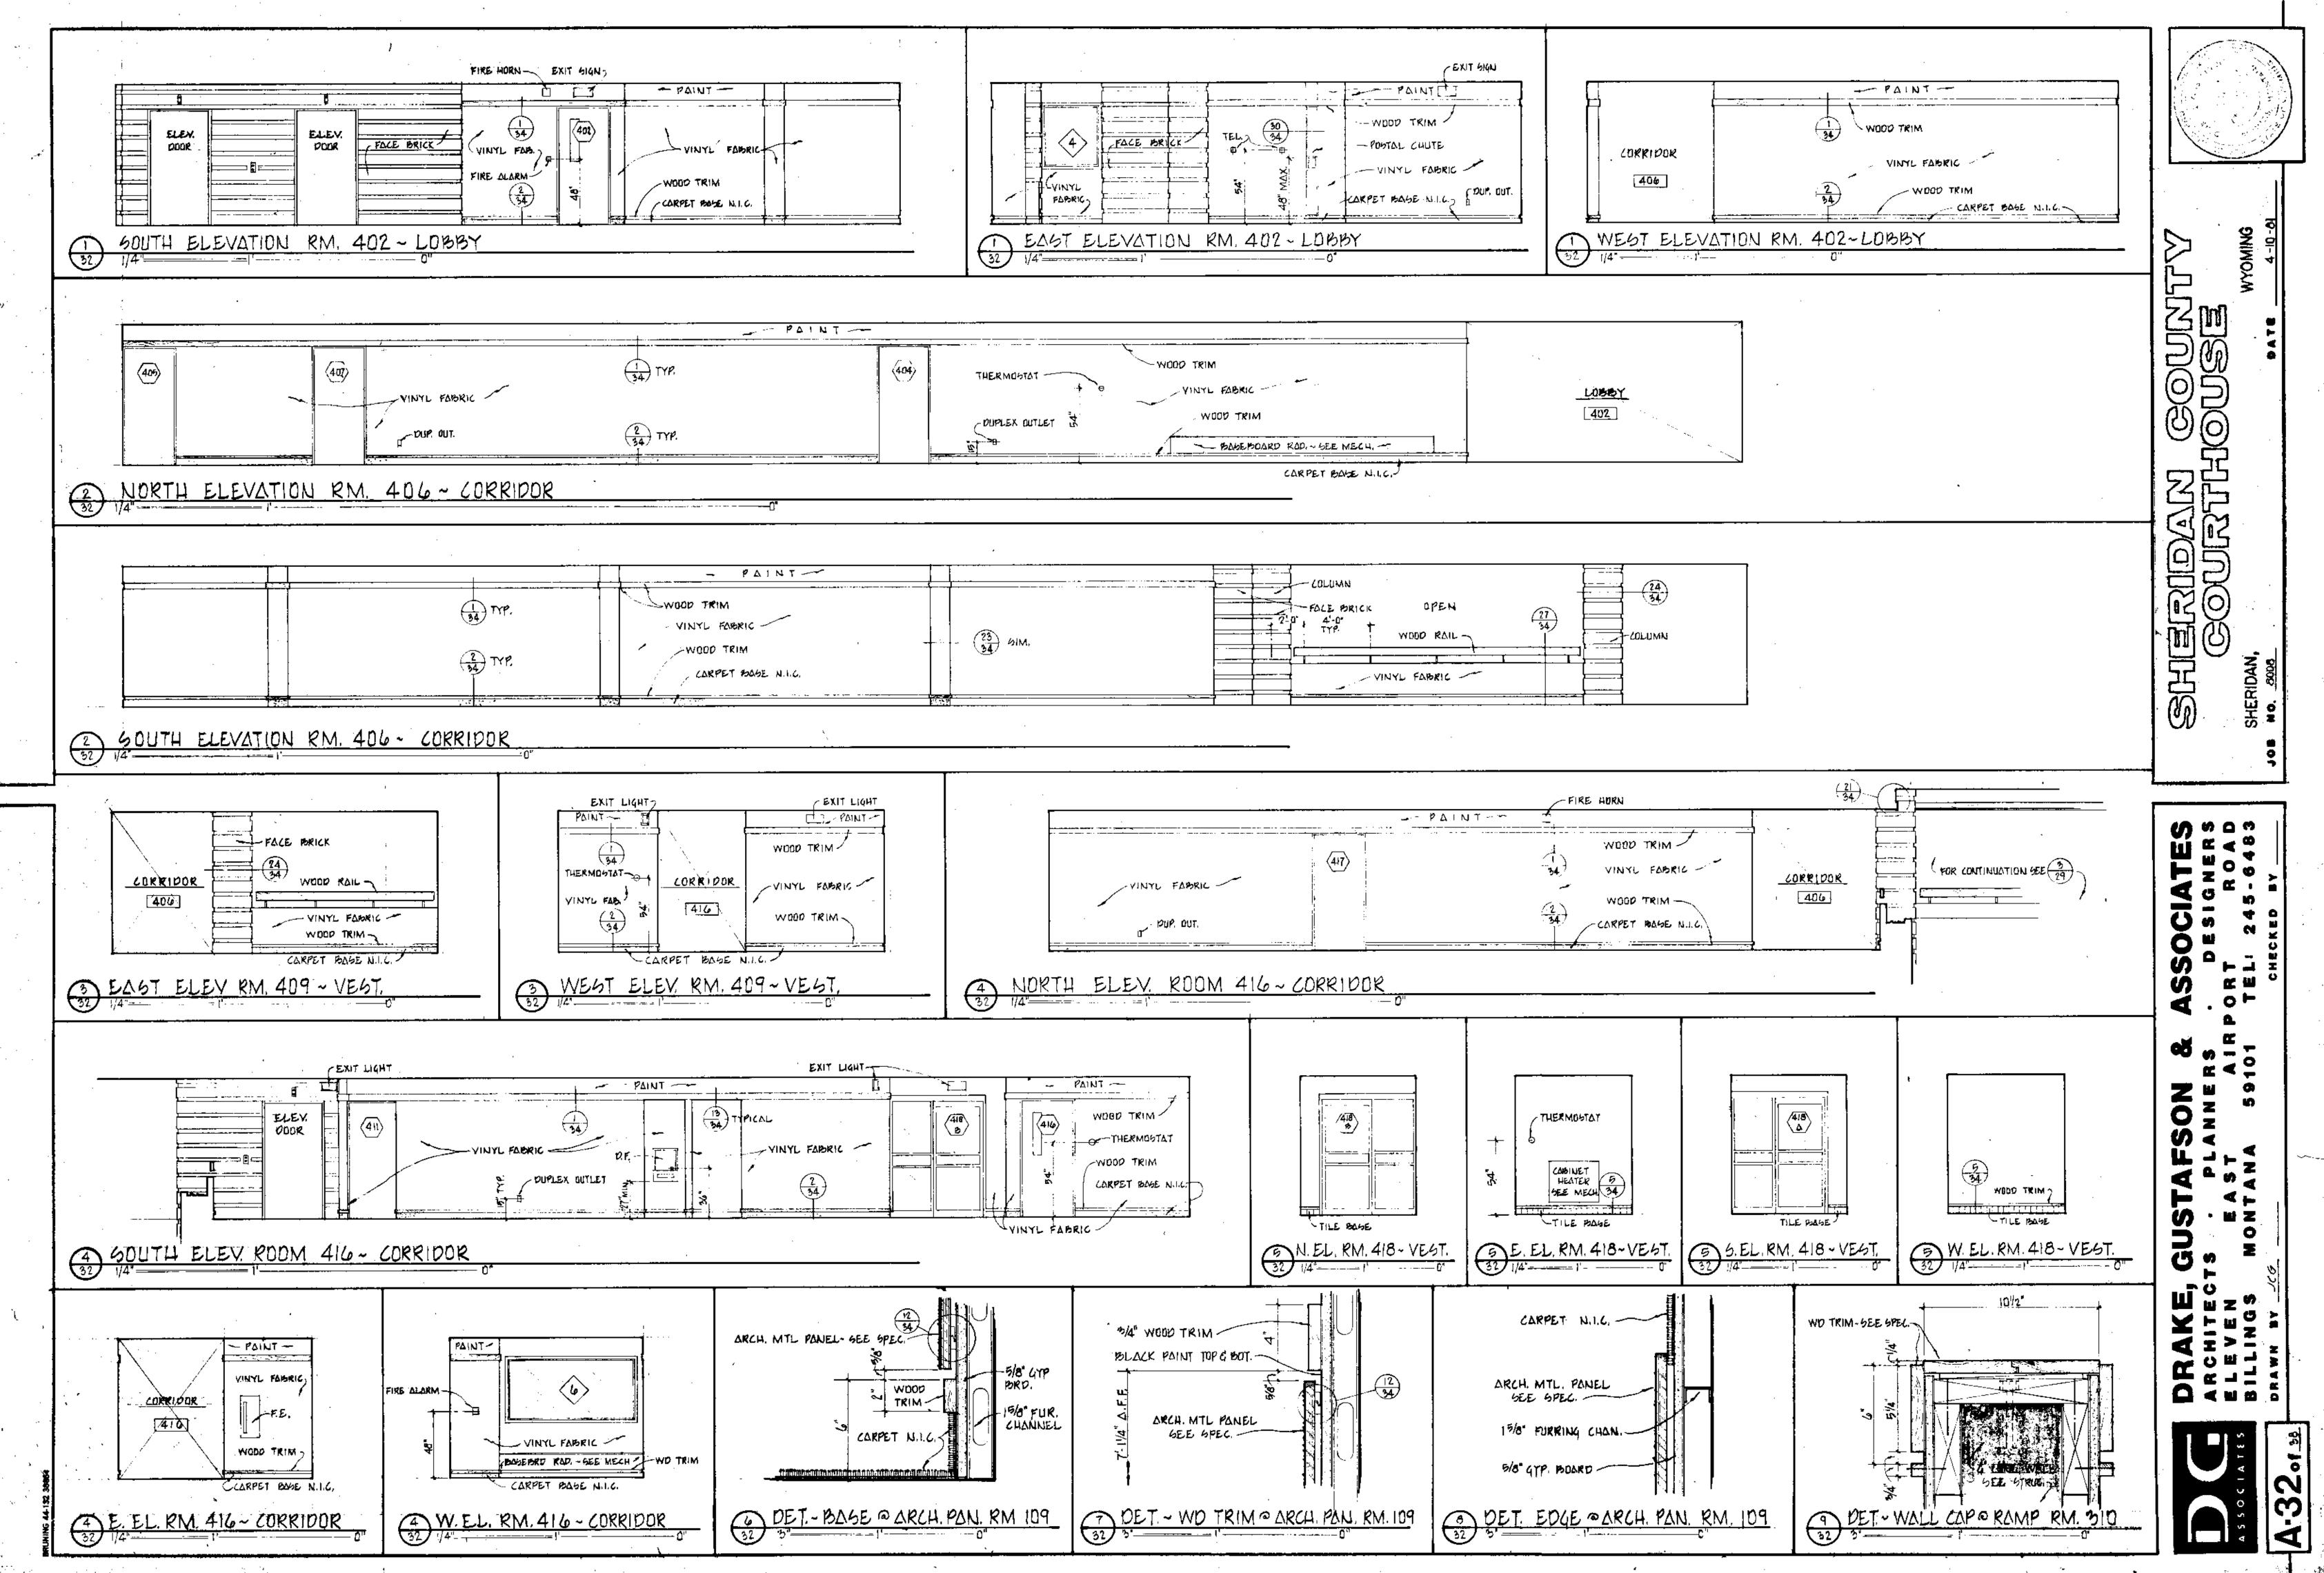


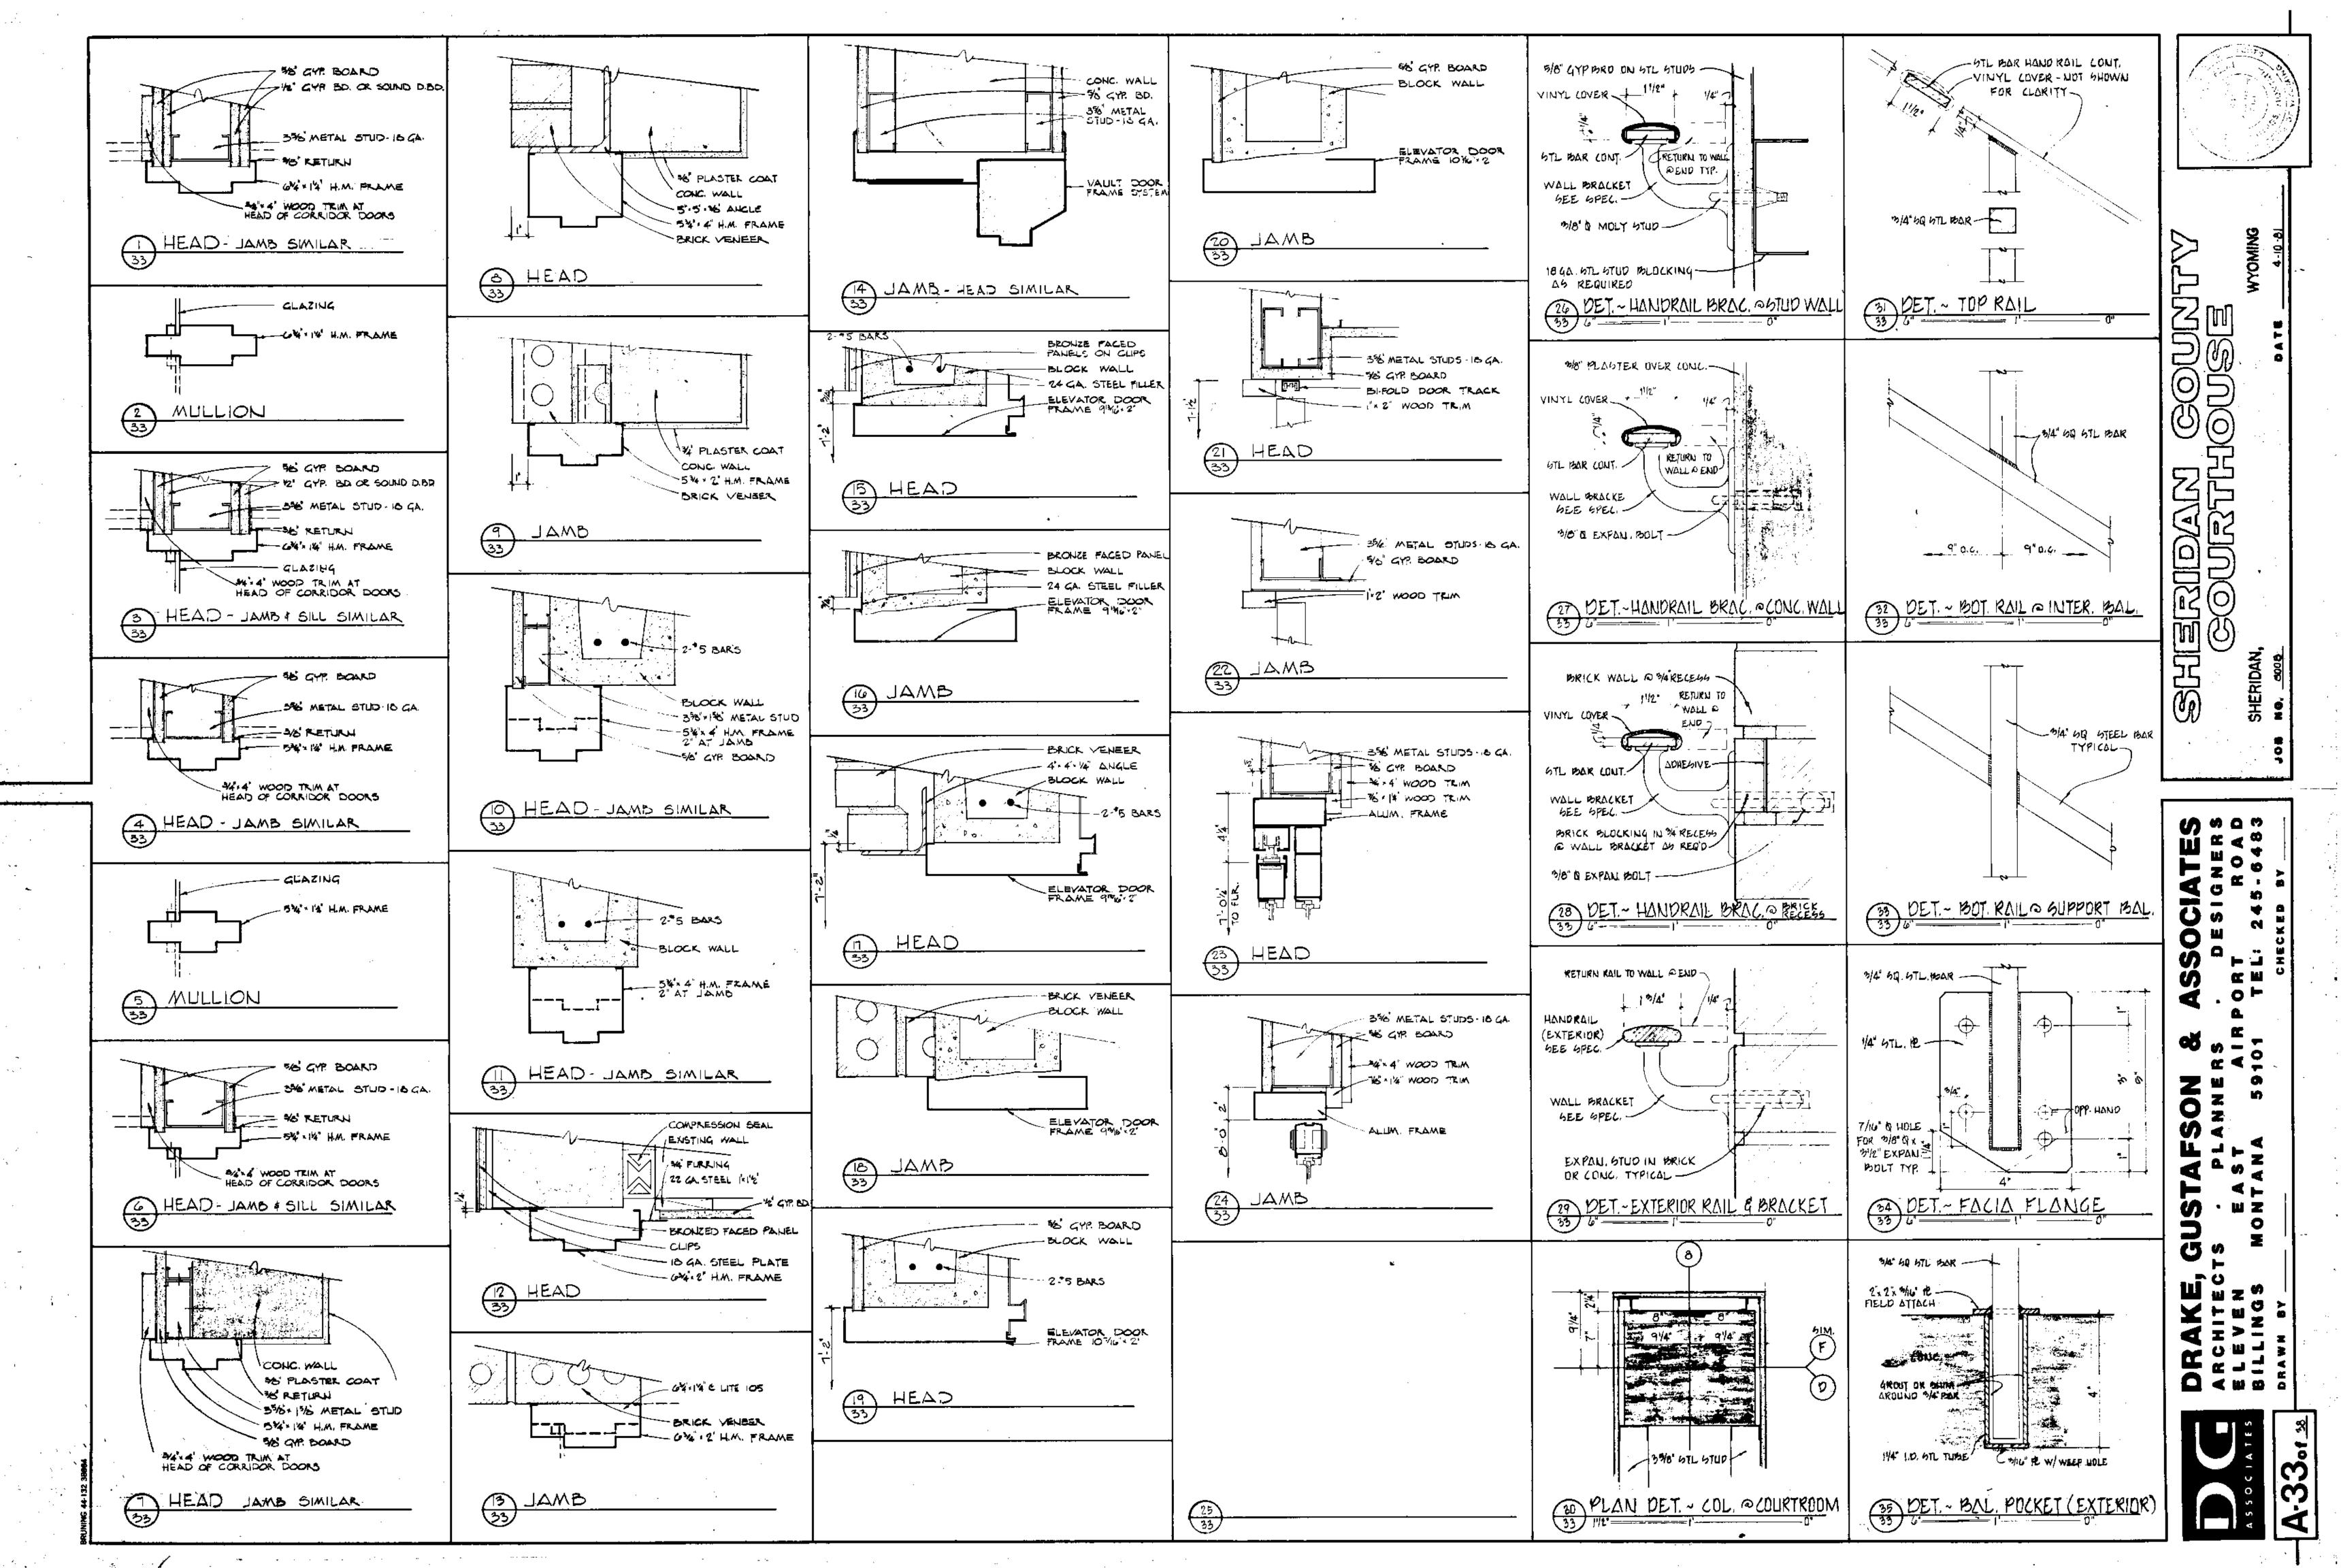


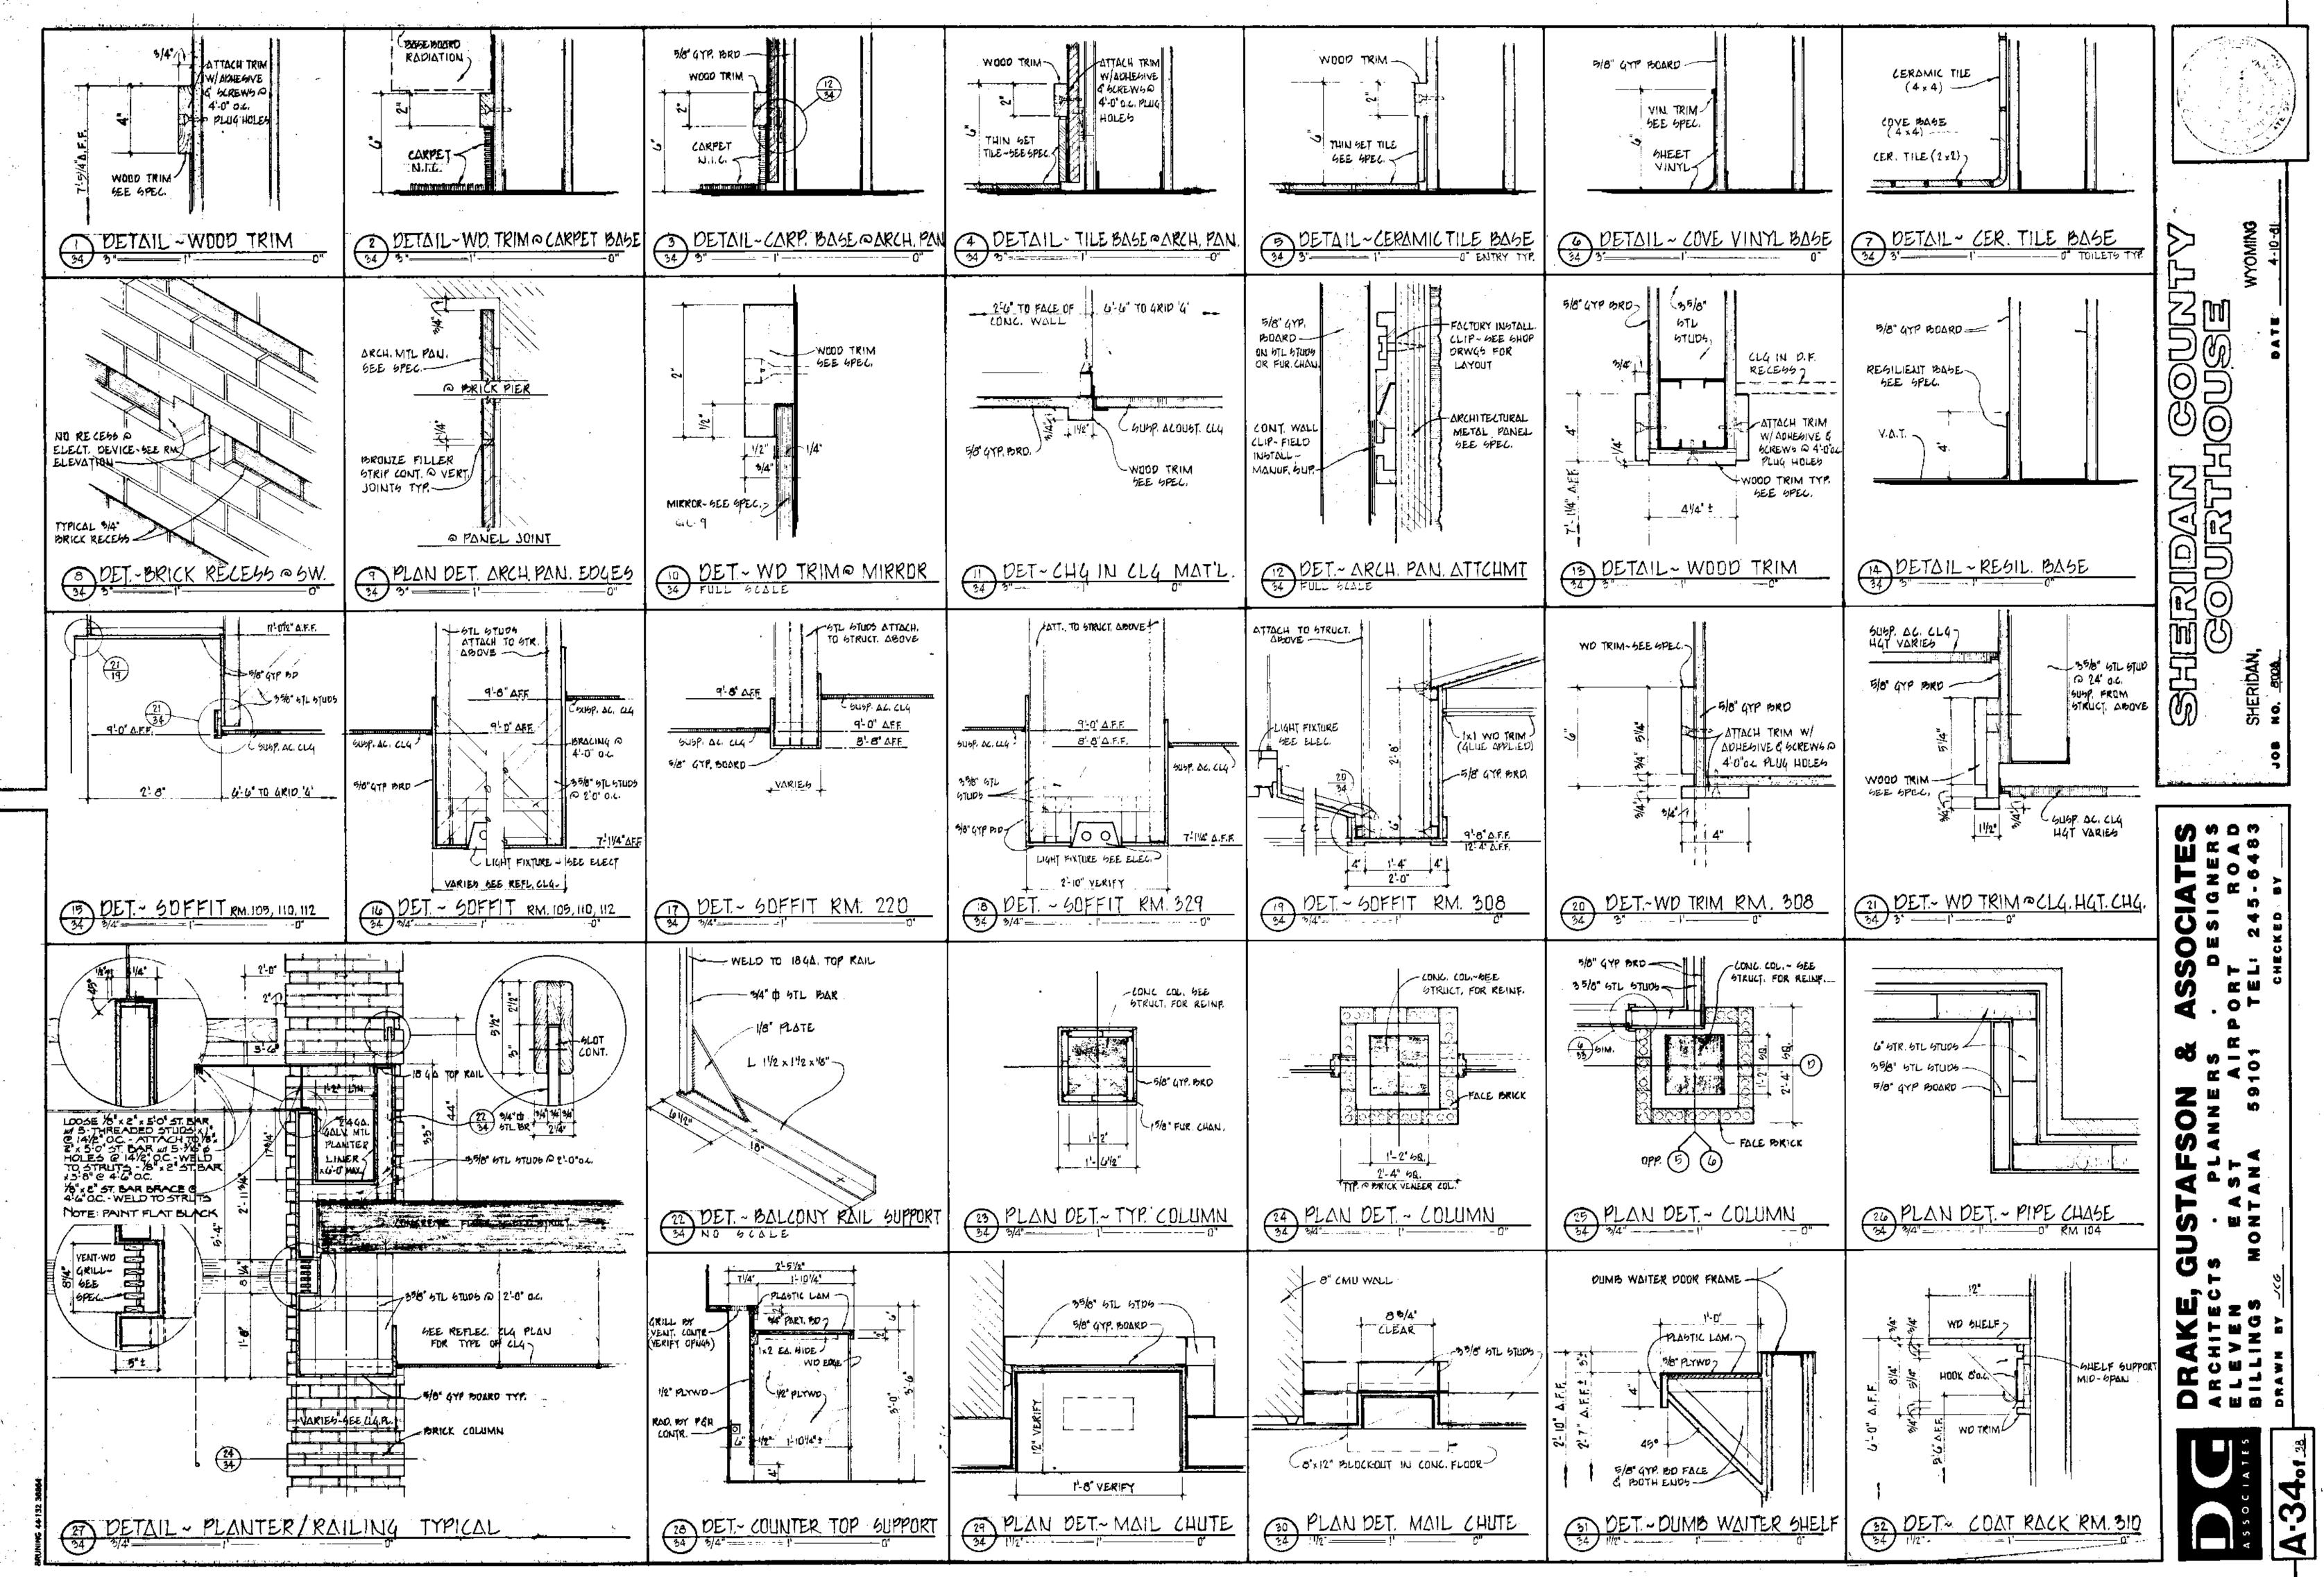


Ţ


. .

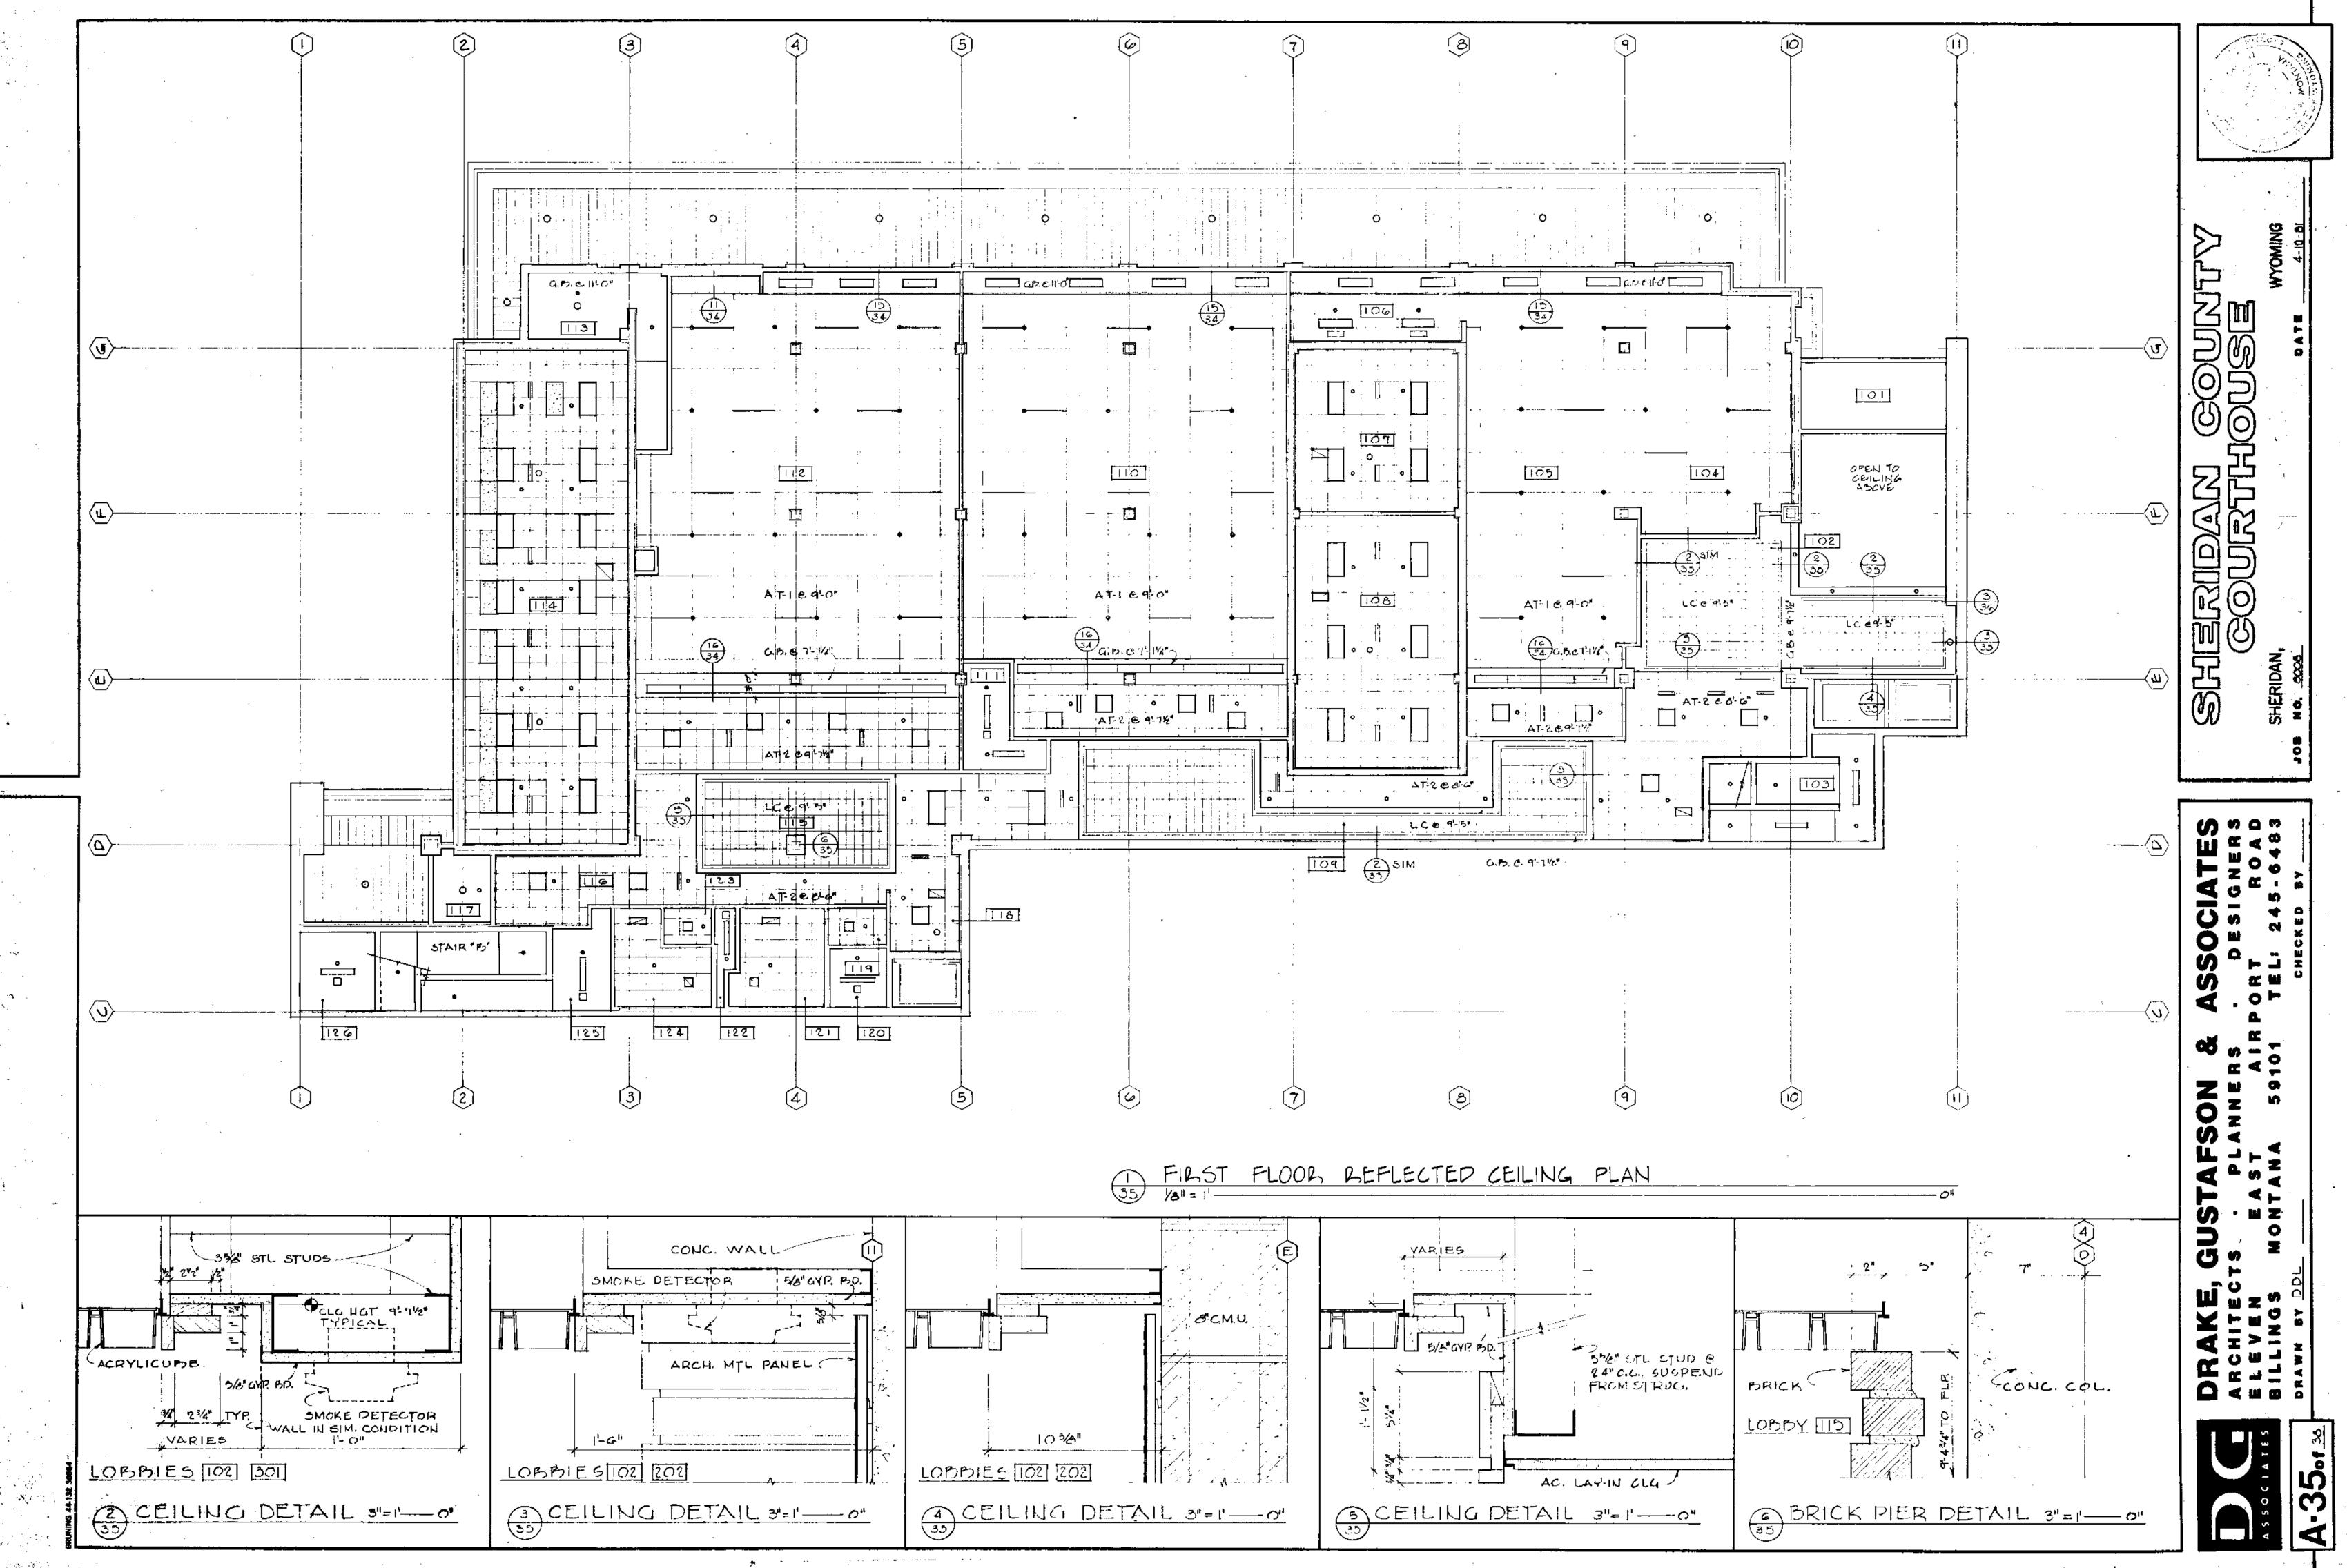

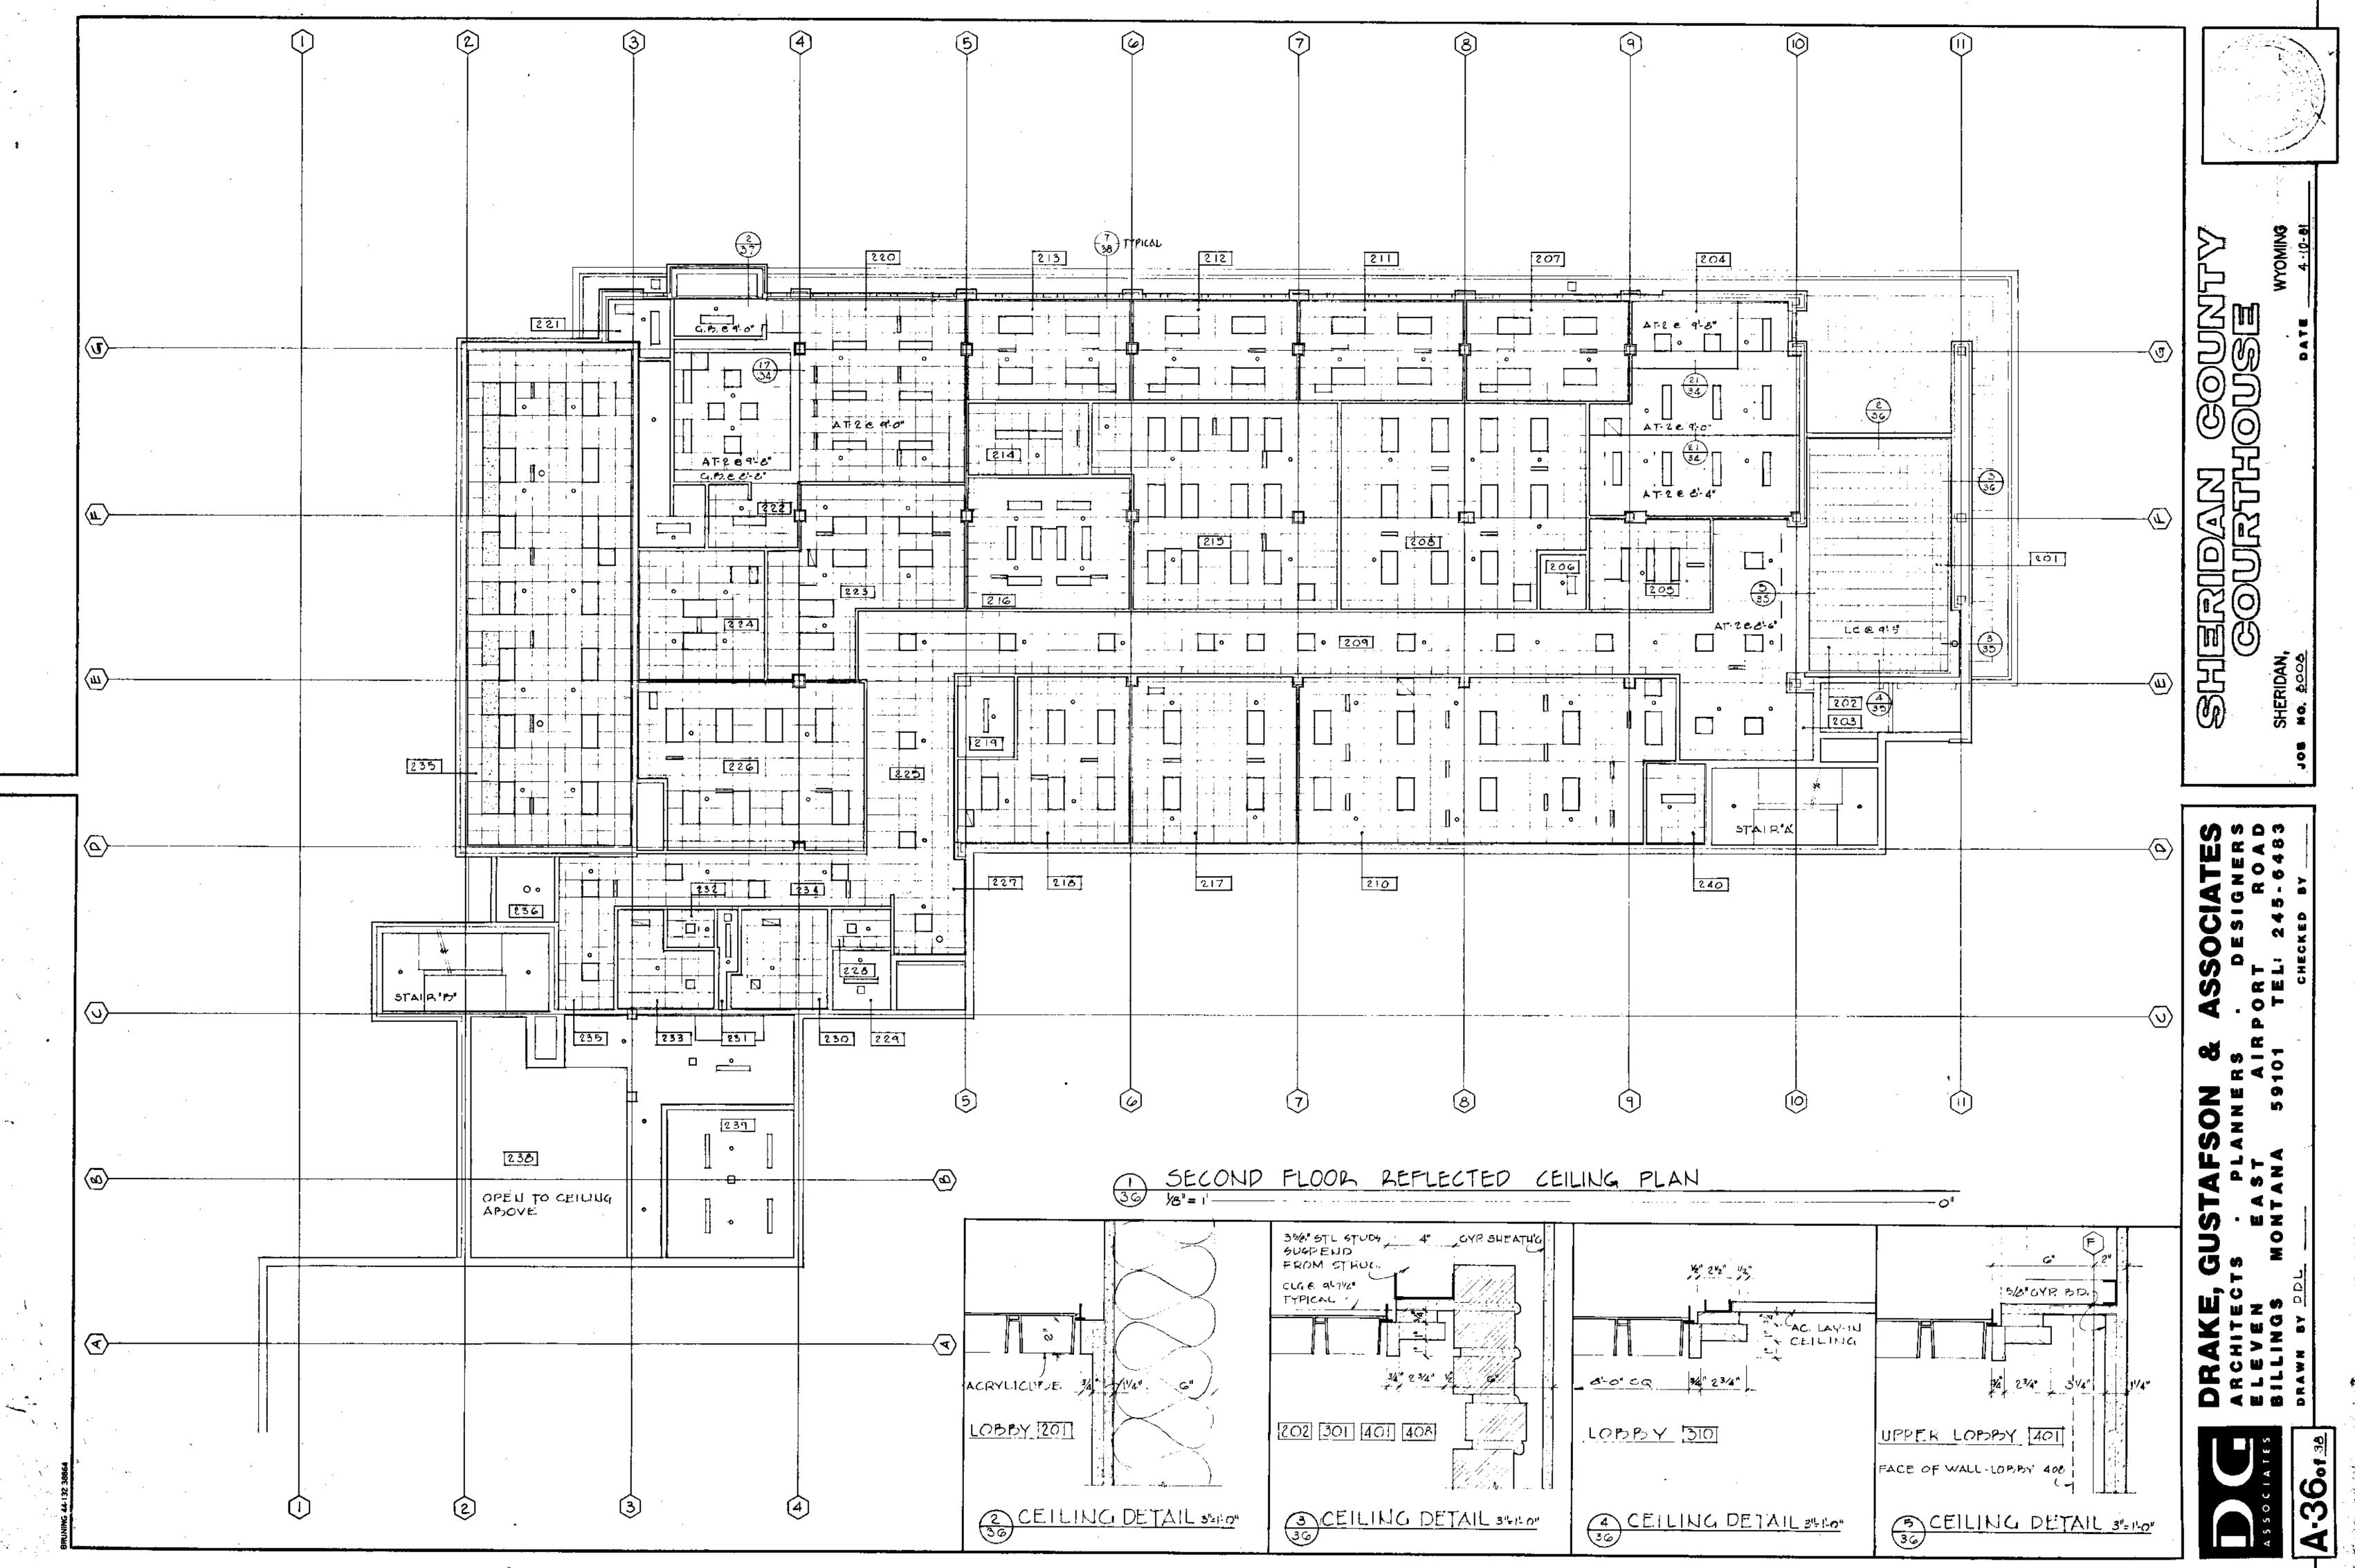



~

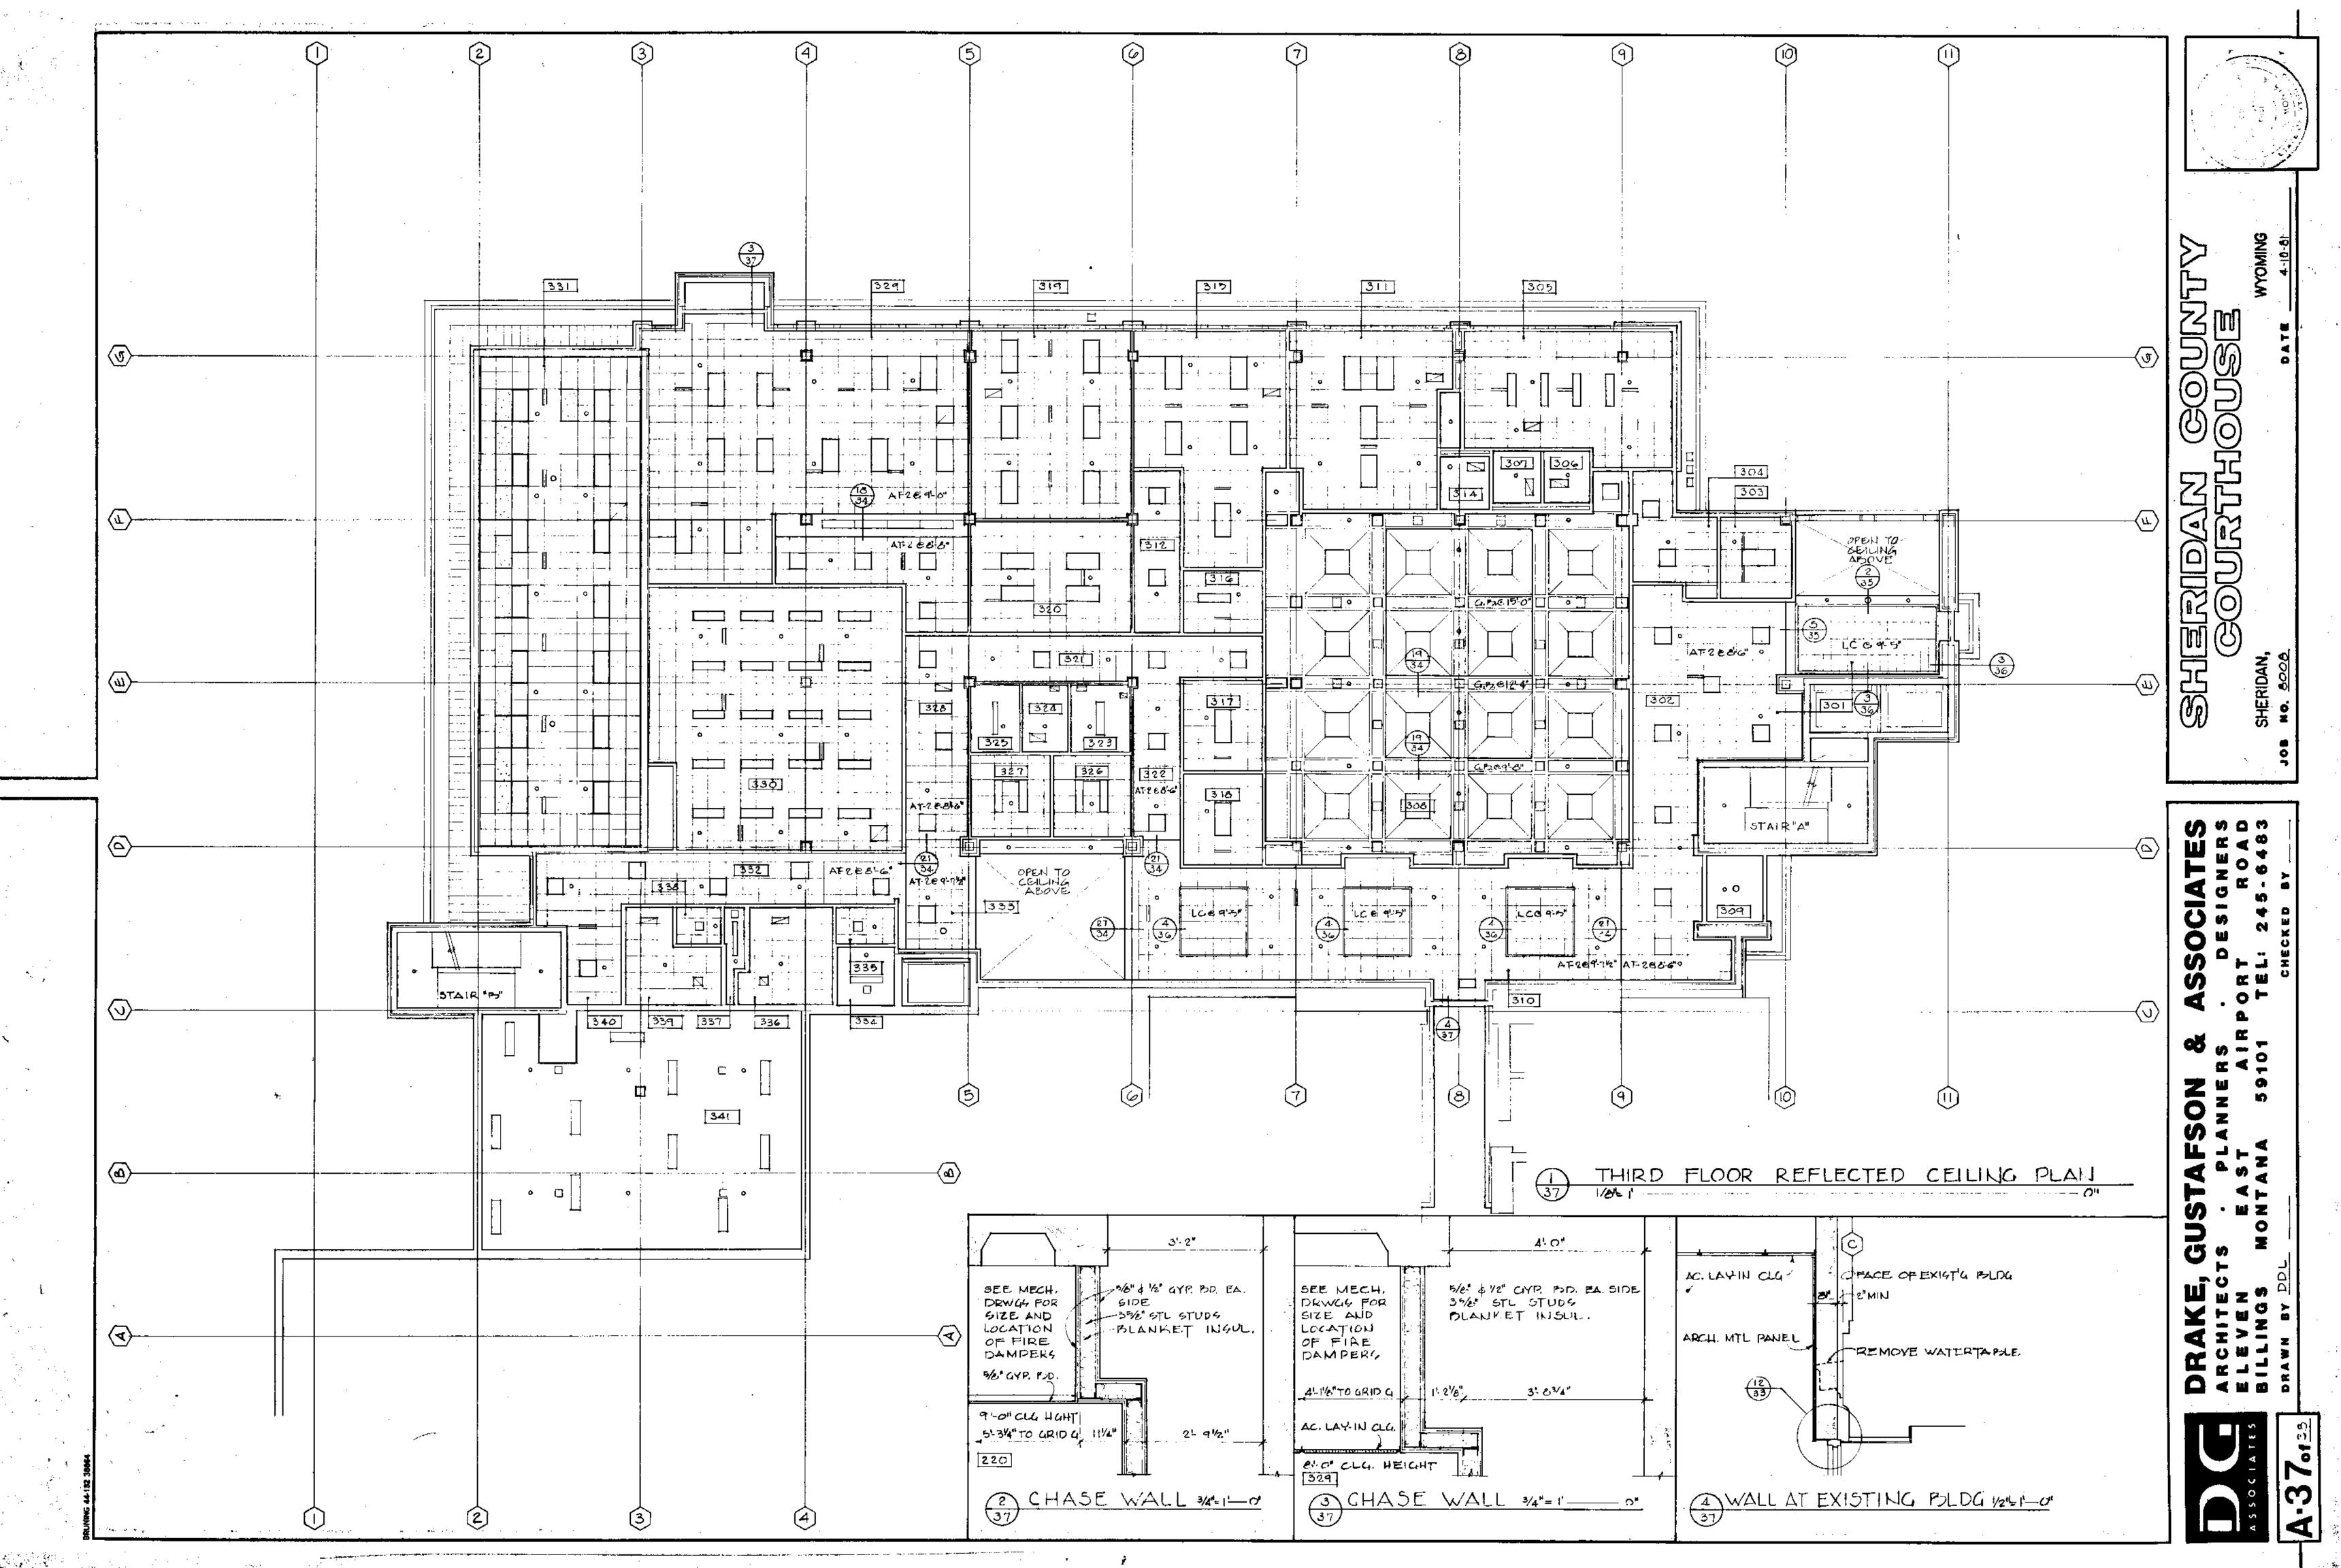

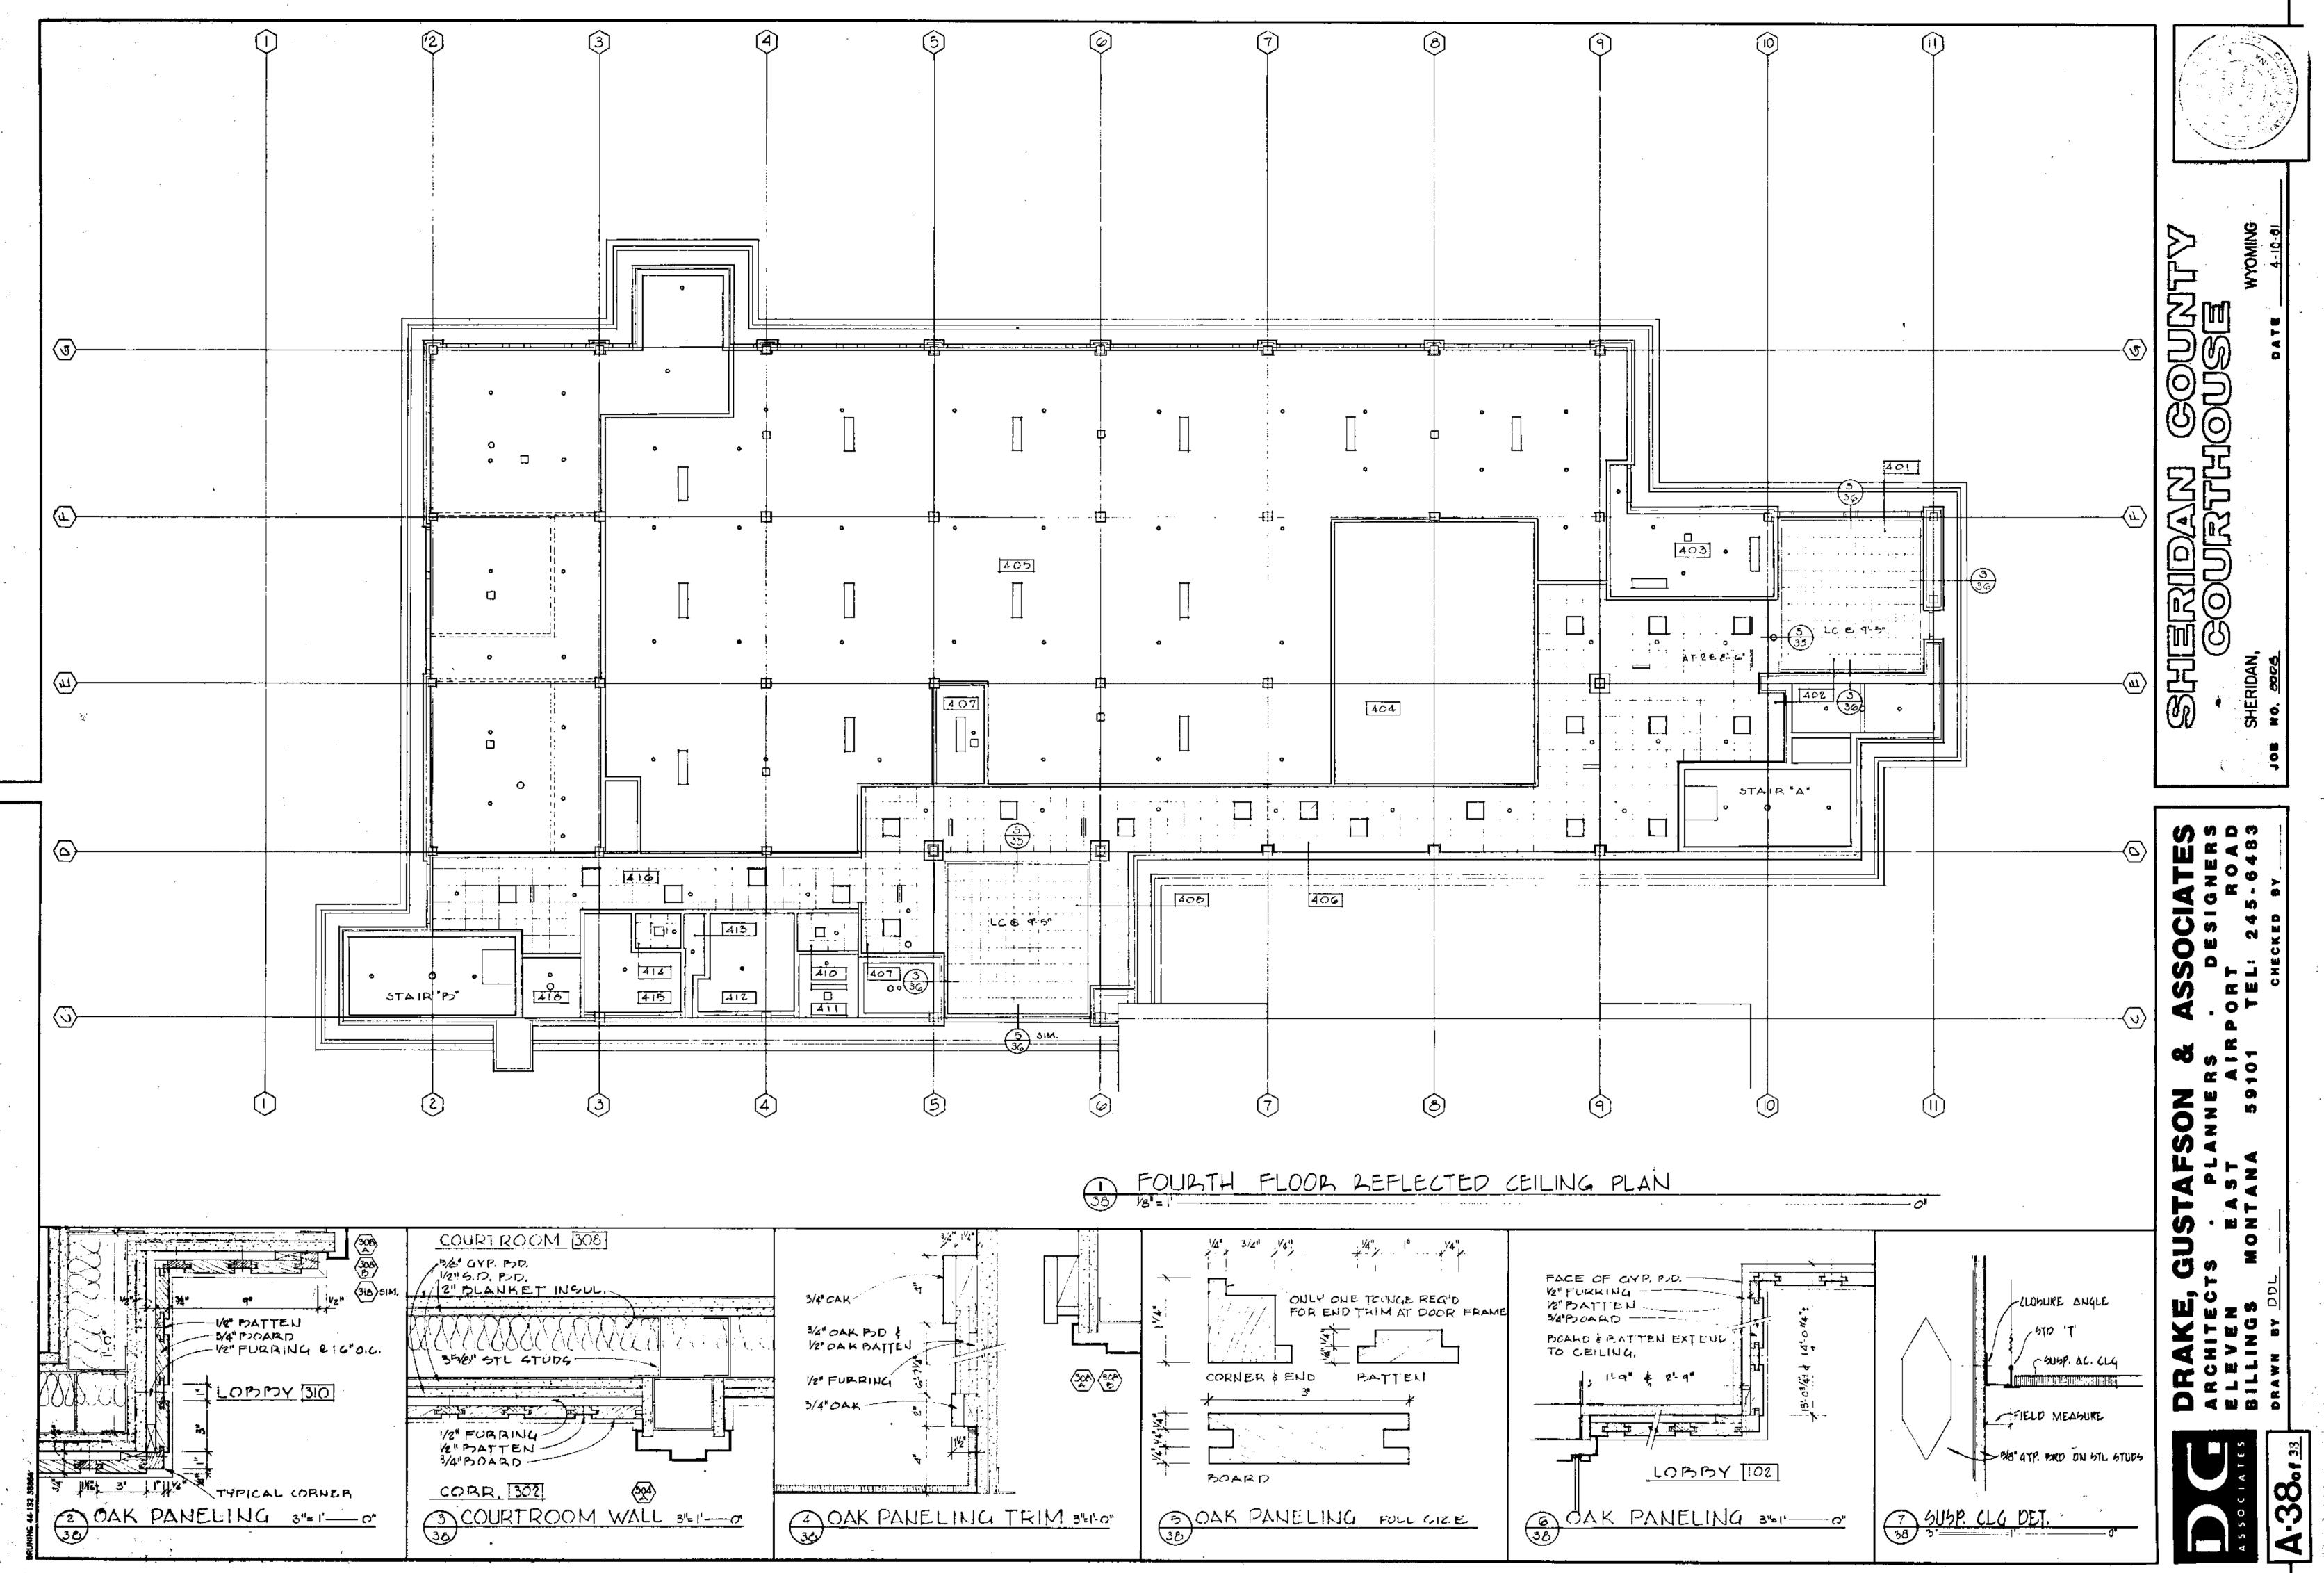



`

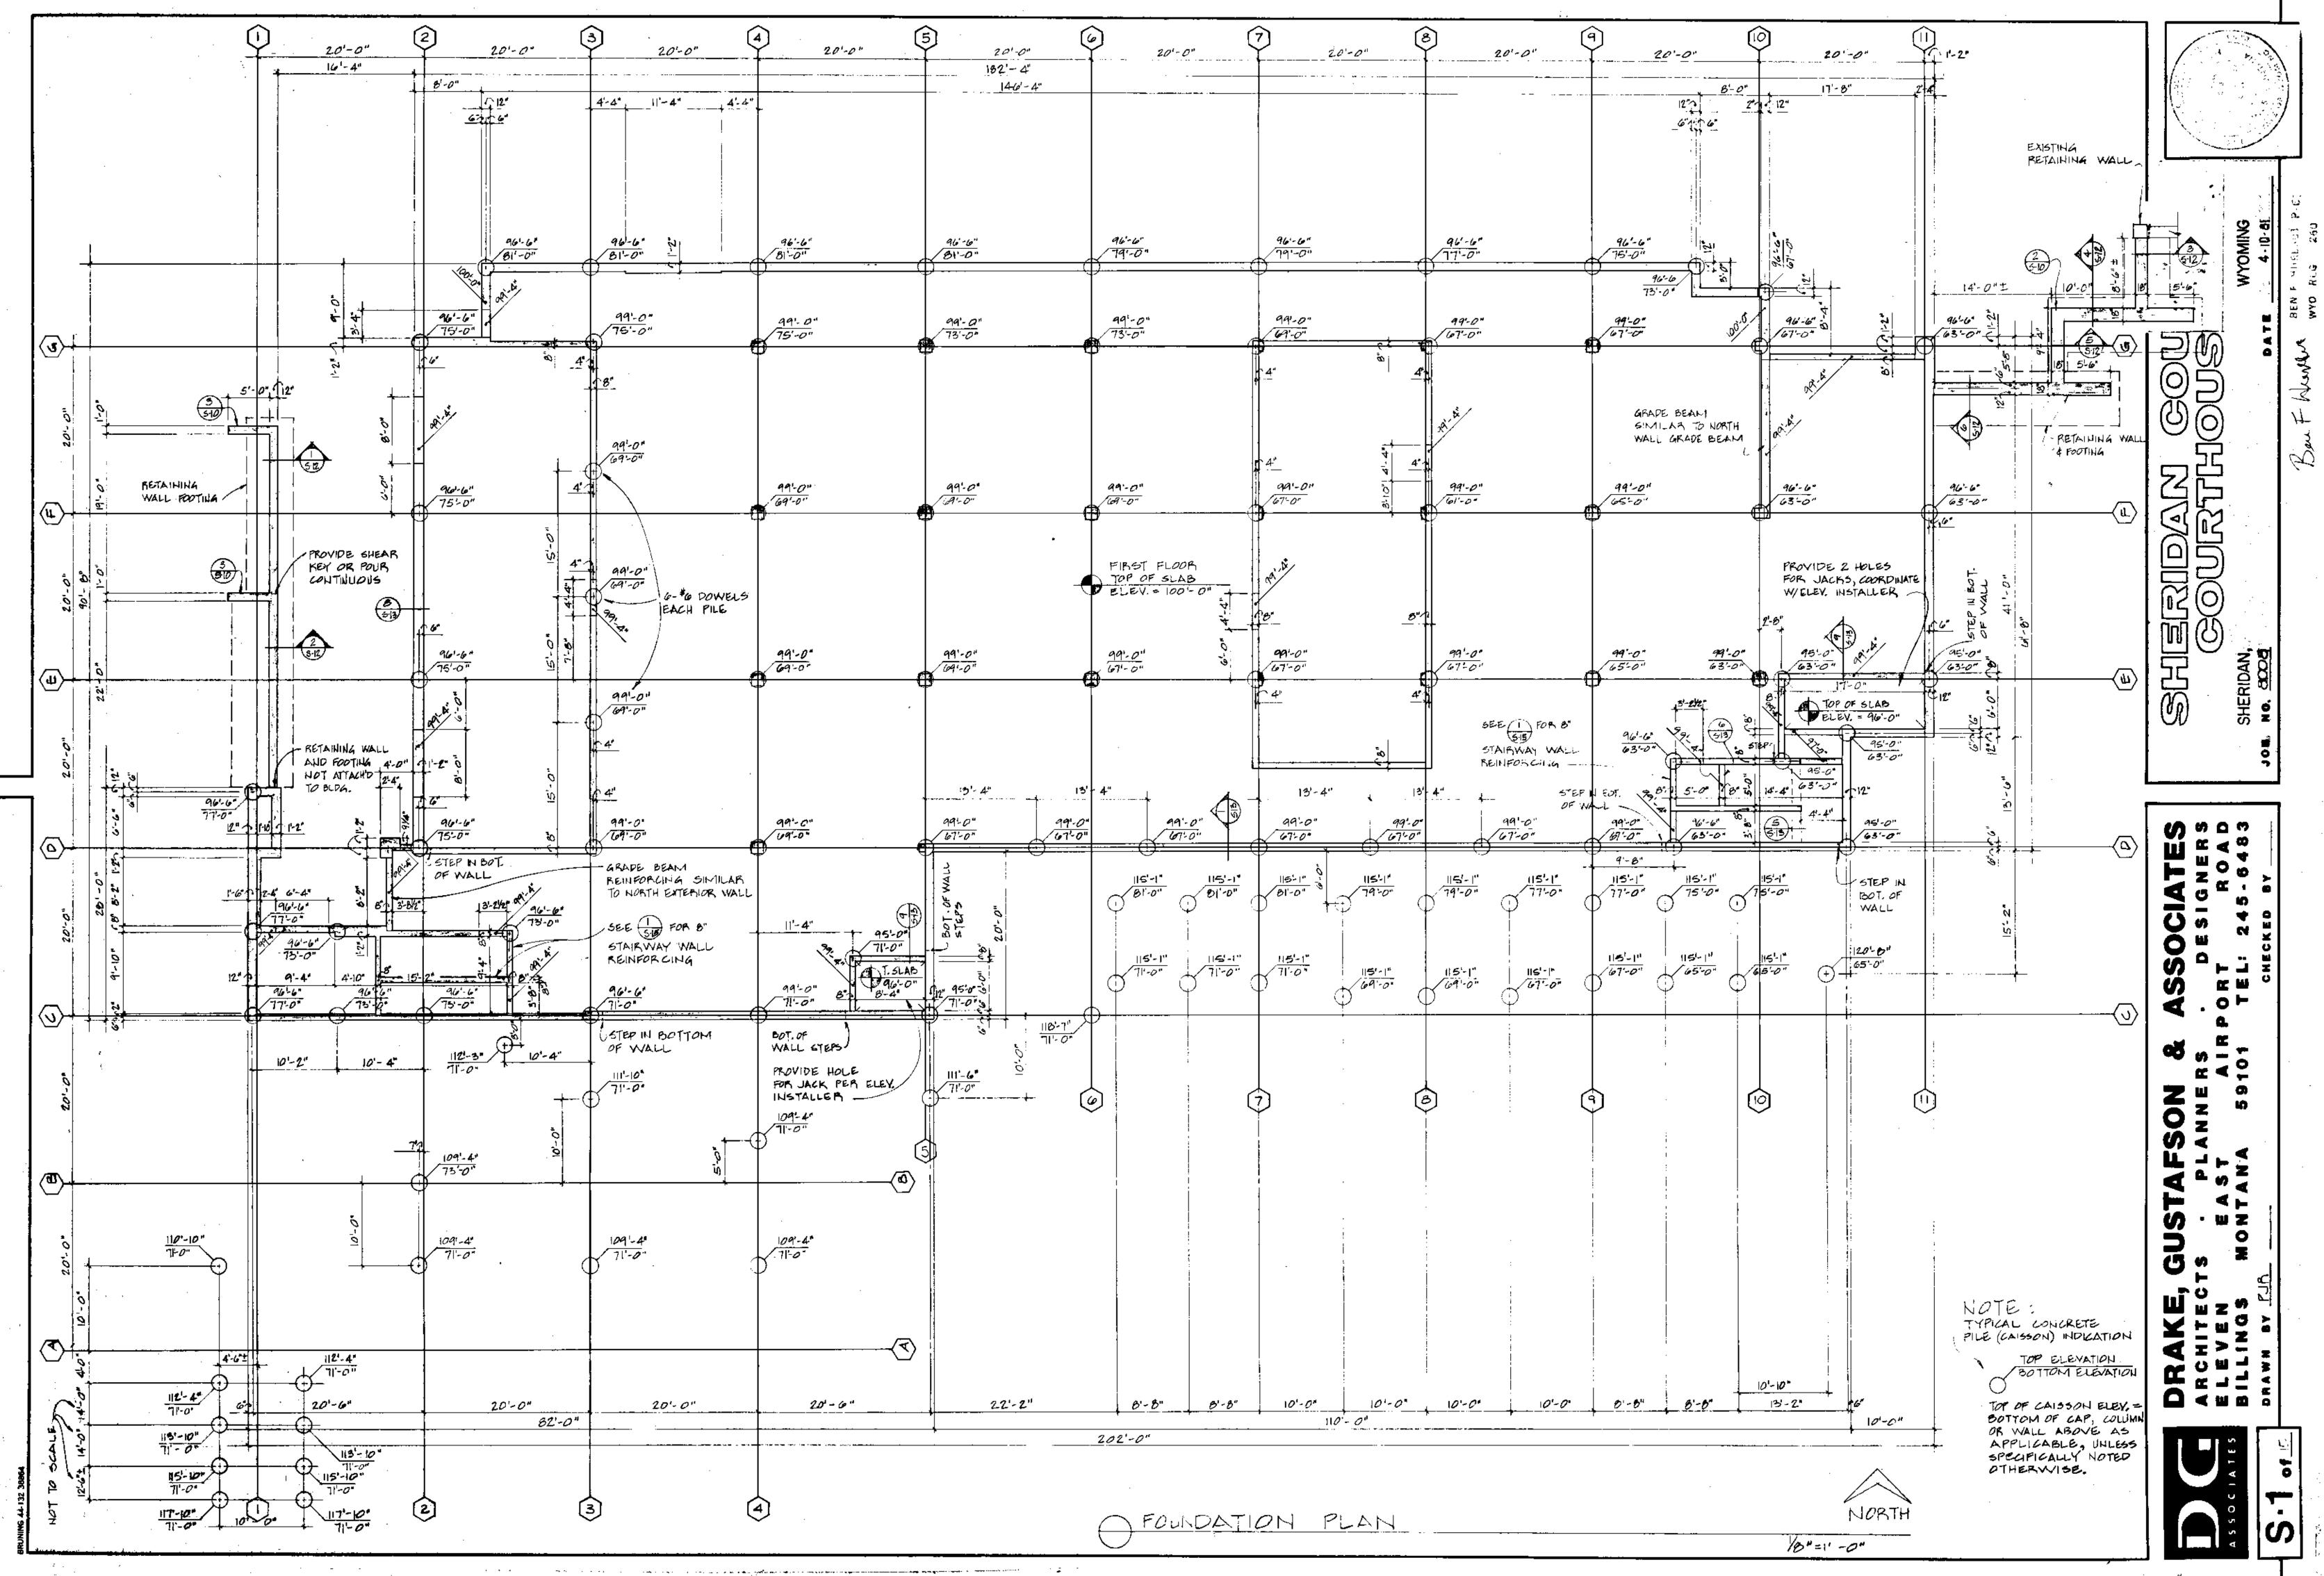

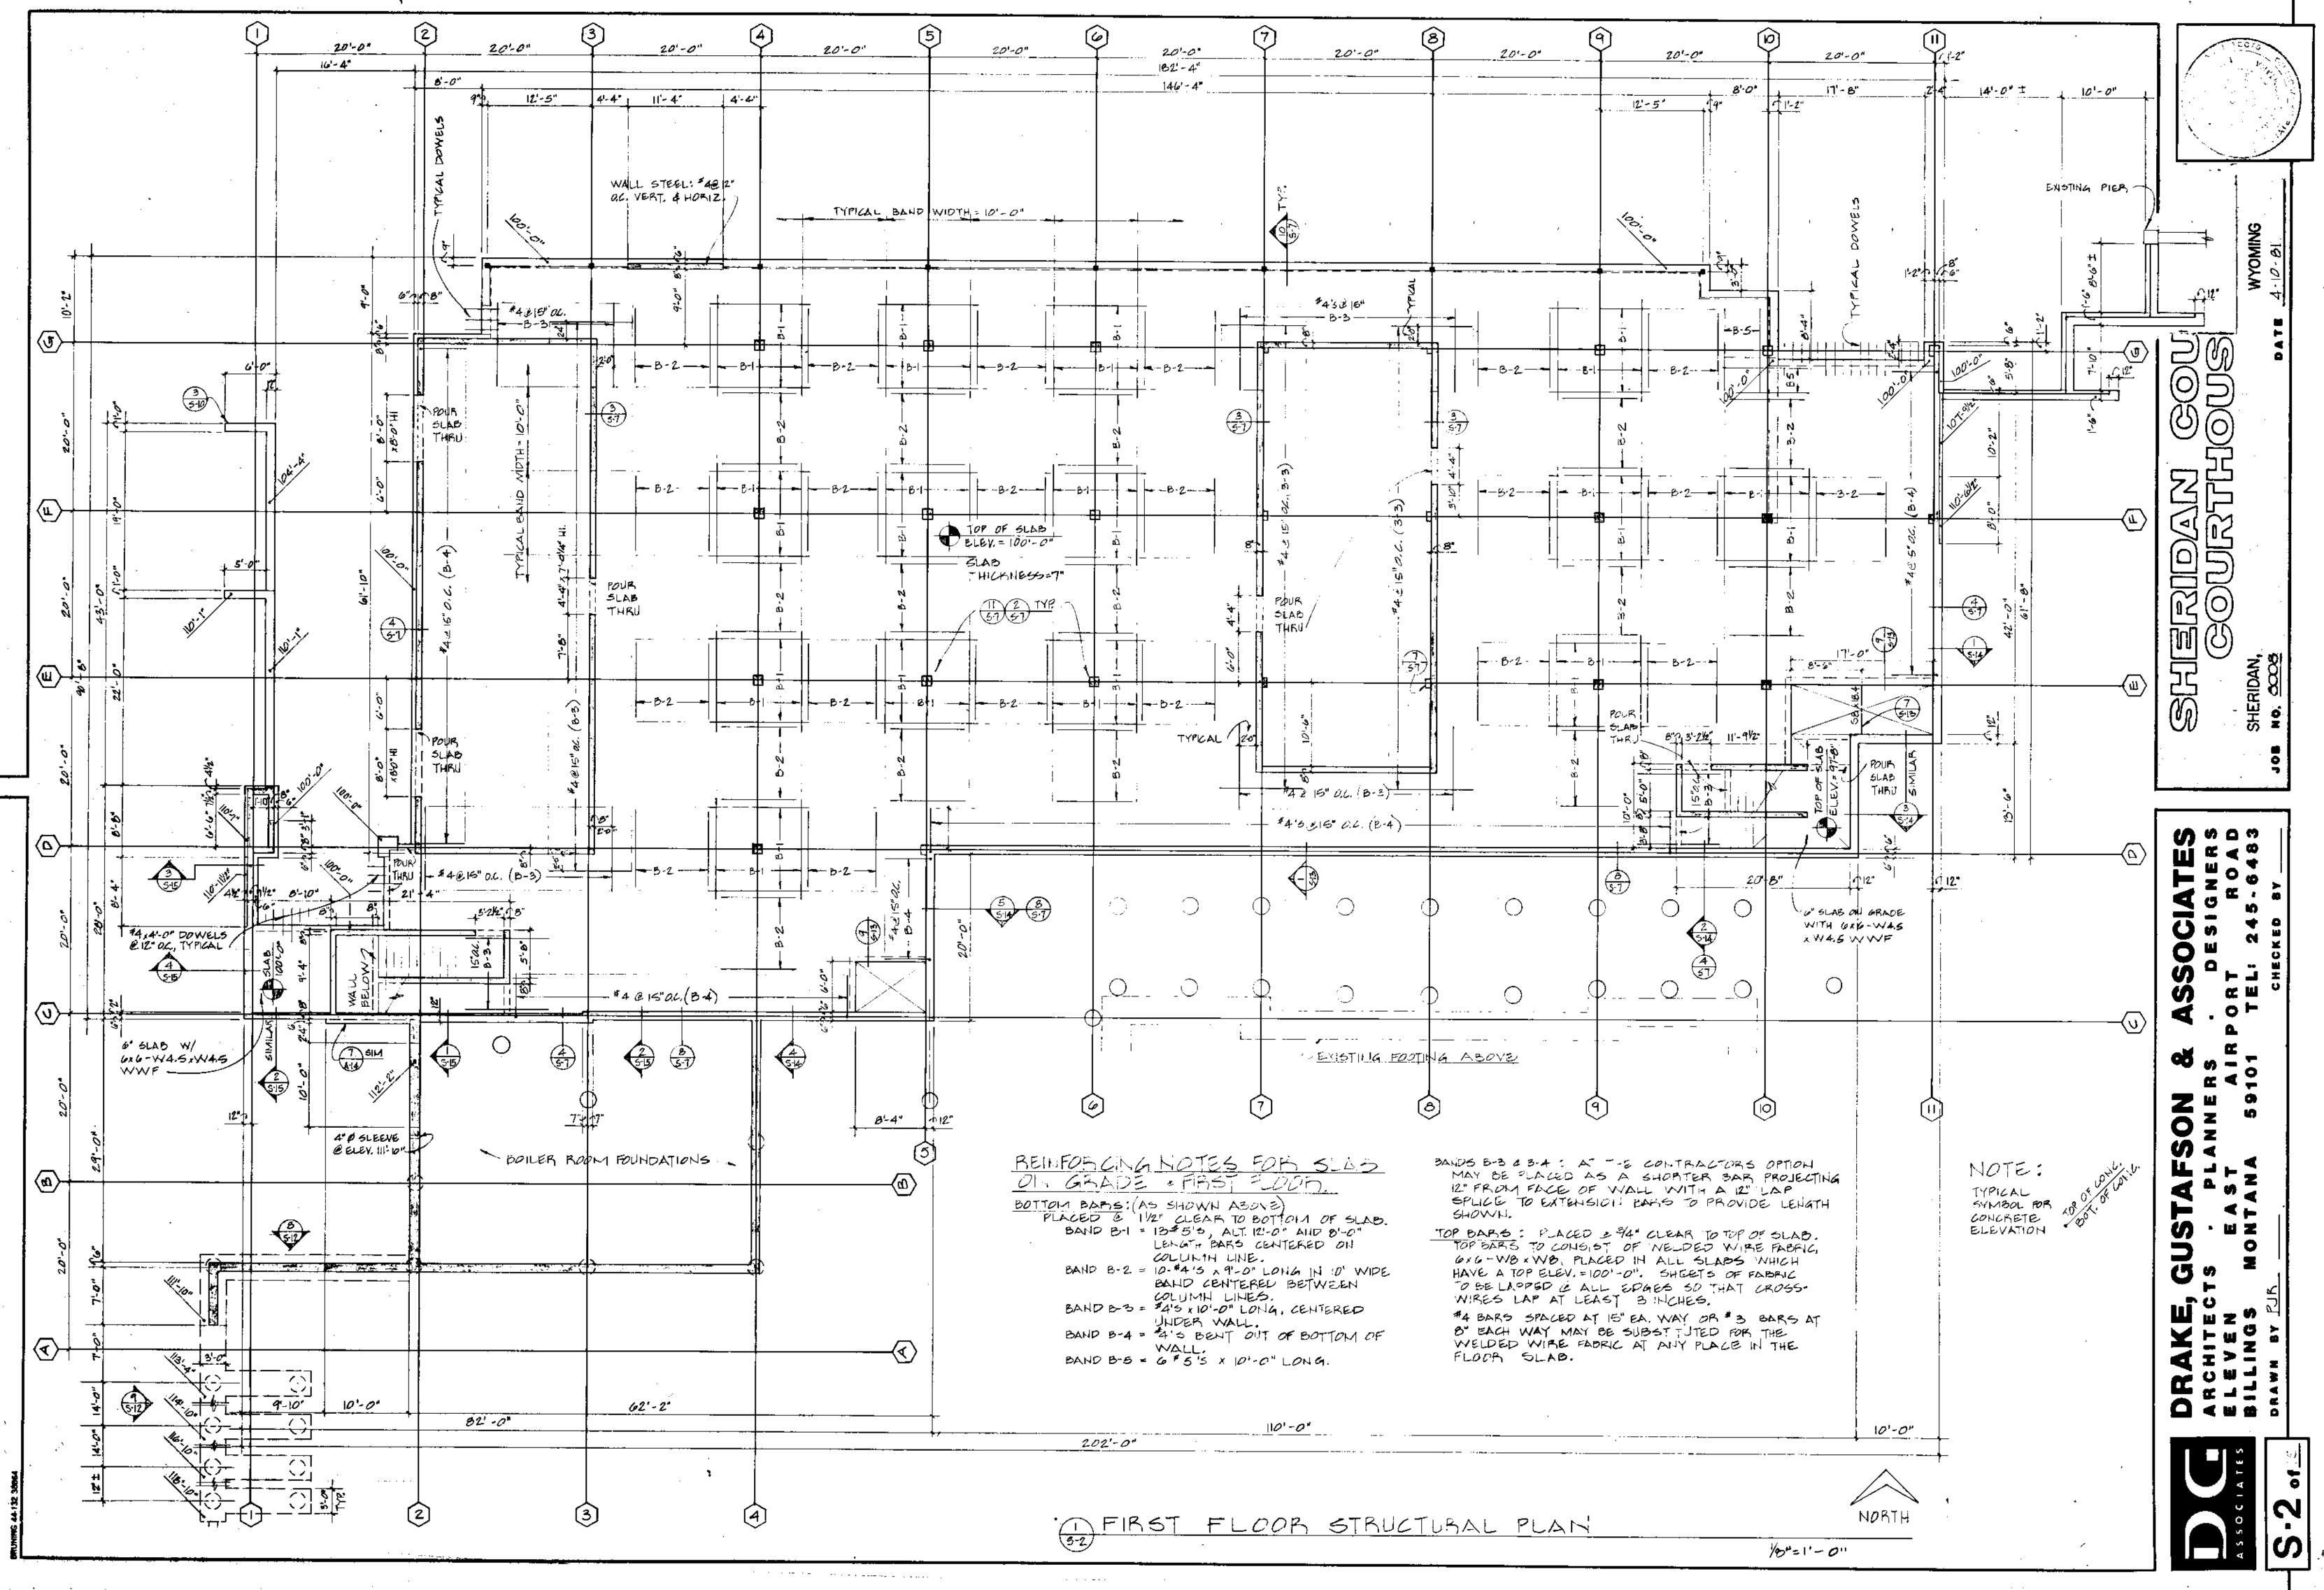


. . .

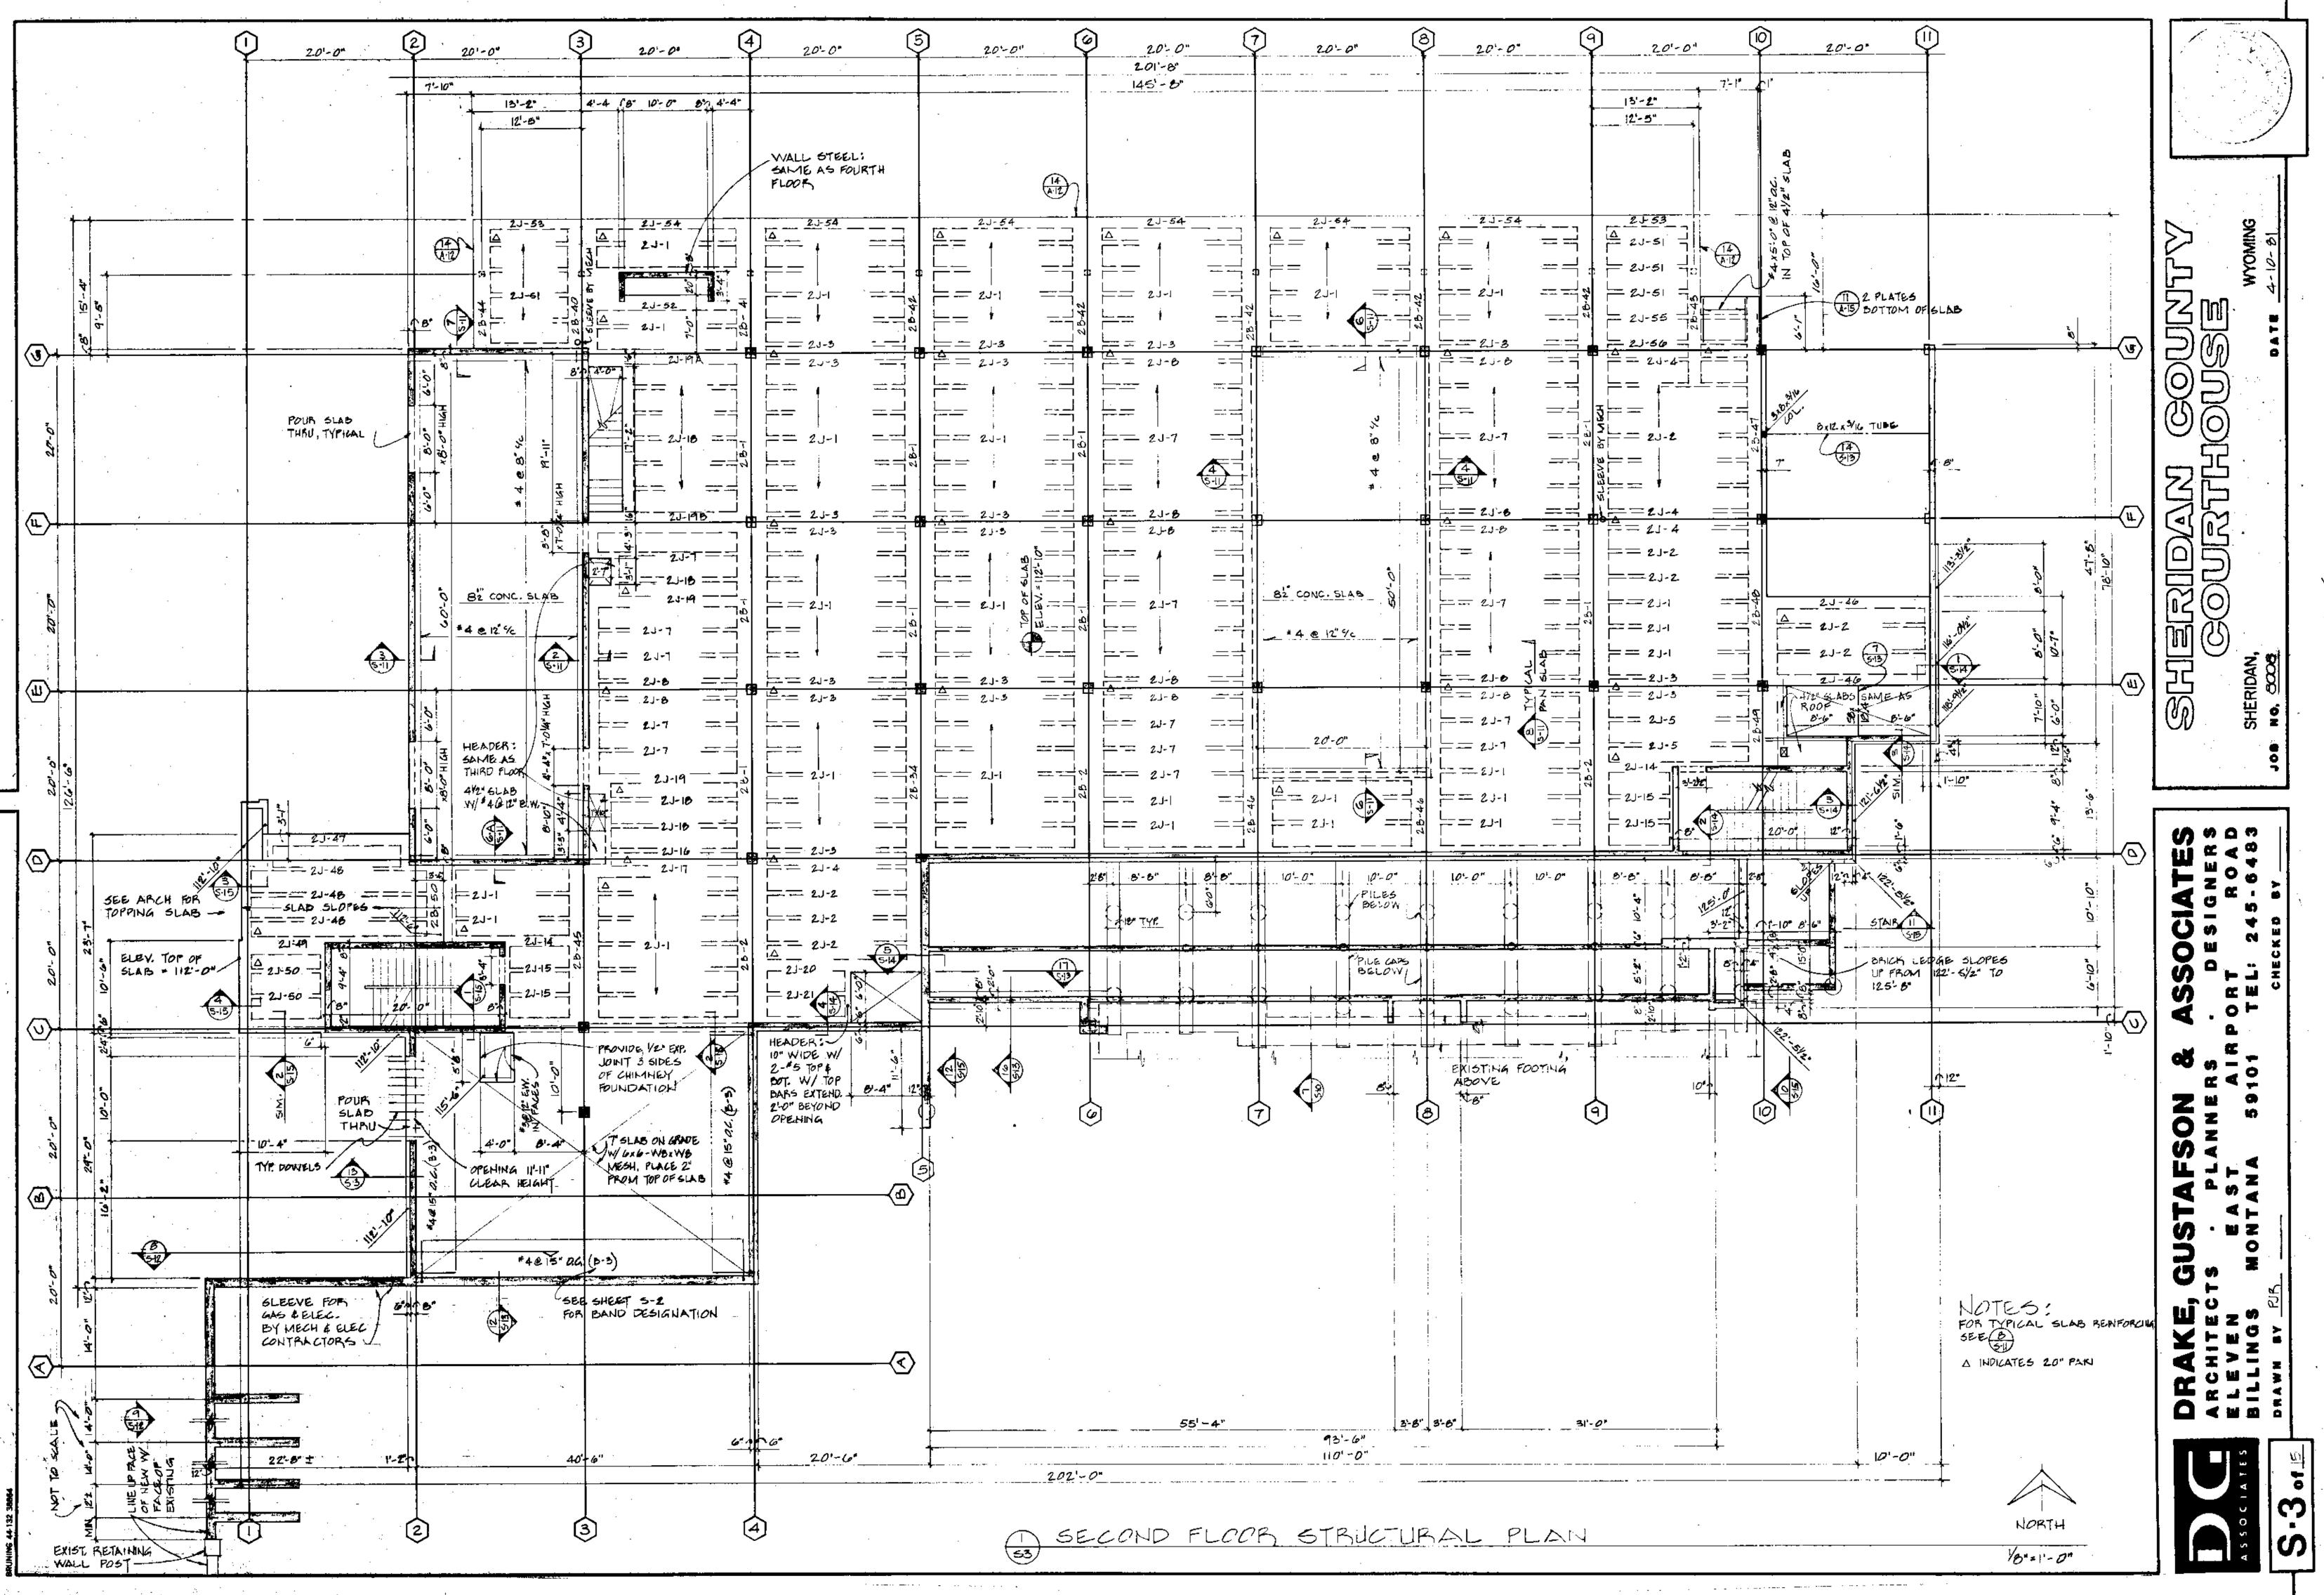


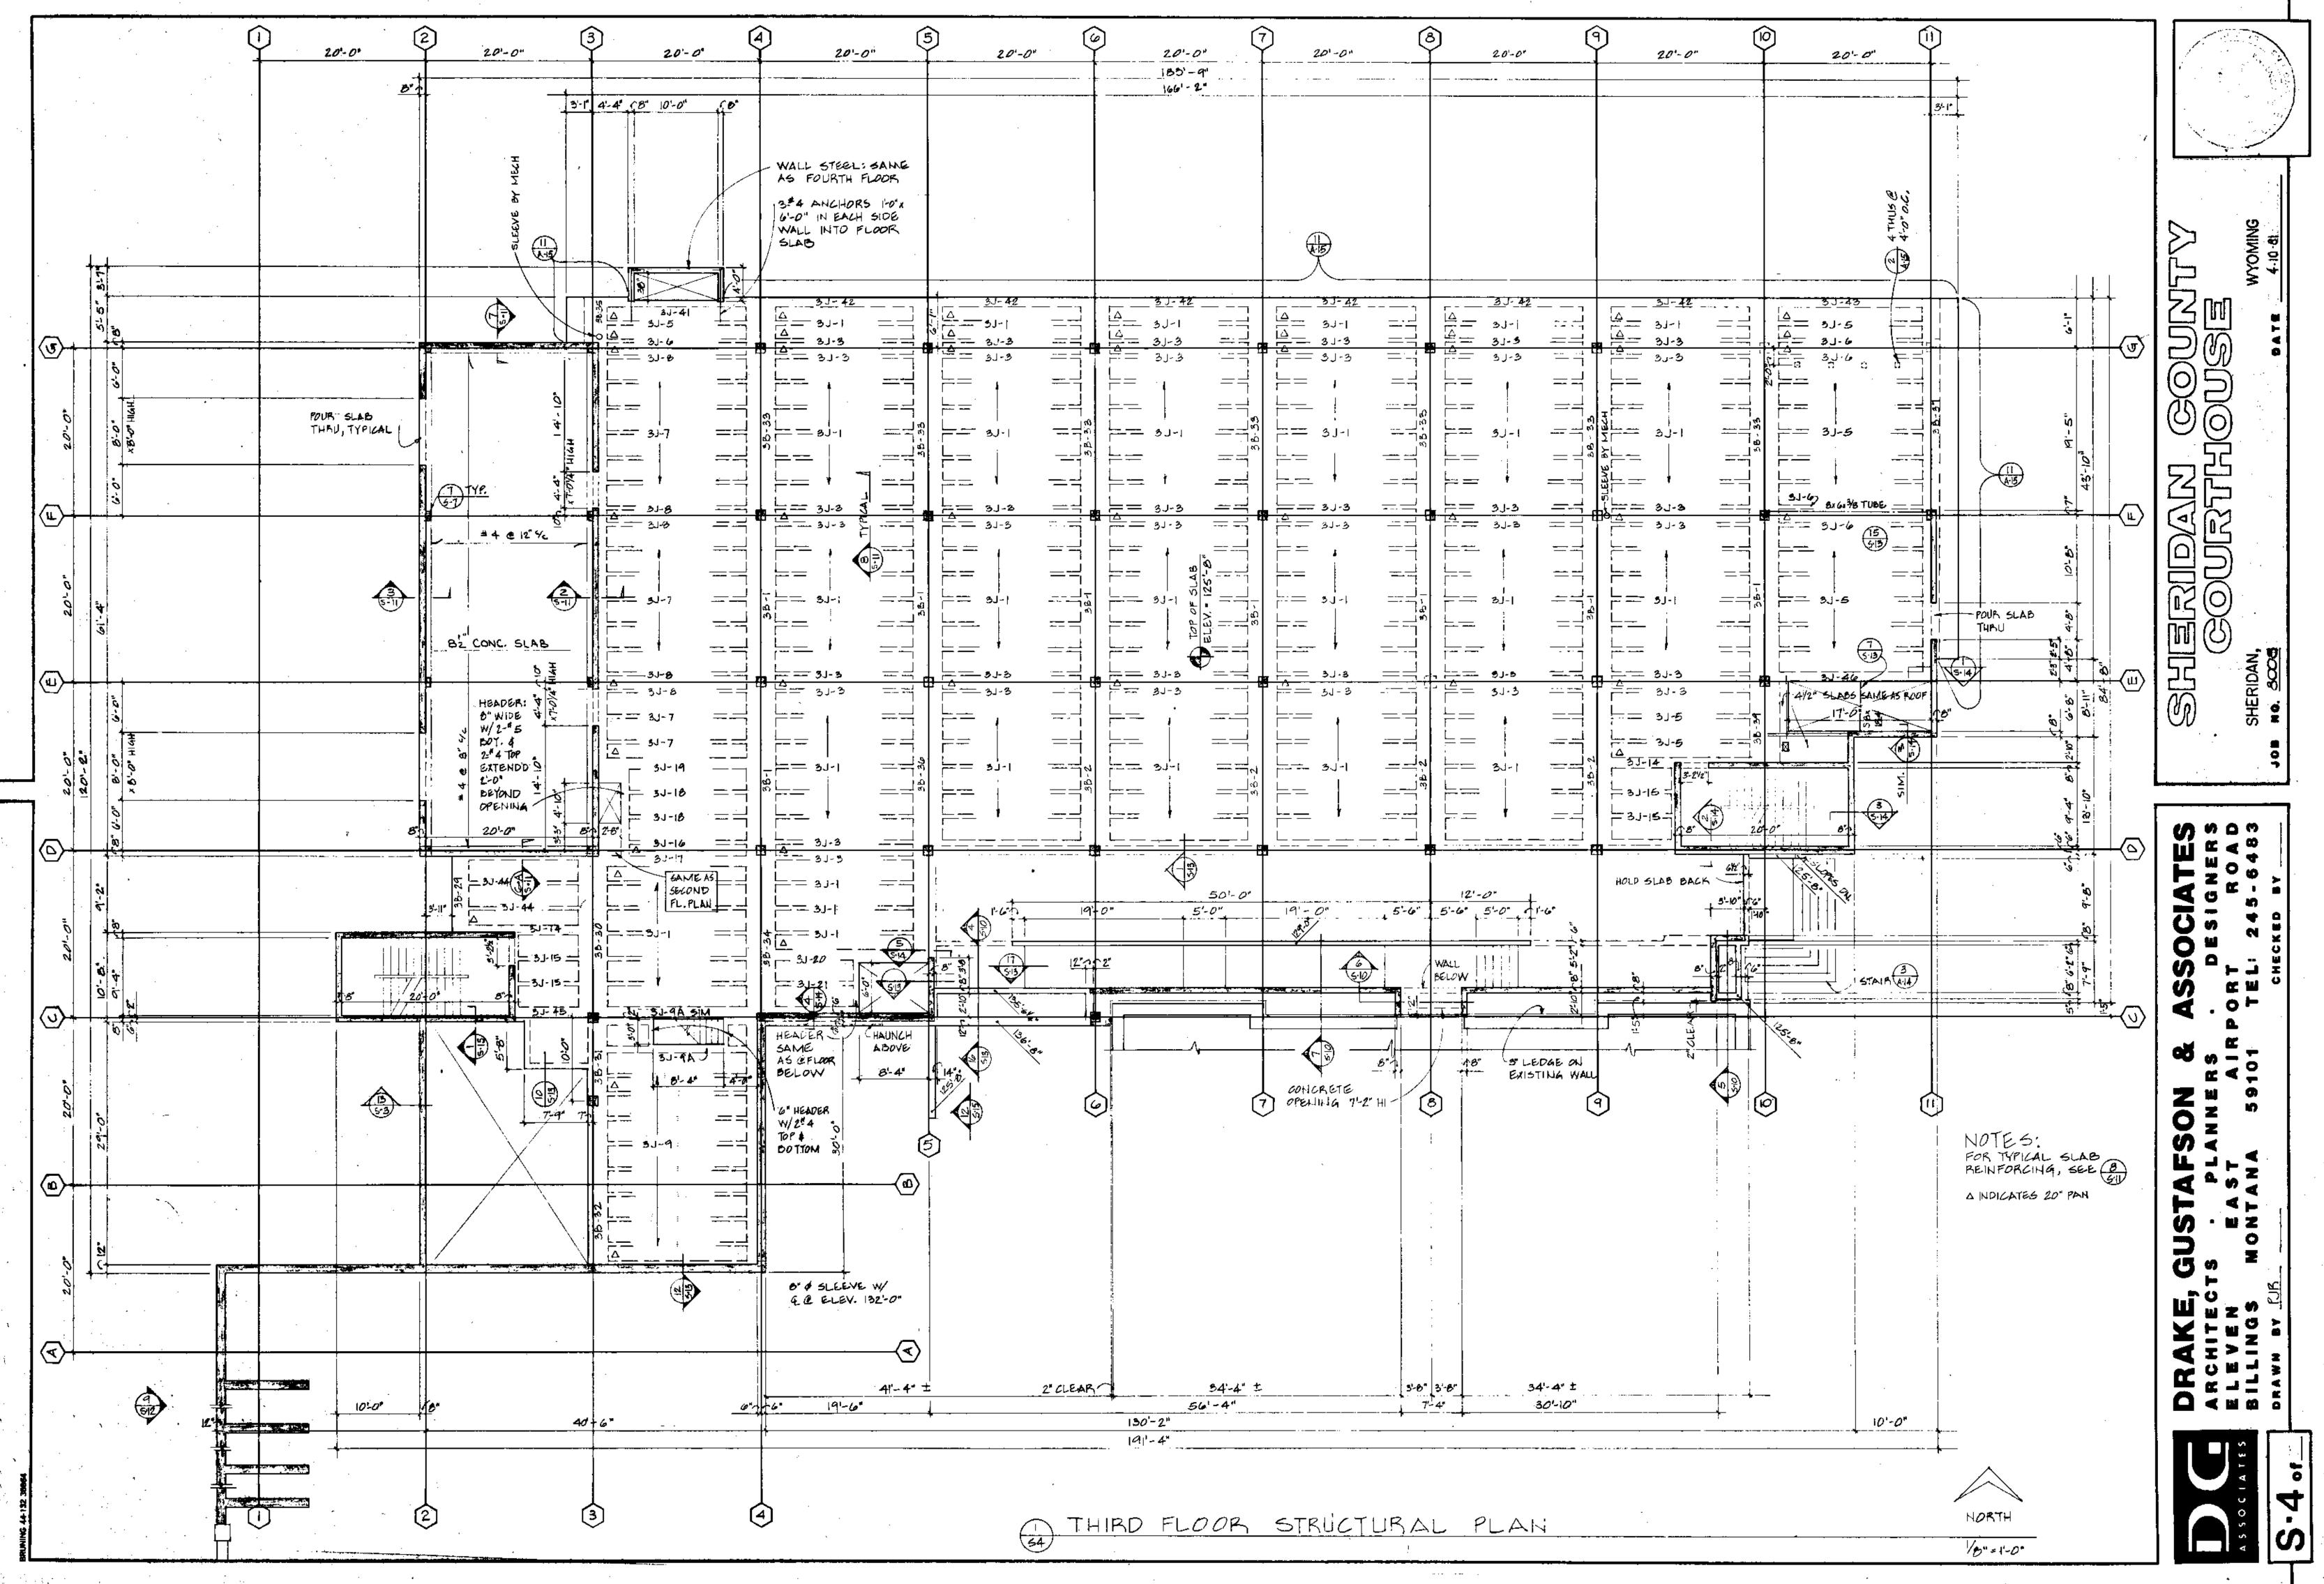


• ;

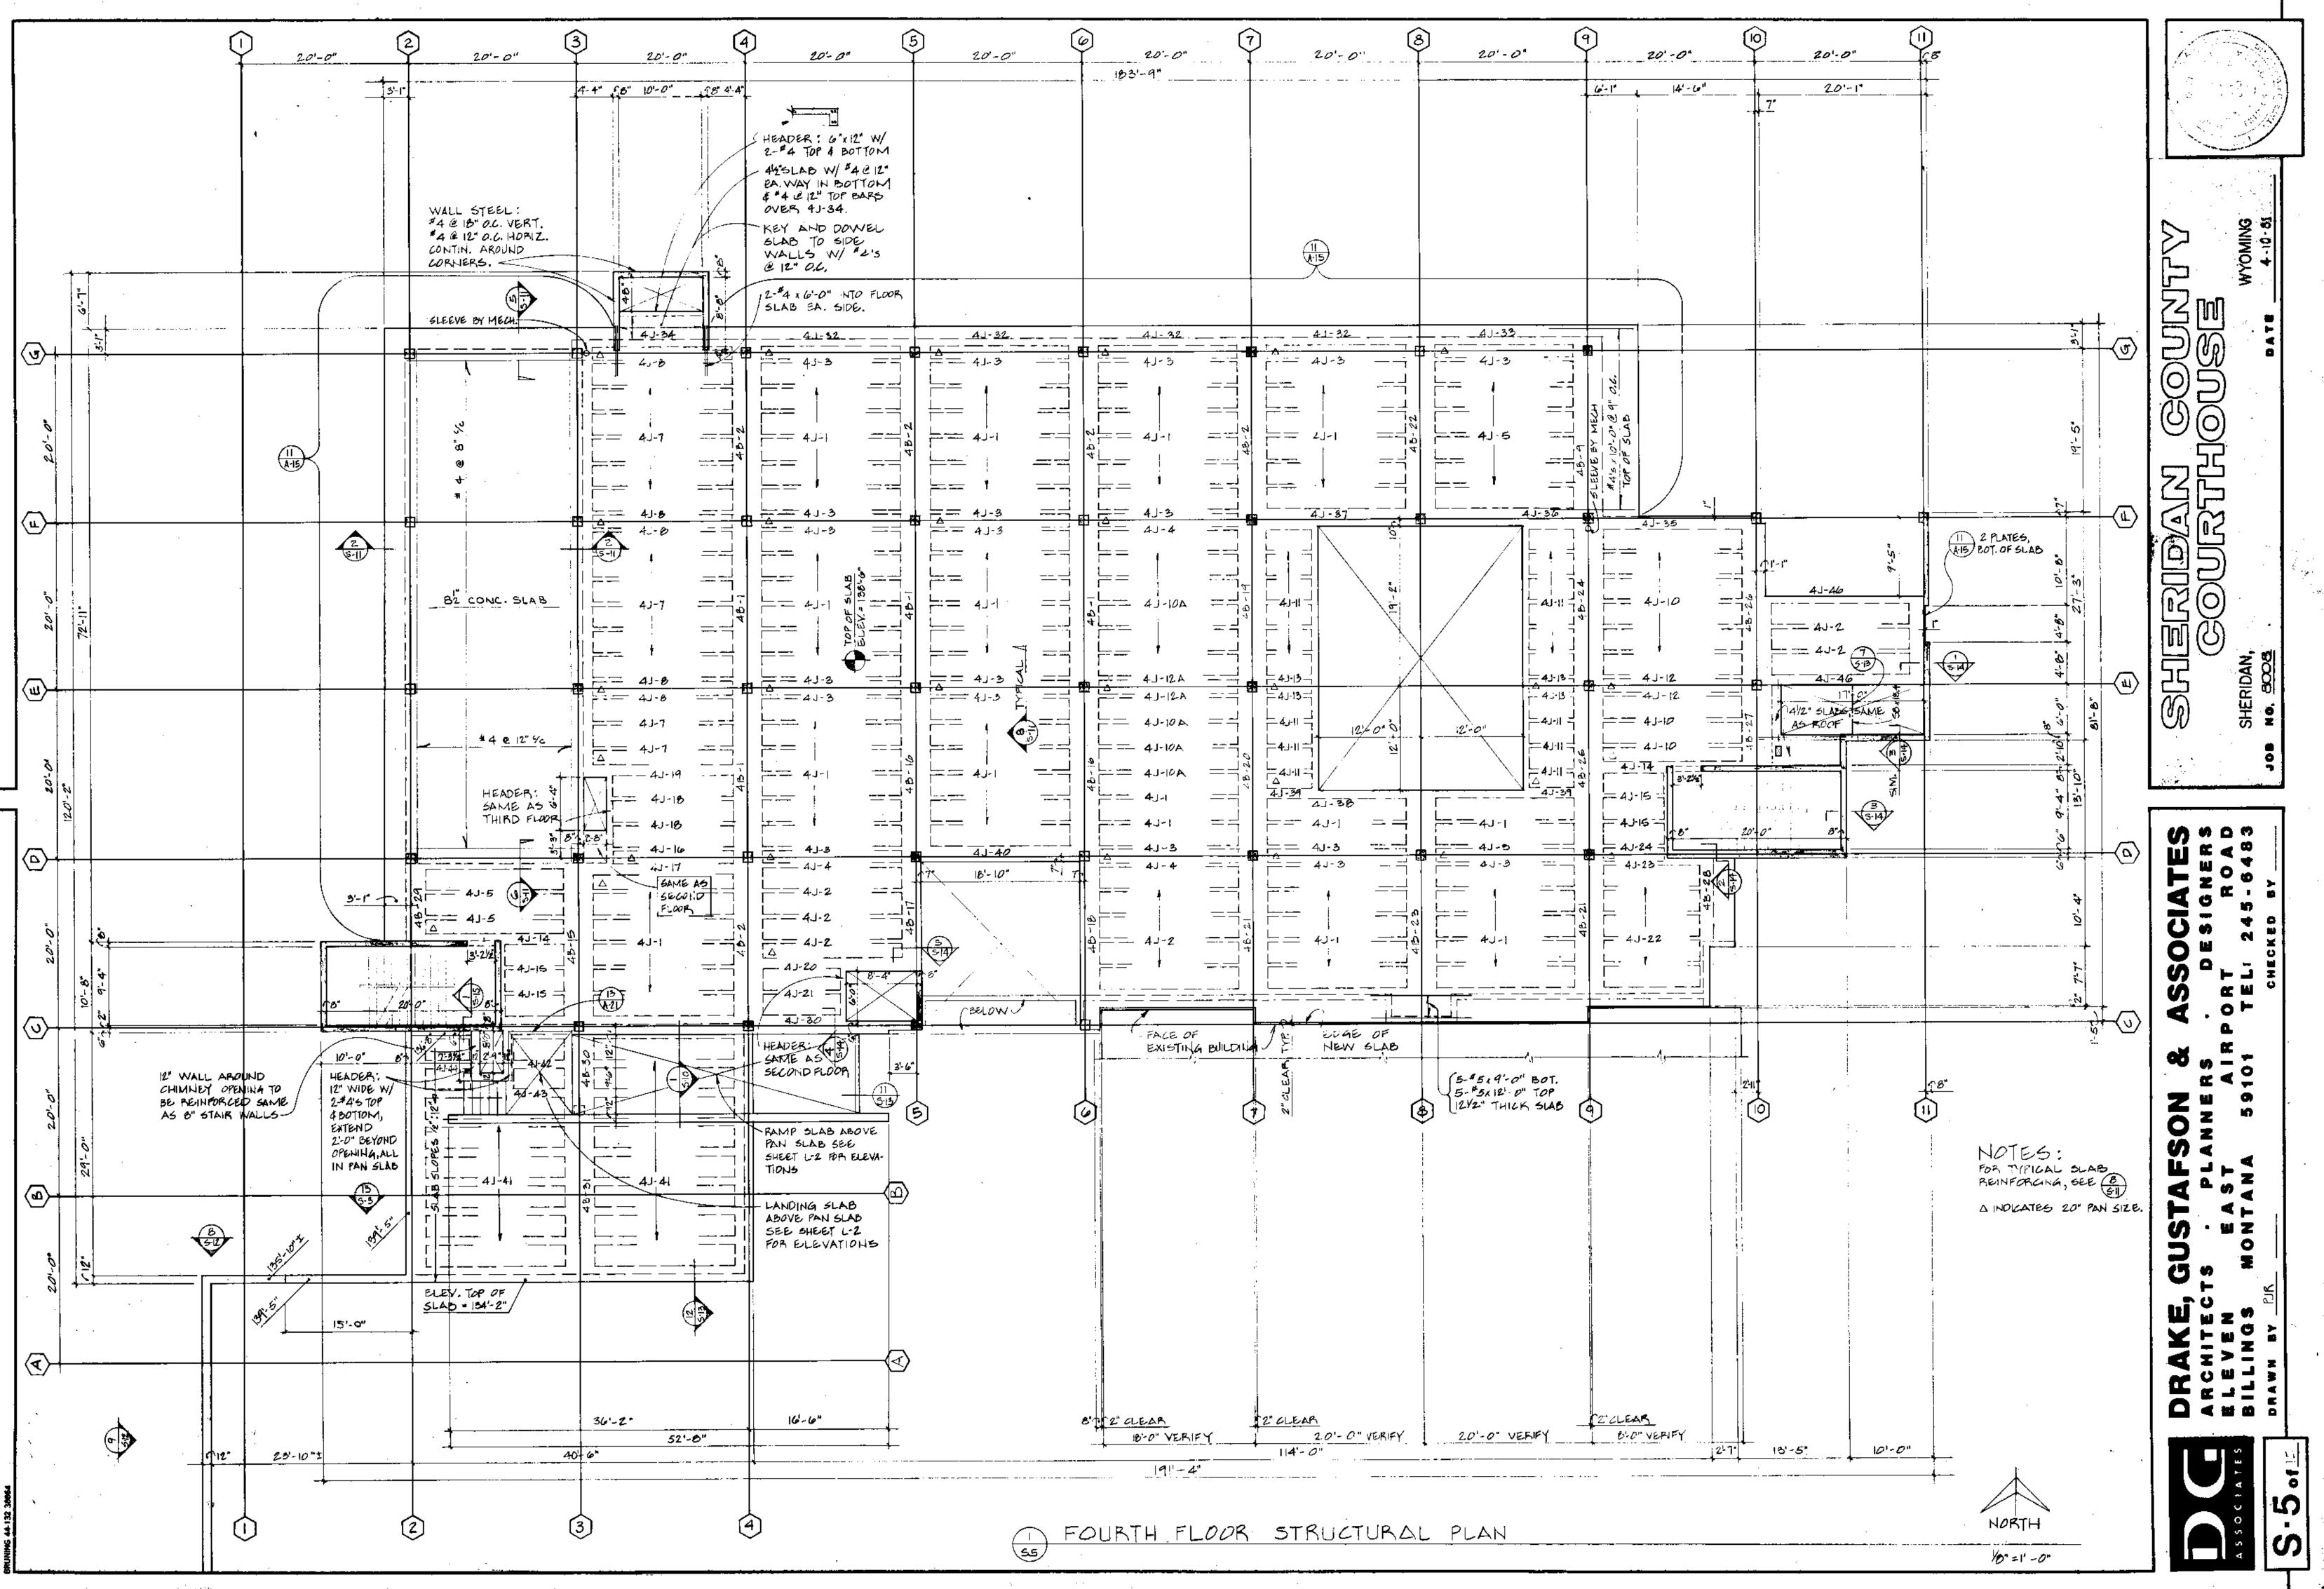


N

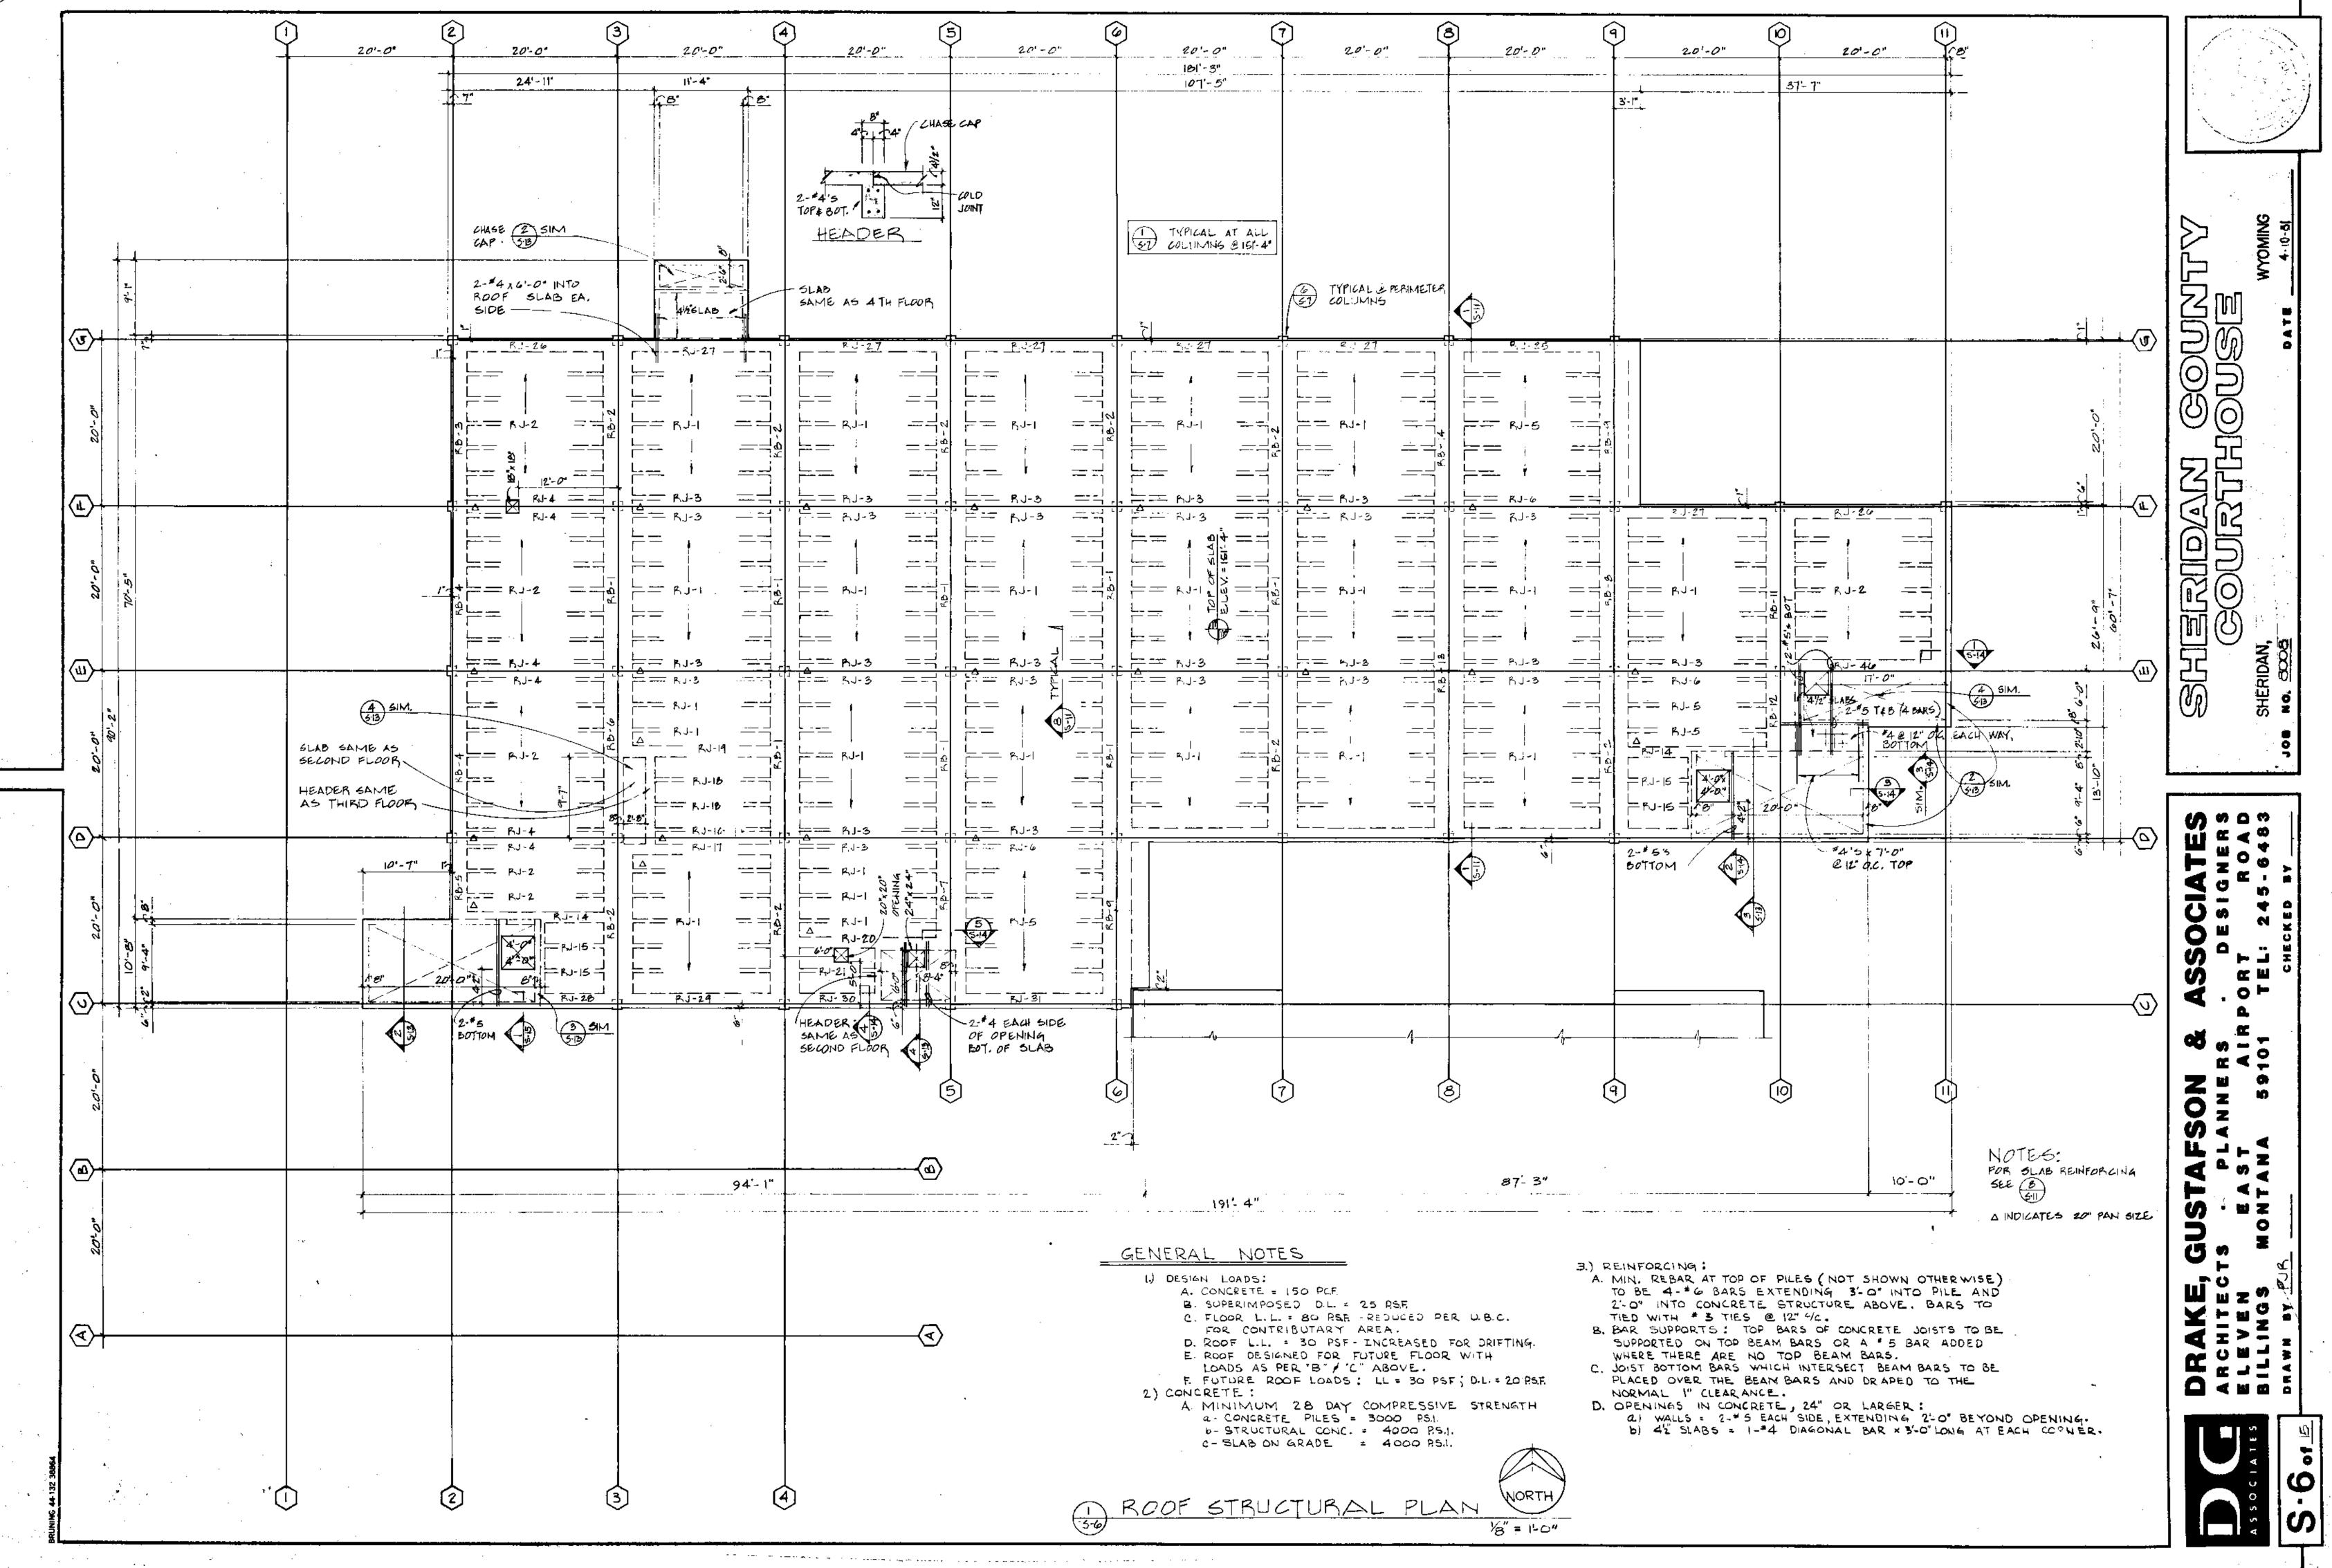


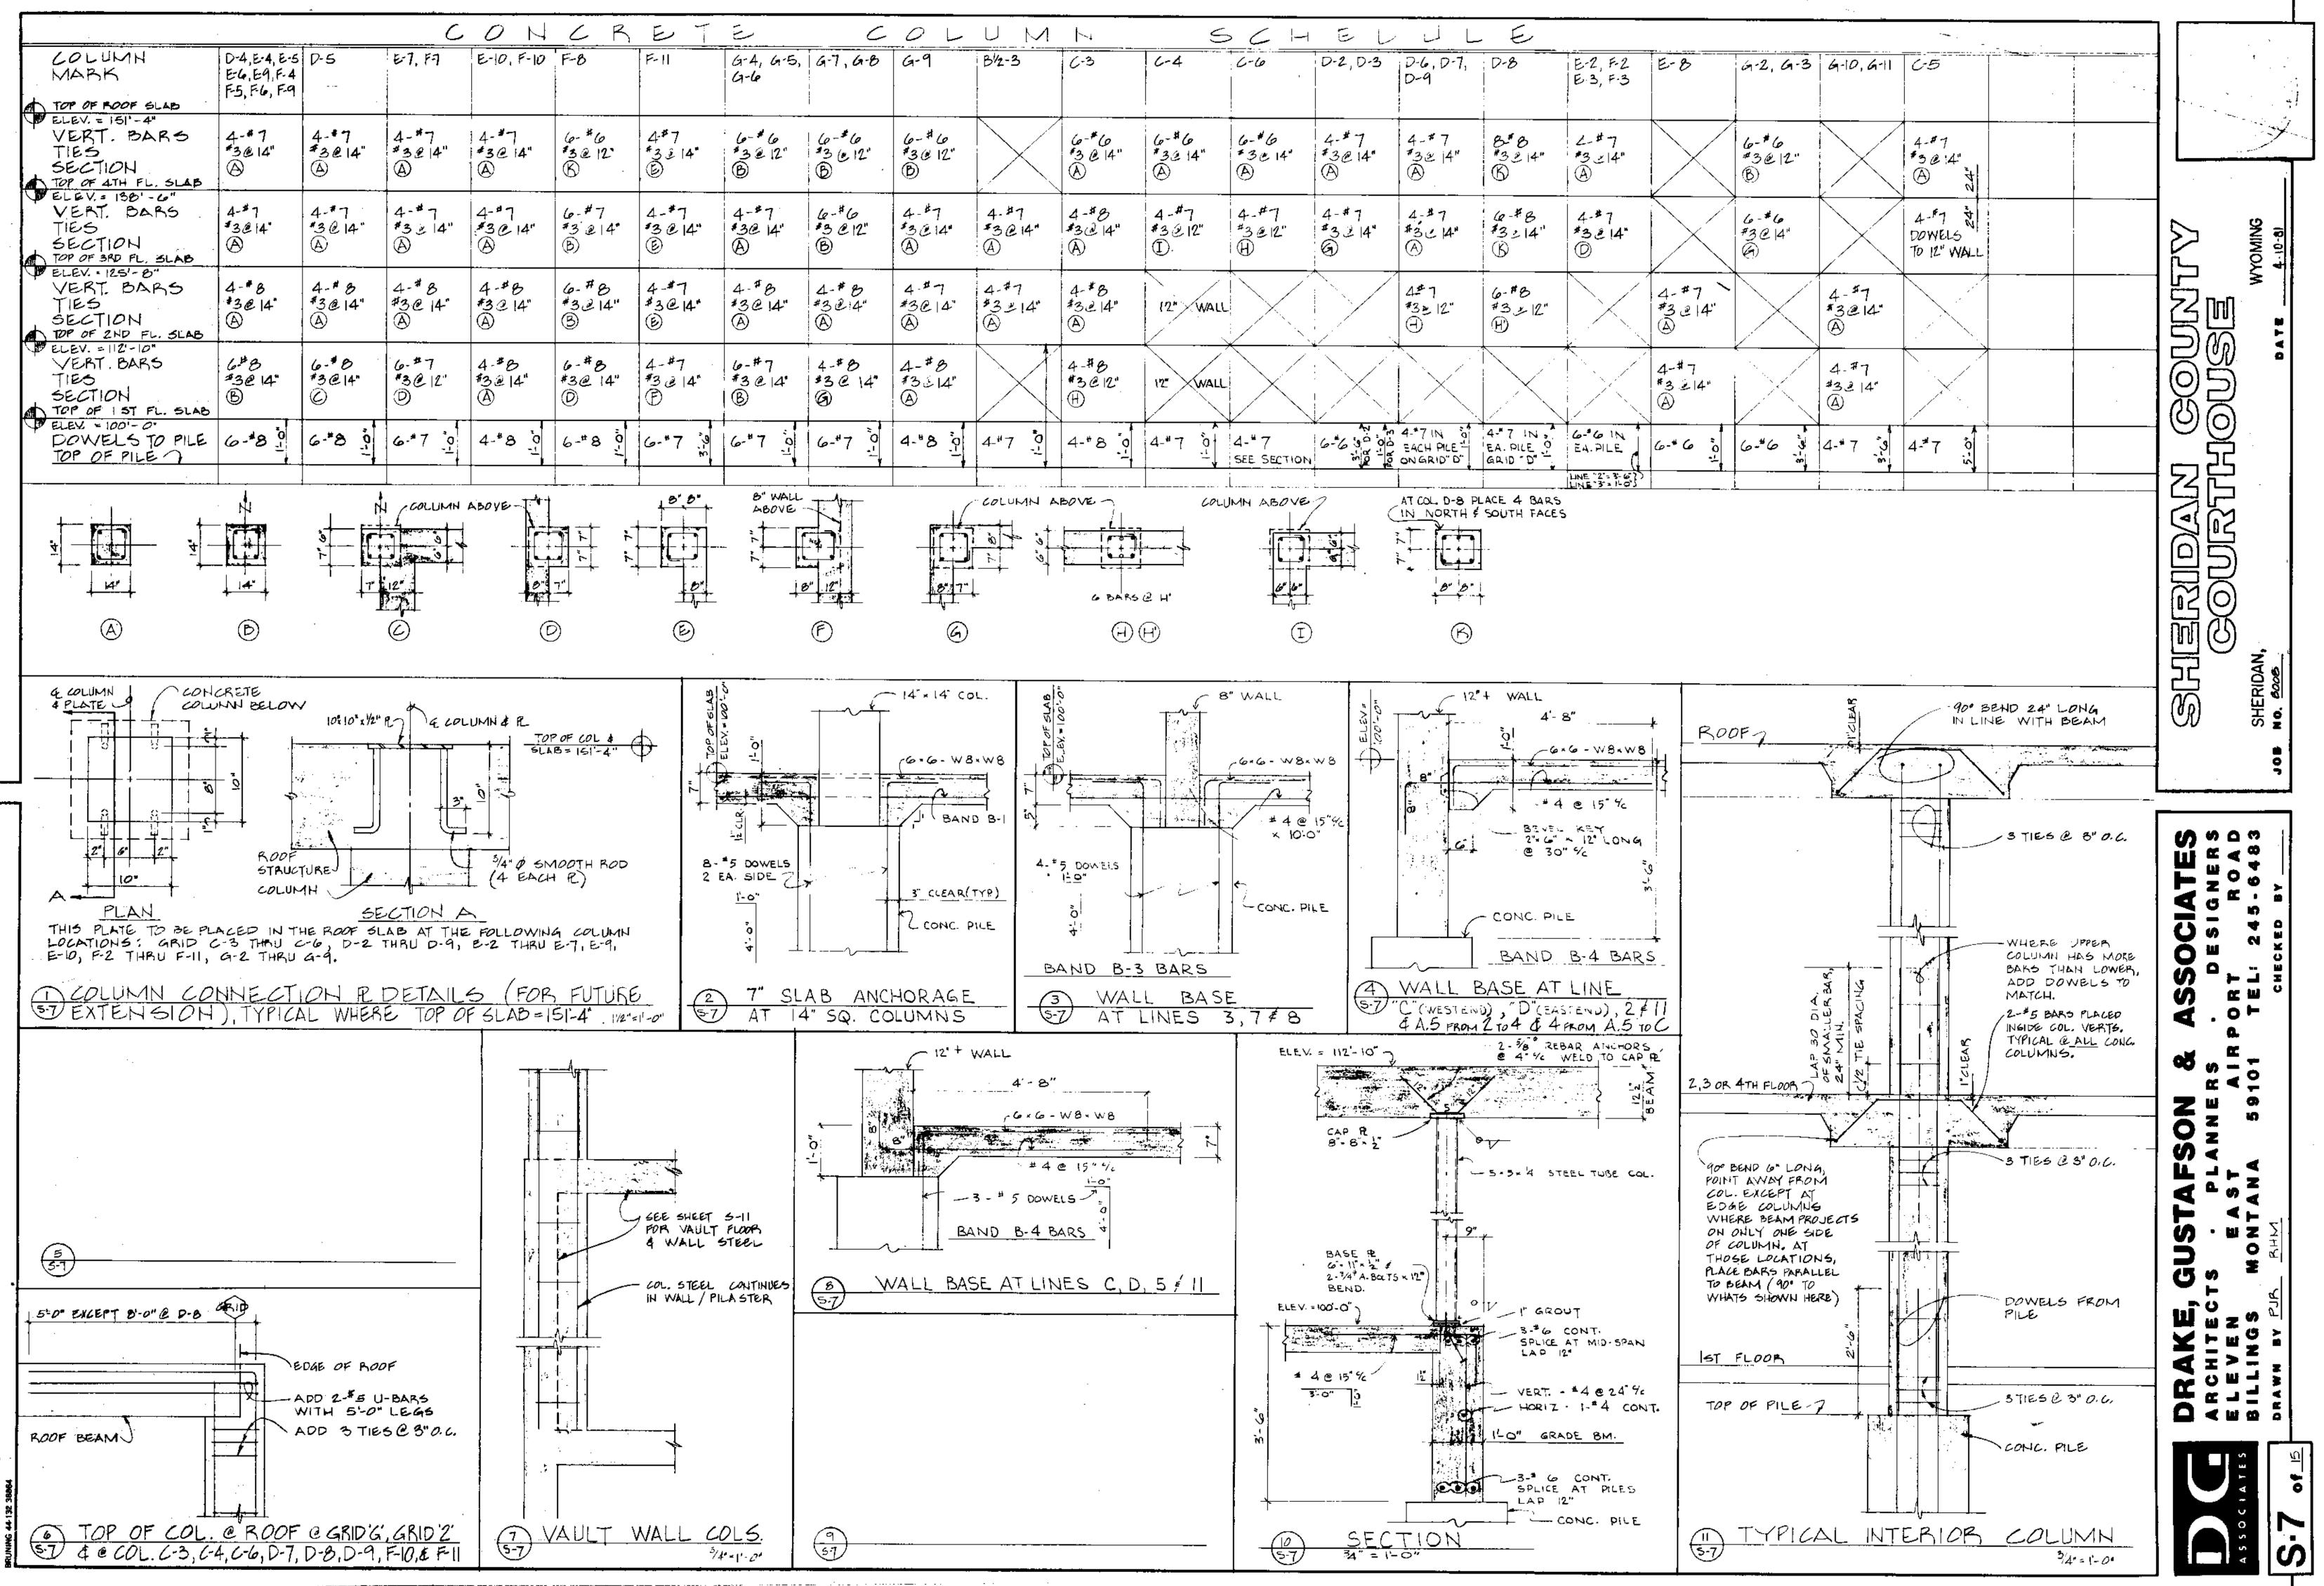


•

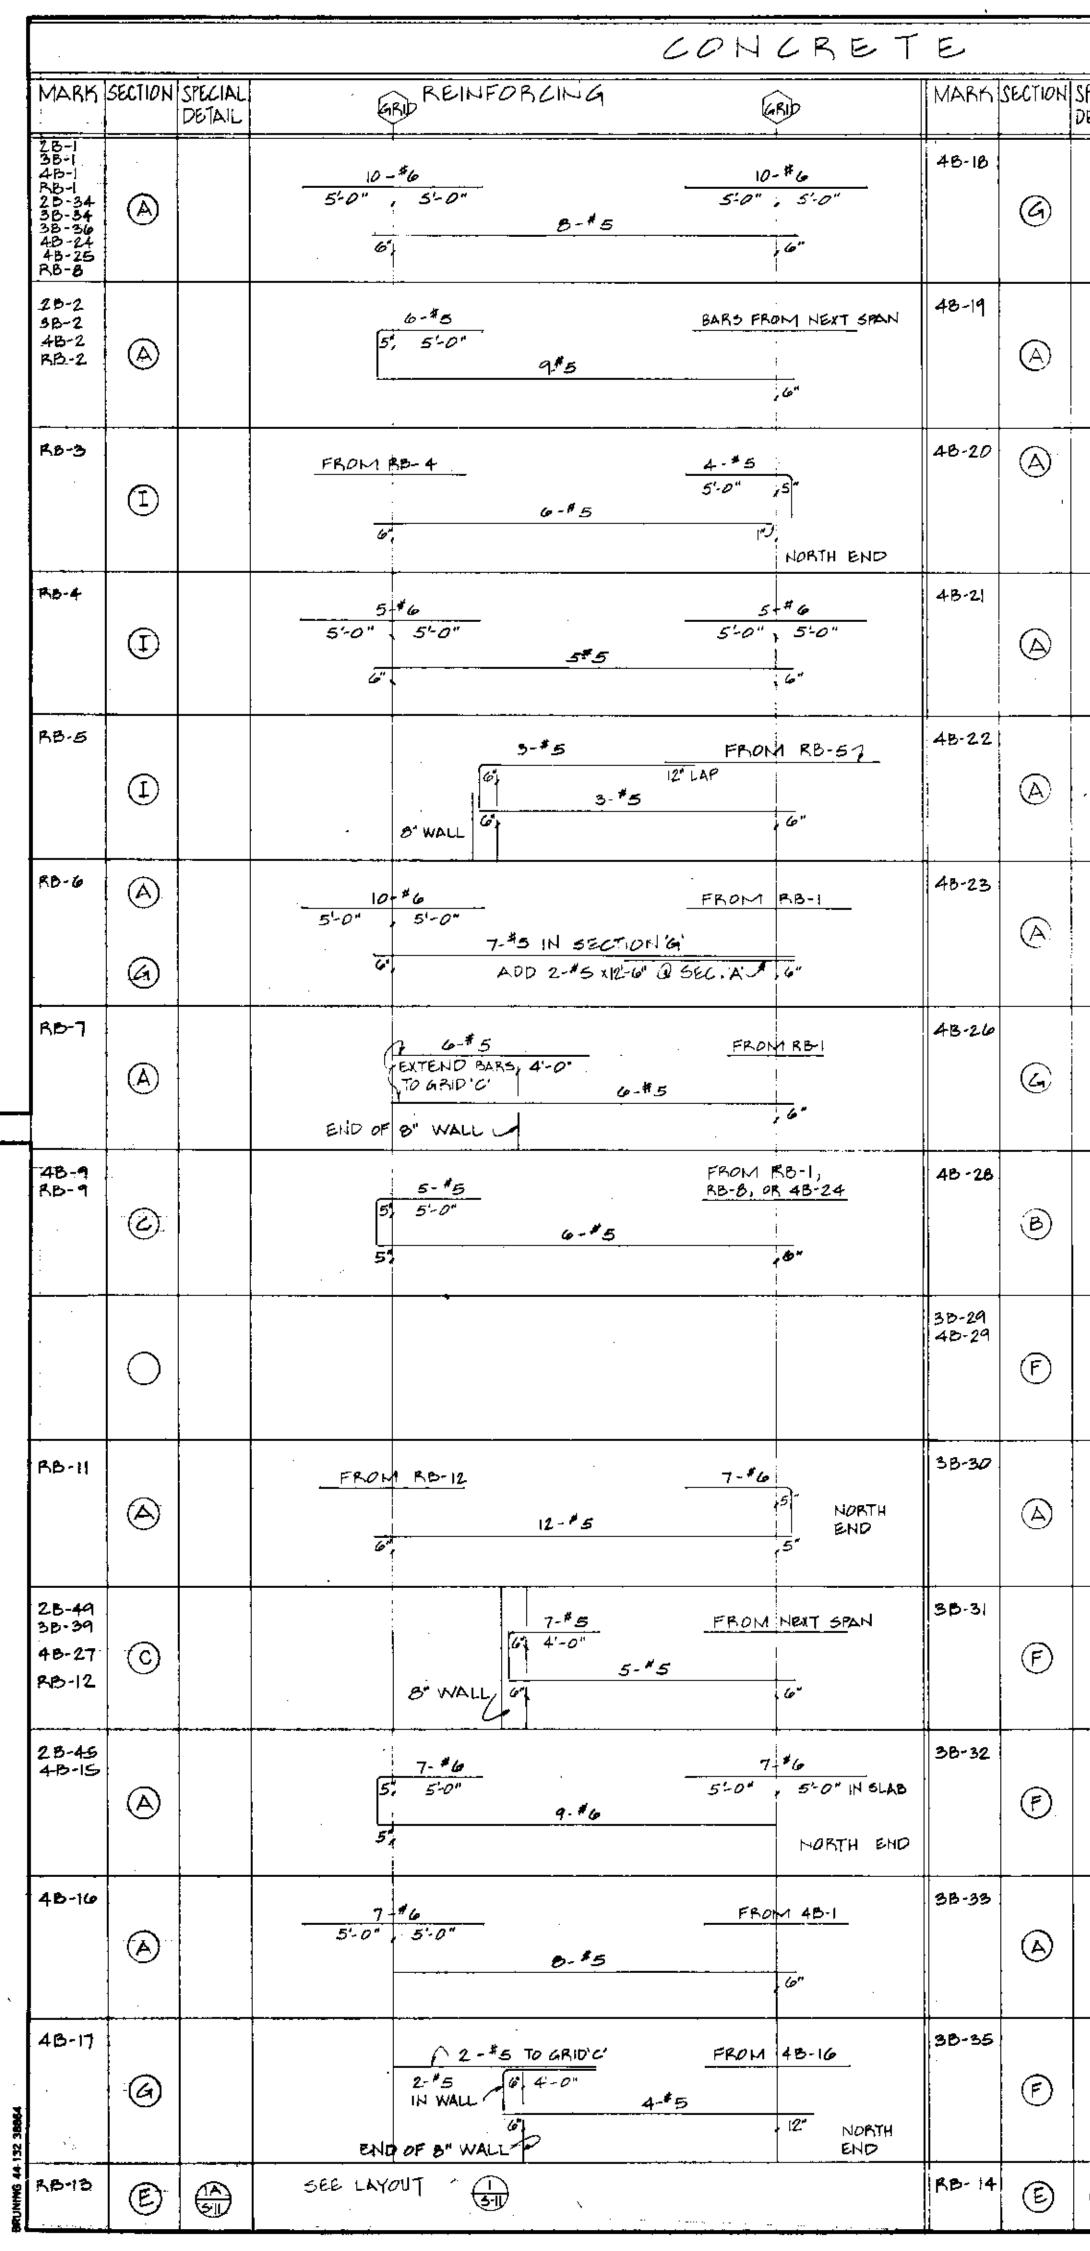



| | BEAM. | | | 5 | CHEDUL |
|-----------------|--|----------------|------------|-------------------|---|
| PECIAL ETAIL | REINFORCING | MARK | SECTON | SPECIAL DETAIL | GRID REI |
| | 3-#5 INTO COL. 7 (3-#5 BENT IN WALL 5: 4-6 5#5-1 6" WALL | 3B-37 | Ē | | 6 # 5 5'-0" ; 5'-0" 6"; |
| | 9-*6 5'-0" 5'-0" 8-*5 6" | | \bigcirc | | |
| | 9 * 6 5'-0" 5'-0" 6" 6' | 2.B-40 | (A) | | 4'-0" 8" WALL |
| | TO SLAB END 7 3-#5 3-#5 IN WALL | 23-4 28-42 | | | FROIA 28-1 OR 5-56 GR.77887LAP 24 5'-0", 5'-0" 5 |
| | 5-#6 5. 5'-0" 10-#6 5. 5' | 28-43 | Ĥ | | 4'-2" |
| | EXTEND BARS TO END OF CANTILEVER B'WALL B | 2B-44 | (H) · | | 4'-0"; 6"; 8" WALL |
| | B+#6 5'-0", 5'-0" | 28-46 | (A) (H) | | 12" WALL 10" |
| | 4-#5 4-#5 BARS TO 13'-0" EDGE OF 1 2-#5 6" NORTH END | 2B-47 | G | | 6-*6 5-0" , 5'-0" 6", |
| | 4-#5 2-#5 3'0" IN SLAD 6" 3'-0" 3'-0" 6" 4-#5 1N WALL 6" 5" 8" WALL | 213-48 | (A) (G) | | 6+ ^{\$} 6 5'-0", 5'-0" 6, |
| | $ \begin{array}{ccccccccccccccccccccccccccccccccccc$ | 2.8-50 | J | | 8"WALL |
| | FROM 3B-32 4-#5 6" | 4B-30 | B | | 8-#- 5'-0" ; col. 4 |
| | $ \begin{array}{c ccccccccccccccccccccccccccccccccccc$ | 4B-31 | B | | 12" WALL SOUTH END 10", 5'-0" |
| | FROM 3B-1 6'-0", 5'-11" 9-*5 6', 5'-11" NOBTH END | 2B-51 | H | | 3-*5 4'-0" 4'-0" 12" - |
| | 6+ *5 6-*5 6-*5 <u>4-*5</u> <u>2-0"</u> | | 0 | | |
| | SEE LAYOUT (51) | | 0 | | |

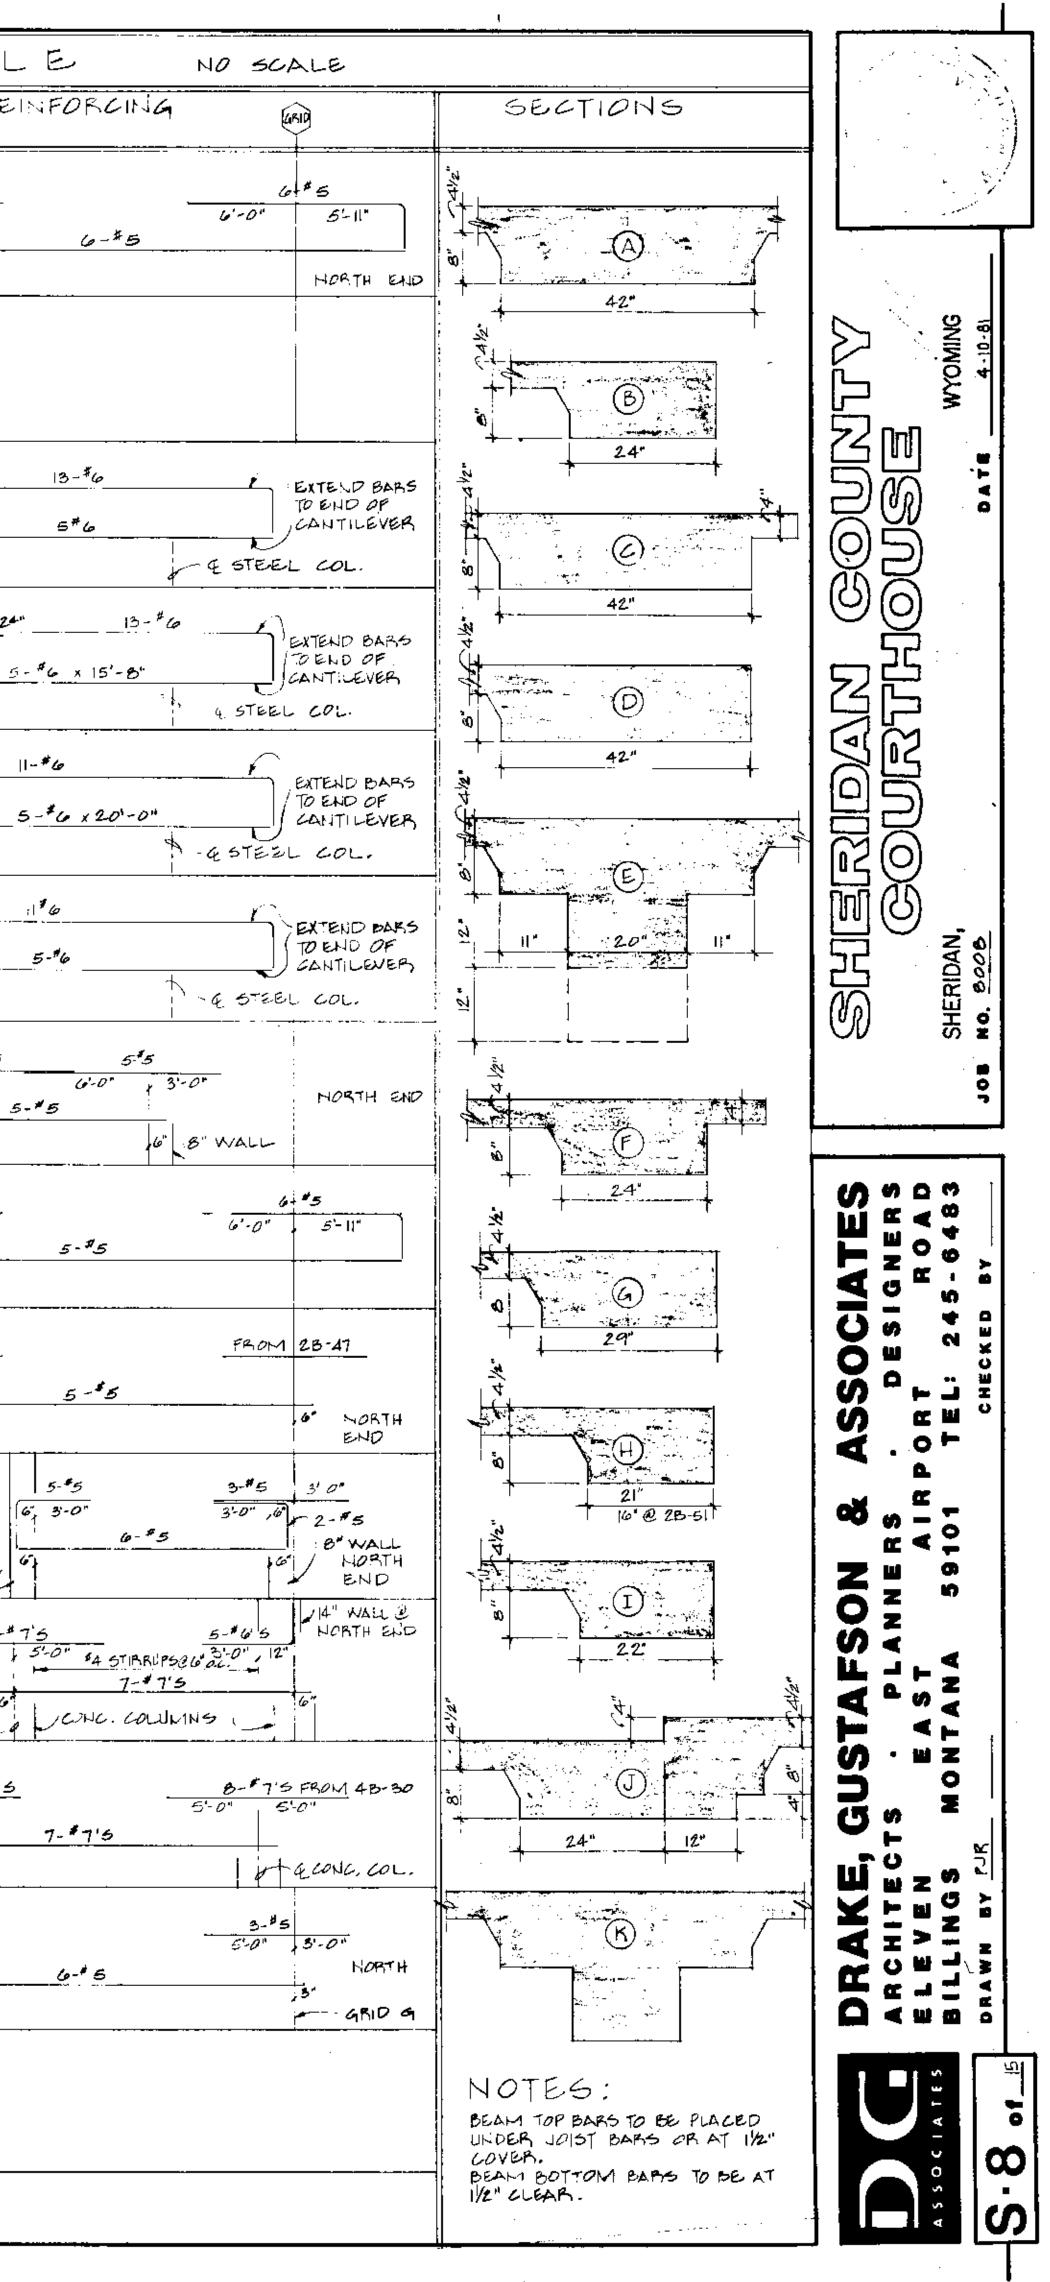


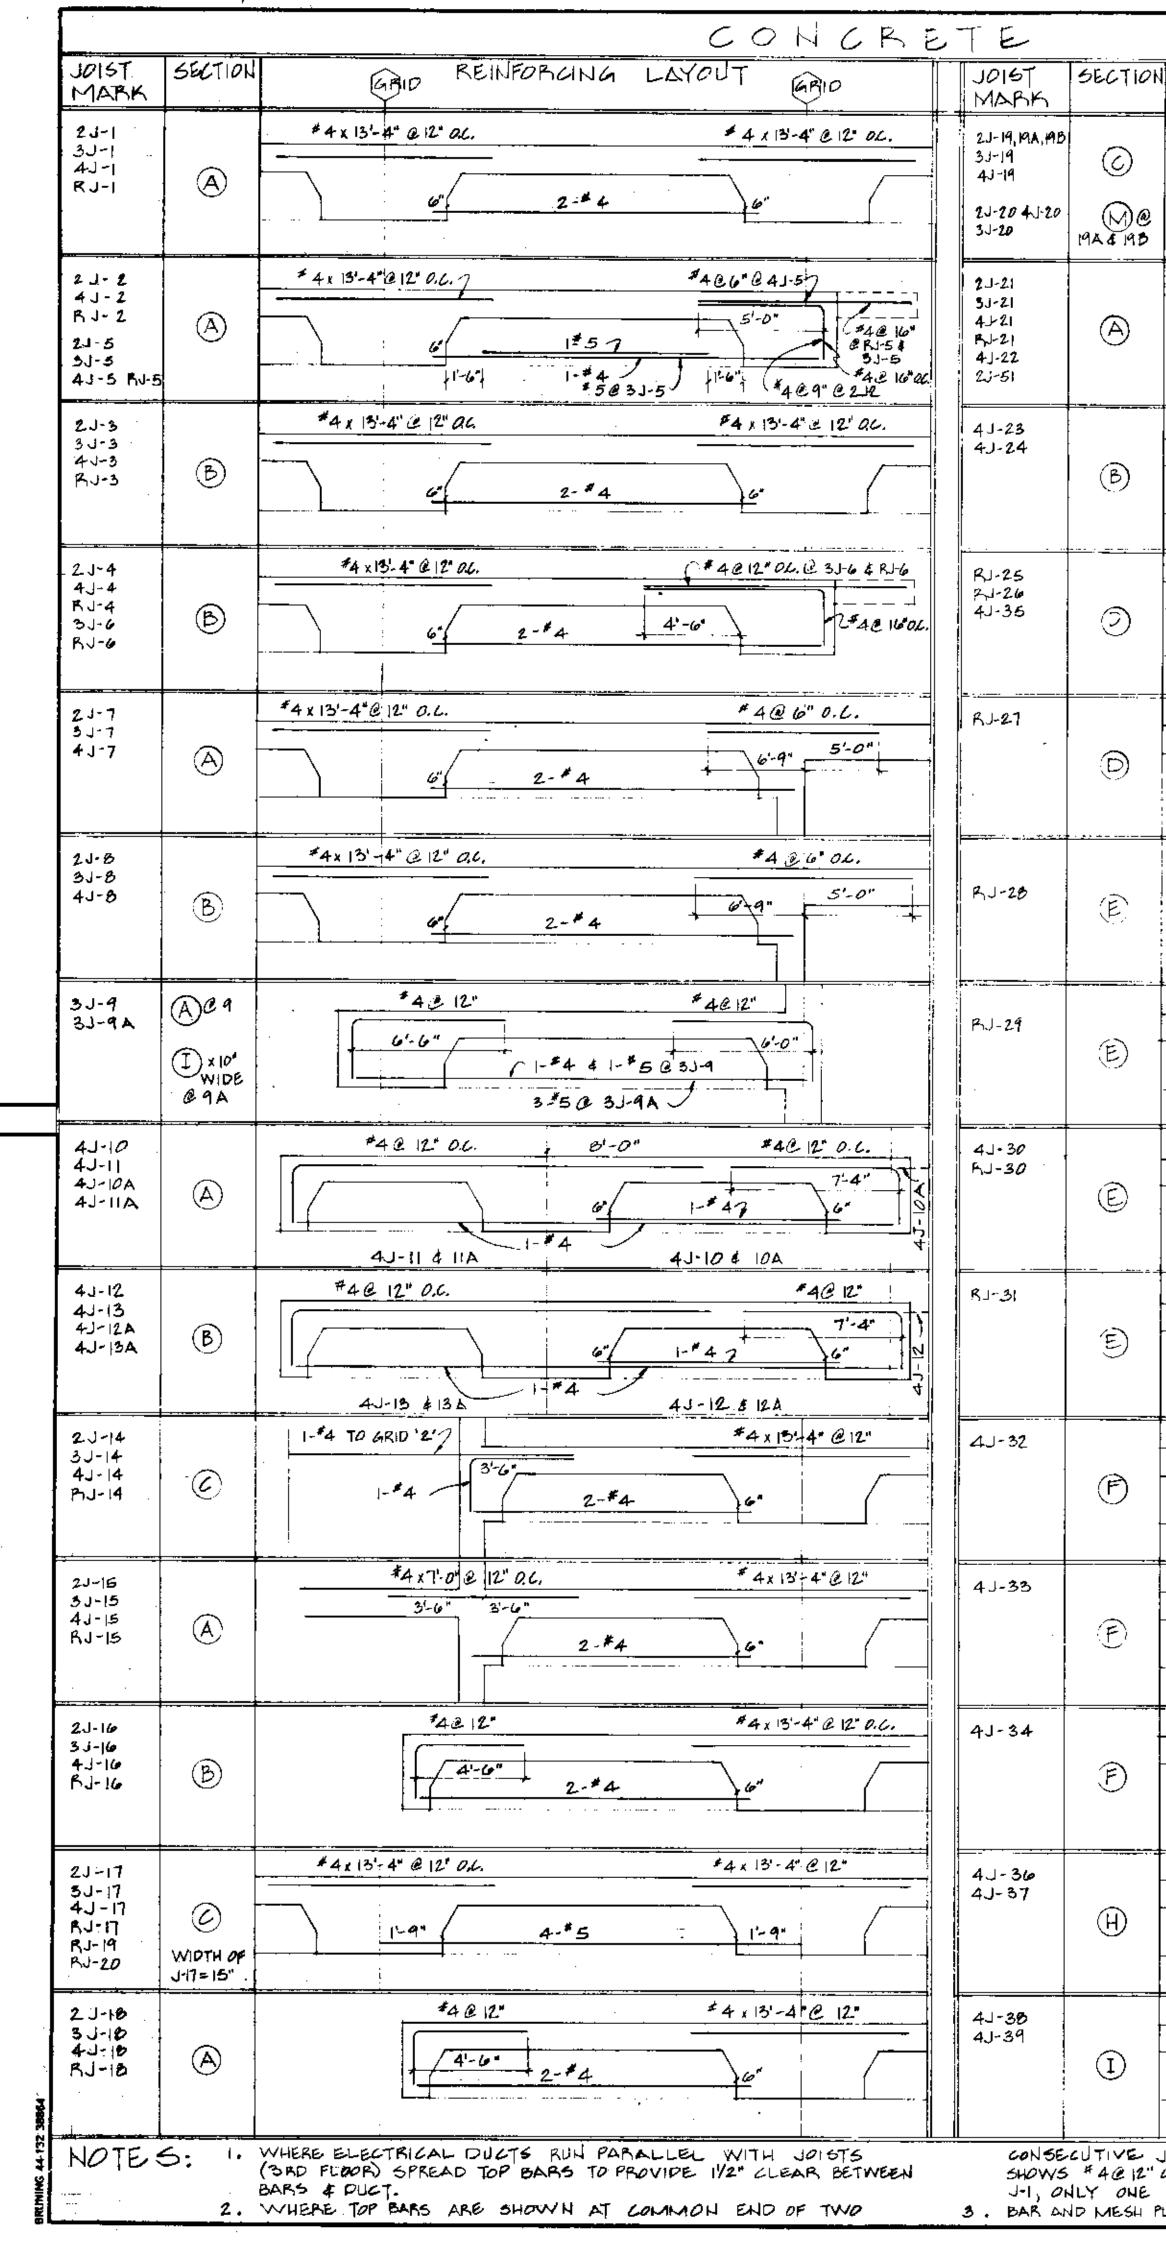



J01 5 SCHEDULE NO SCALE REINFORCING LAYOUT J015T SECTION GRID MARK #4@6"@ J-19-3-#5 x 13'-4" 4 x 13'-4"@ 12" 0.6 4-1-40 (\mathbf{H}) 4-*5 (M) @*4 8 12 @ J-20 2-3 6-#5 @ :9A 8-#5 @ 19B (*4@12"@4J-22 * 4 x 13'-4" @ 12" O.C. 4- #5 FROM J-42 31-41 3J-43 / 4'-6" آست ک * 4 @ 12" a.c. 2-*4 2-3" #4 , 13-4" @ 12" 26. 2-4 4 4 3-23-3-#5x13'-4" 3 .) - 42 2.1-54 5'-6" 5) 3-6 * 4 212 0.6. 2-*4 2-3" 4.45 FROM RJ-27 OR AJ.36 #4 @ 12" ac. @ BJ-25-31-44 #4@ 12" D.L. \mathbf{r} <u>∖</u>6'-0" (A 3-15 3-#5 2'-3" ~~~ 4-#5 x 13-4" 4-#5x 13'-4" #4312 31-45 K) 3-6" 3'-6" 2'-3" 3-#5 - **-** -2'-3" 4.04 FROM RJ-29 OR 4J-297 #4x 13'-4" @ 12" al 31-46 (l_{-}) B- - 40 20-47 3-#4 2-3" 21-46 (\mathbf{I}) 41-46 4-*51 13'-4" 4-15 x 13'-4" #41216 23-48 Ò #4@16* .3-#5 2'-3" 2'-3" 3-#5 # 4 J-30 FROM RJ-31 FROM RJ-29 08 4J-20 (M)*4@12* 121-49 3-*5 2:3" 23-50 A4 #5 x 13'-4" 4-55 FROM 2J-51 21-52 _____ ····-7'-8" $\langle \hat{I} \rangle$ 3-*5 4#-5 × 13'-4" 4-#5x 13-4" FROM 2J-54 21-53 $(\widehat{1})$ 2'- 3" 3-#5 2-3" 2'-3" -----,3-#50 COL. #400"0.67 FROM 4J-32 FROM 23-1 \$ 23-3 21-55 ------7-0" 2-5 3-#5 2'-3" 2J-56 3 2-157 FBOM 4J-32 5 - *** 6**'5 X 13'-4'' 4J-4 (\mathbf{I}) 2-151 . 2 - 3" 4-#5 × 18'-4' 4-*5x 13'-4" #4'5 @ 12" 0.6. 4J-43 6, 5-6 (\mathbf{I}) 3-#5 2'-3" 2-3" · ____ · __ · __ · · 4-#5 * 13-4 4-*5x 13'-4" #4'5@12" 0.C. 4J-42 41-44 (\mathbb{I}) 3-*5 2-3" 2-3" 4J-44 CONSECUTIVE JOISTS, ONLY ONE SET IS REQUIRED. EXAMPLE: JOIST J-1 SHOWS #4@12" O.C. AT EACH END BUT, WHEN BUILT IN LINE WITH ANOTHER J-1, ONLY ONE SET OF #4'S @12" IS REQUIRED WHERE THE END'S MEET. 3. BAR AND MESH PLACING SEQUENCE @ ELECTRICAL DUCTS AS FOLLOWS: A. JOIST TOP BARS PLACED OVER HEADER HEADER DUCTS. B. PLACE MESH UNDER FEEDER DUCTS & PLACE A 24" WIDE STRIP OF 616-6/6 MESH OVER DUCTS. C . PLACE MESH OVER HEADER DUCTS. D. SPREAD JOIST TOP BARS TO MISS FEEDER DUCTS (11/2" CLEAR).

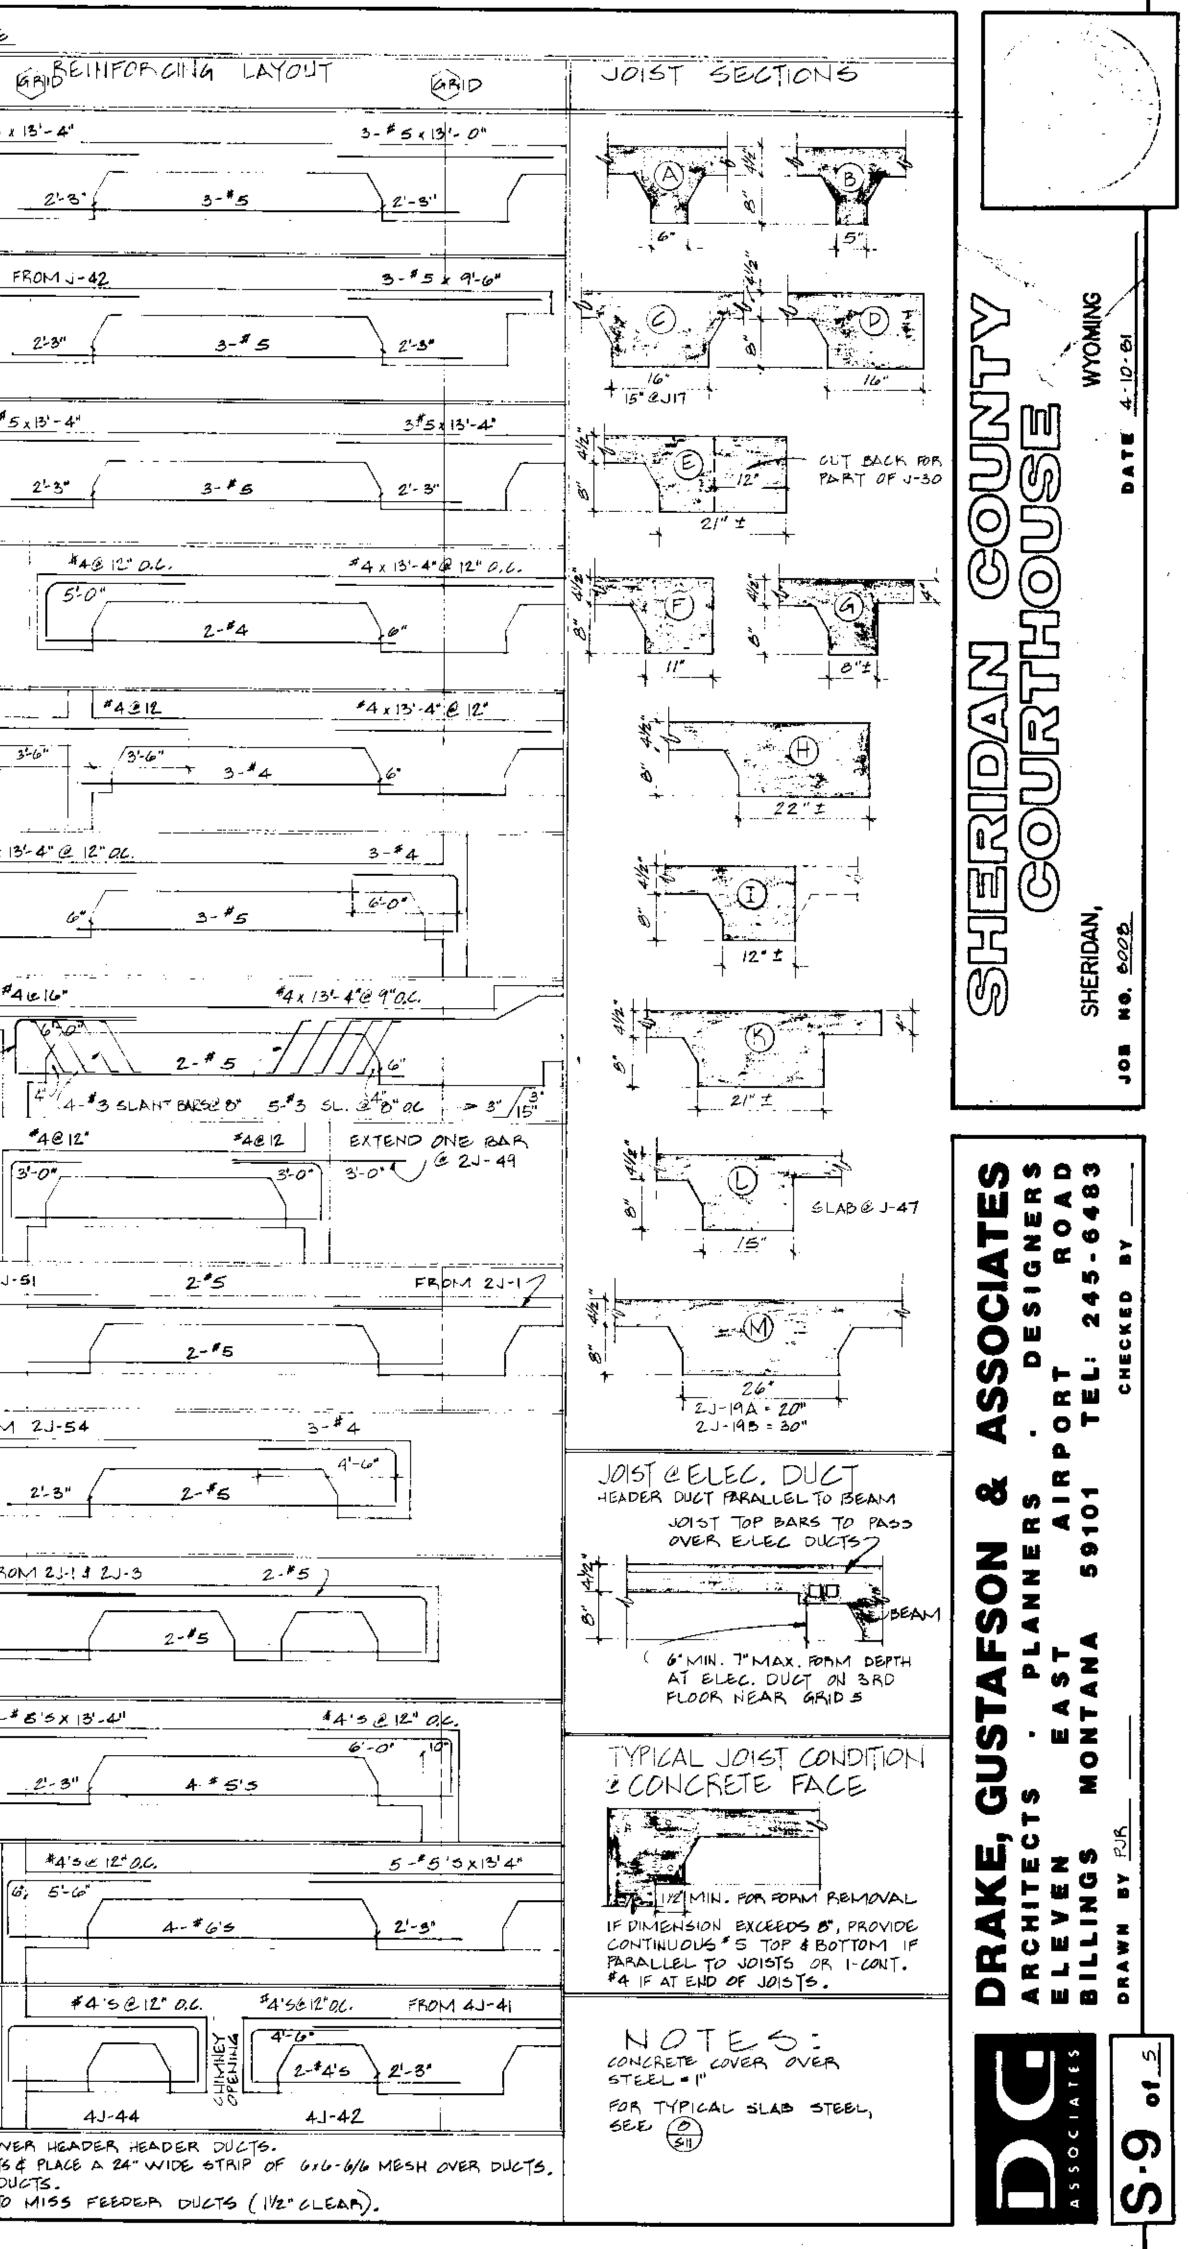


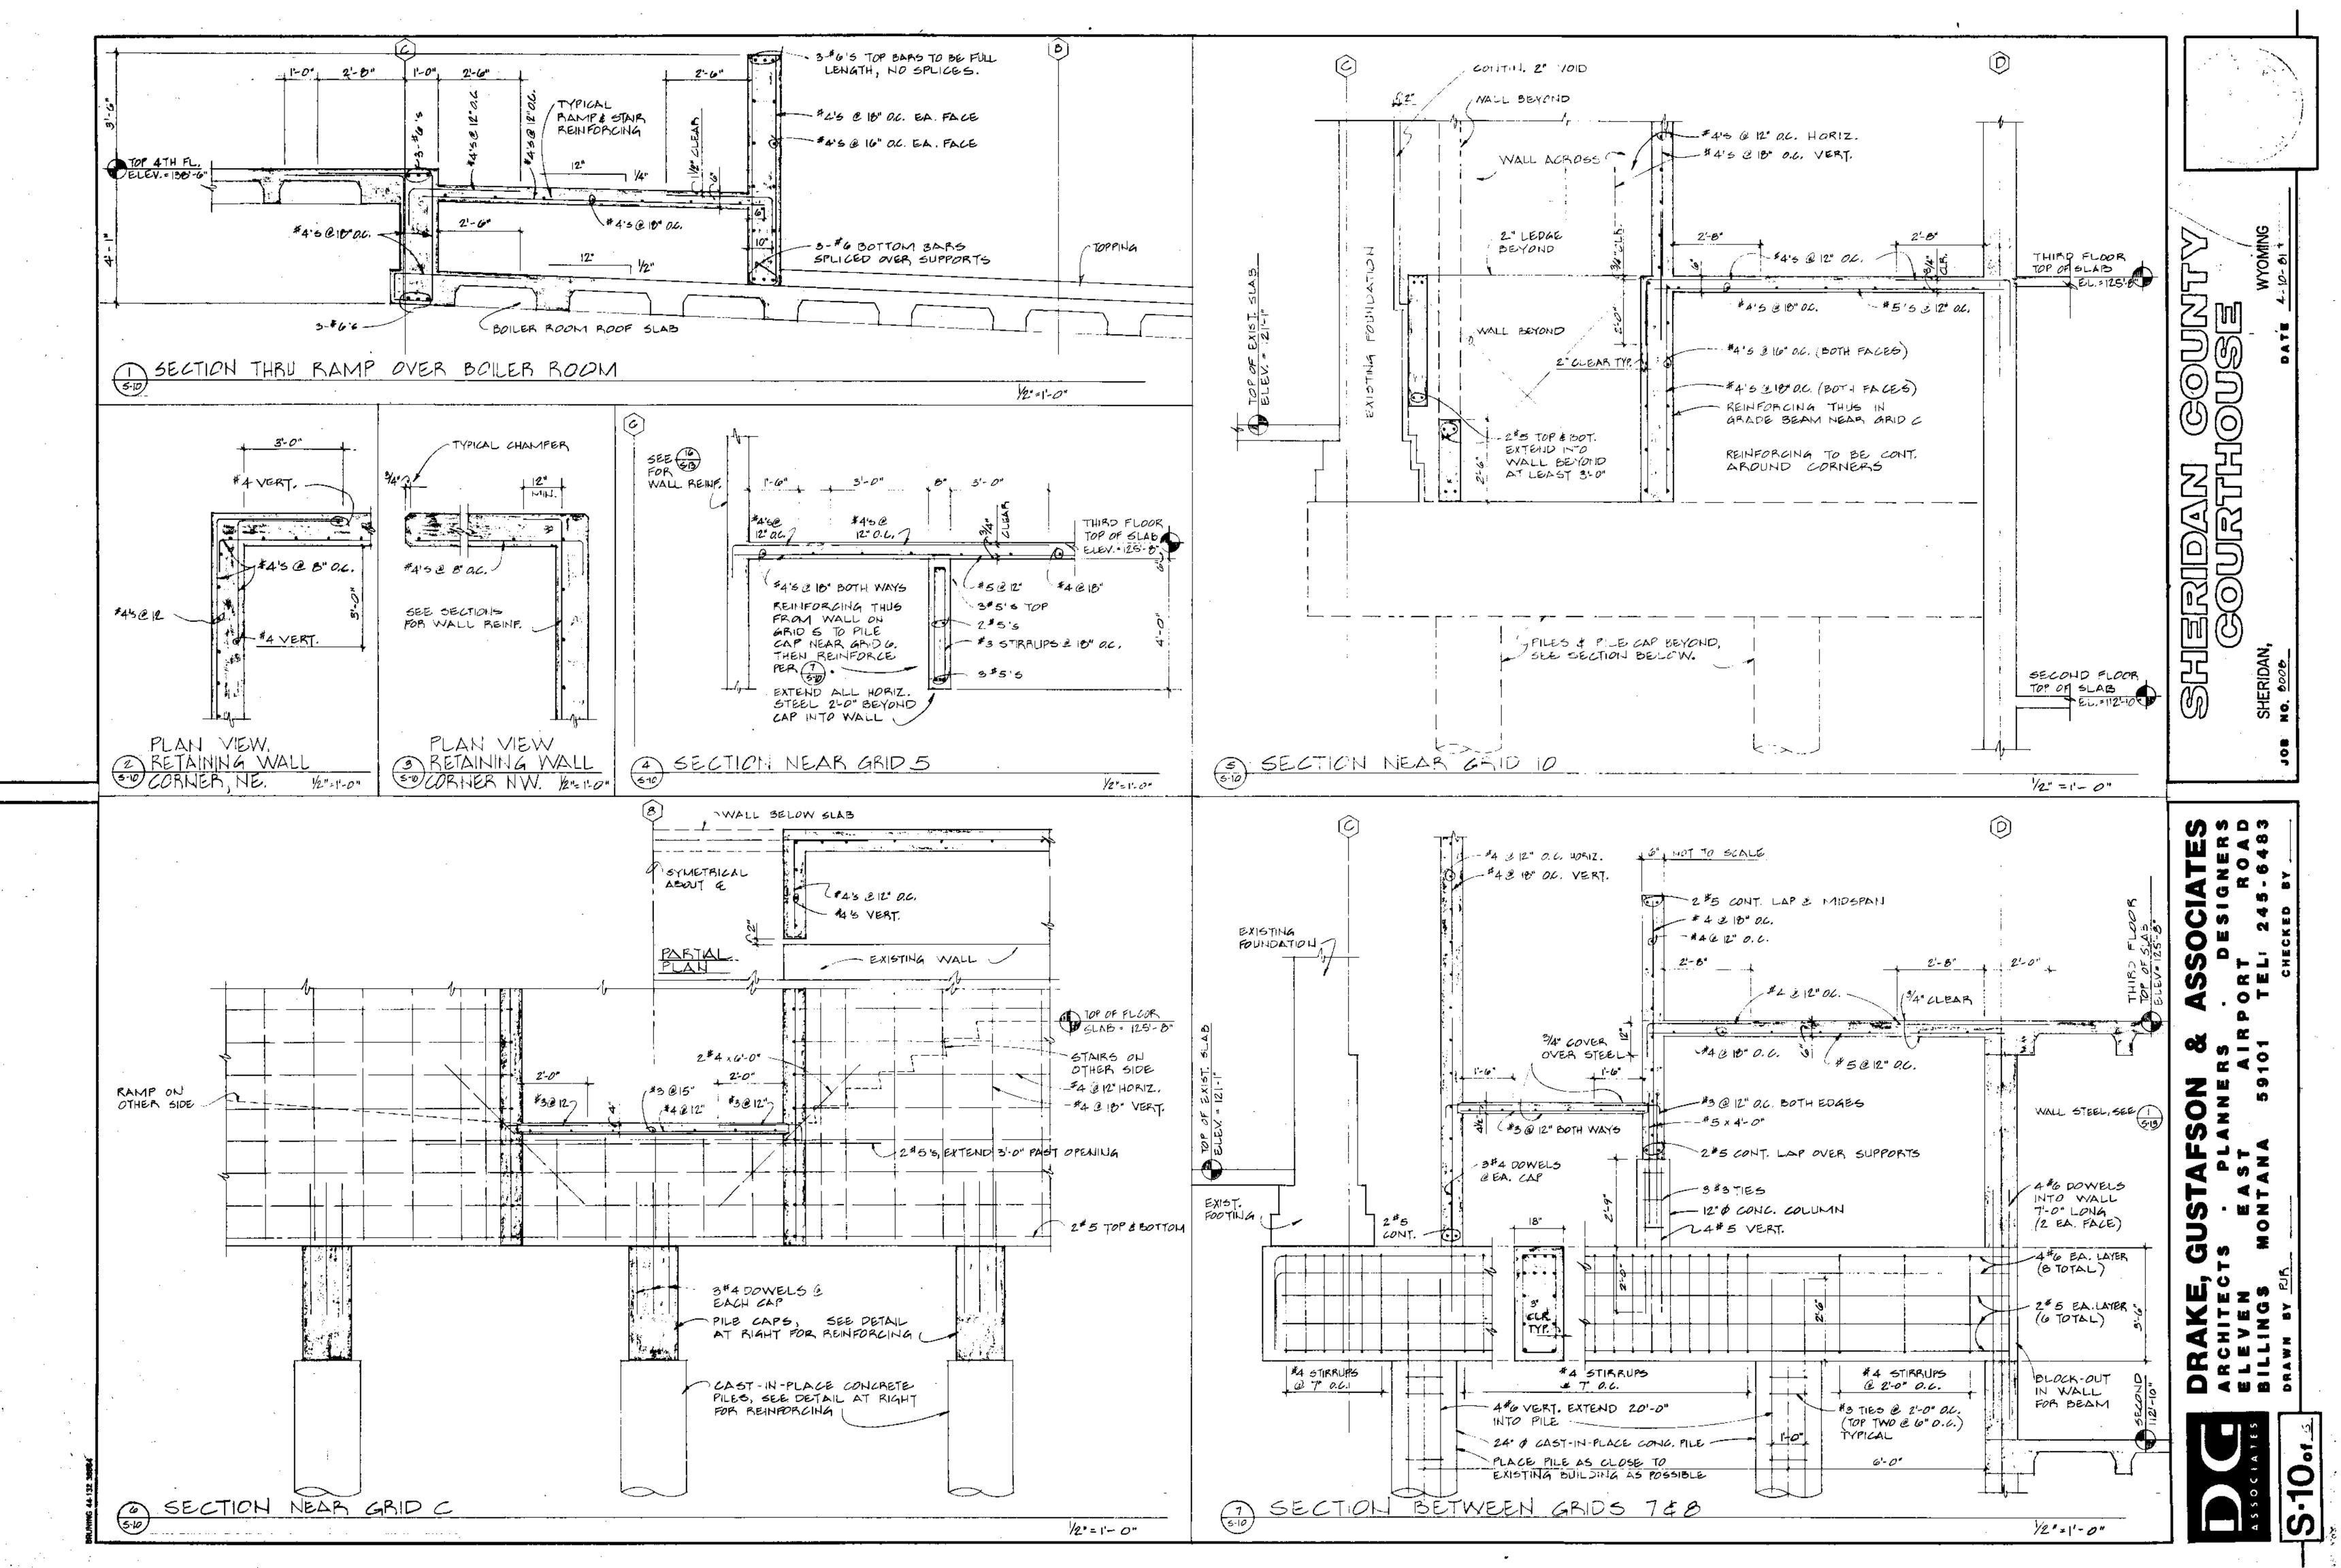

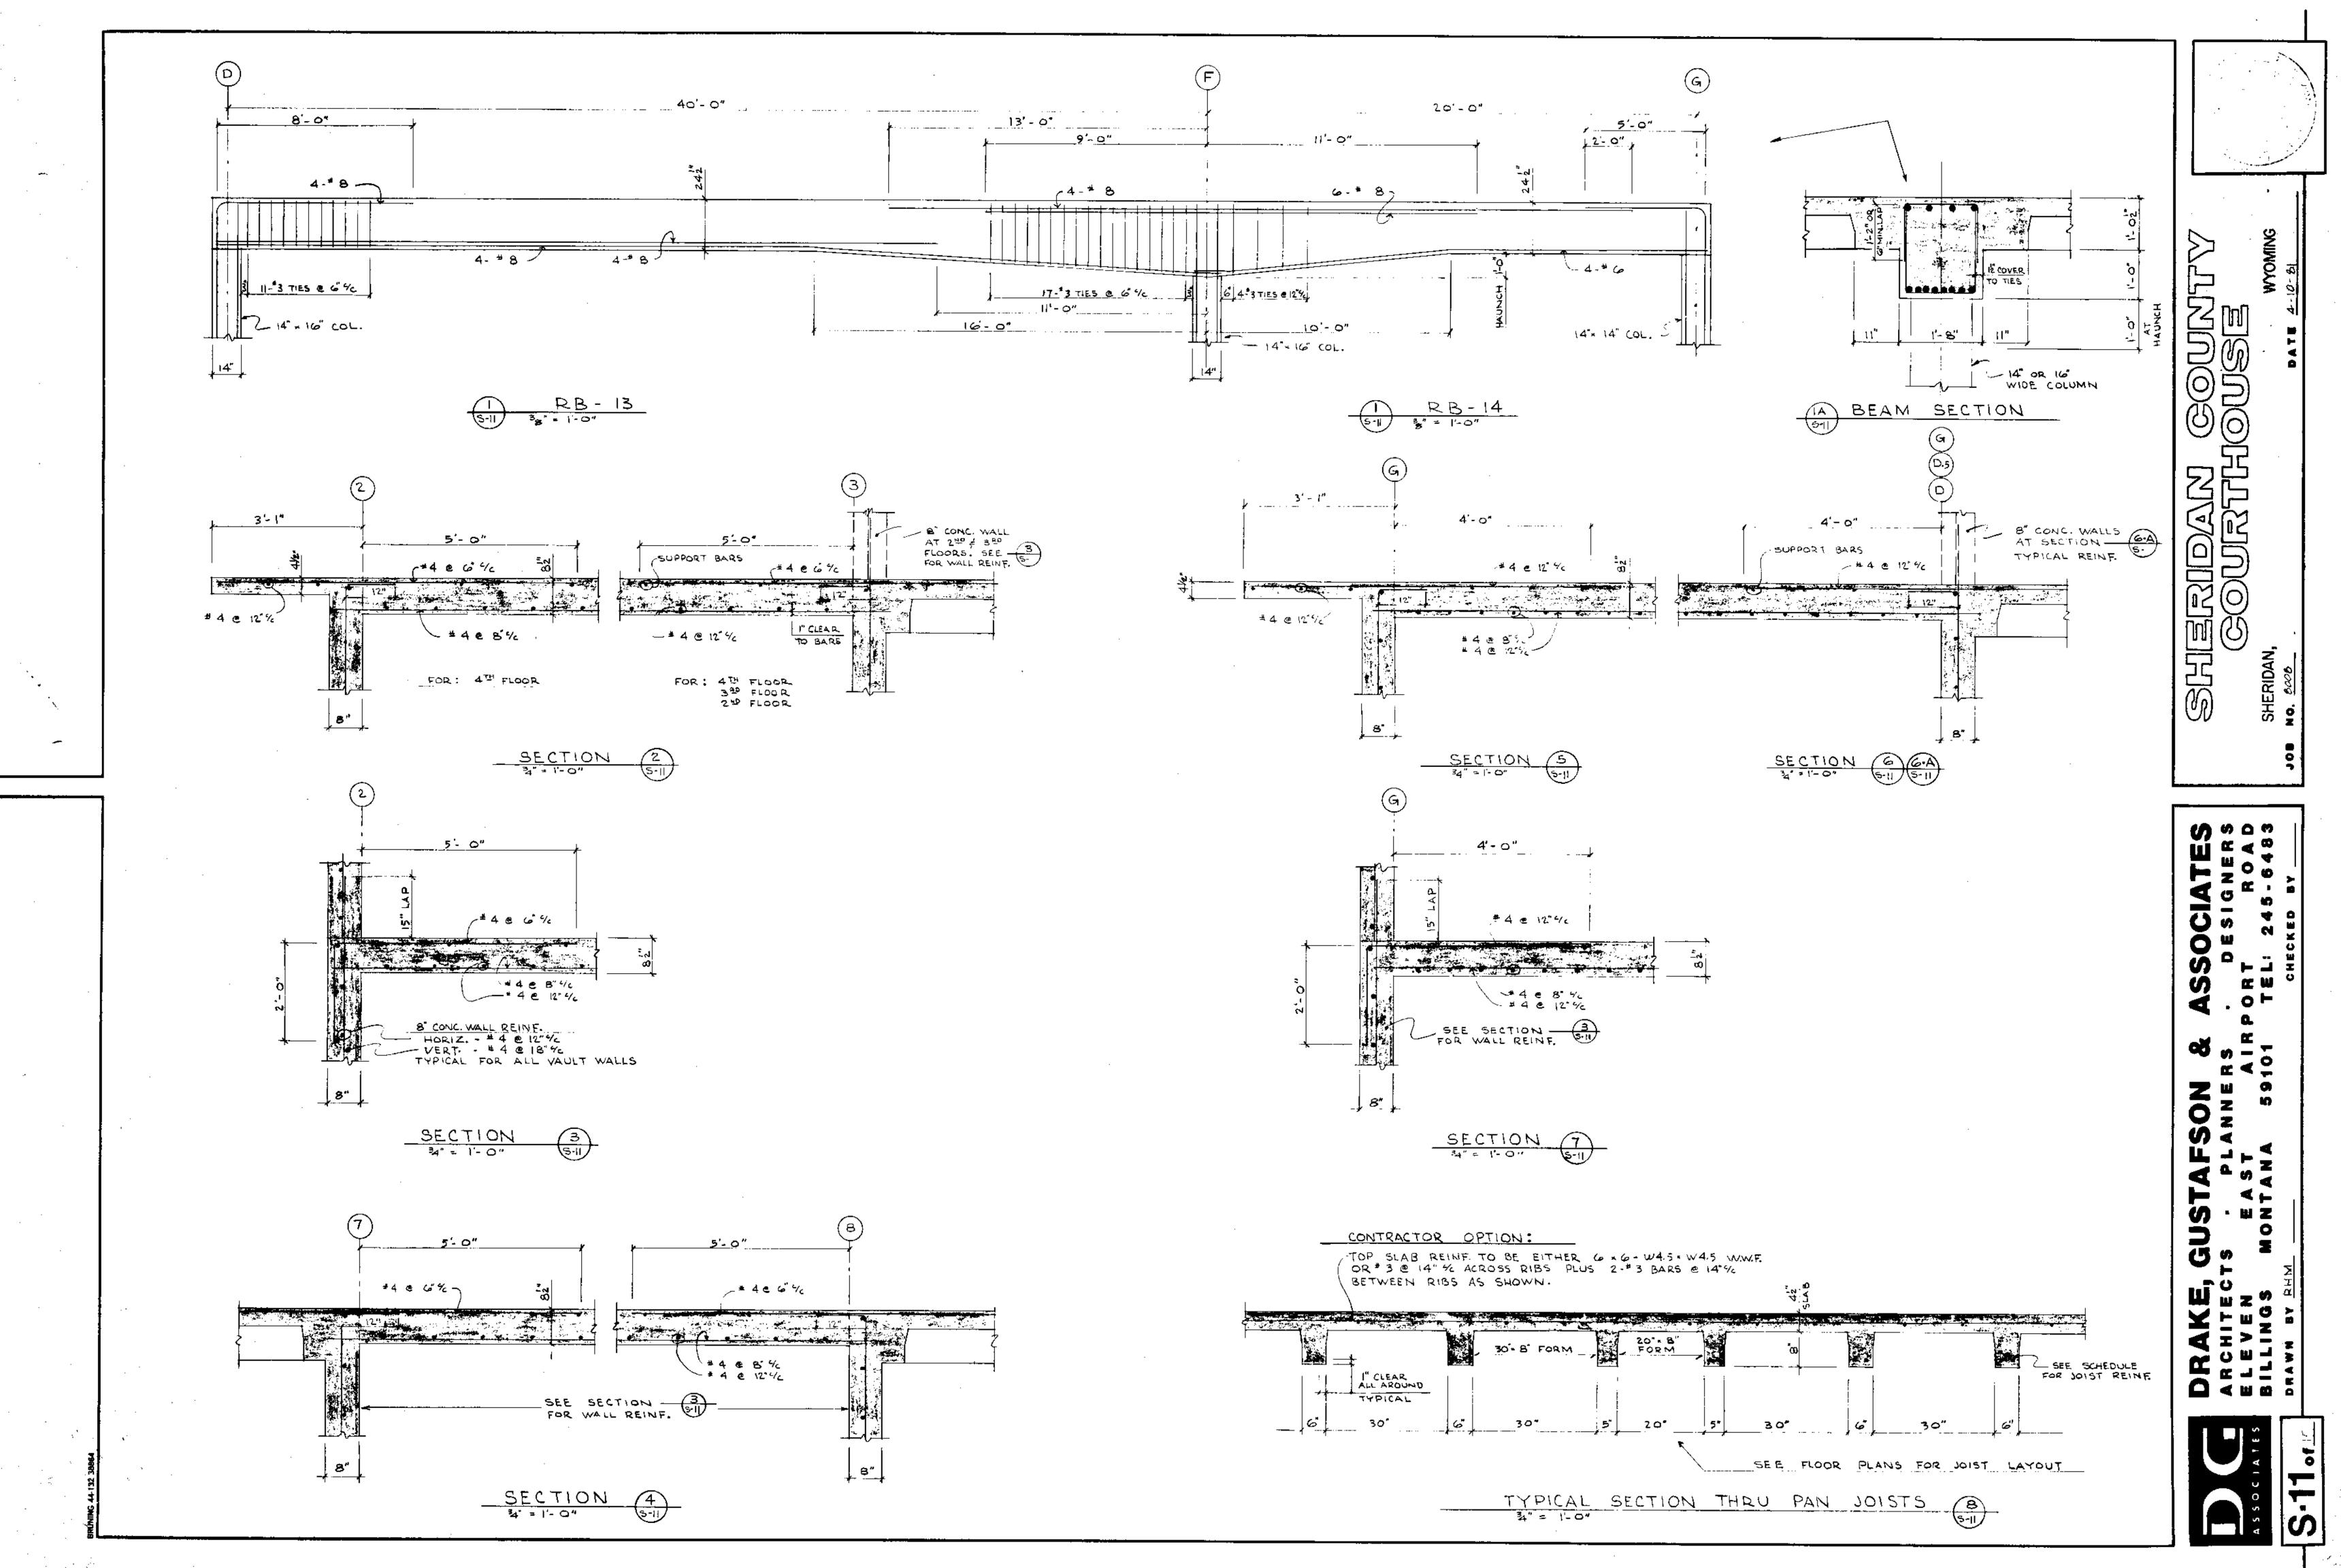


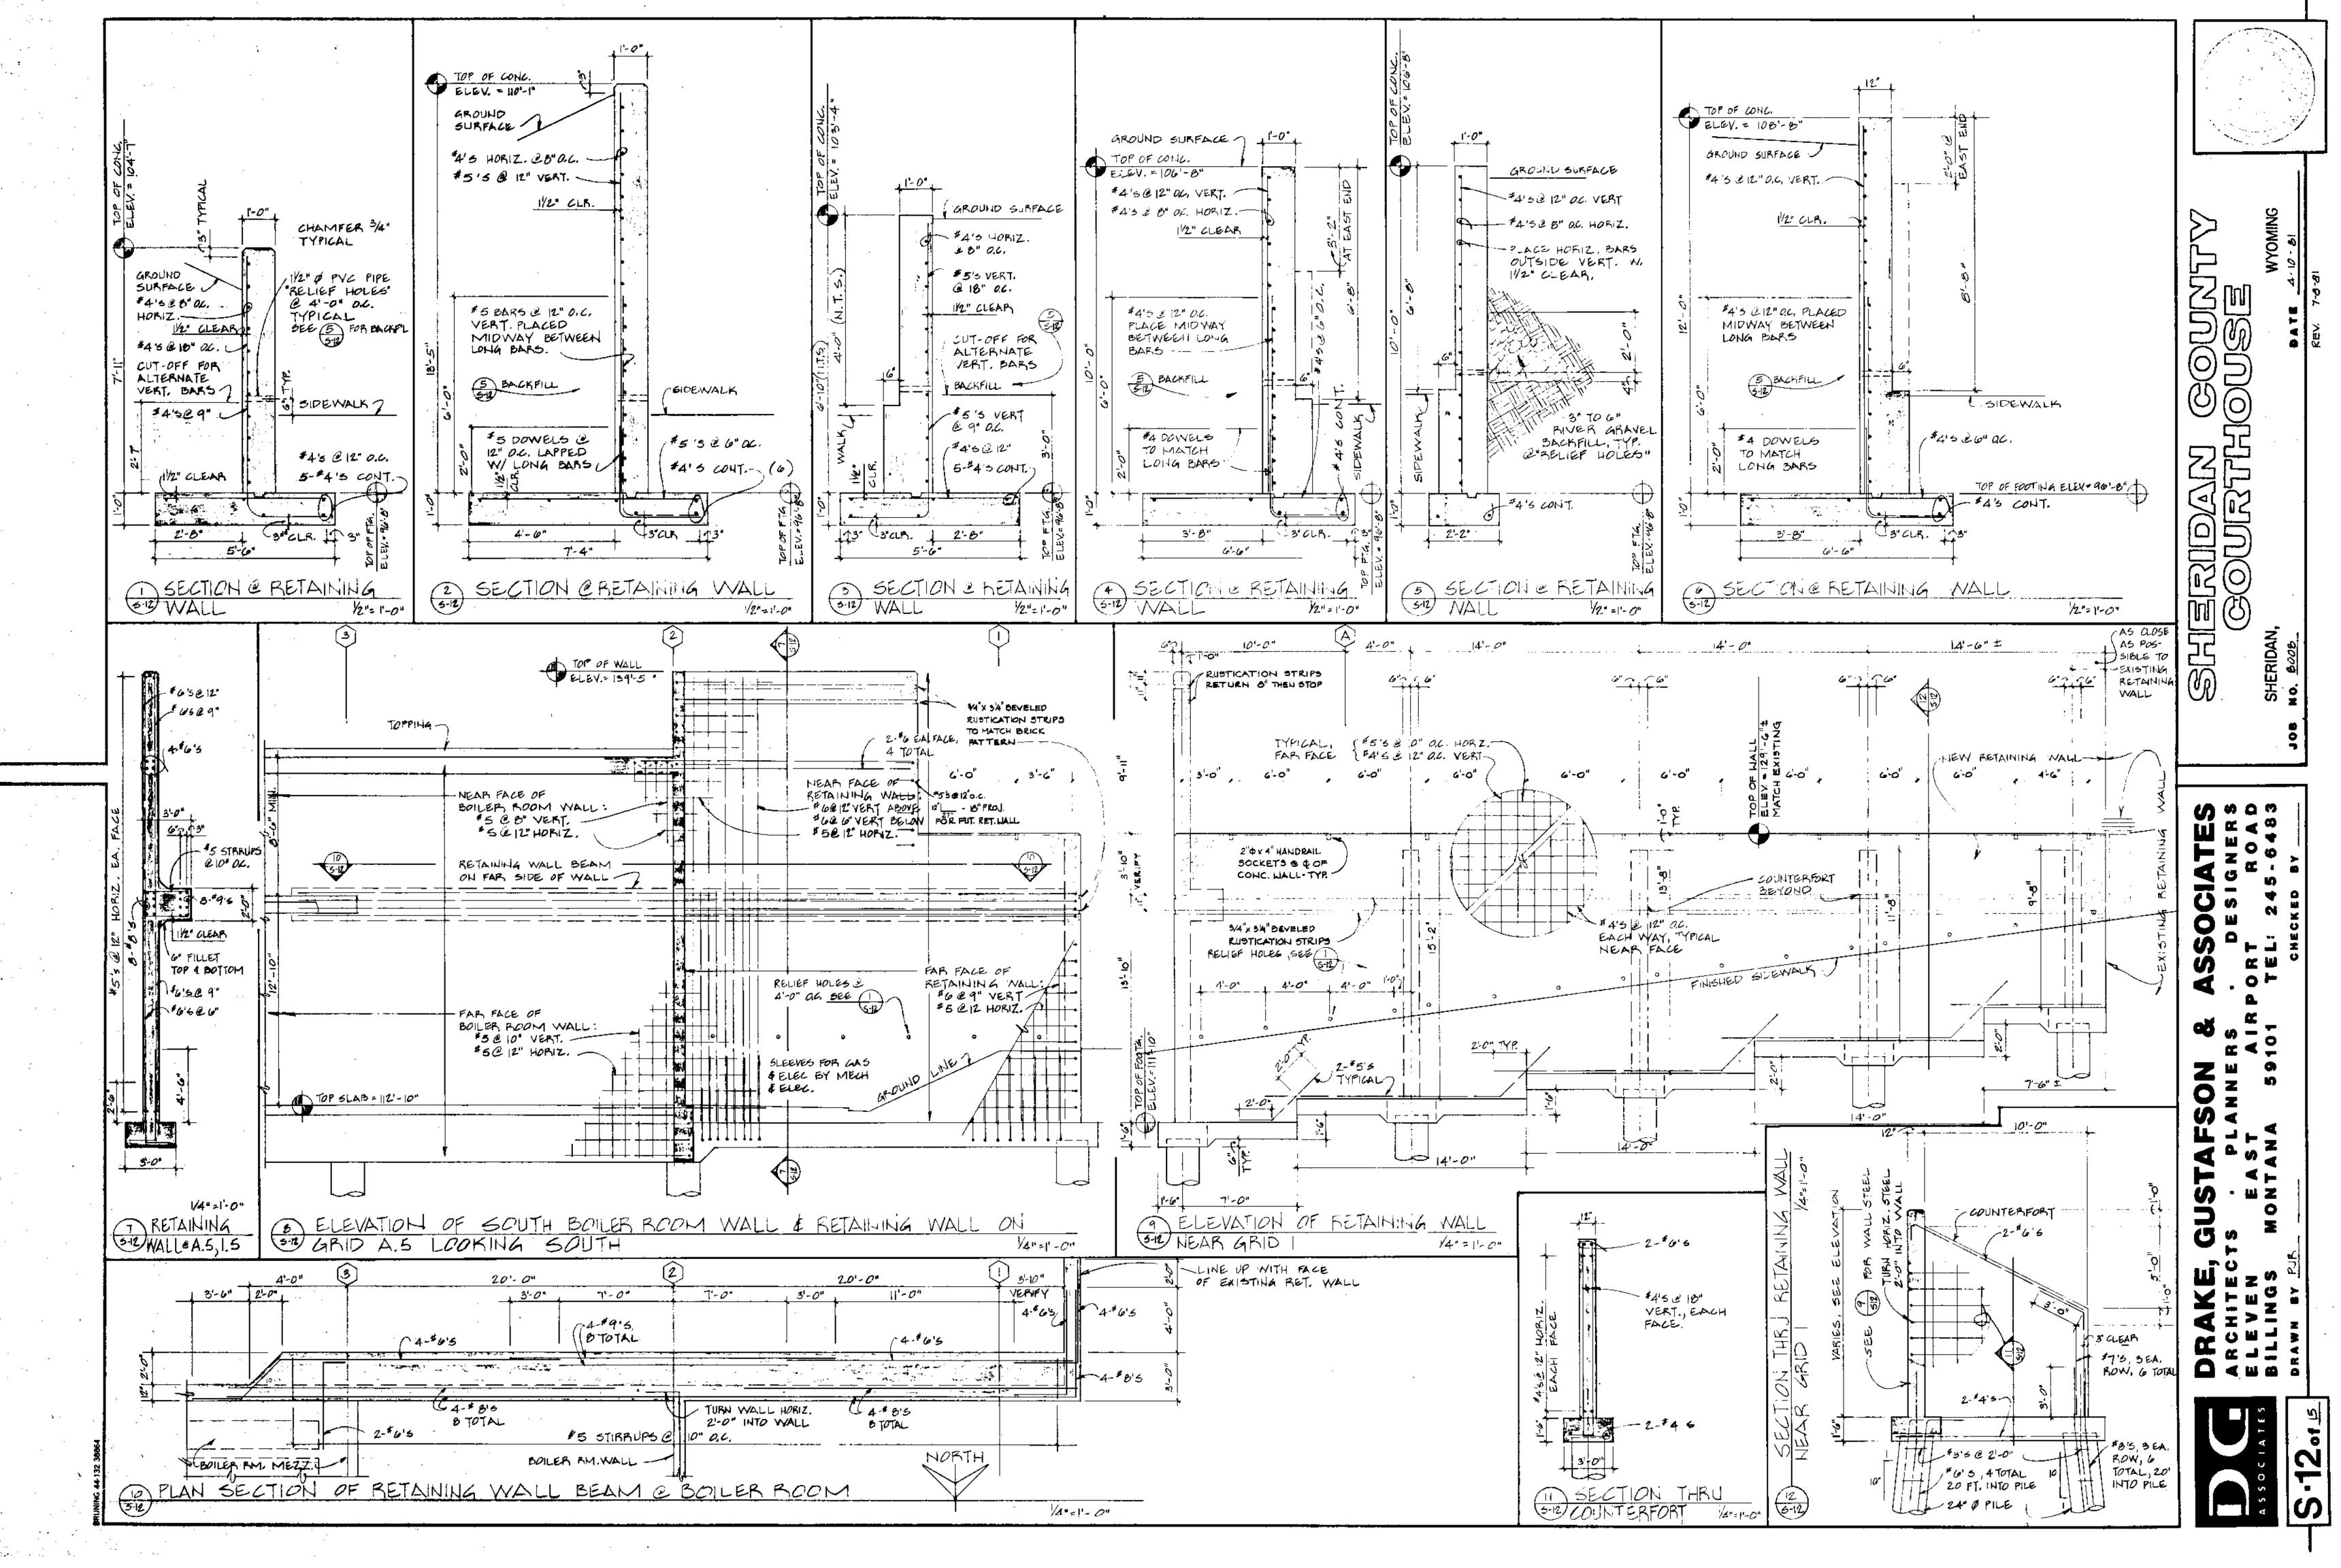


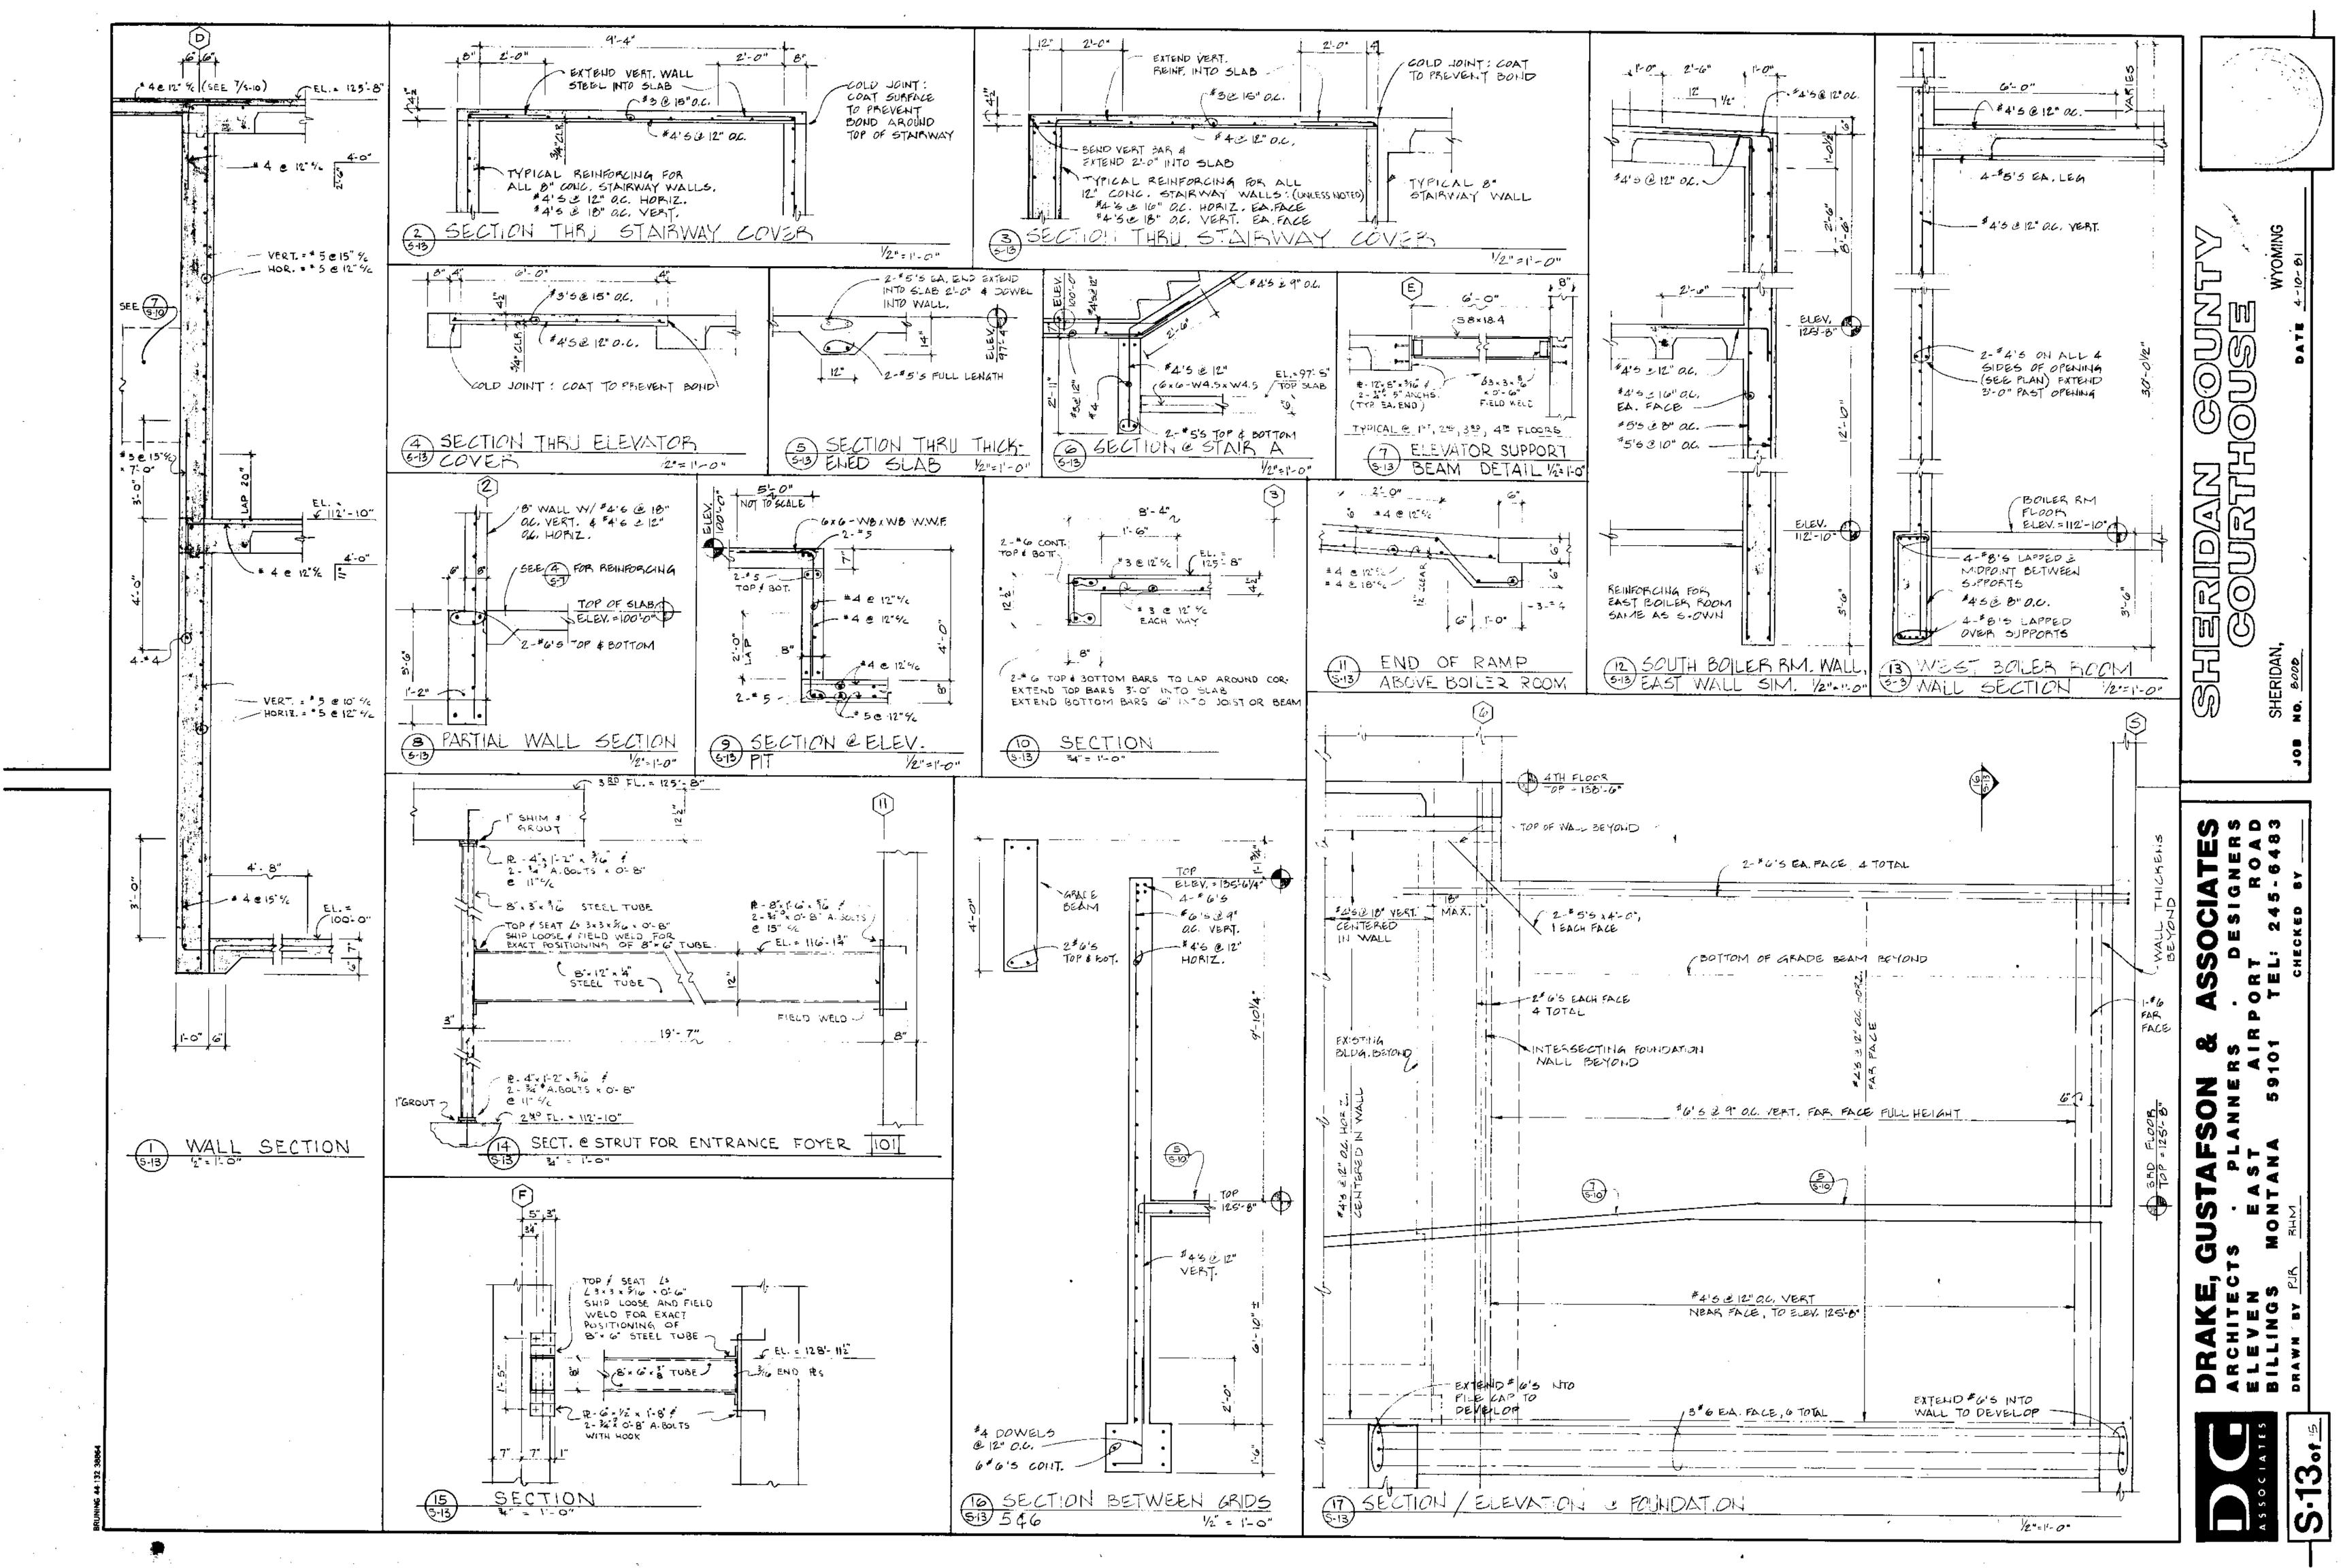

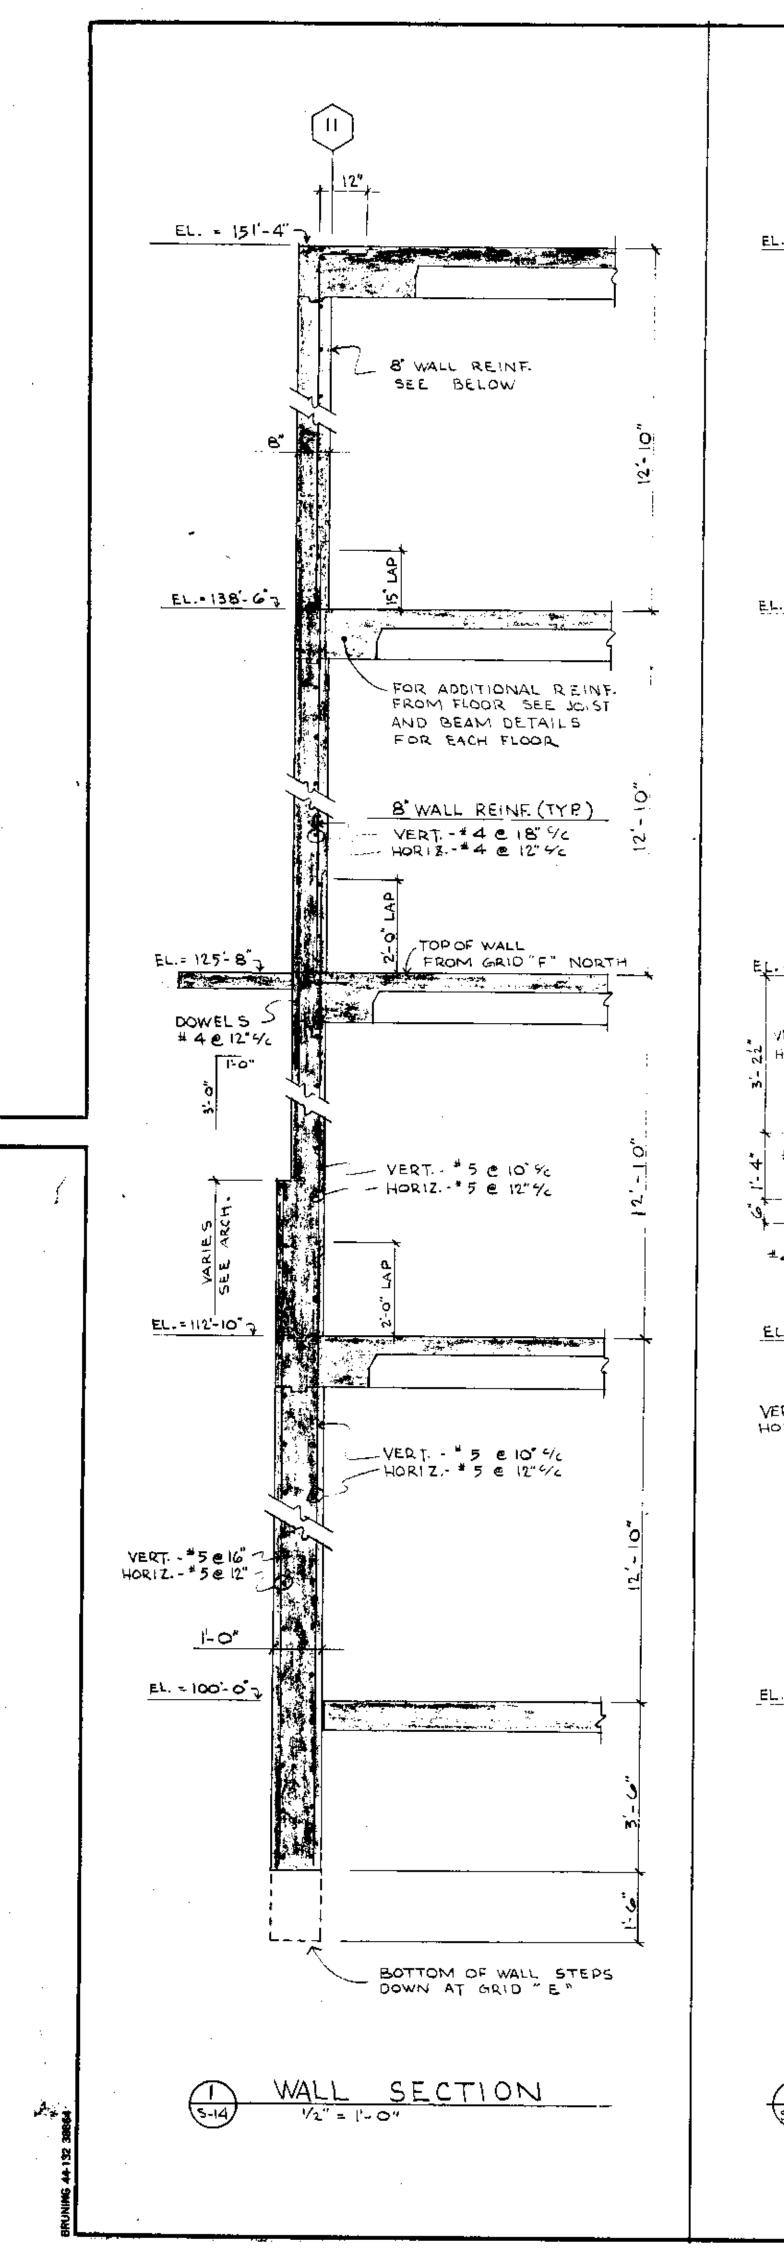

-:

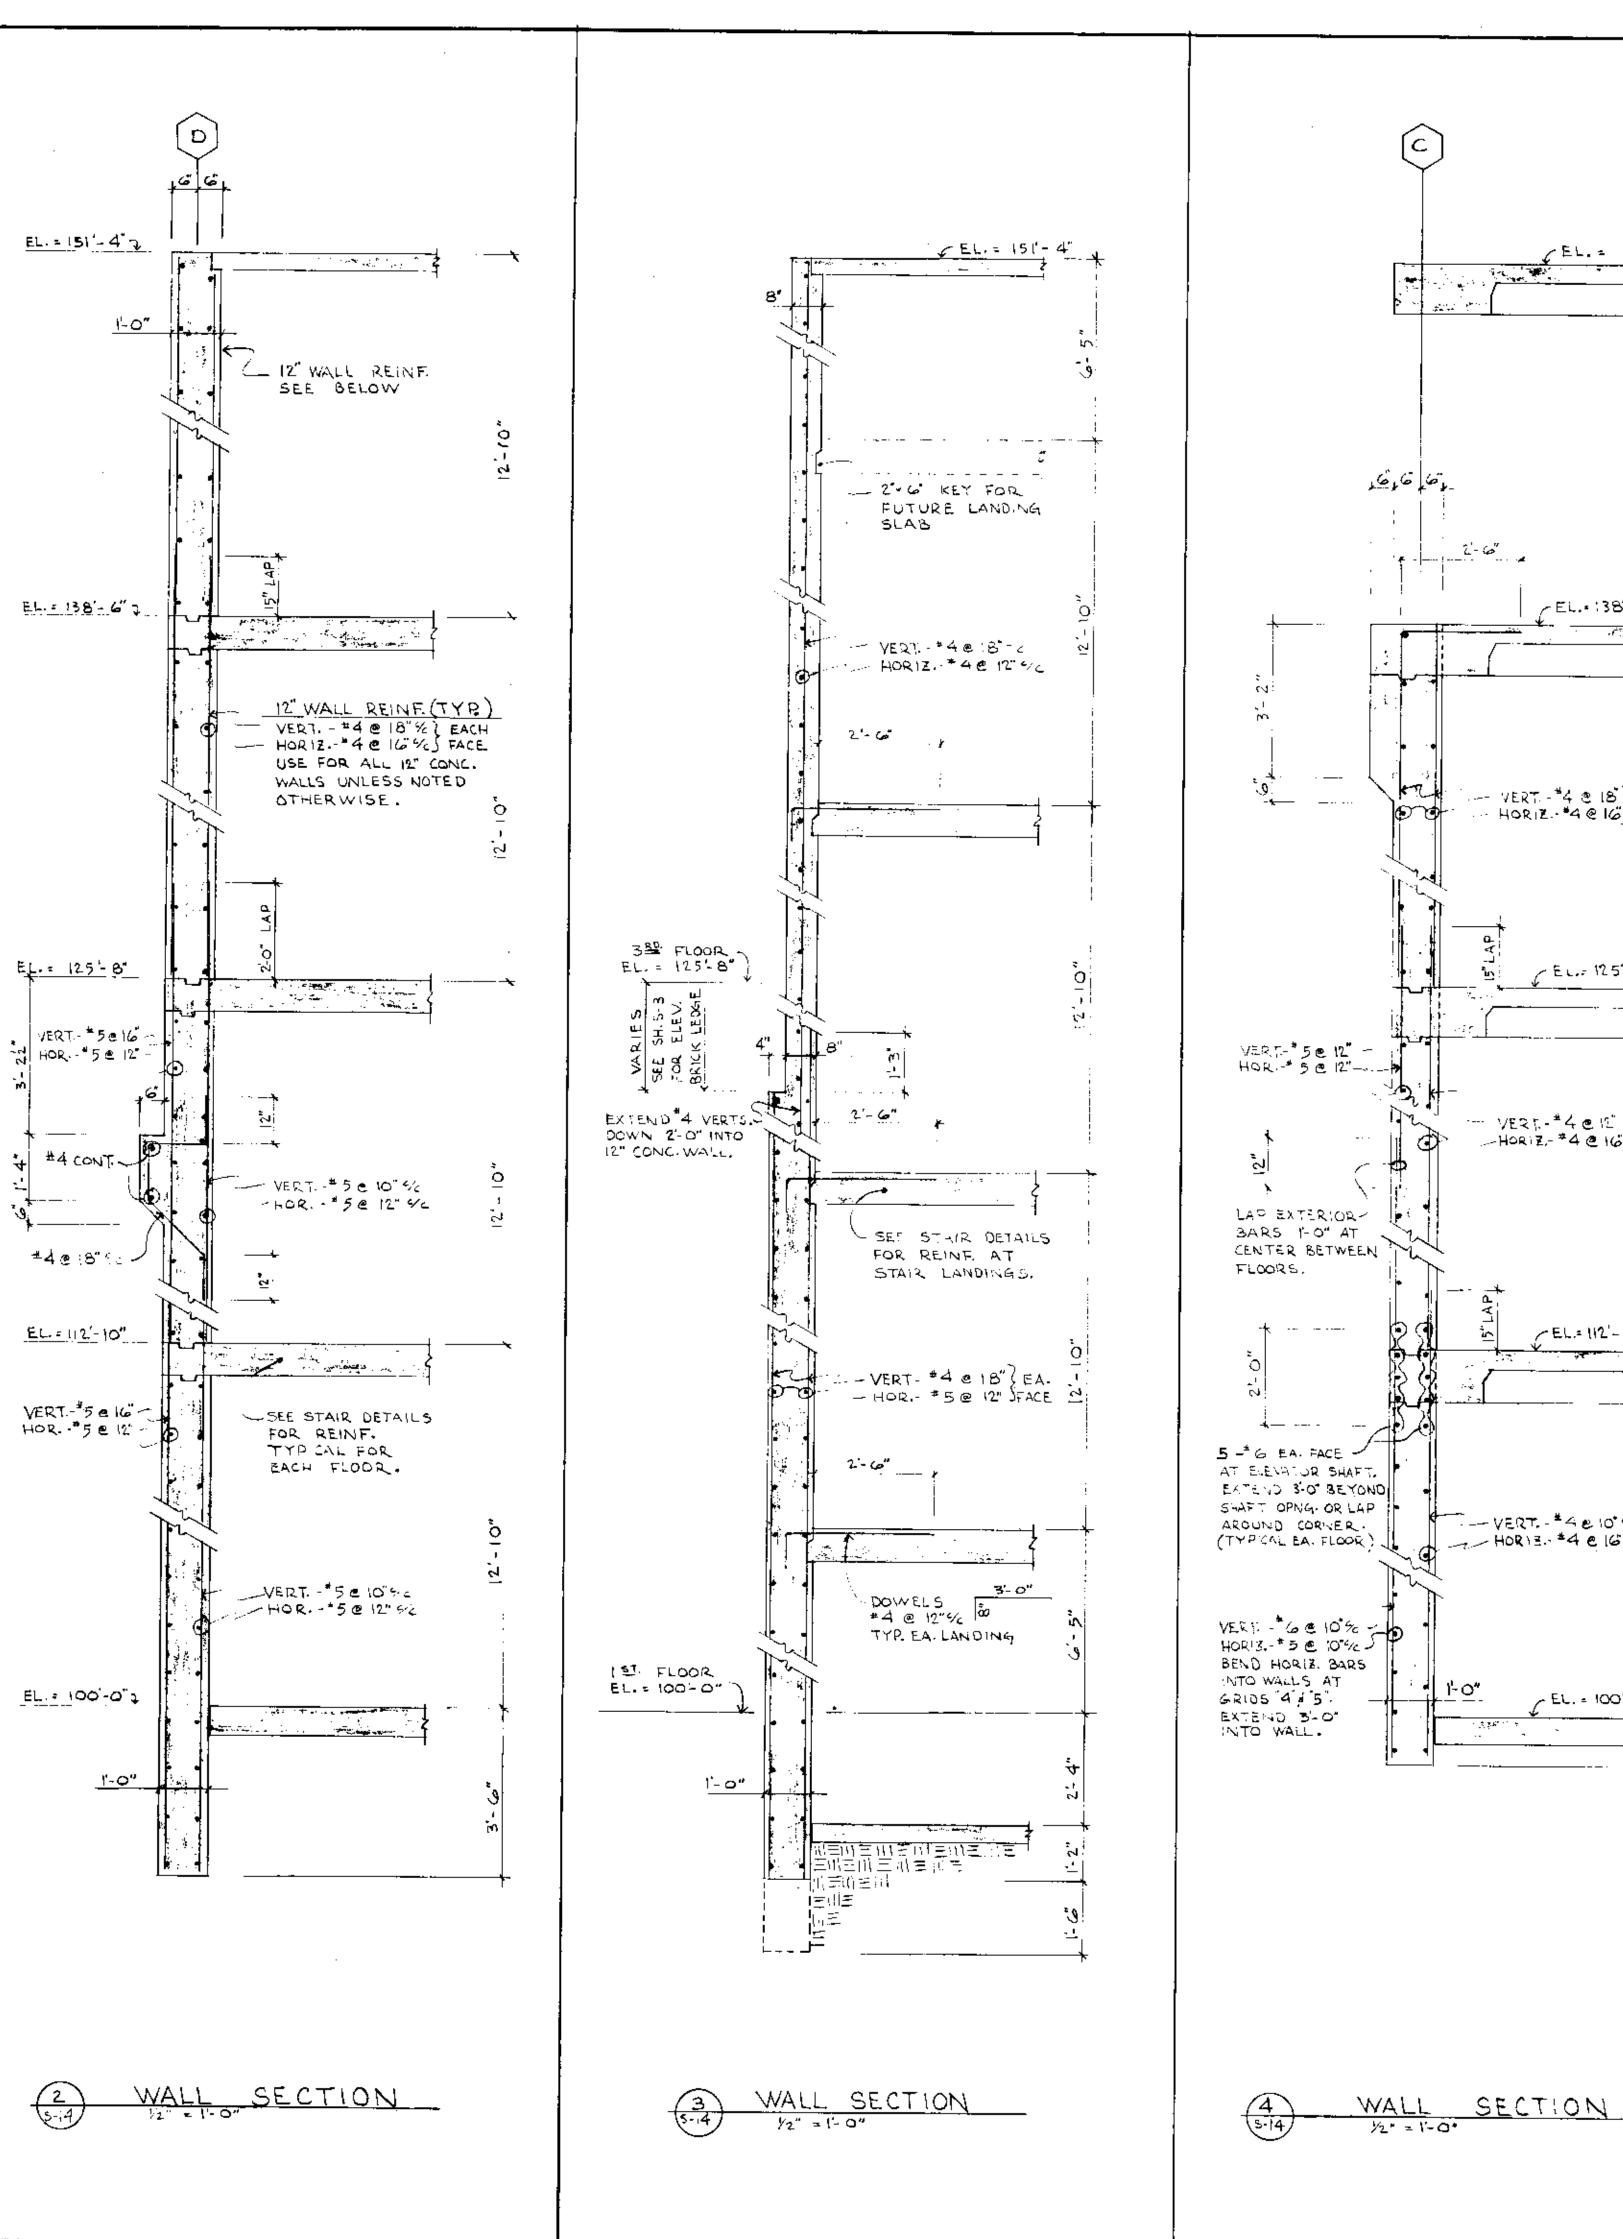


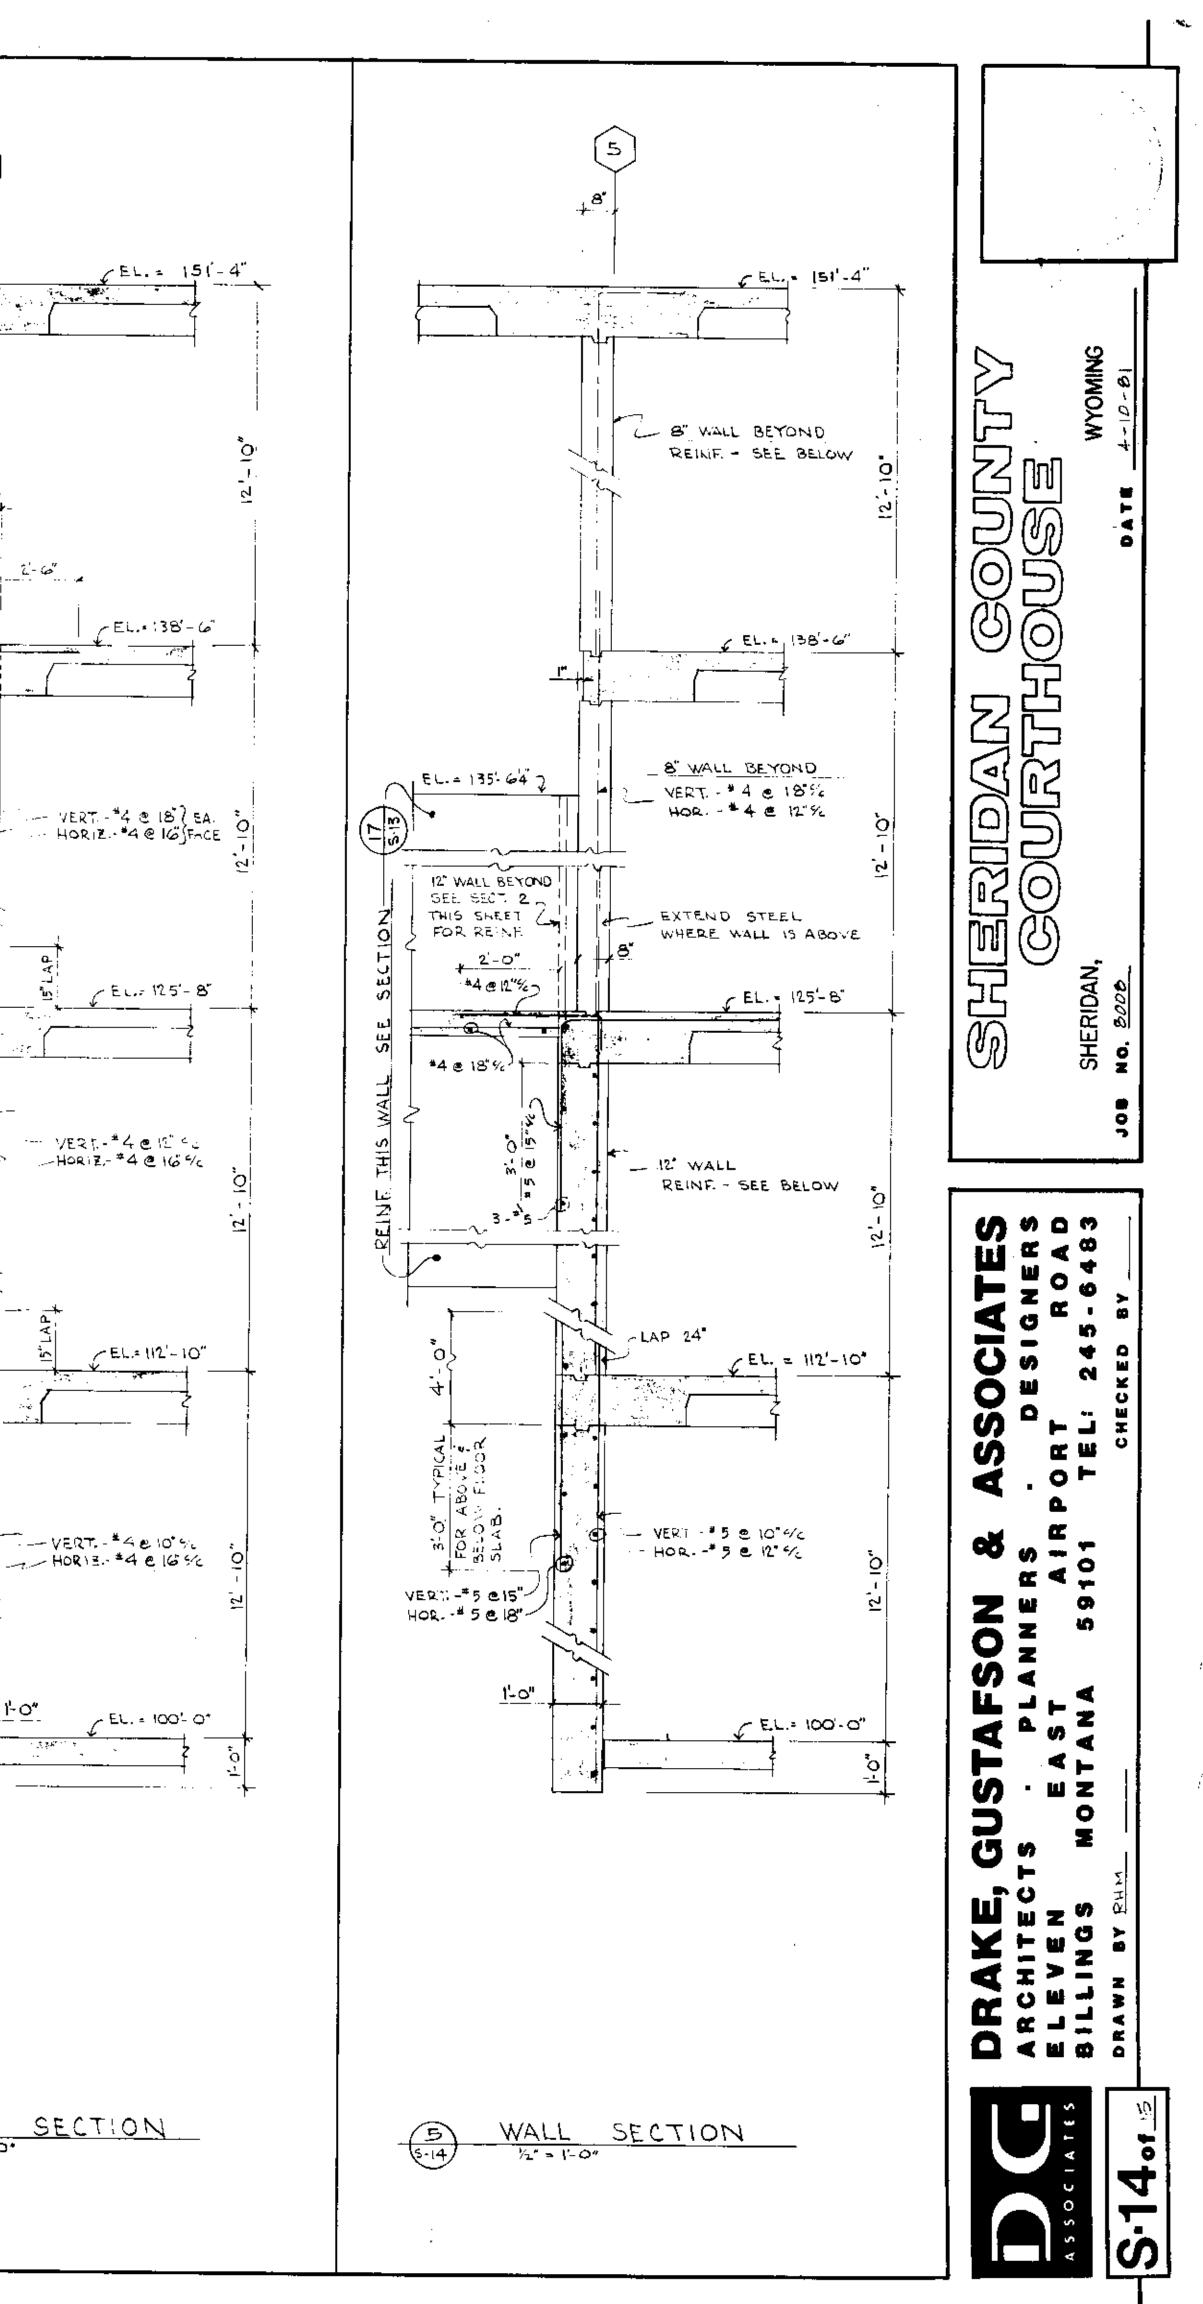


2-6


<u>1-0"</u>


 $X \in \mathbb{C}$

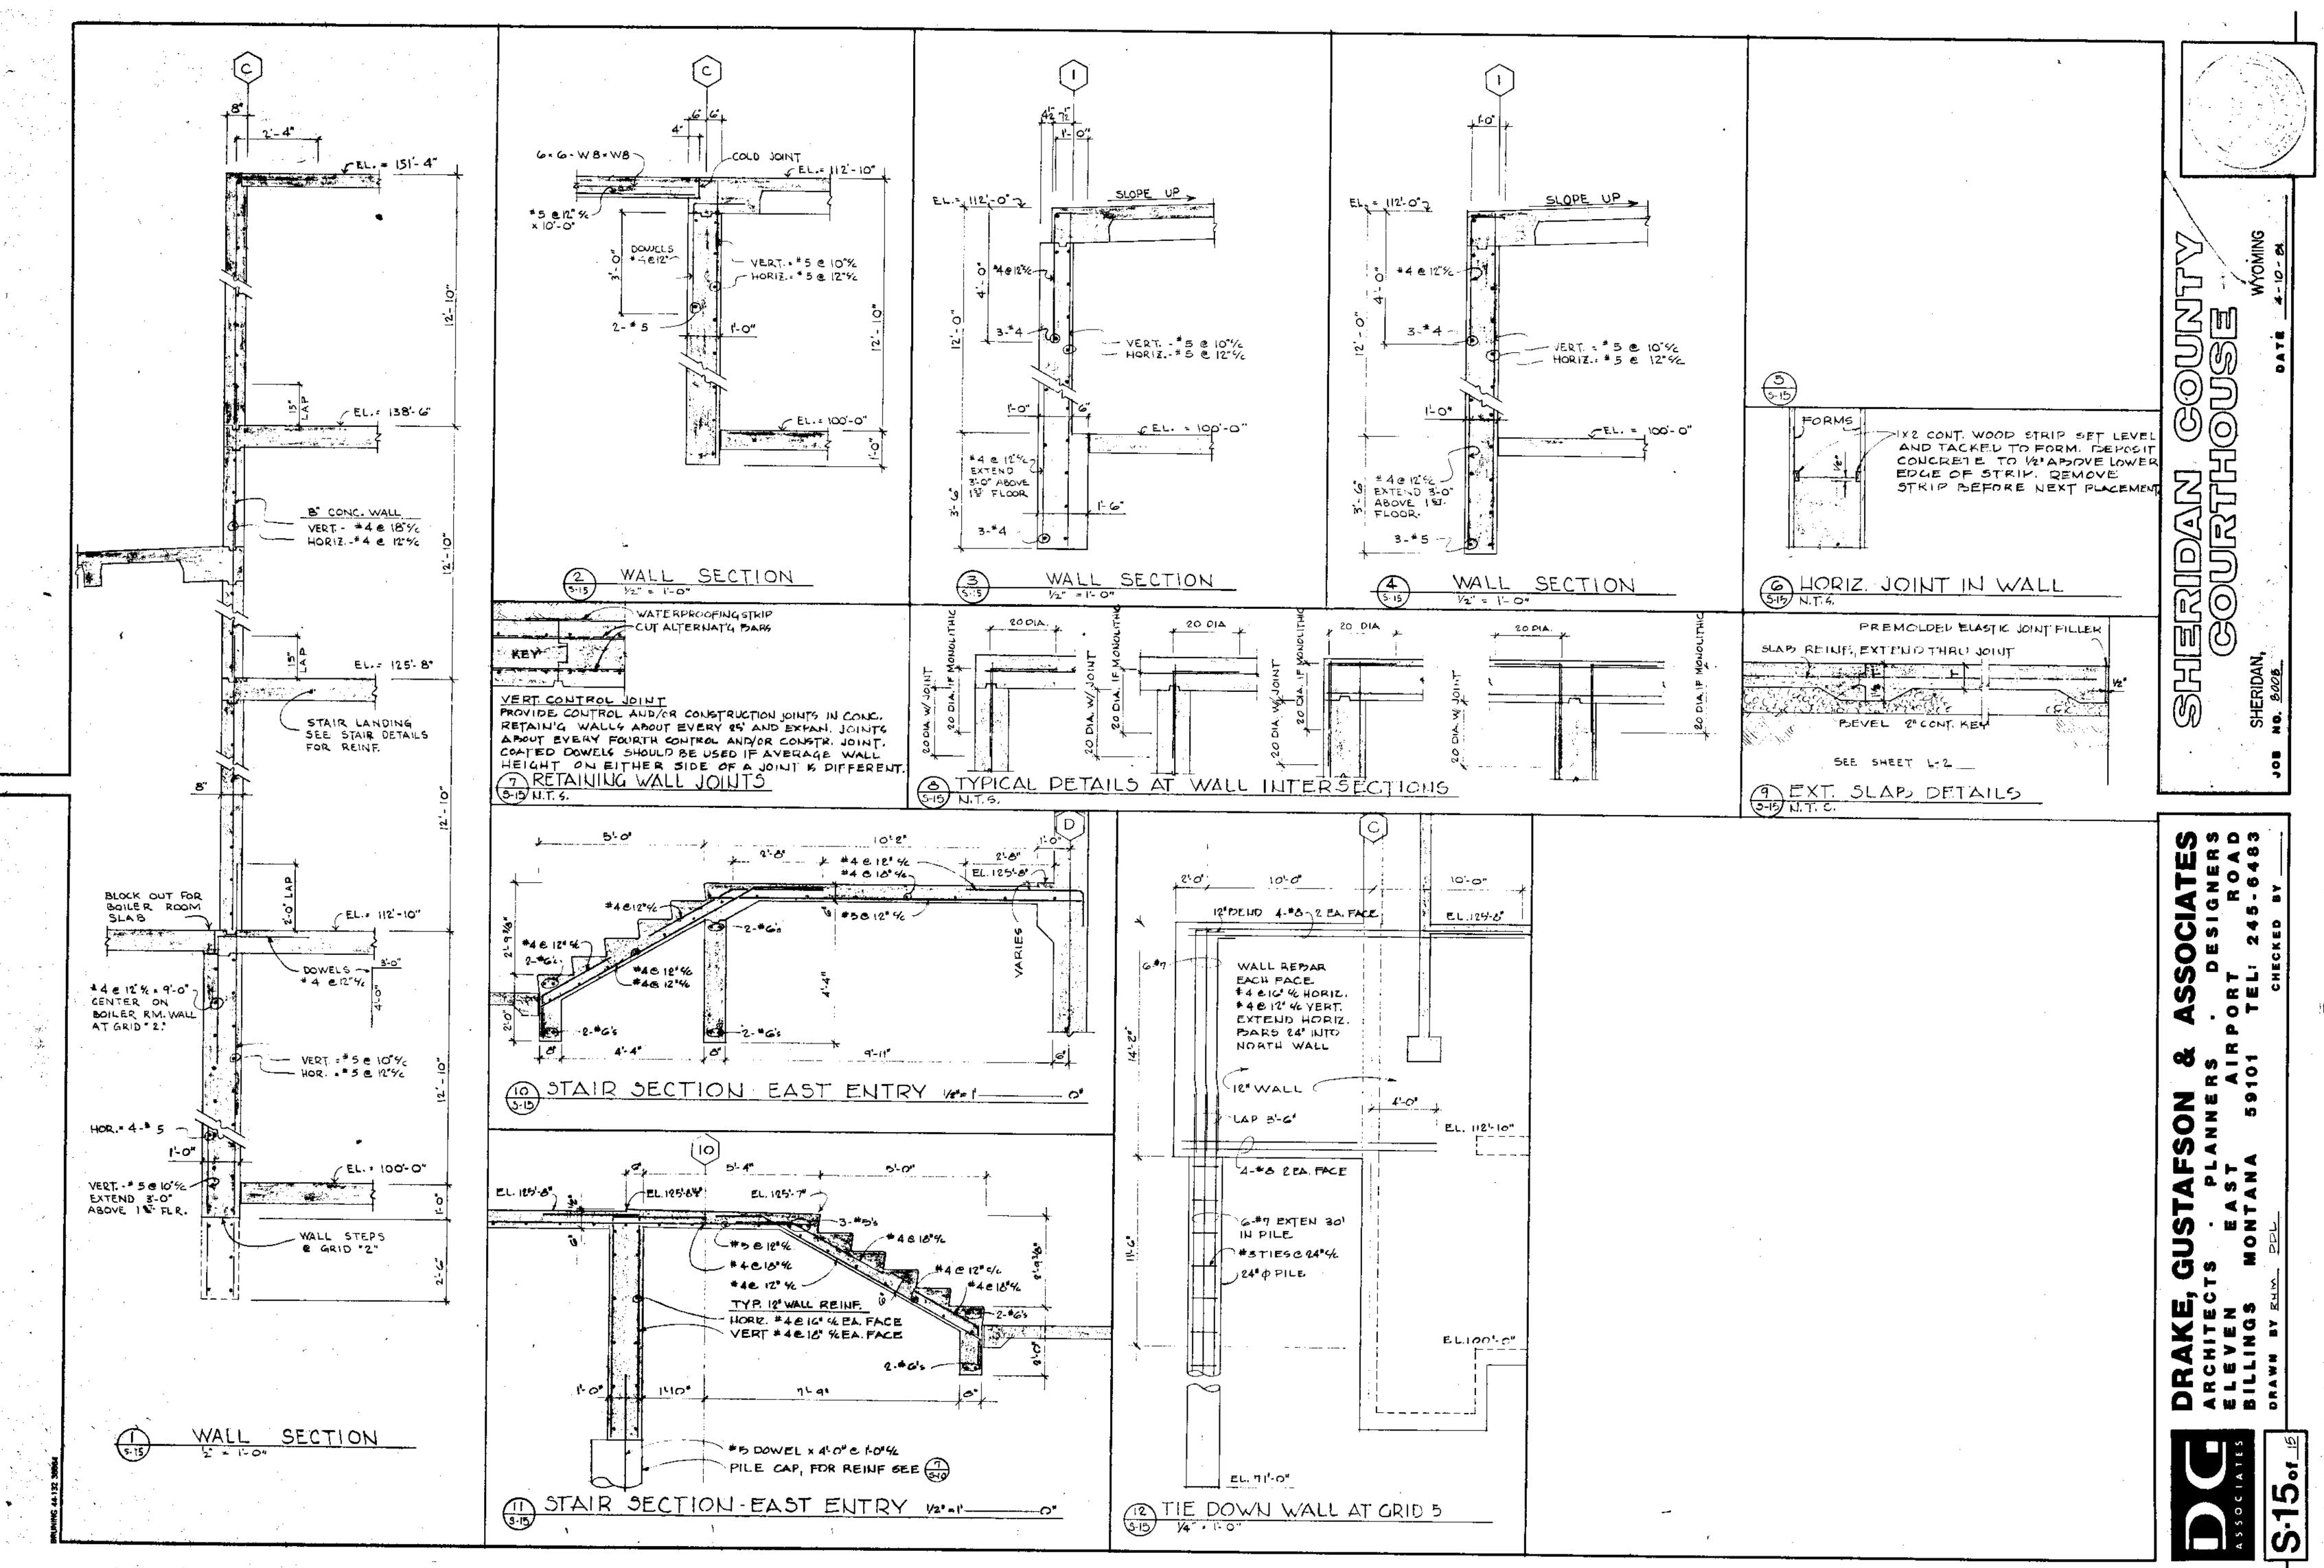


n an an Arrange ann a Arrange ann an Arrange

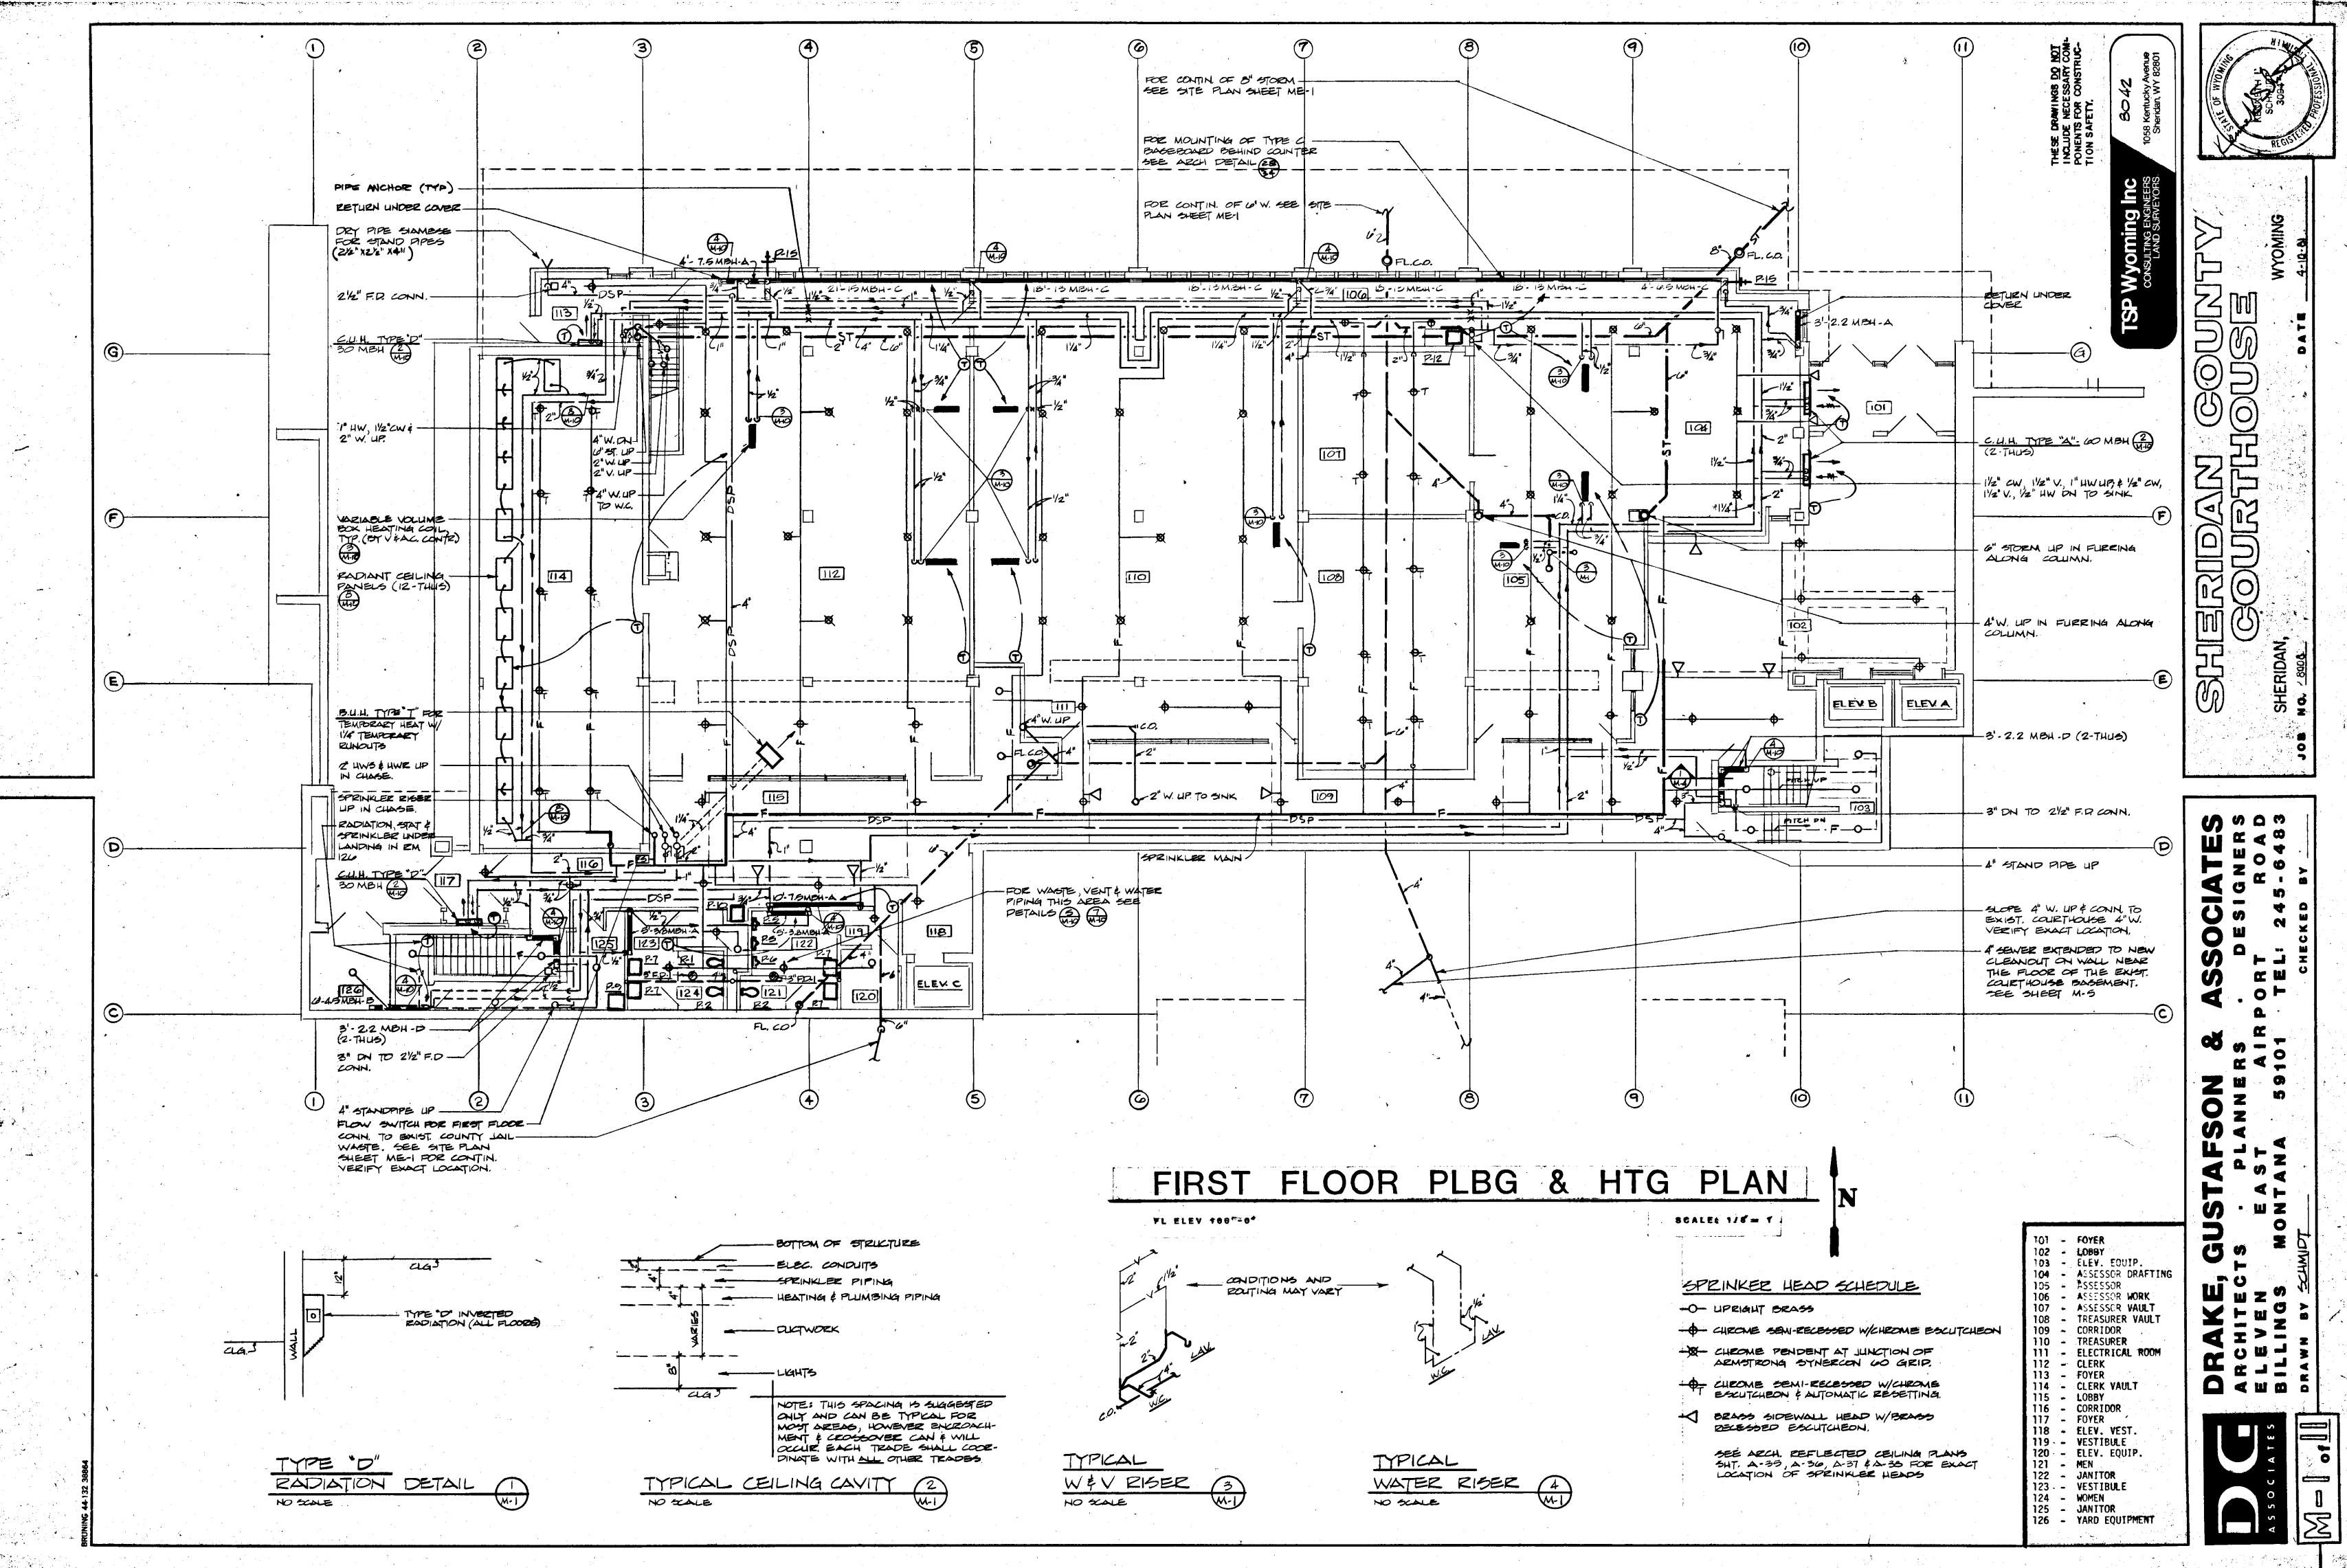


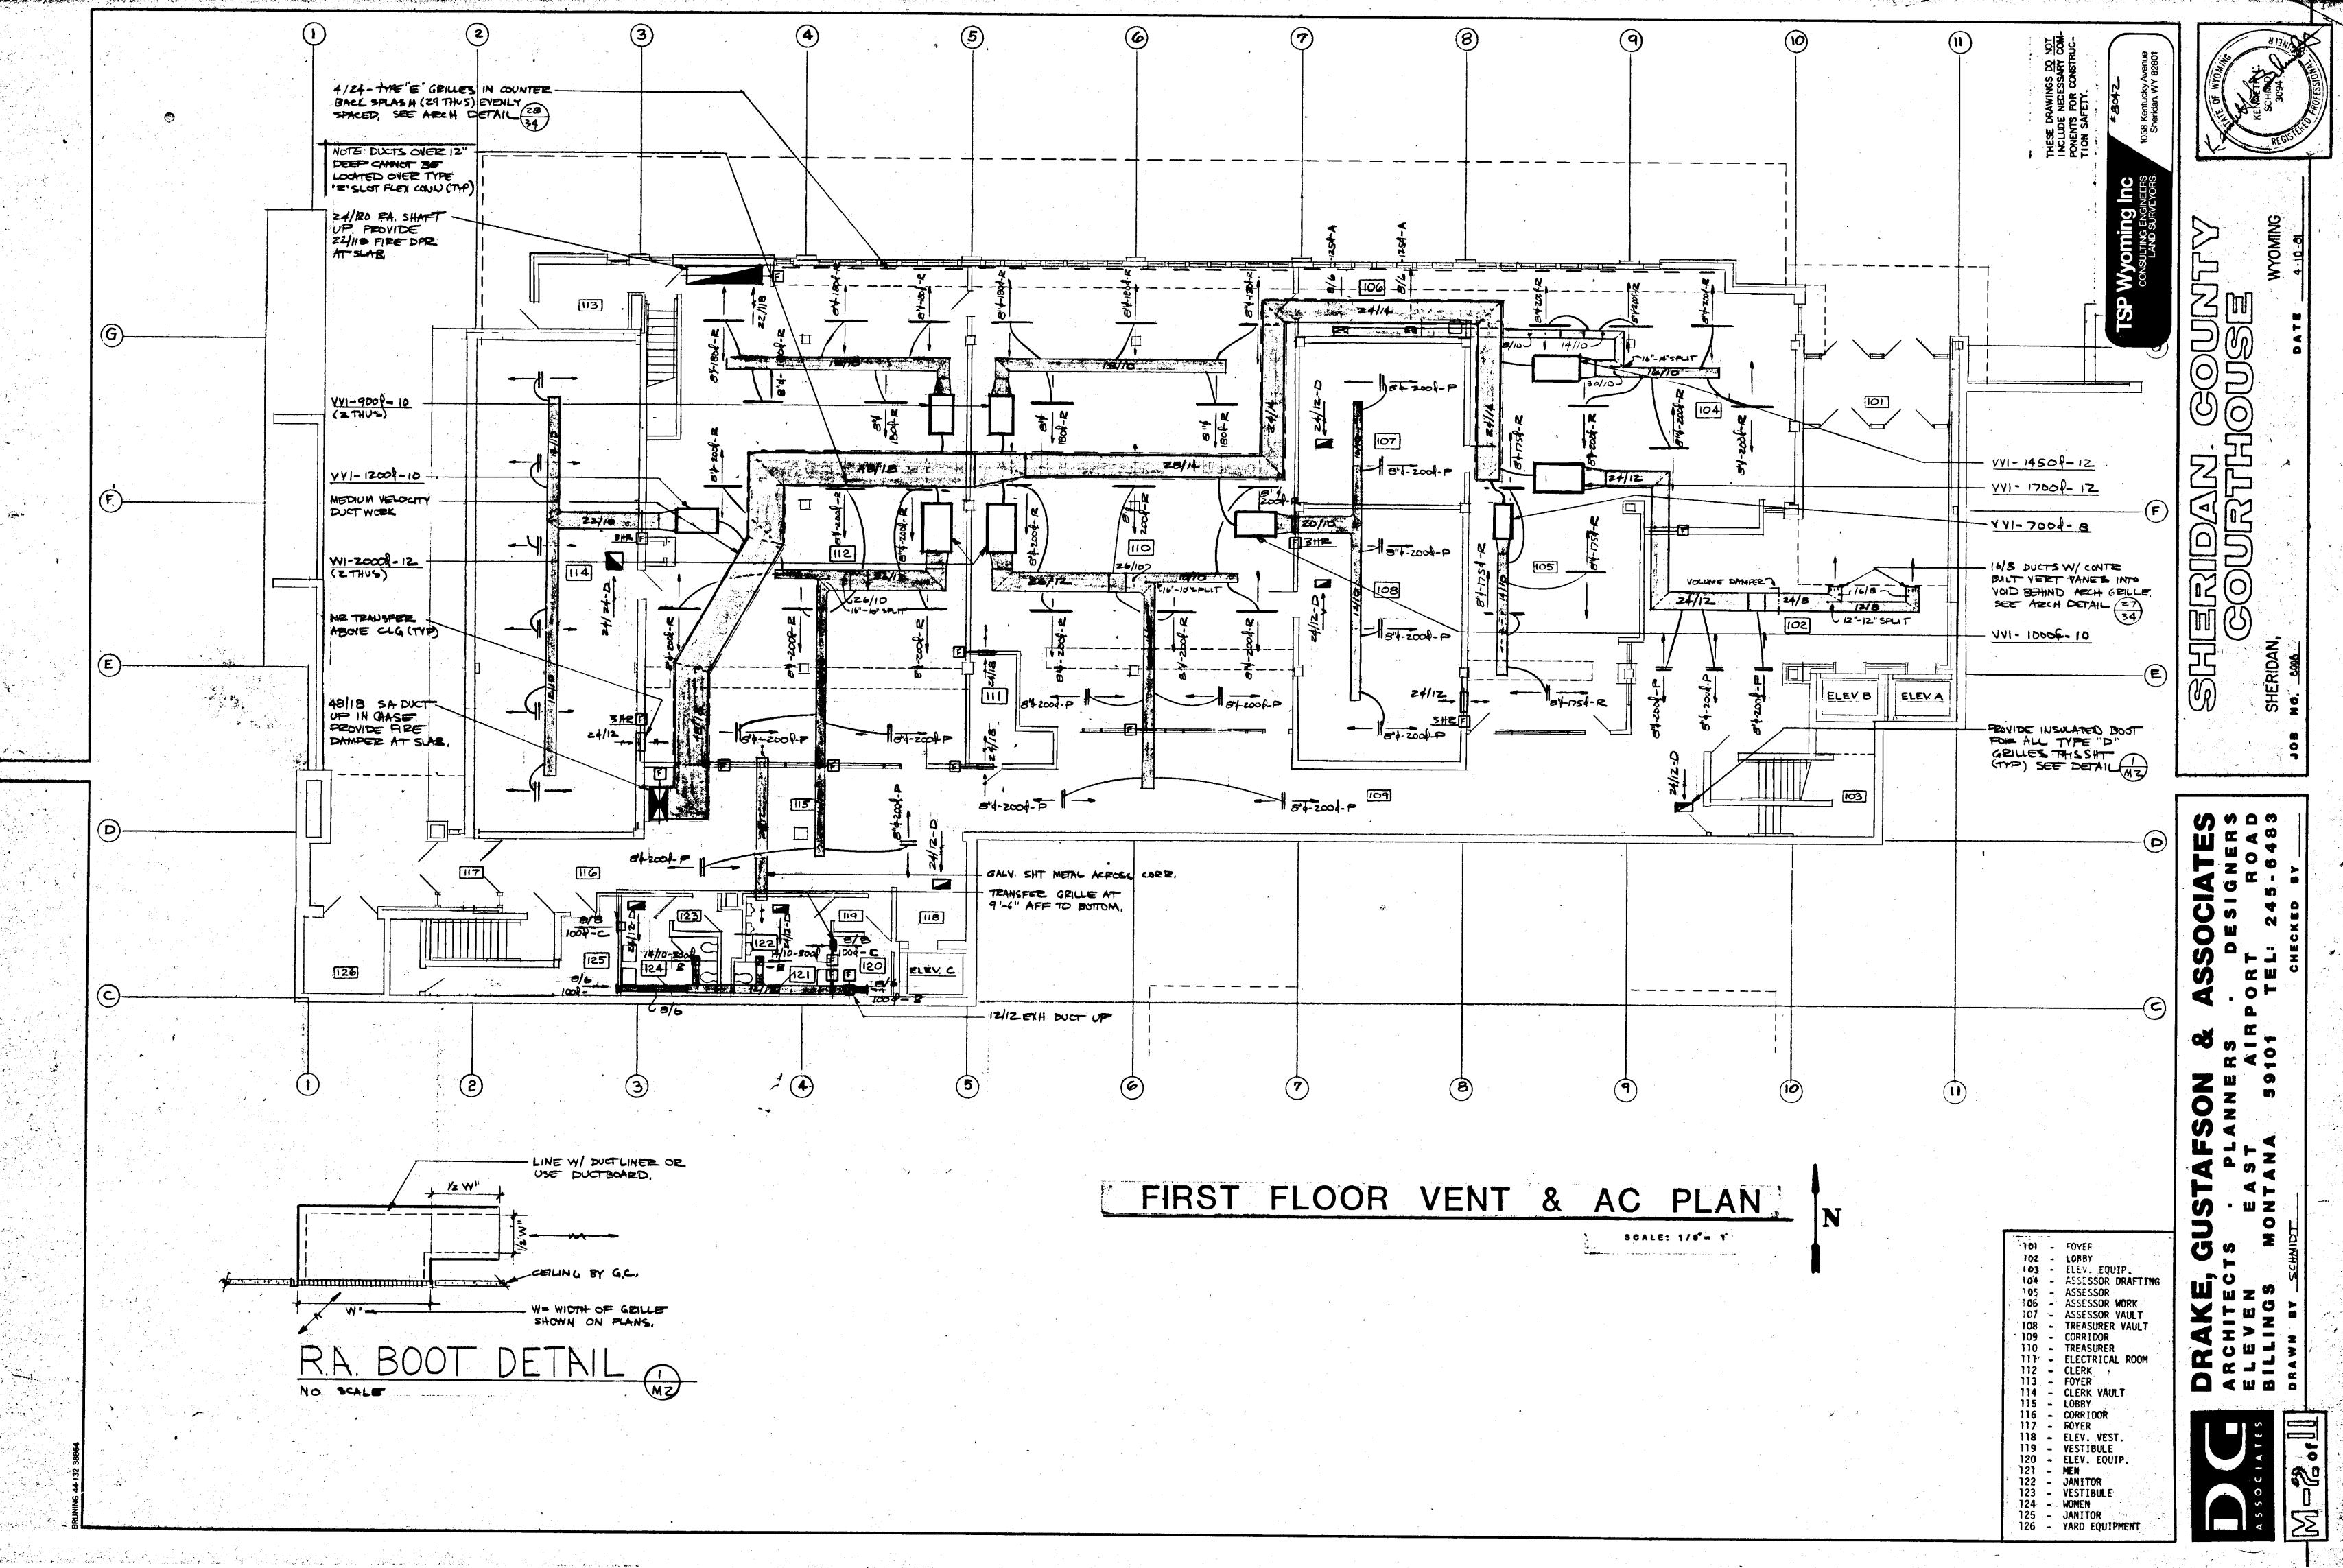

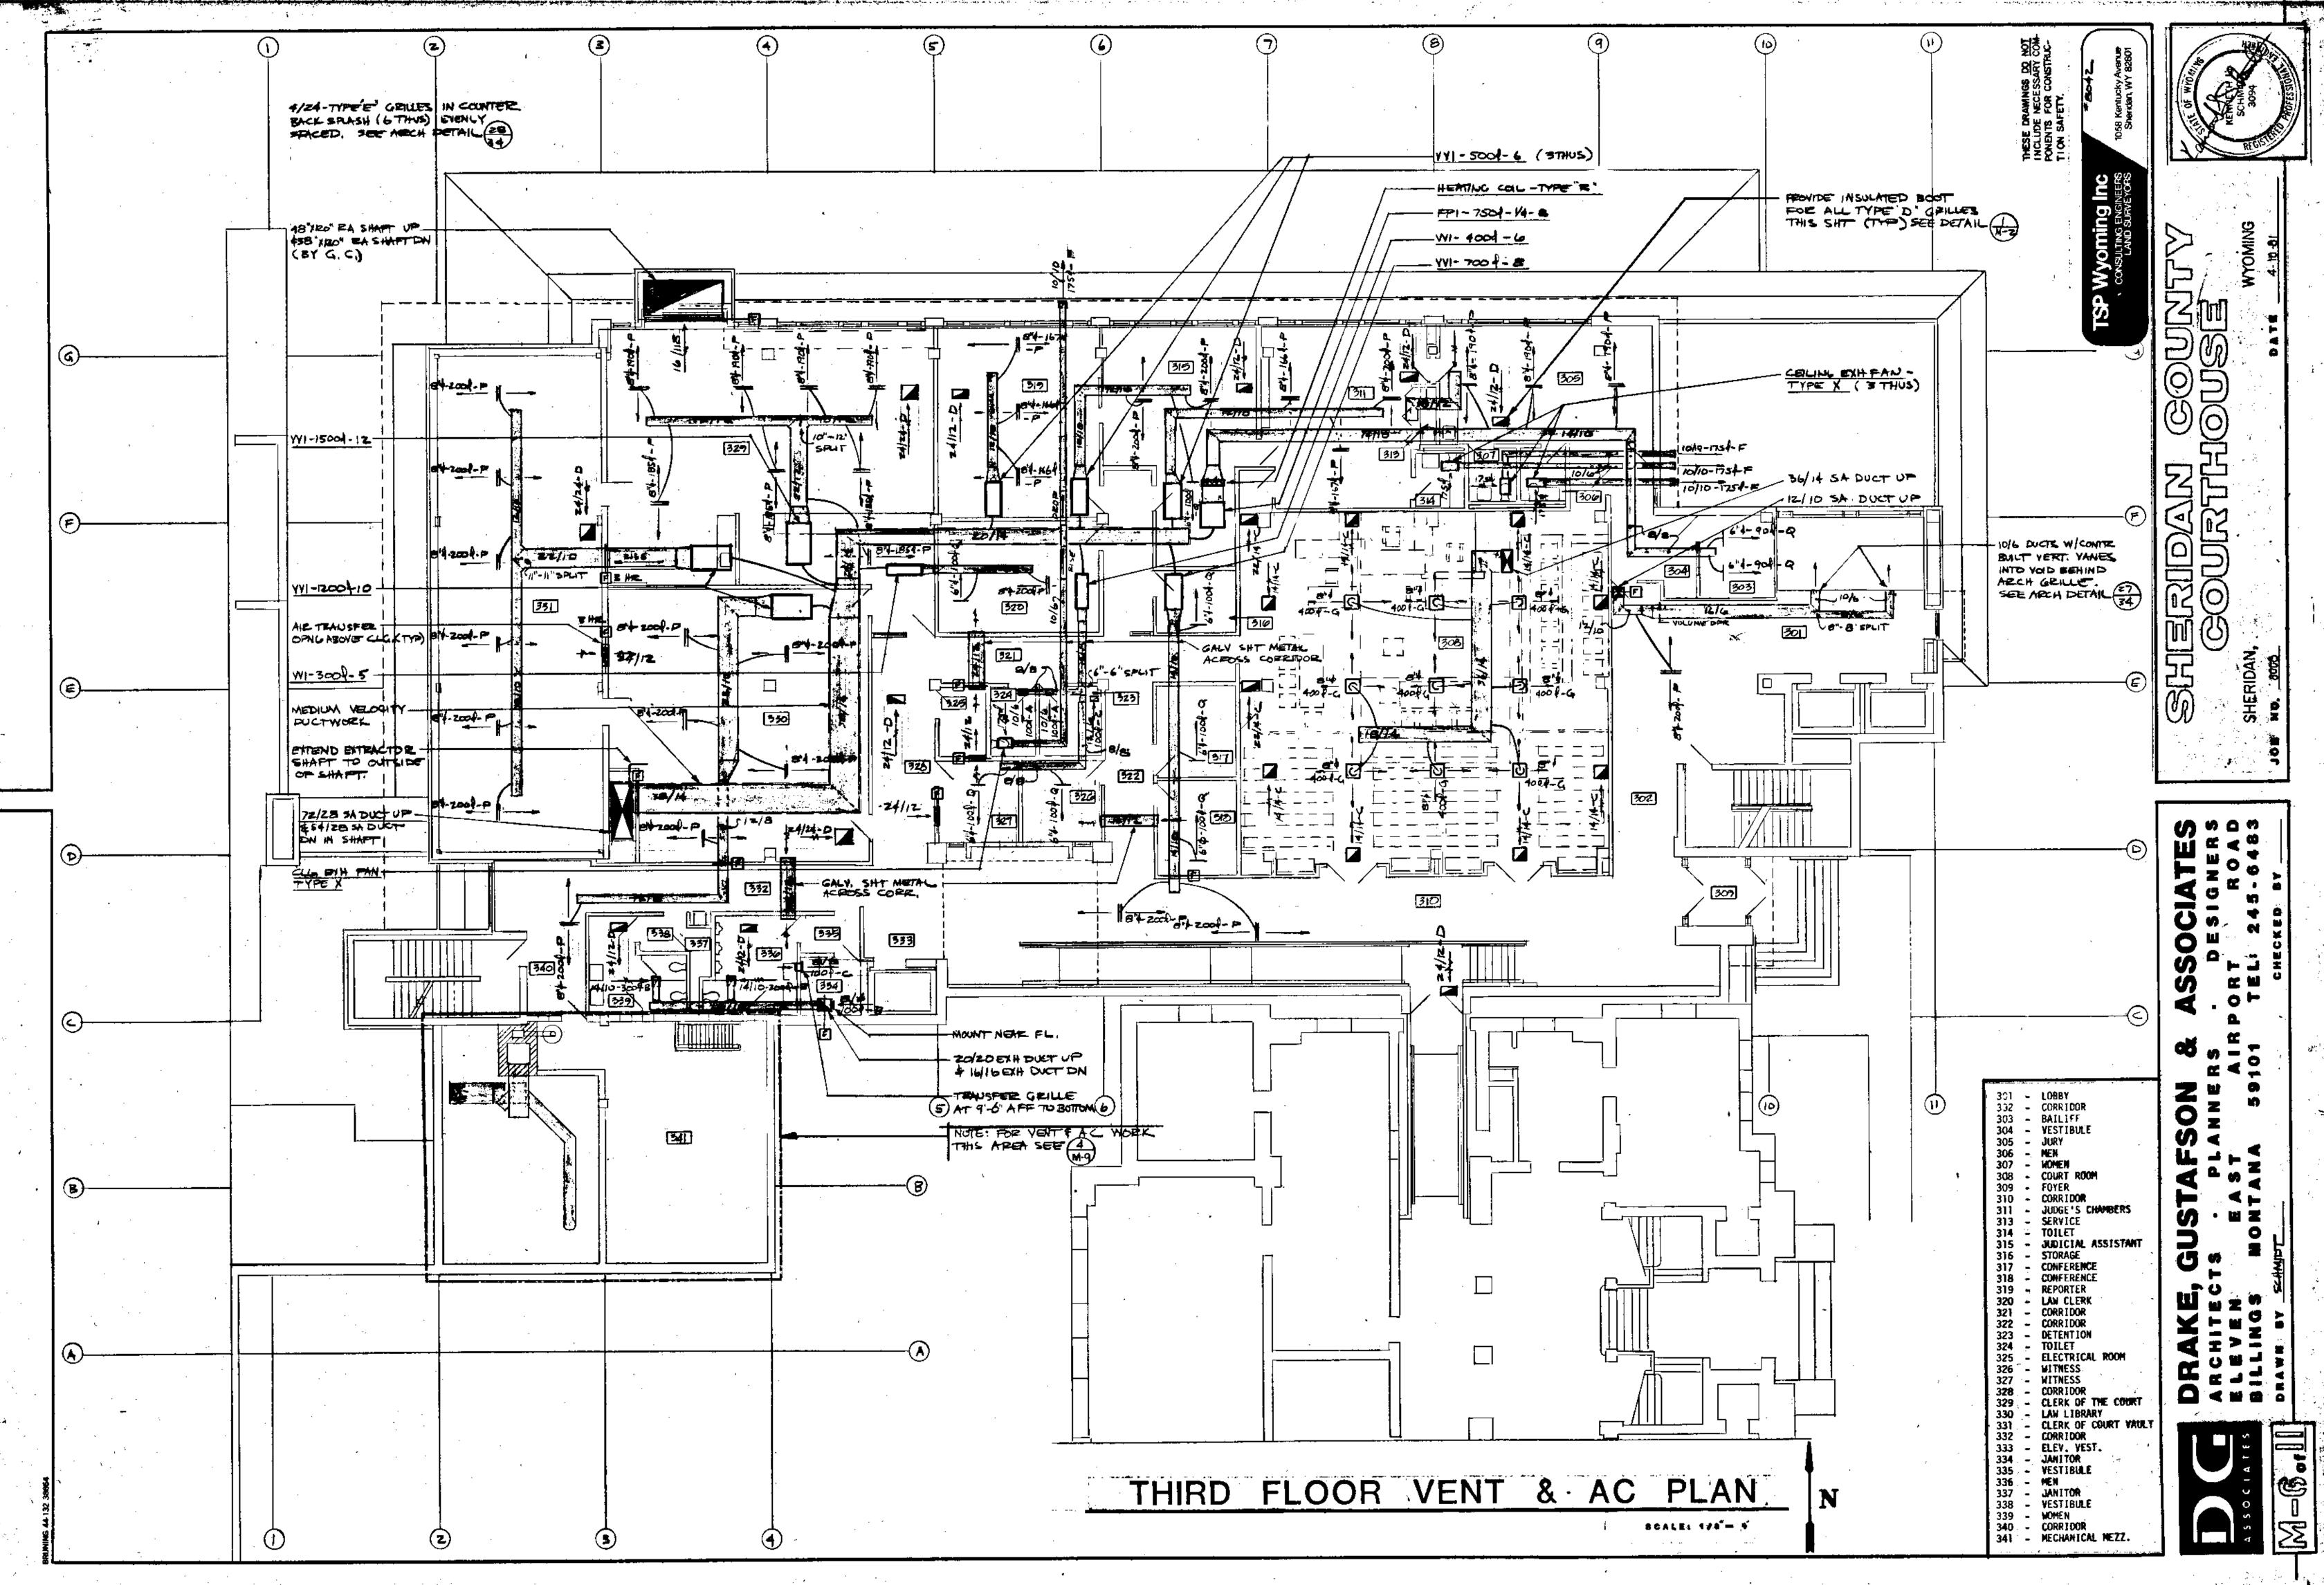

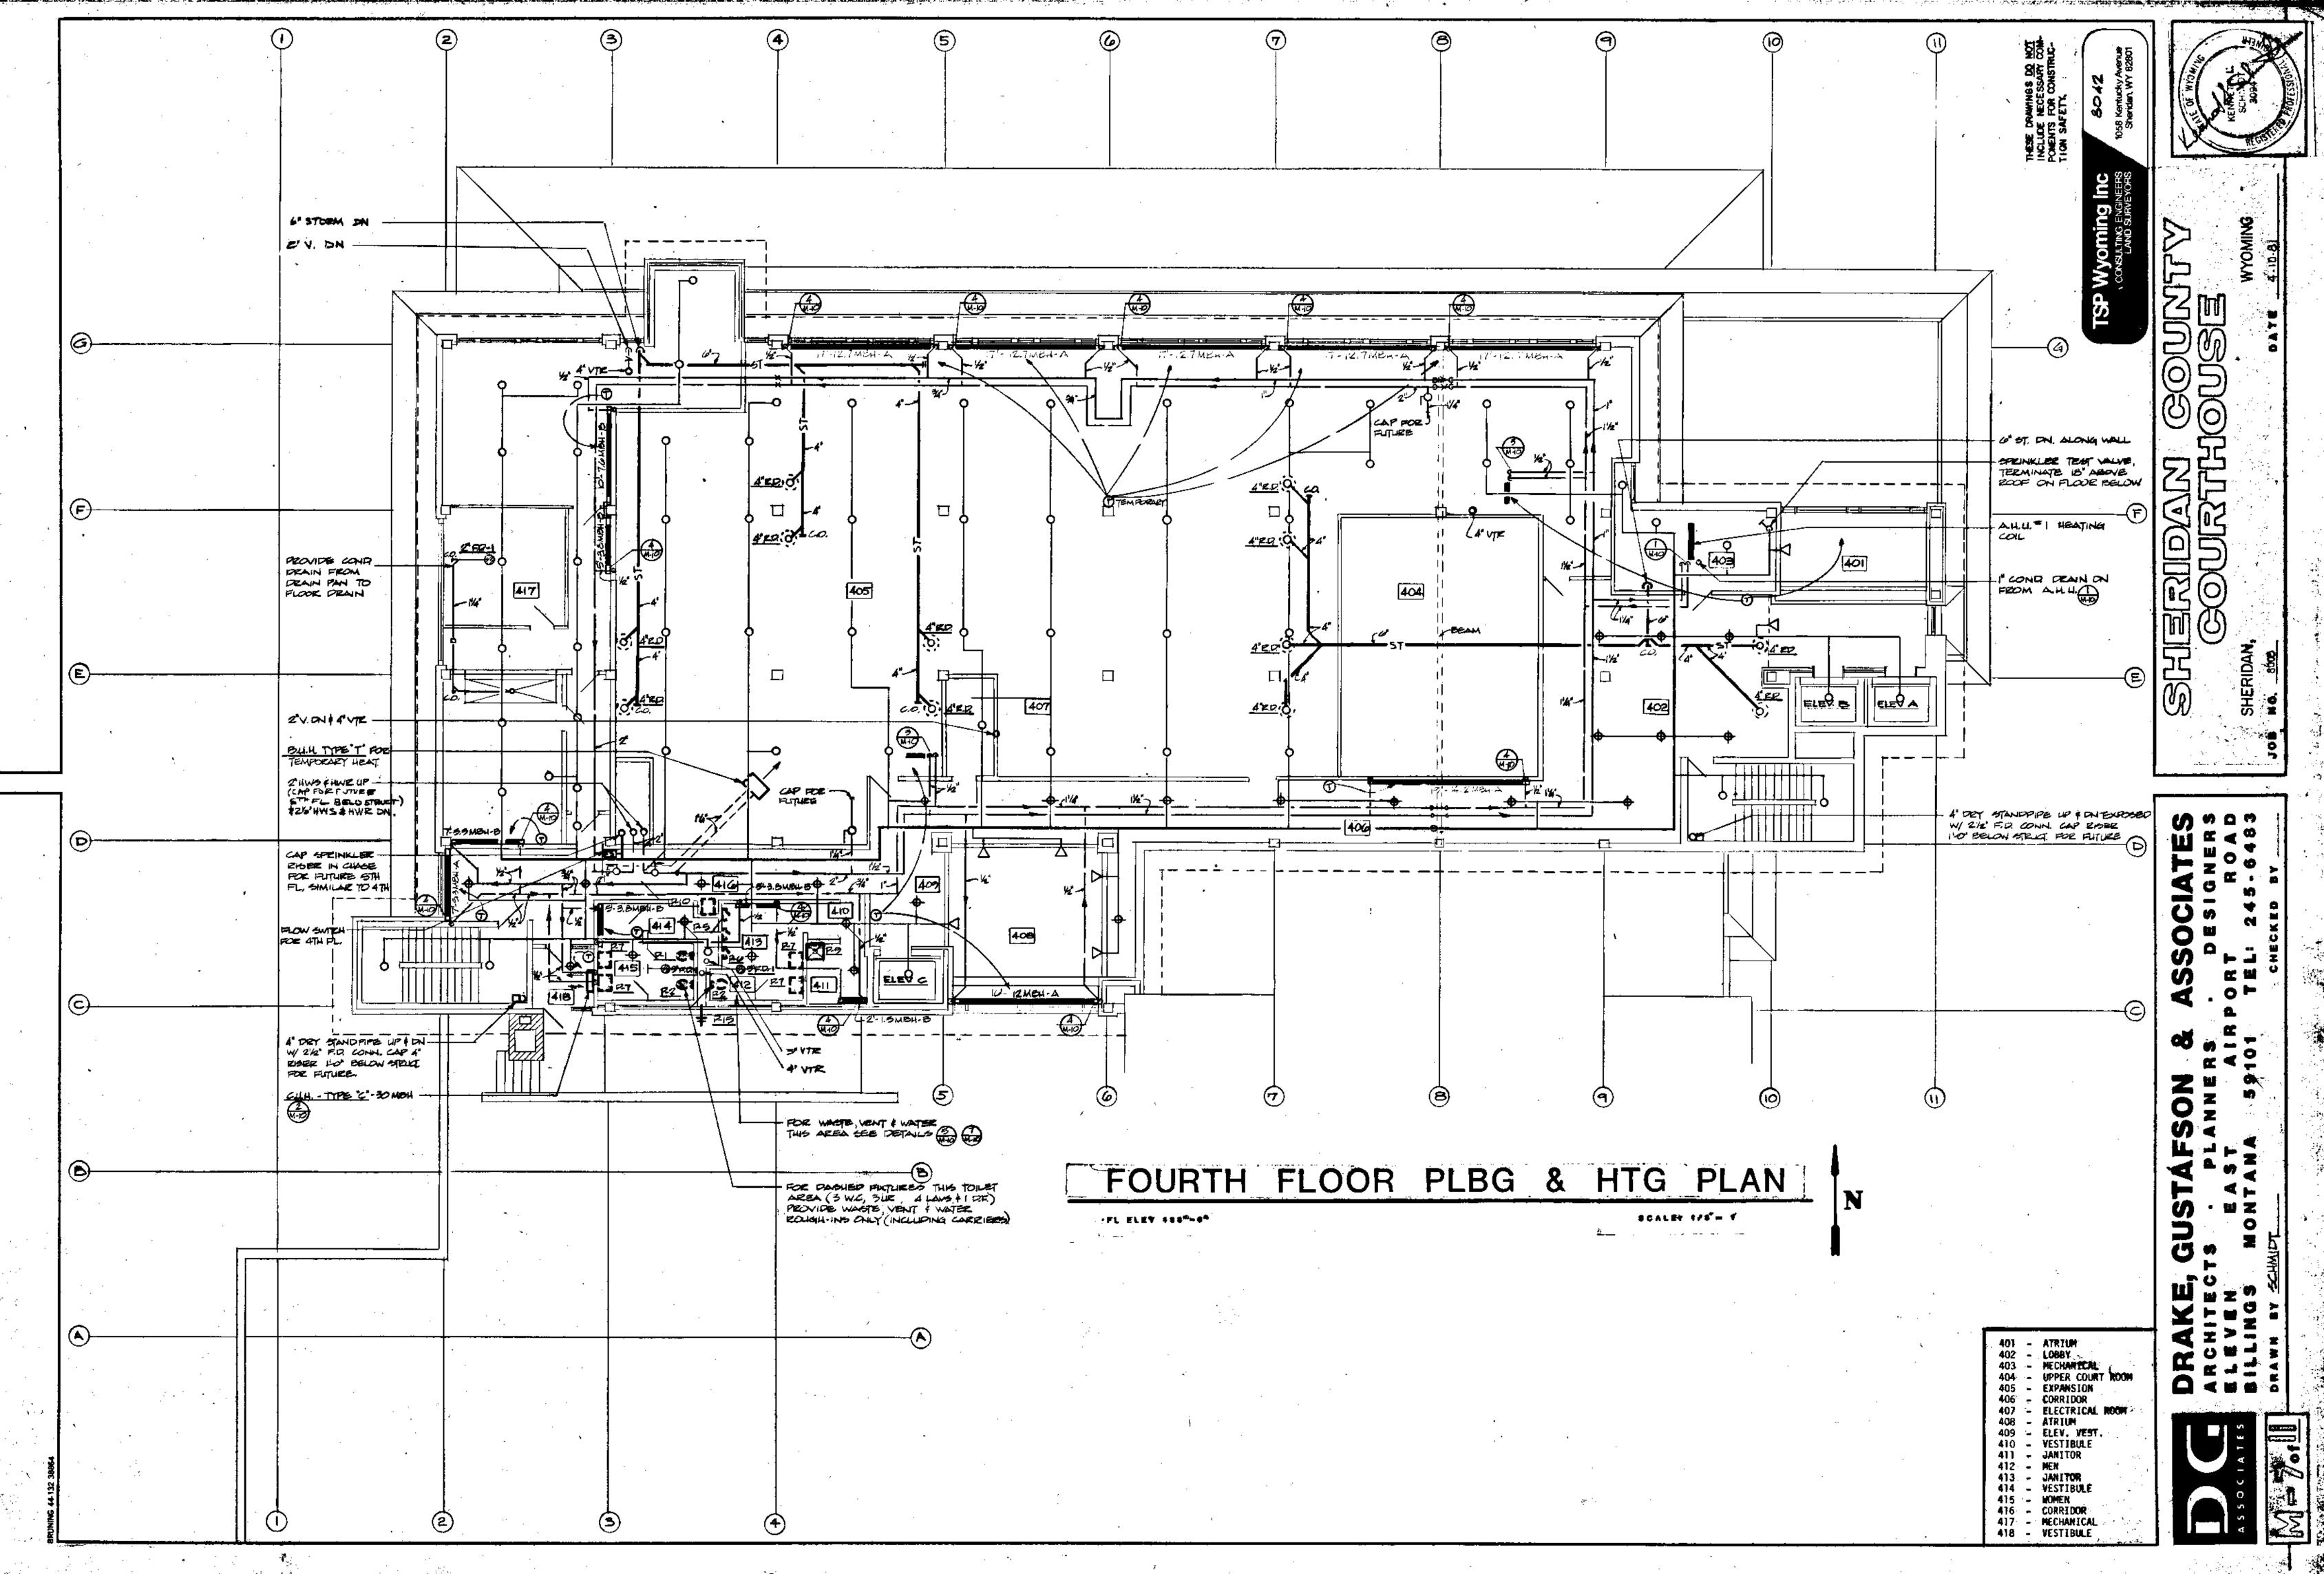


| | I | | | | |
|---|---|---|---|---|---|
| Ð | 5 | 6 | 7 | Ø | 9 |
| | | | | | |
| · | | | | | |
| | | | | | |

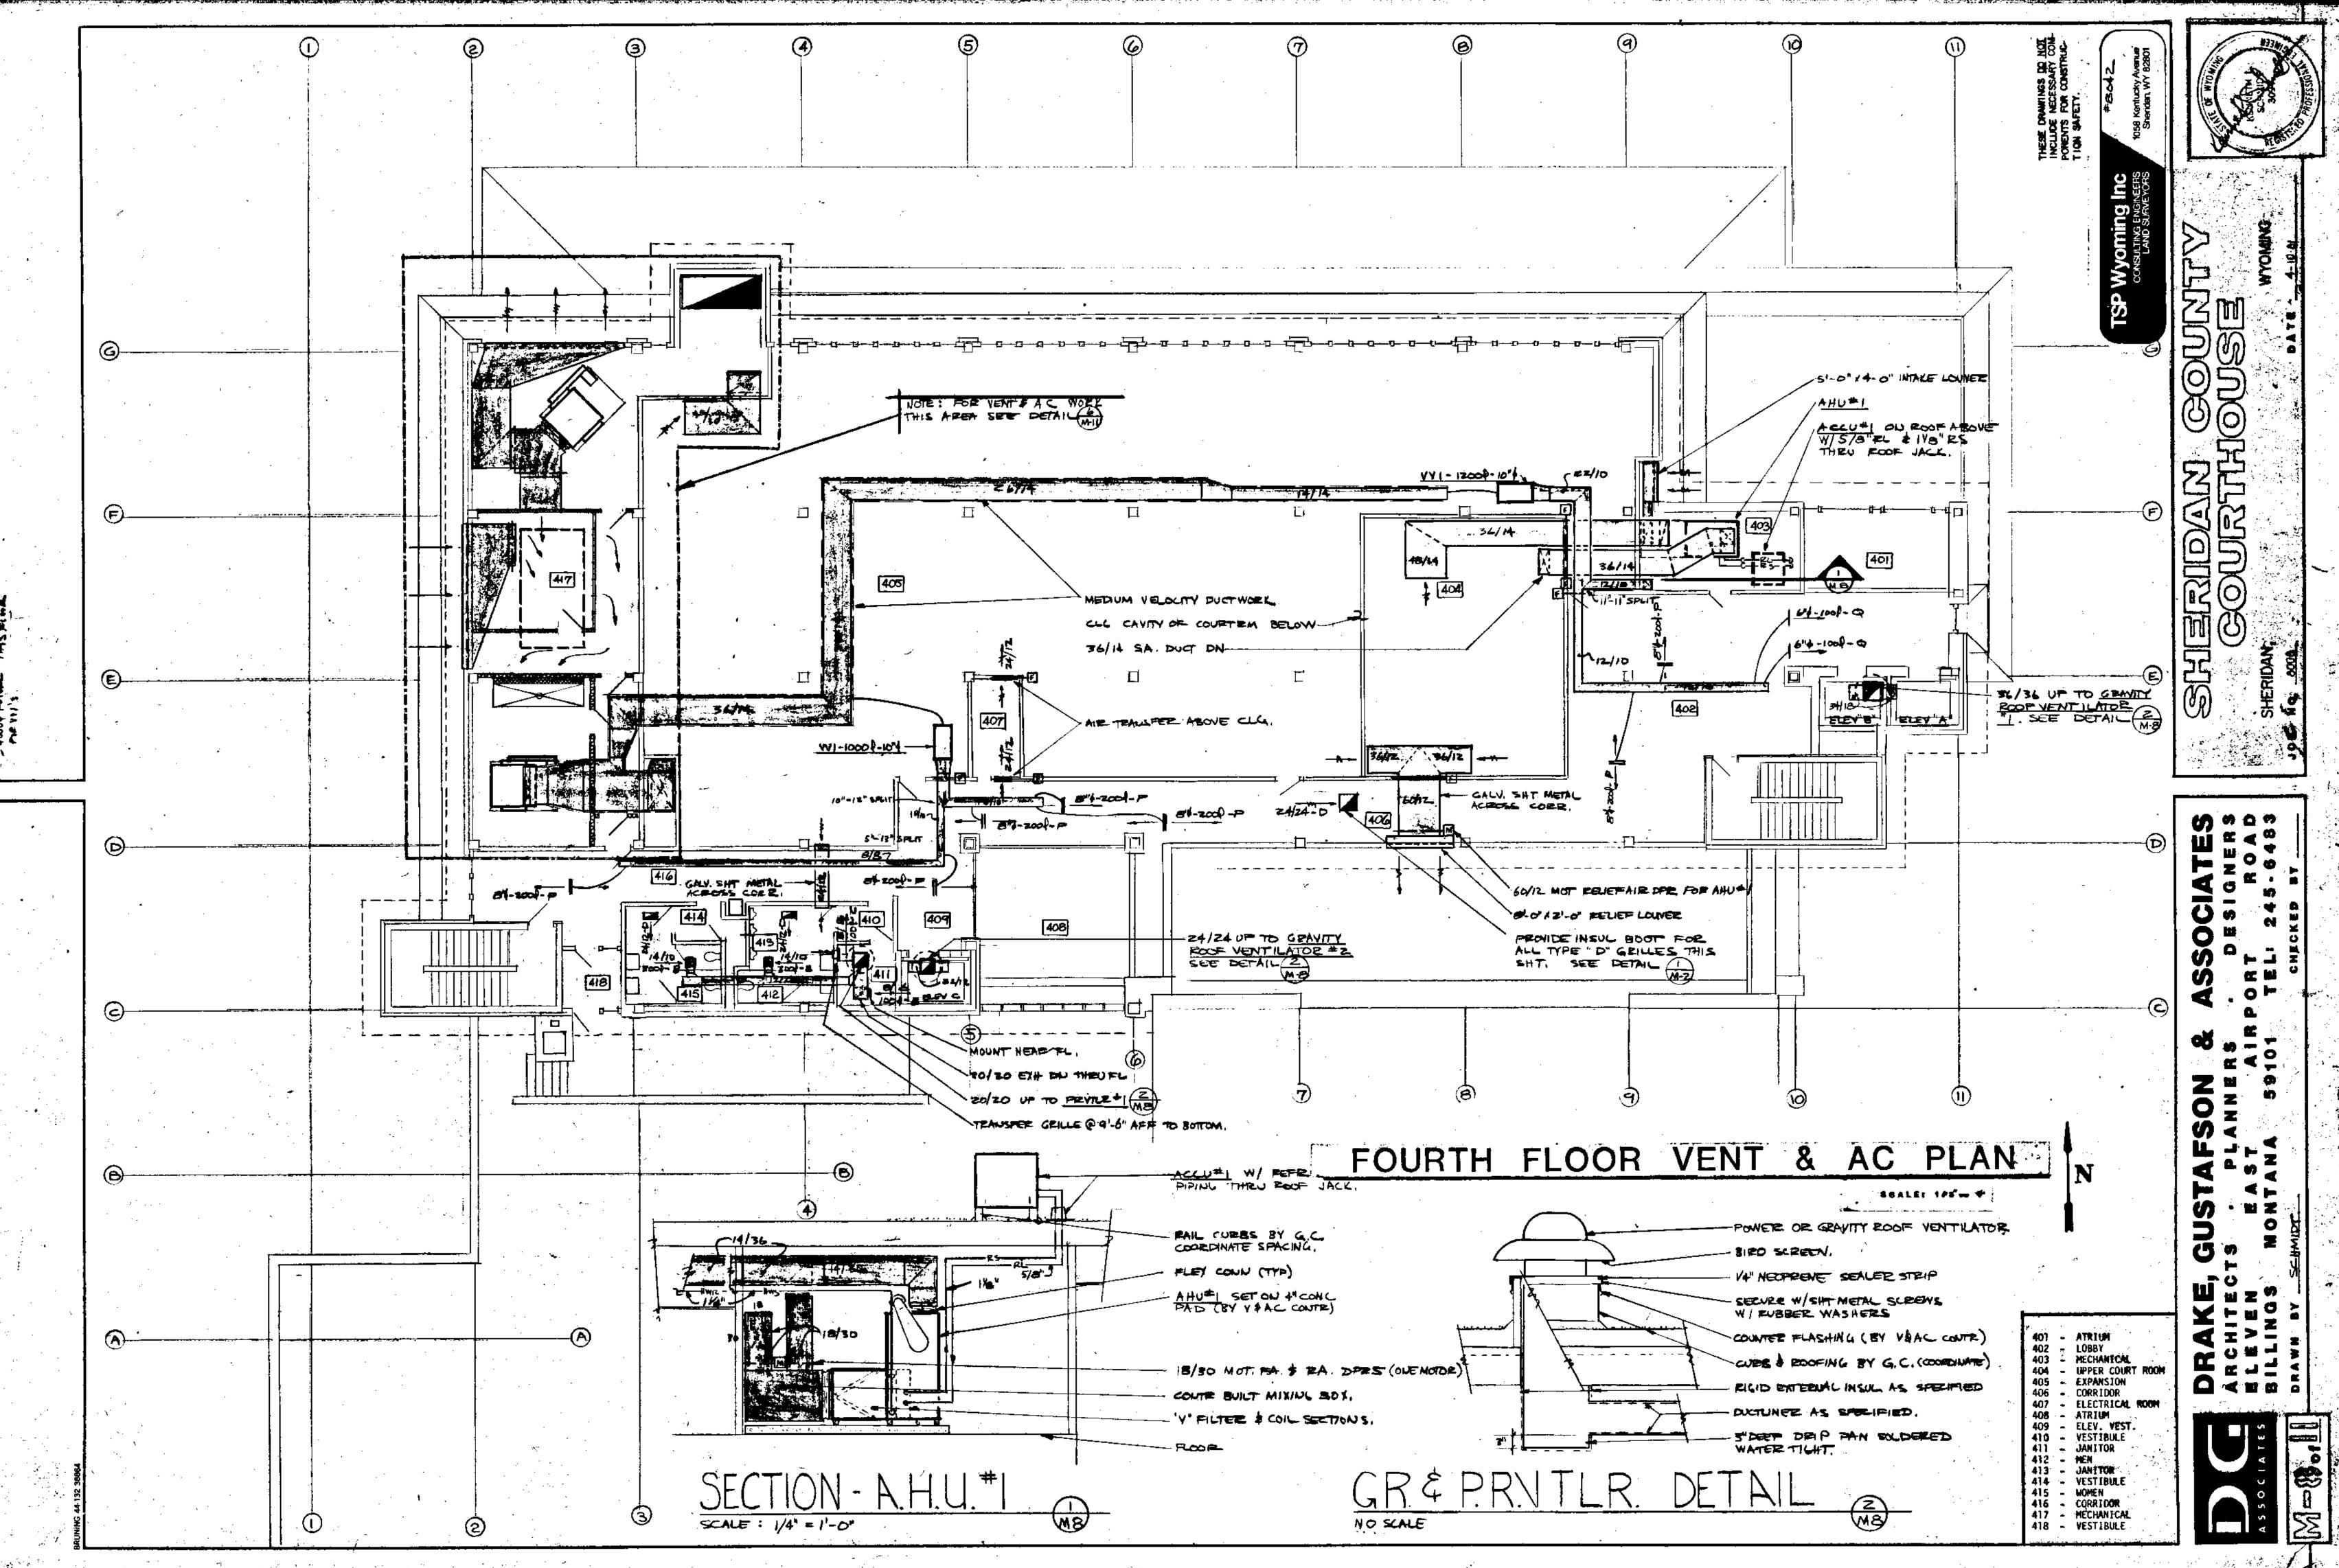



BOHLERE & PUMP LOCAL CONTINUE PANEL COMPECT S" & WATER HEATER -FLUE TO G & MASONEY CHIMMEY. WATER HEATER + CIRC 12" PUMP # Z . SEE DETAIL 6 I"DEMN & I'L"OW DN SAF#2 SUSP FEOM STRUCT ABOVE PROVIDE PECT, TO ROUND TRANSITIONS W/D. FLEXCONN. 1.1 SEALA NOT FA. S RA. DPRS -CAP 20 + FLUE FOR FUTURE CONNECT 324 BOLLER FLUE TO 32" A MASONEY CHIMNEY, PEOVIDE C. O. IN END OF FLUE 4" H.W.S. DN TO BOLLEL W'GAS DN TO HEADER 3/4"C.W. DN TO BOUER 2 " POLER FLUE SUSP FRON STRUCT, 4"HWE DUTO BOLEE ----3/4" C.W. DN TO WALL HYDRANTS. 20" CO. IN END OF HOBIZ FLUE LOCATION OF O.A. SENSORE FOR TEMP CONTROL UPPER BOILER RM PLAN SCALE : 14" - 1-0" FROMIDE #" SLHEDULE 40 ENH FOR E. GEN. PITCH IN TO CHMNEY & NOTE: VERIEY ALL LOUVER TERMINATE IN CHIMNEY WAZ! DIMENSIONS W/ACTUAL THE ELEC CONTE TO PROVIDE MUPPLER & INSUL THM BLE. OPNG ON JOB BEFORE OF PERING INSULATE FIRM & BAUFFLER 5'-6' x 4'-7"LOUVER Assected ABOVE DOOR , BLANK. OFF & CONER W / FILLE Remote Persen Water WETER AT S'-O" A.F.F. UNDER HIE ALARM BELL. INSUL, I'DRAIN TROM ABOVE \$14"CW. UP. 122 レック 6" WATER SERVICE, FOR CONT. SET SITE FLAN SHT HE-! FIRE ALARM BELL AT 8-0 AFT <u>(</u> 2%) FOR FIRE SPEAKLER ! -14 FB. - 2". WATER METER PIPING SEE DETAIL 5°FD,-2 4" FL. CO. 56/ 24 FA. UM----S'-8" W X I P-11" H. LOUVER, SO THAT IT CAN BE REMOVED اسعساني C.O. IN BASE OF CHIMNEY BYG C. LOCATION OF FUTURE BOILER-51 ISTO 2 0 "GAS ON TO BOLLER #1. PROVIDE 7" CAPPED-THE FOR FUTURE BOLLETE 5") "" GAS THRU WALL SEAL W/ SILL CON SEALANT. P-IS WALL HYPRANT-NOTE FOR BOILER ROOM HTE PIPING NEW GAS METER (SET ON SEE DETAIL 6" CONC PAD) REGULATOR SERVICE BY MDU. (7000CFF TOTAL MAX) FUTURE LOAD) 1-1-1-BOILER RM SCALE : 1/4"=1'-0"

. .


.

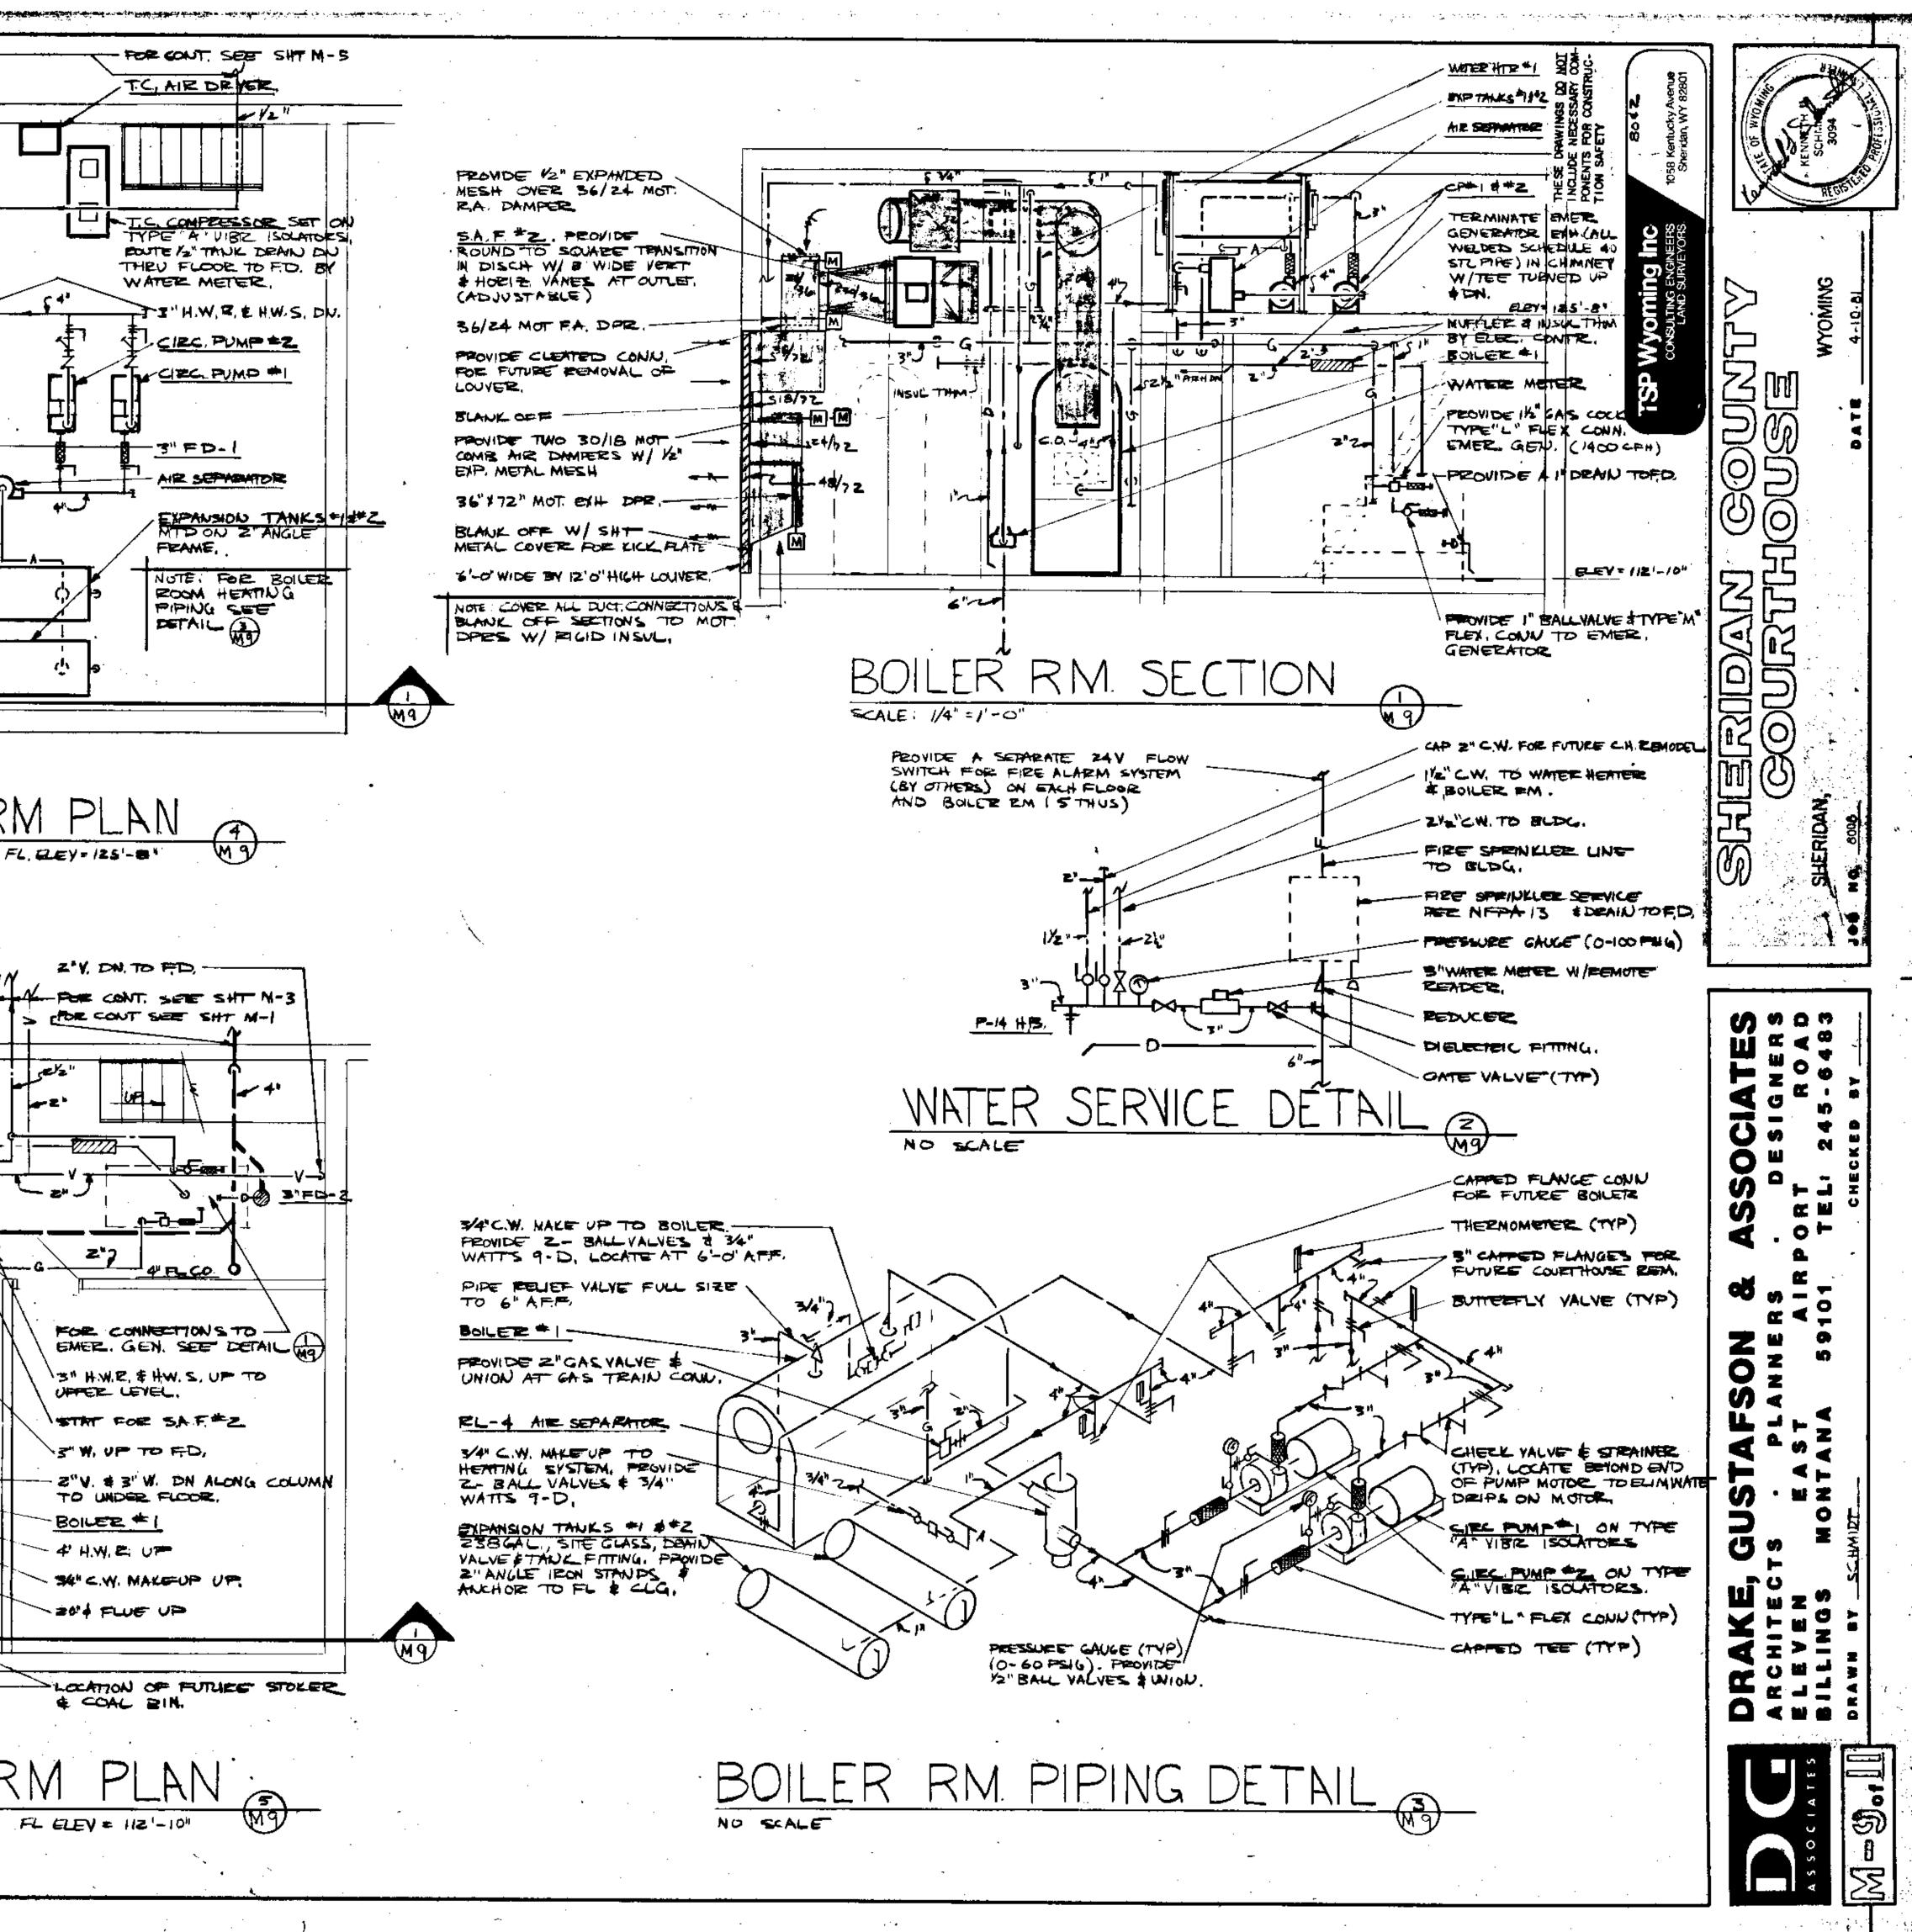


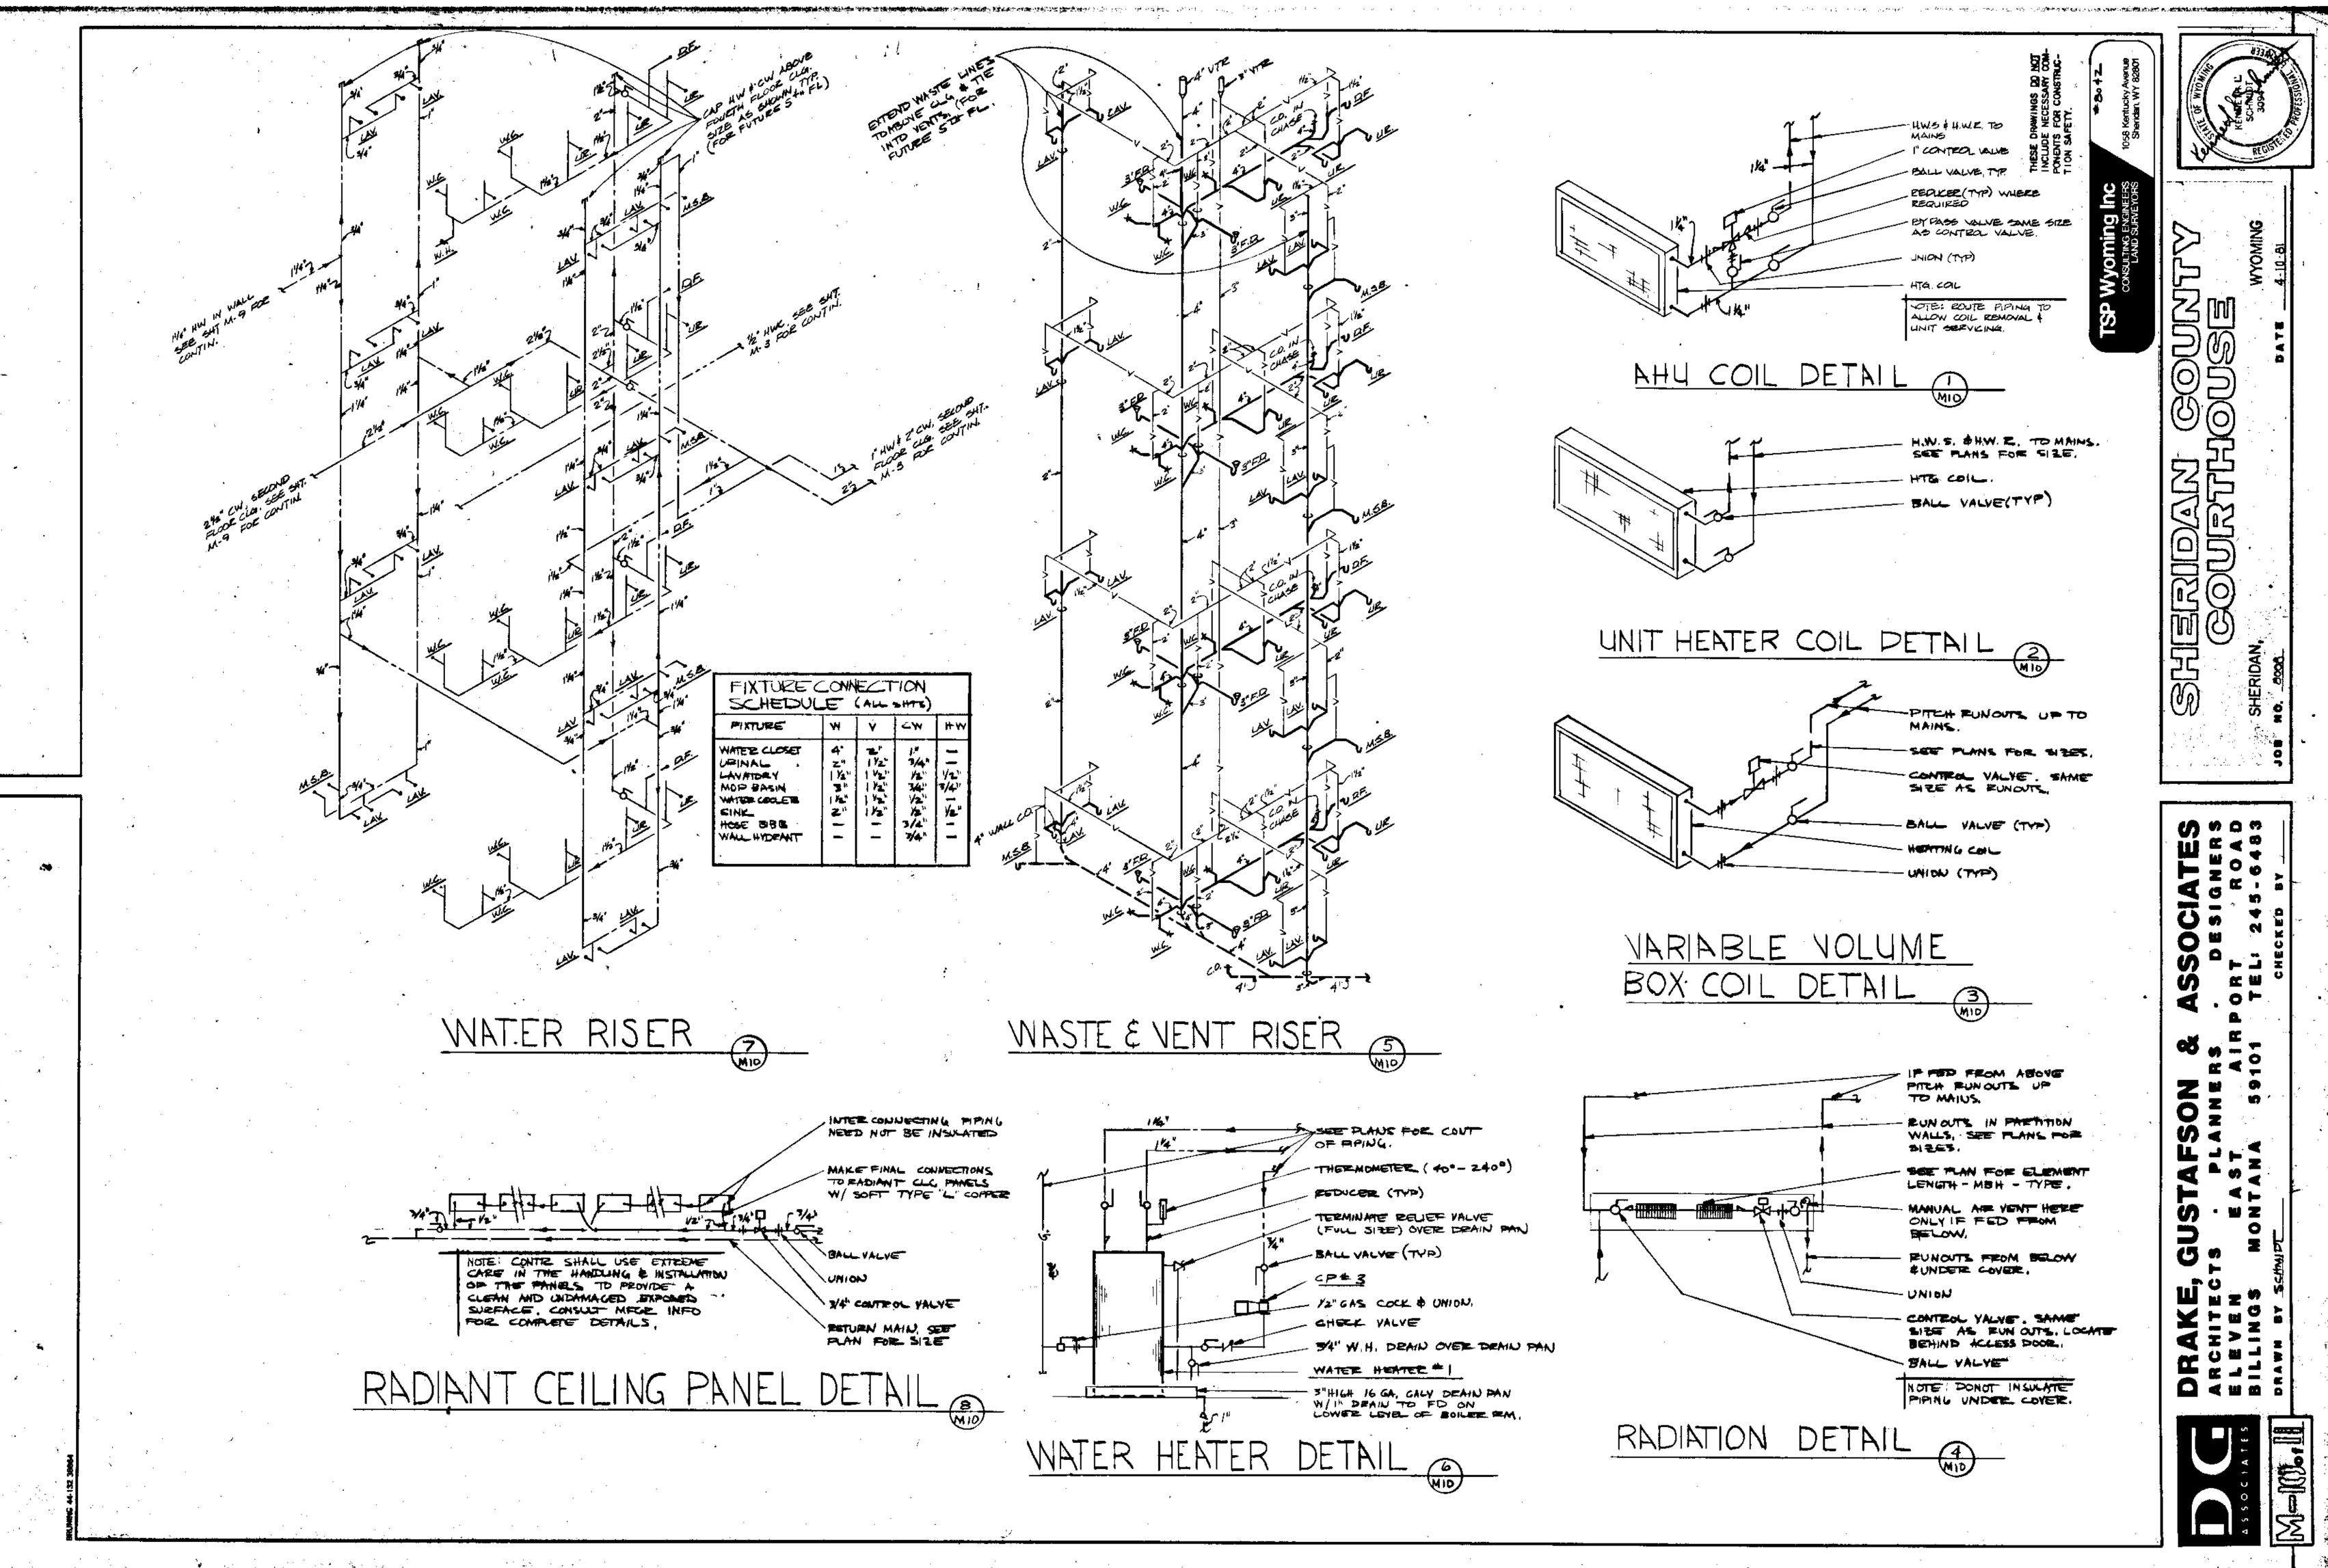


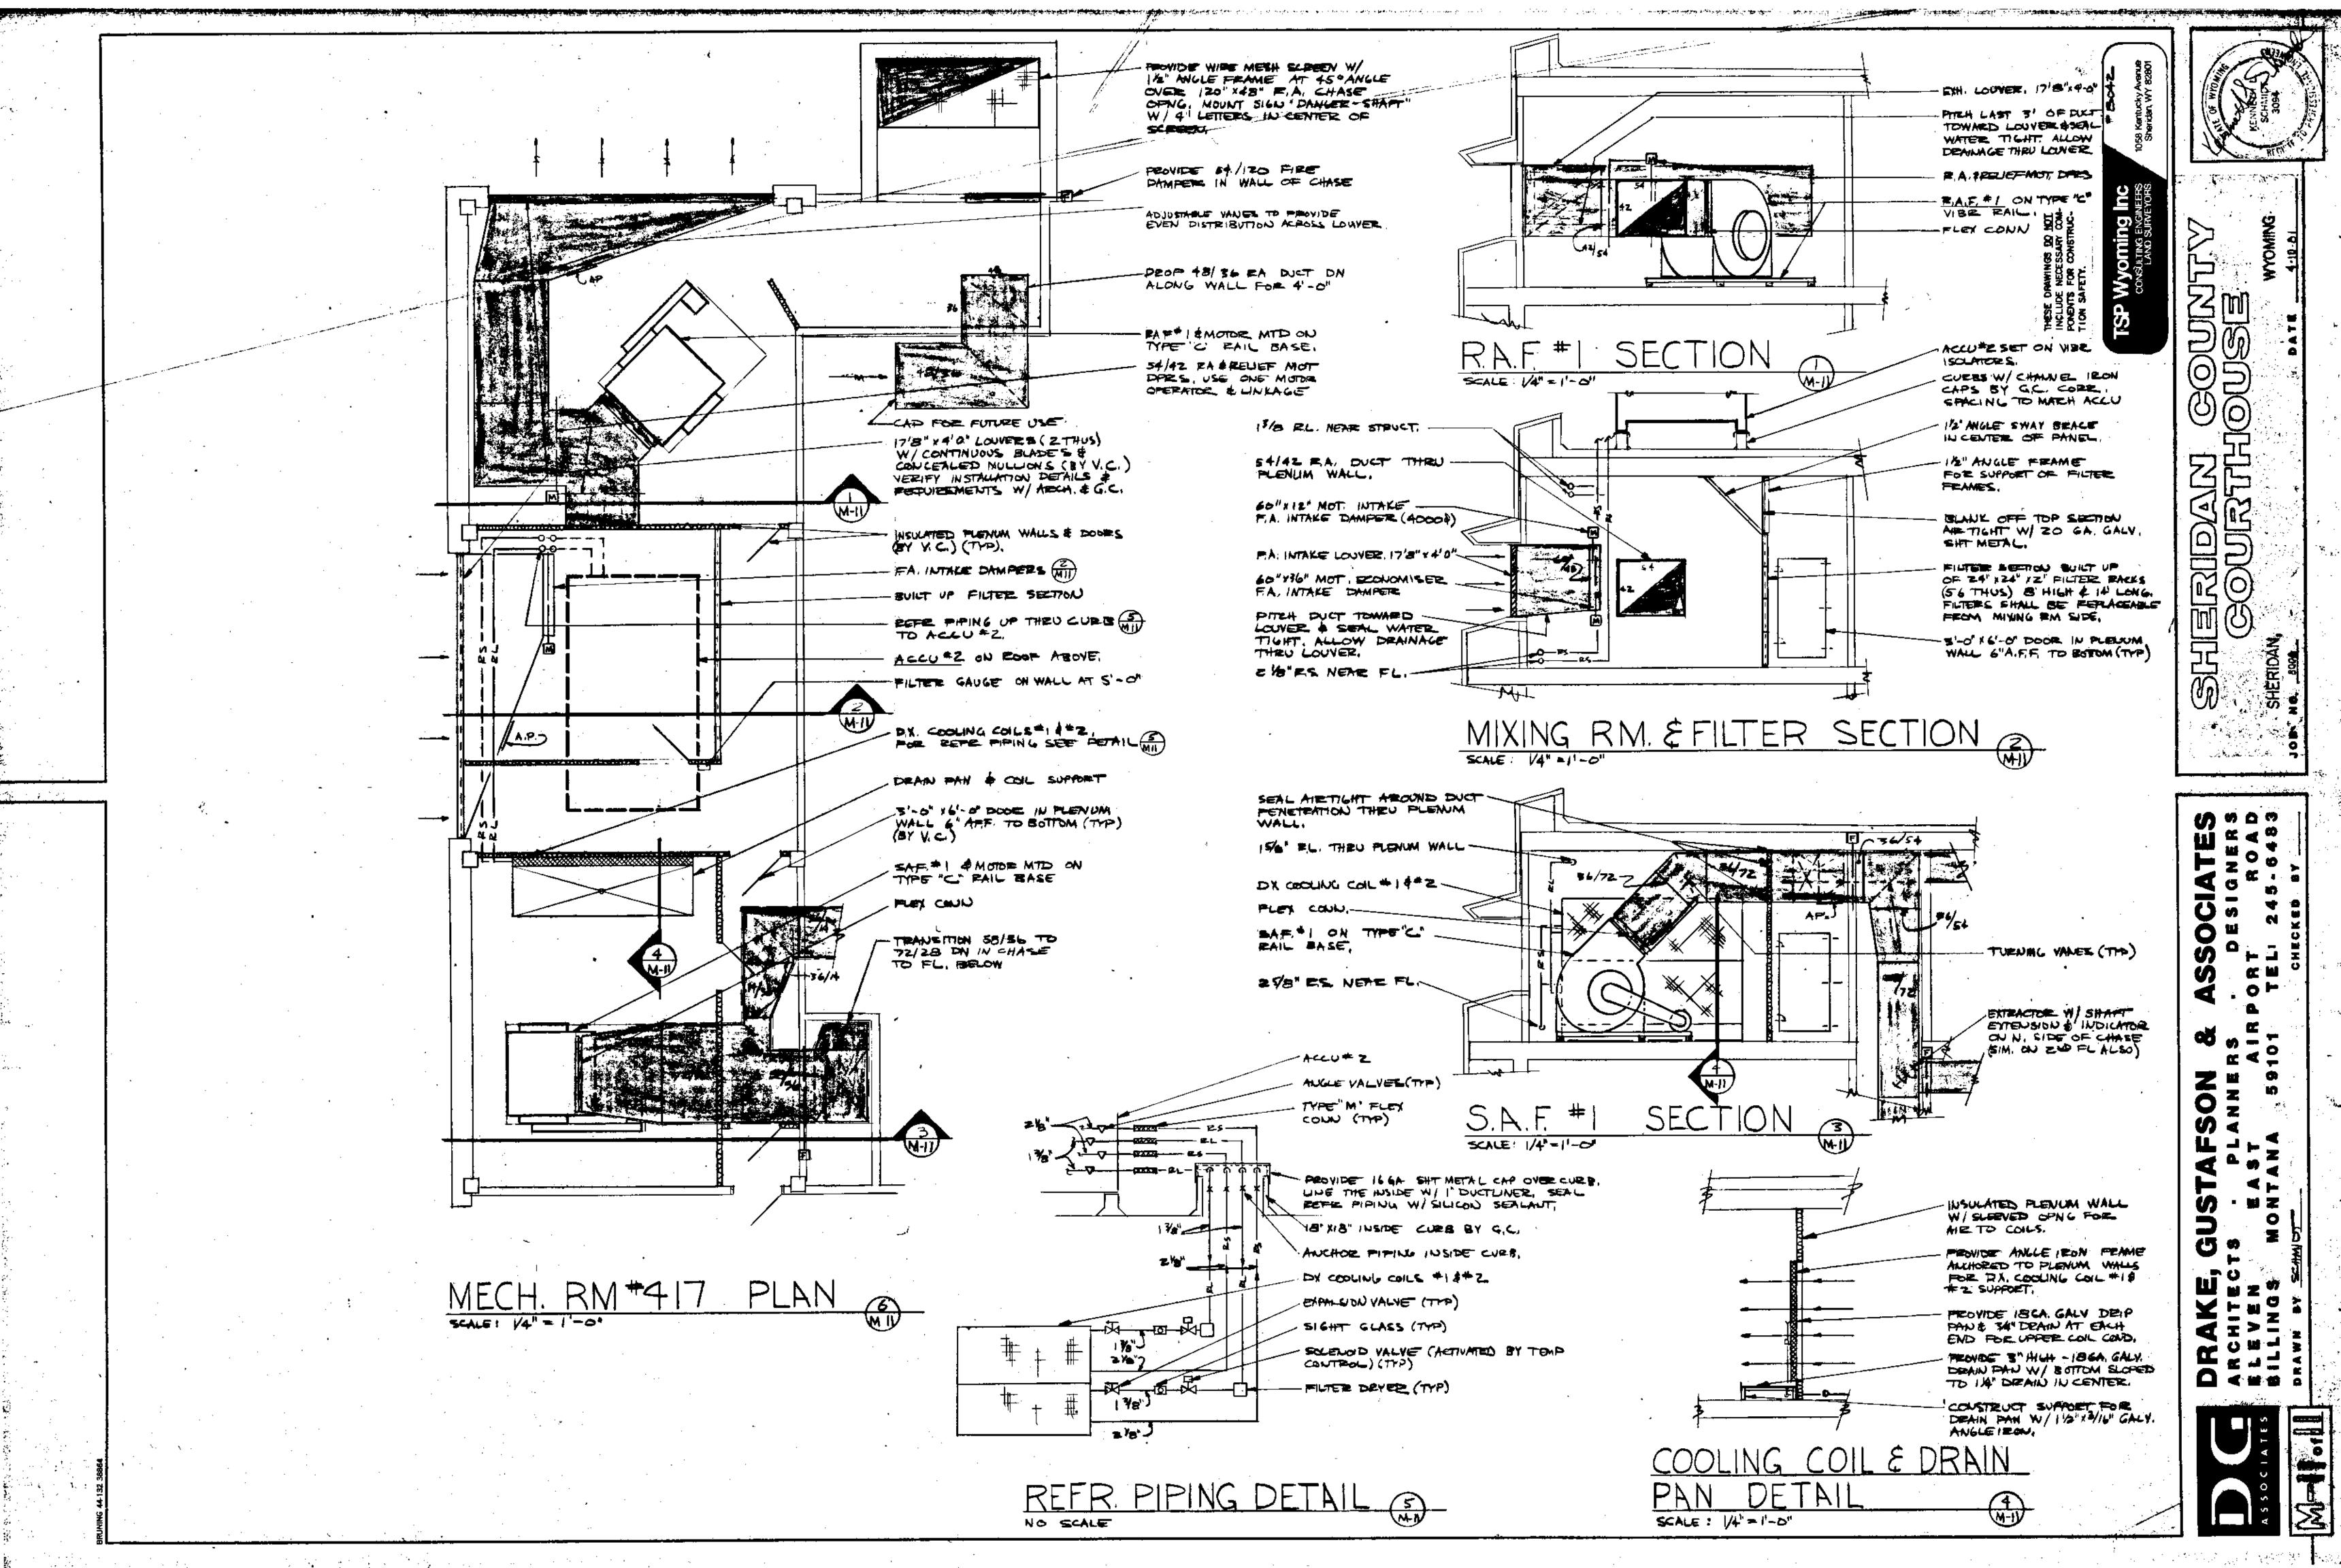





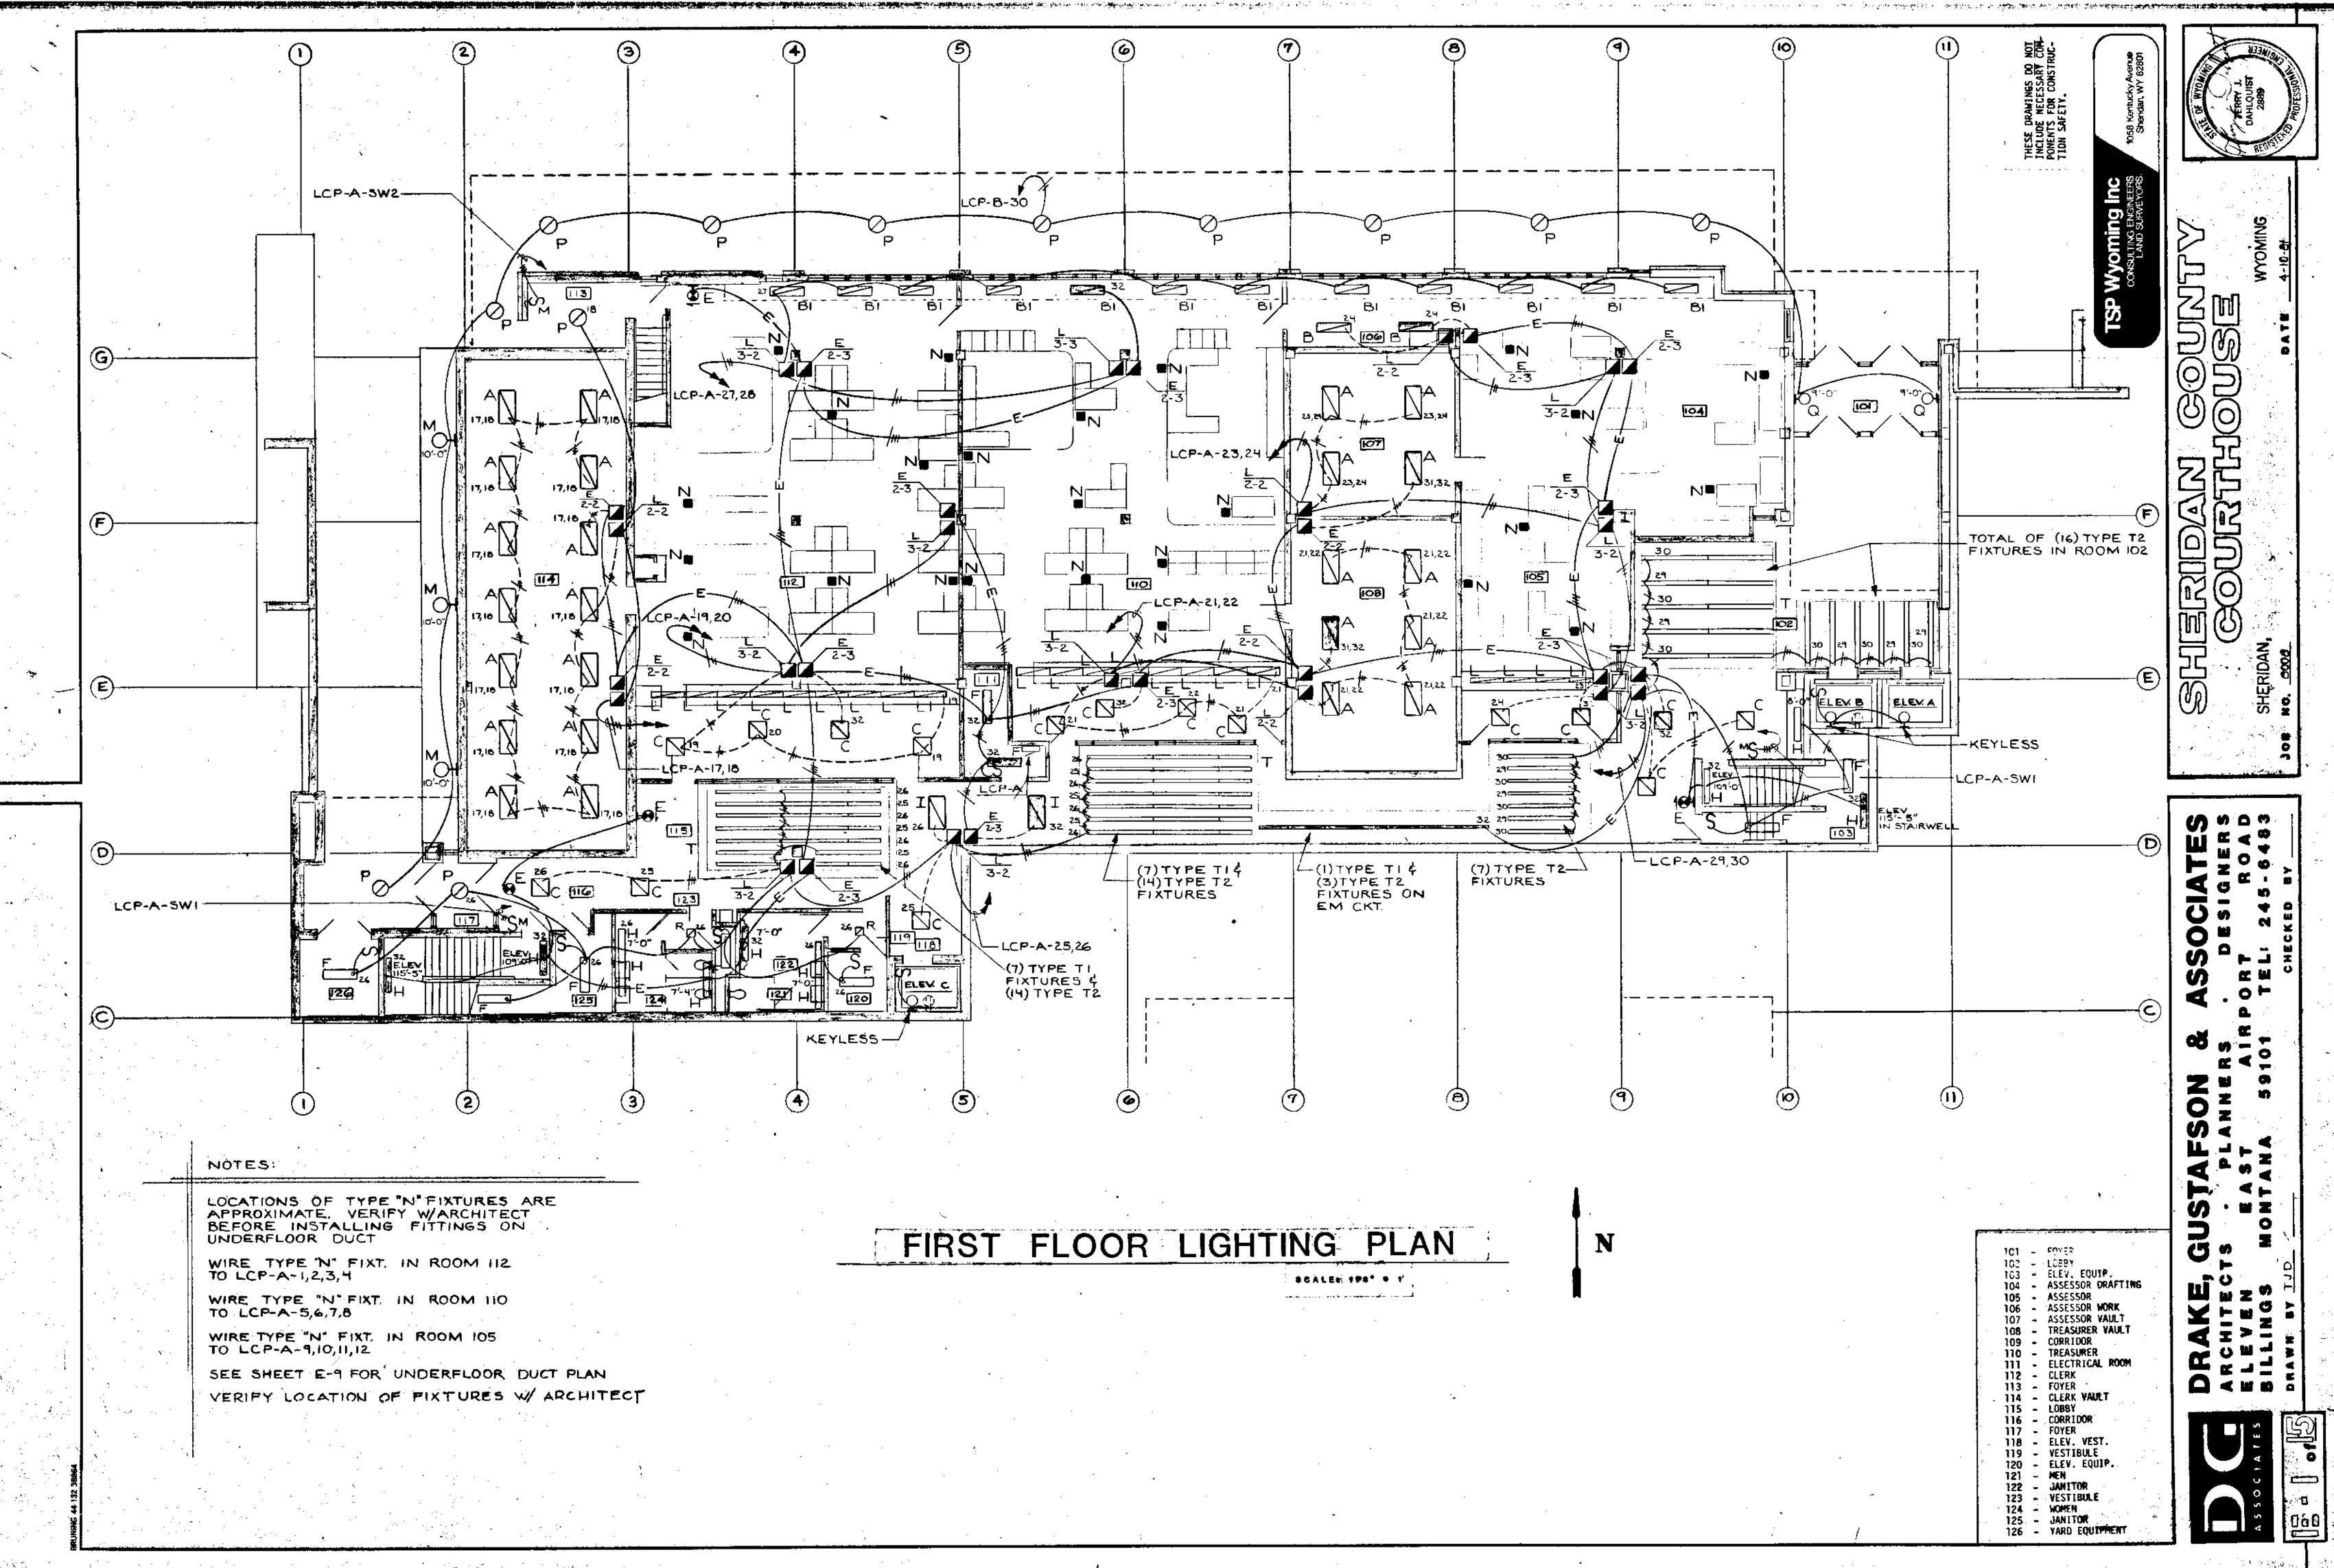


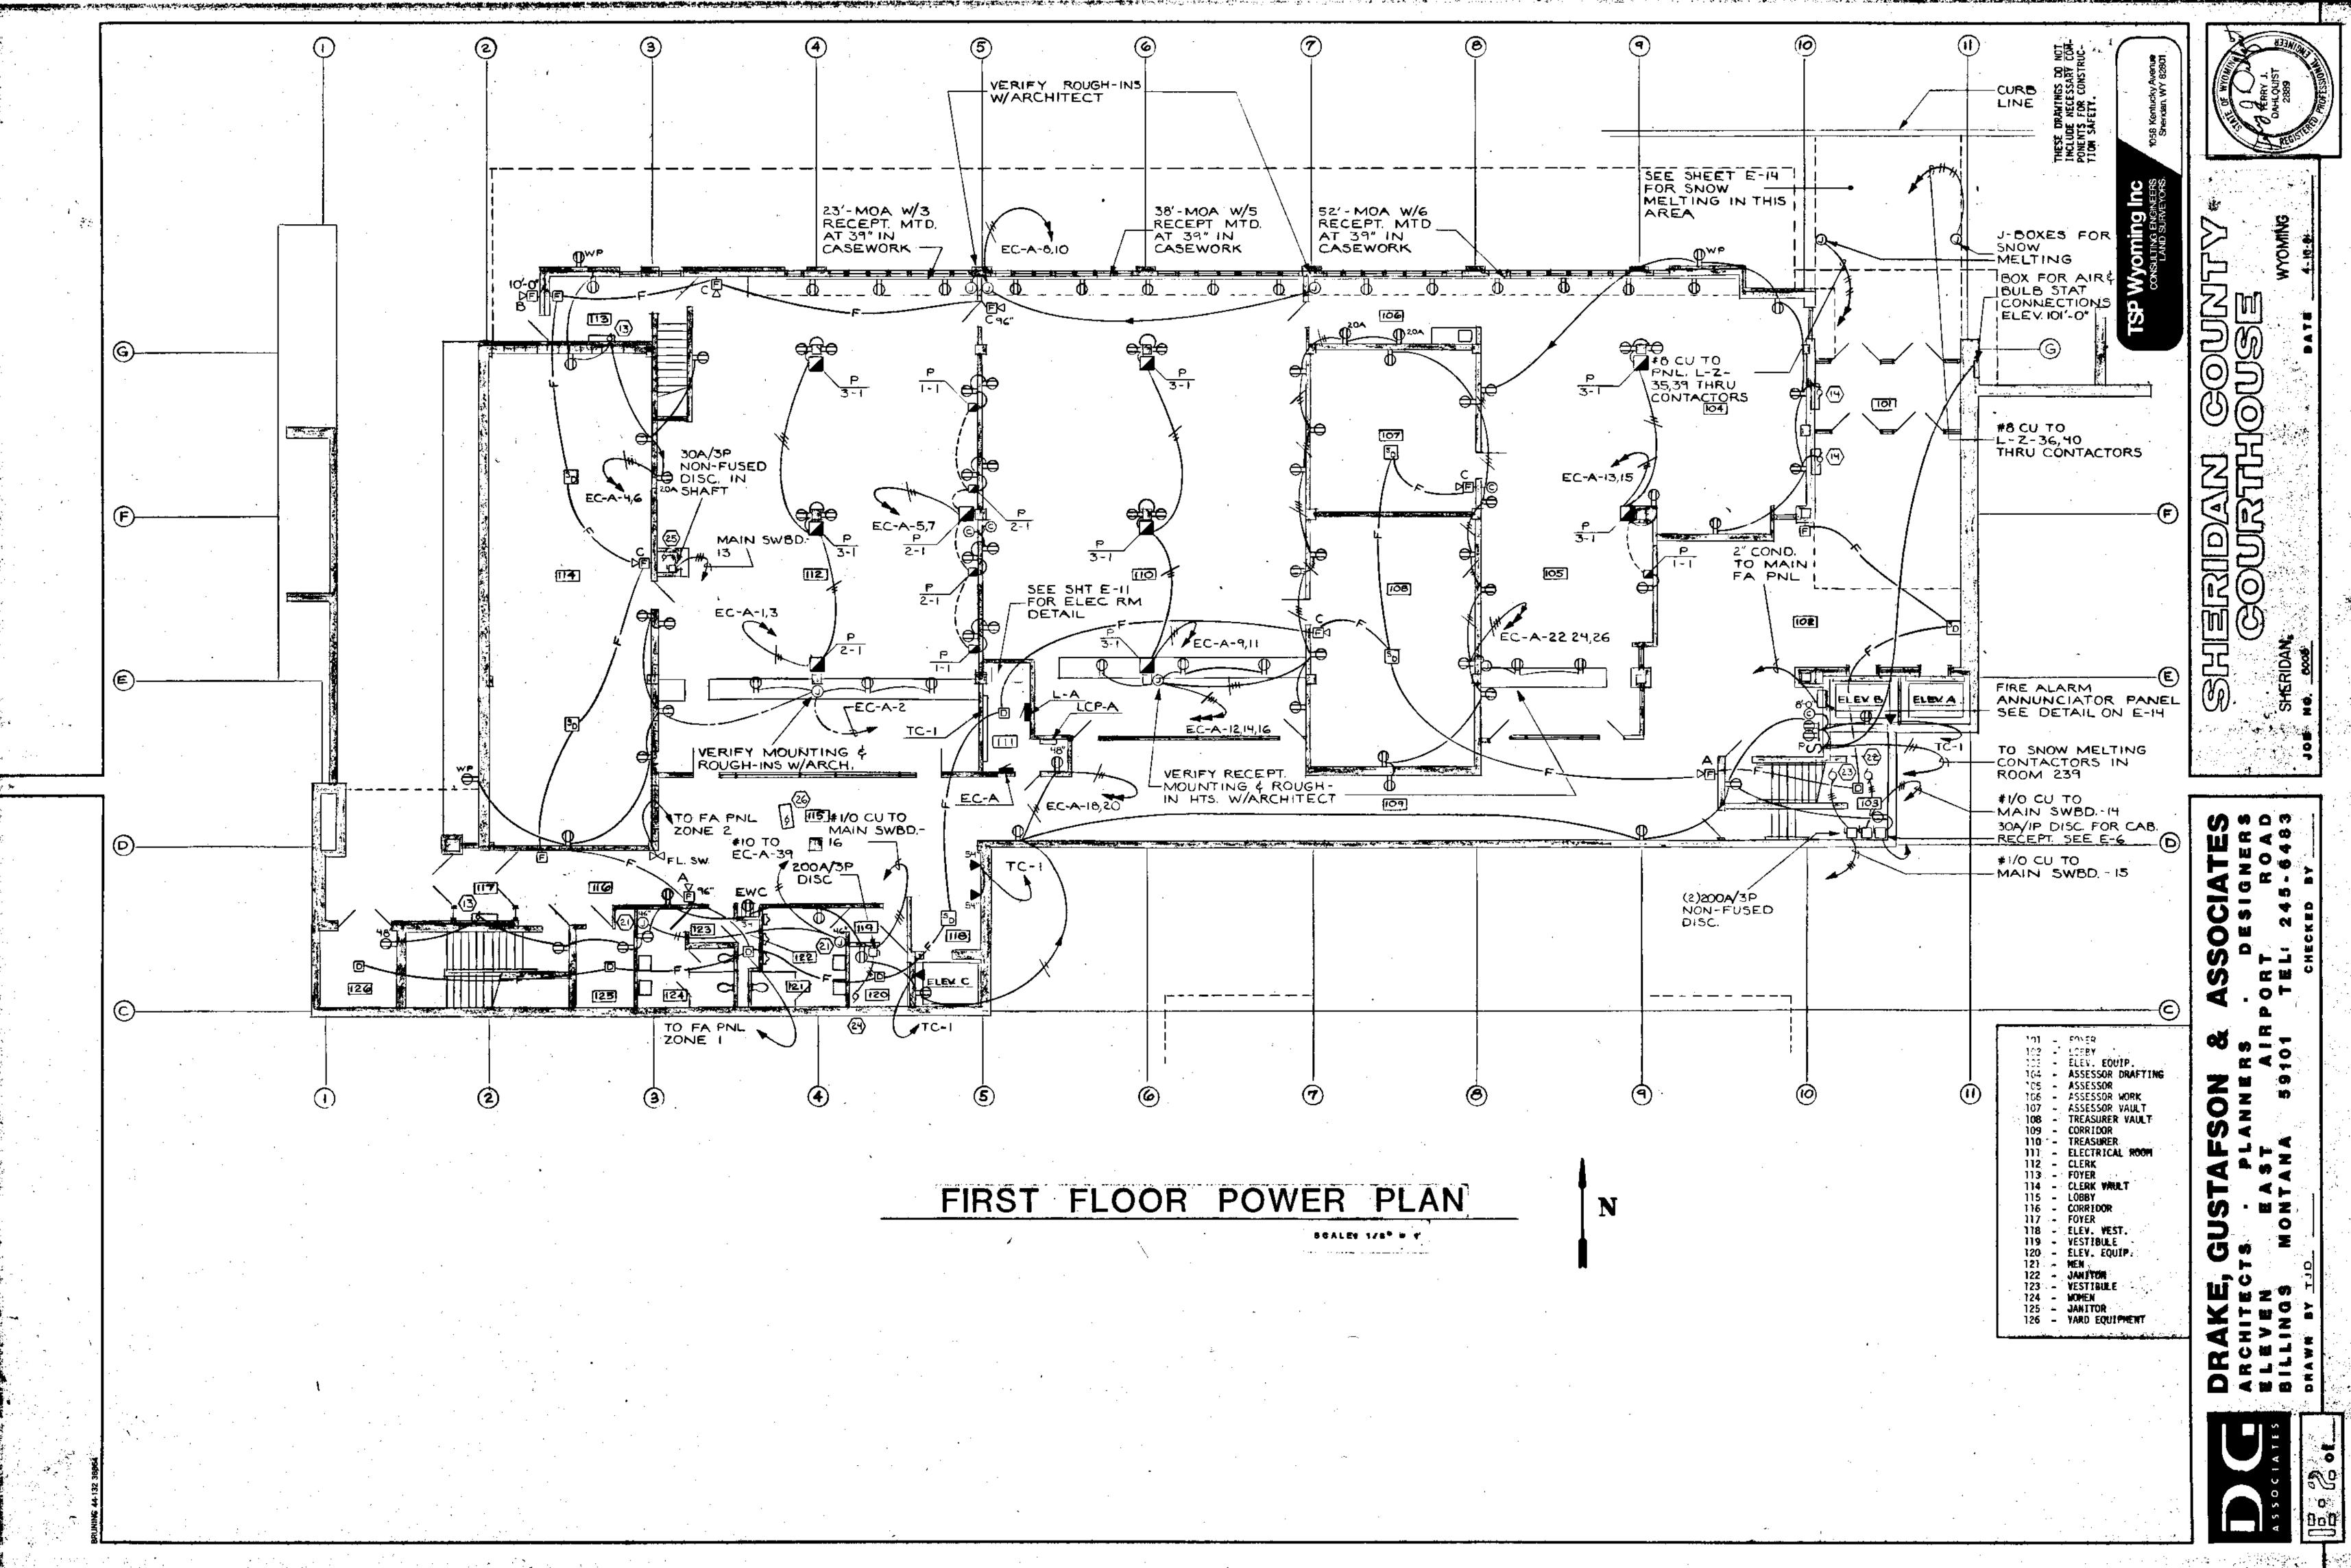


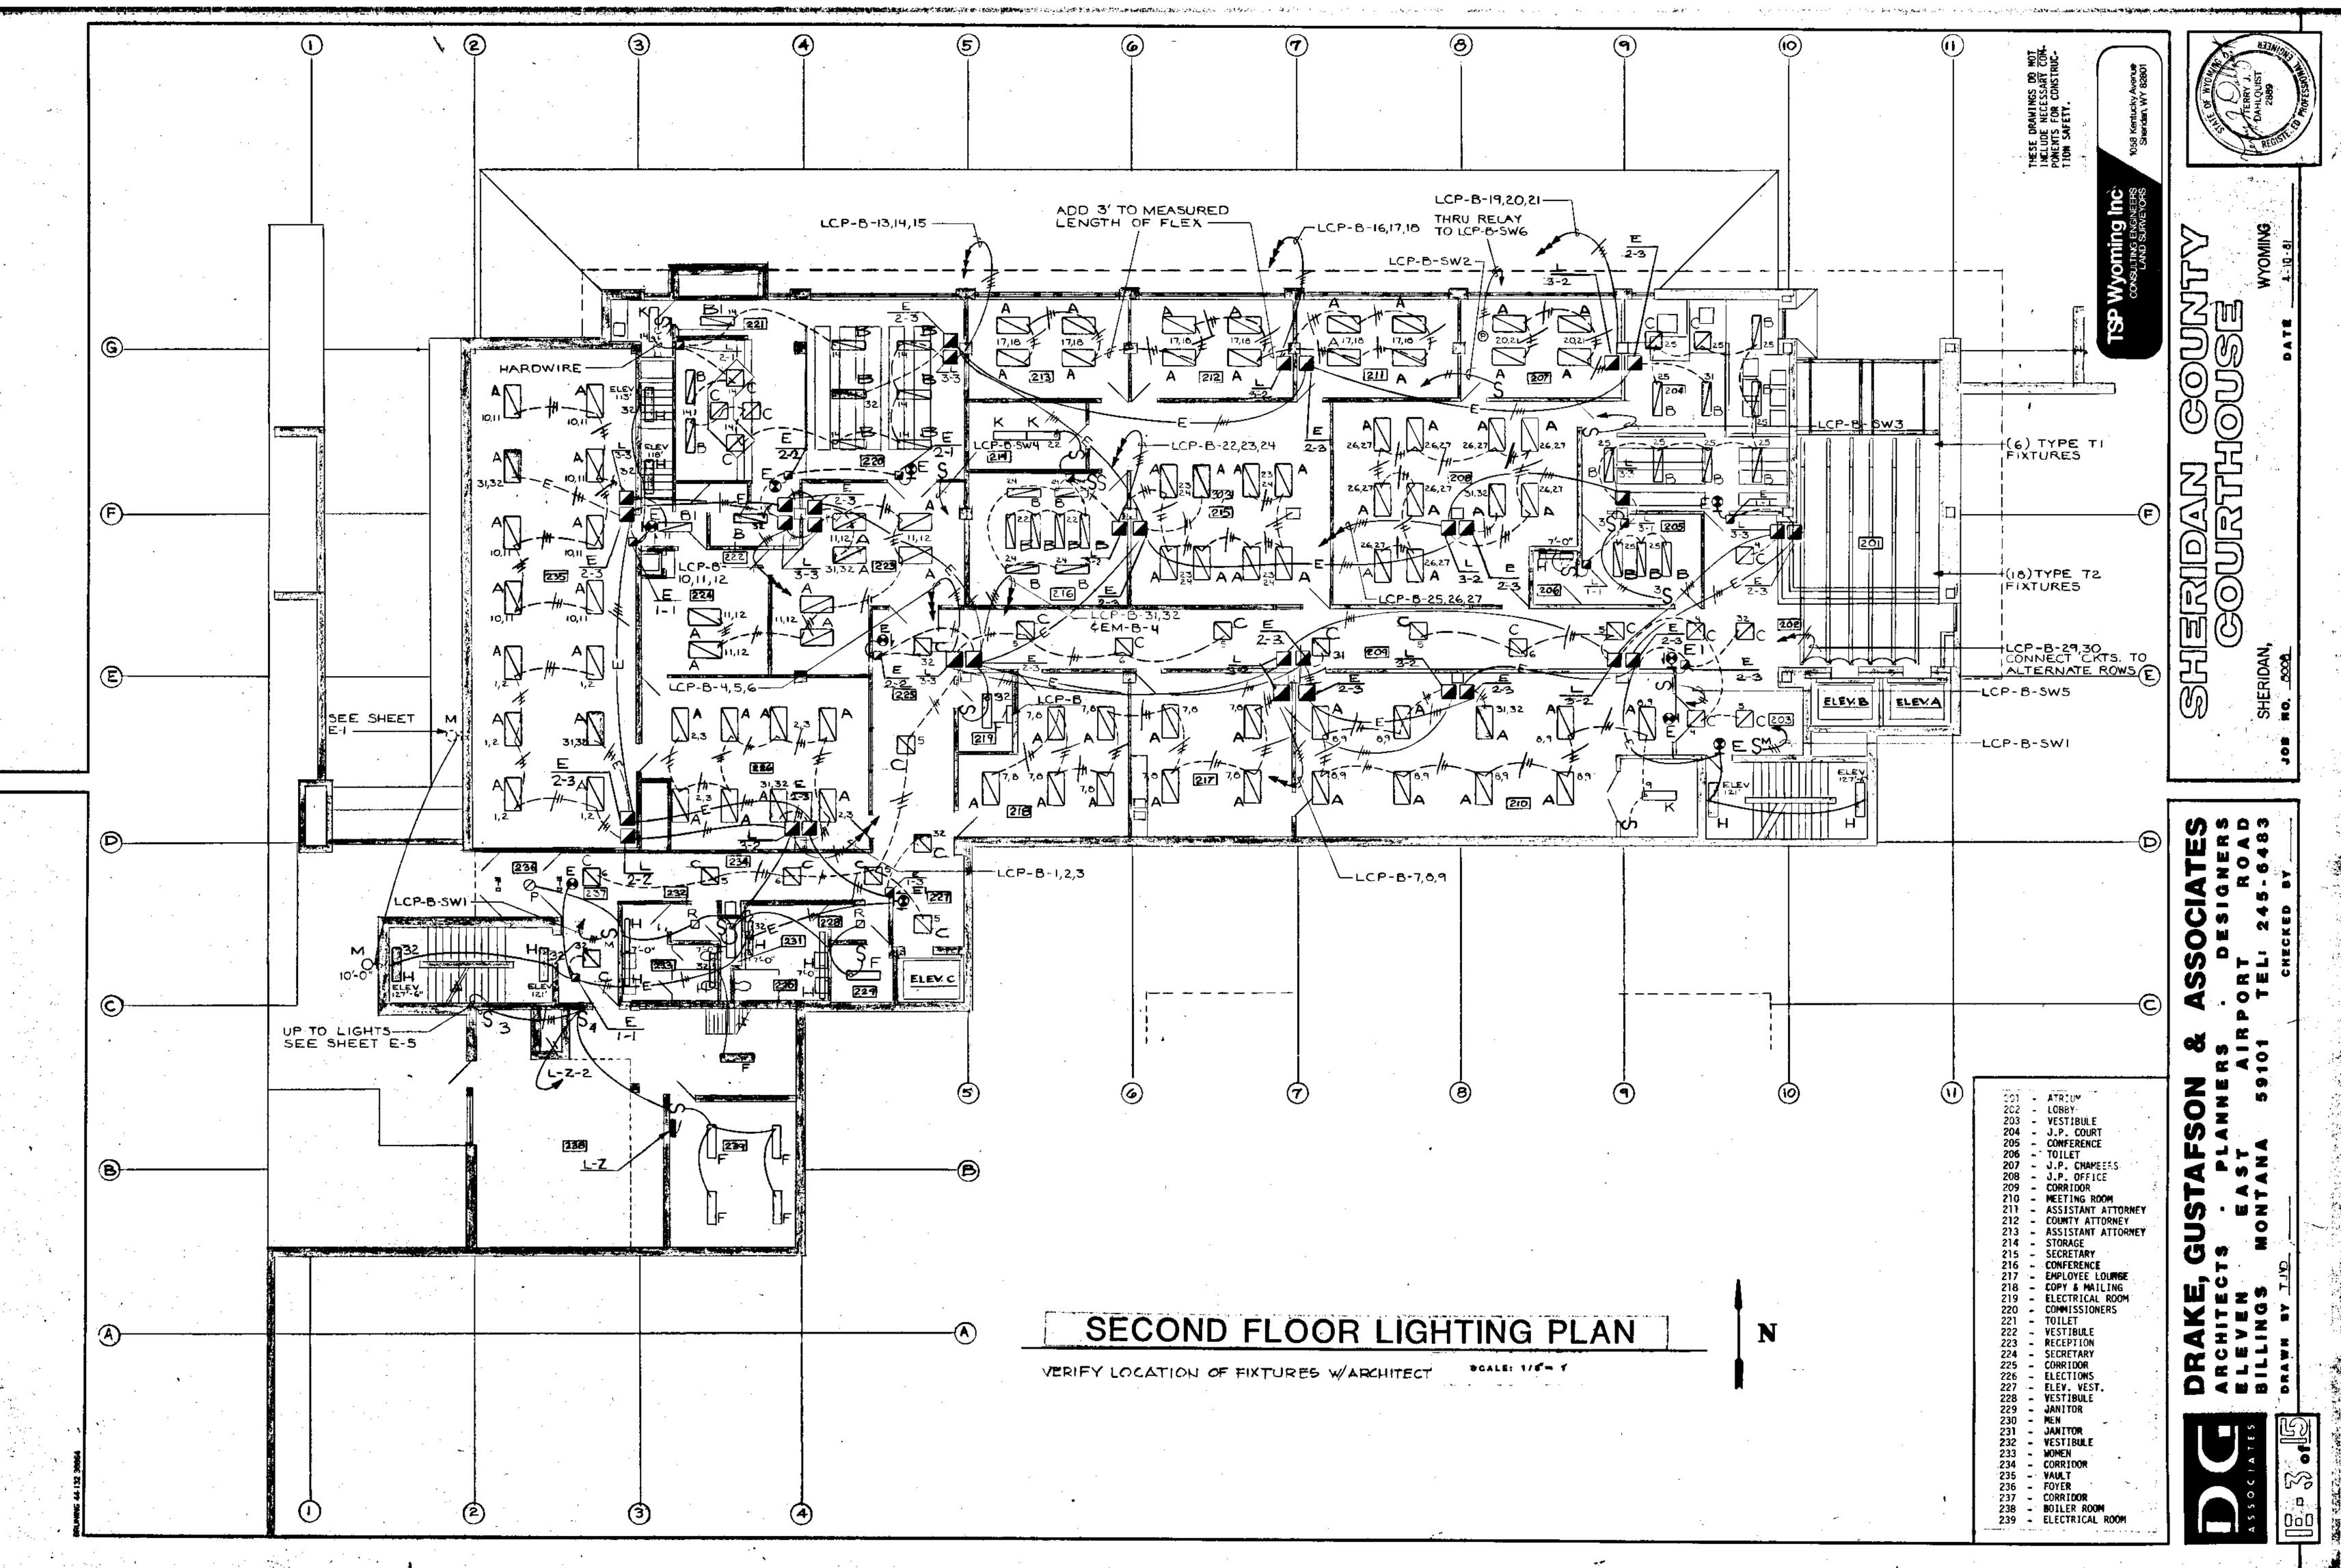


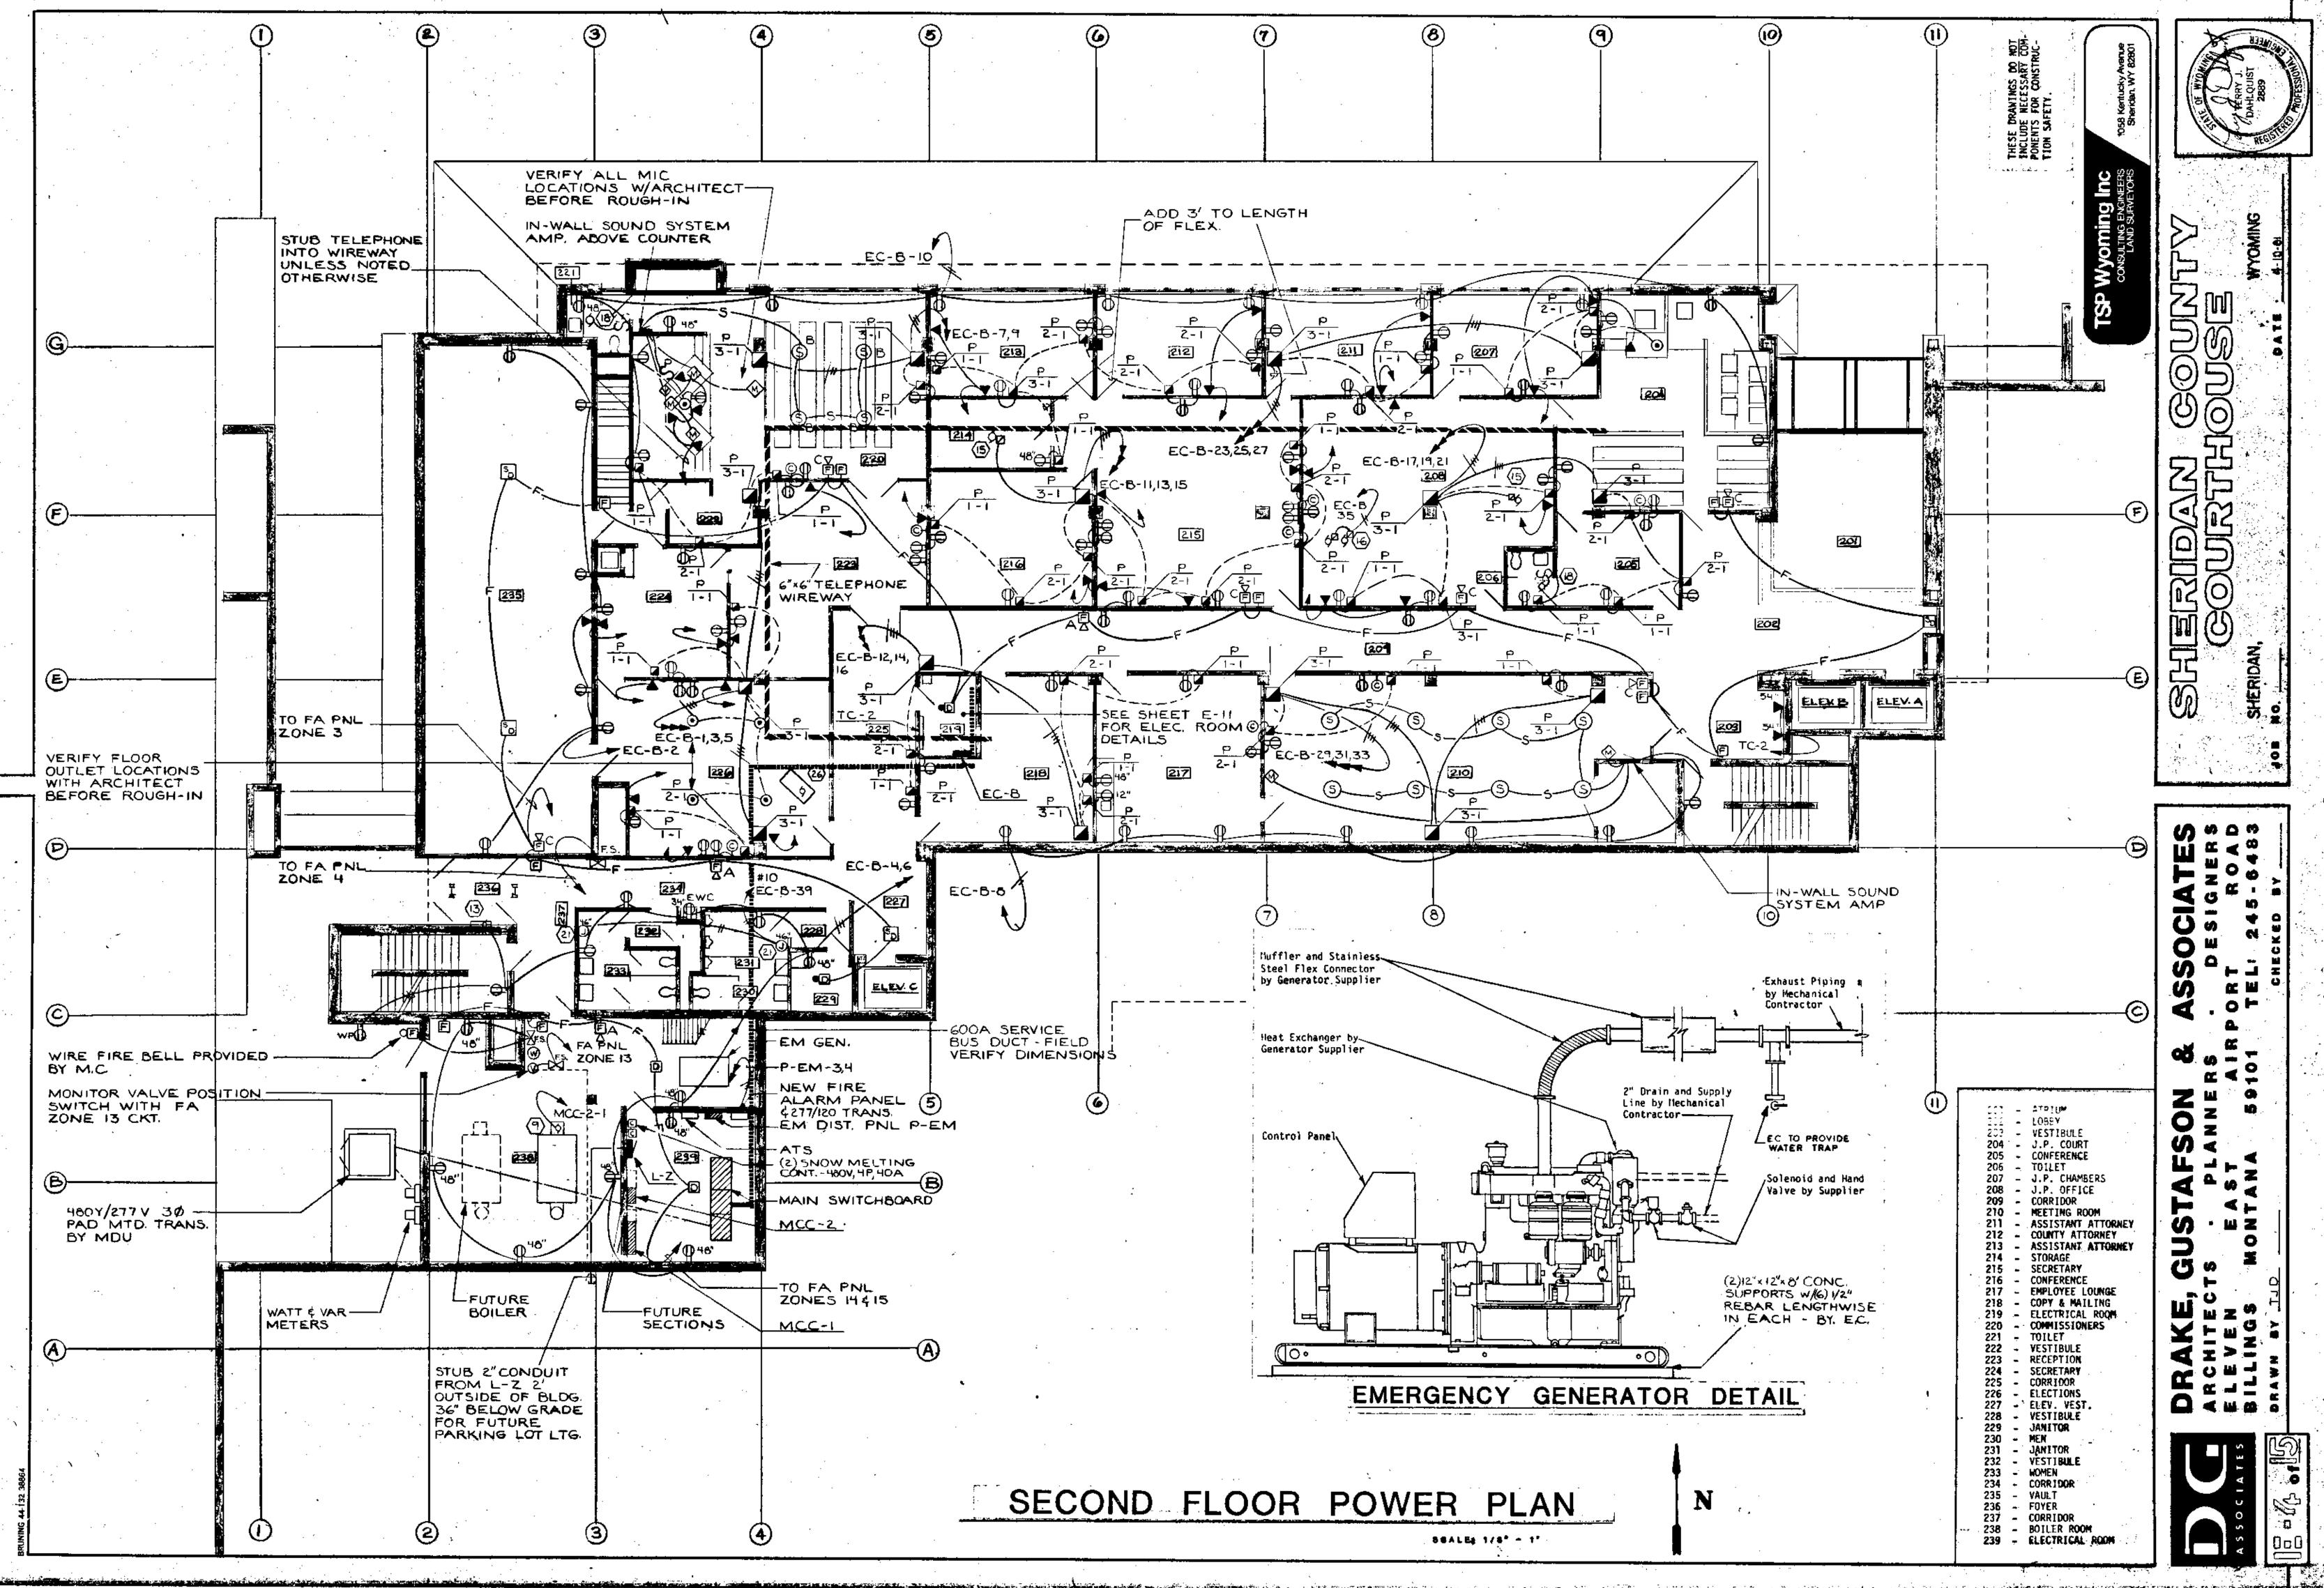

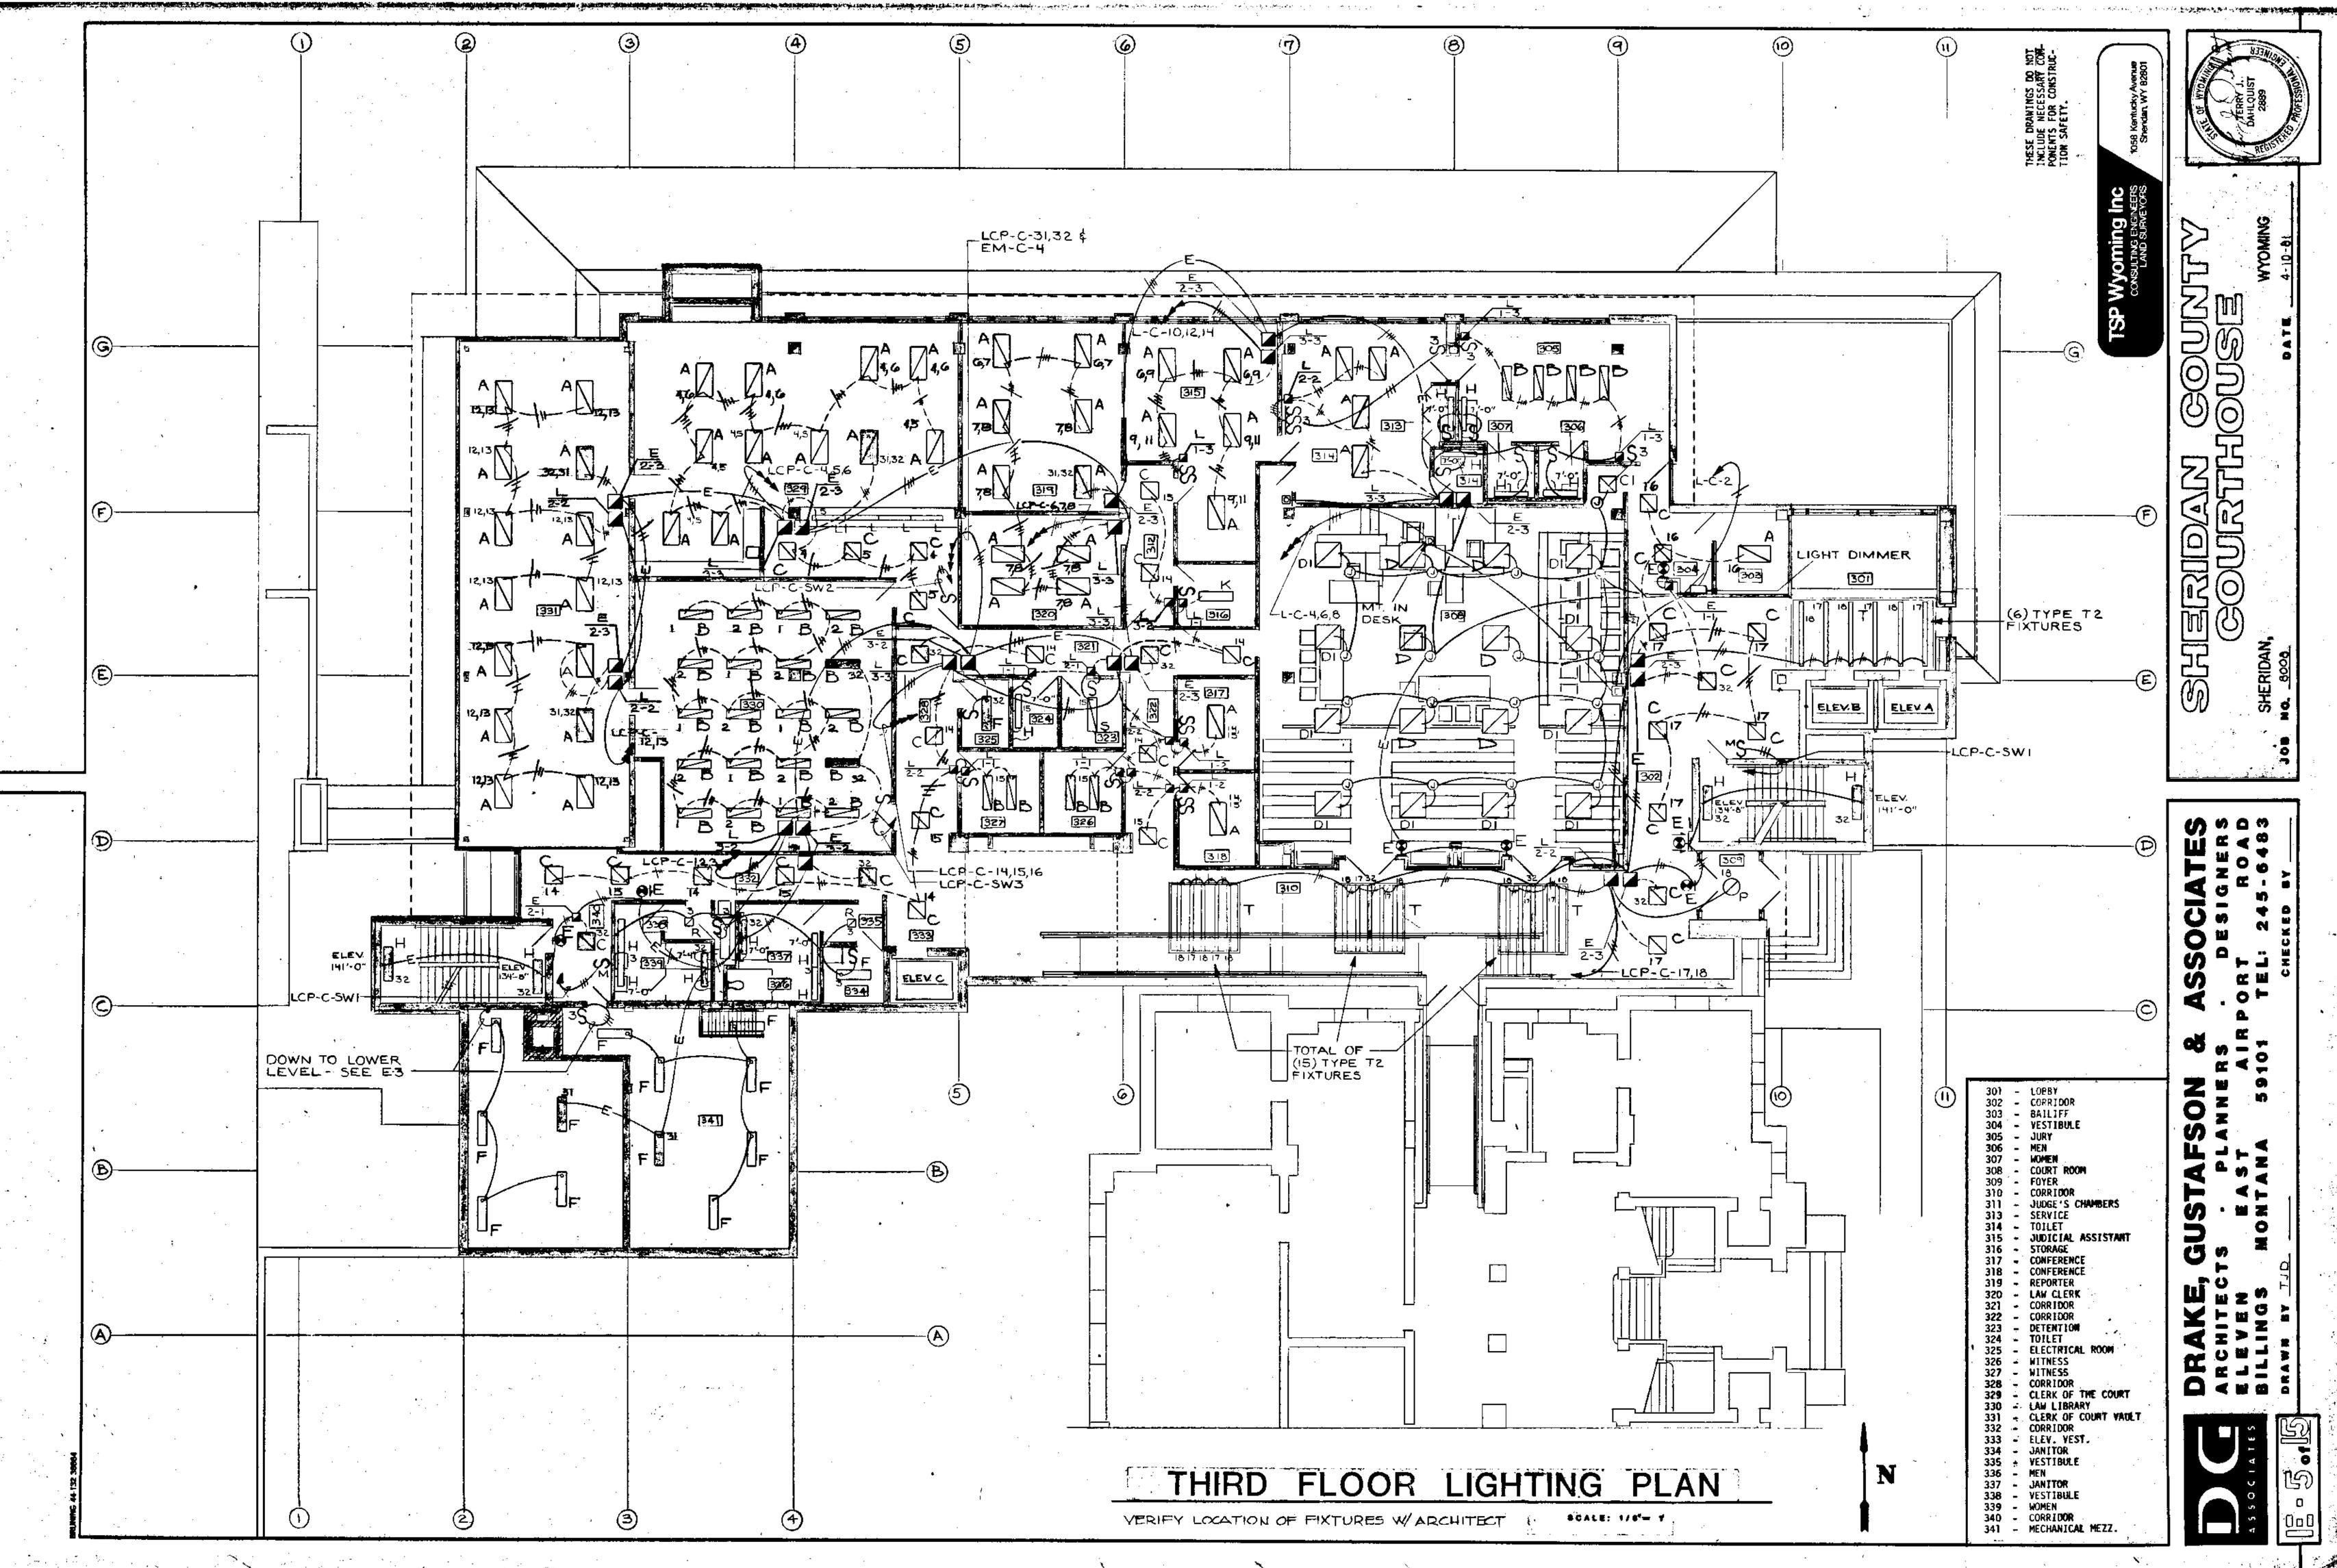

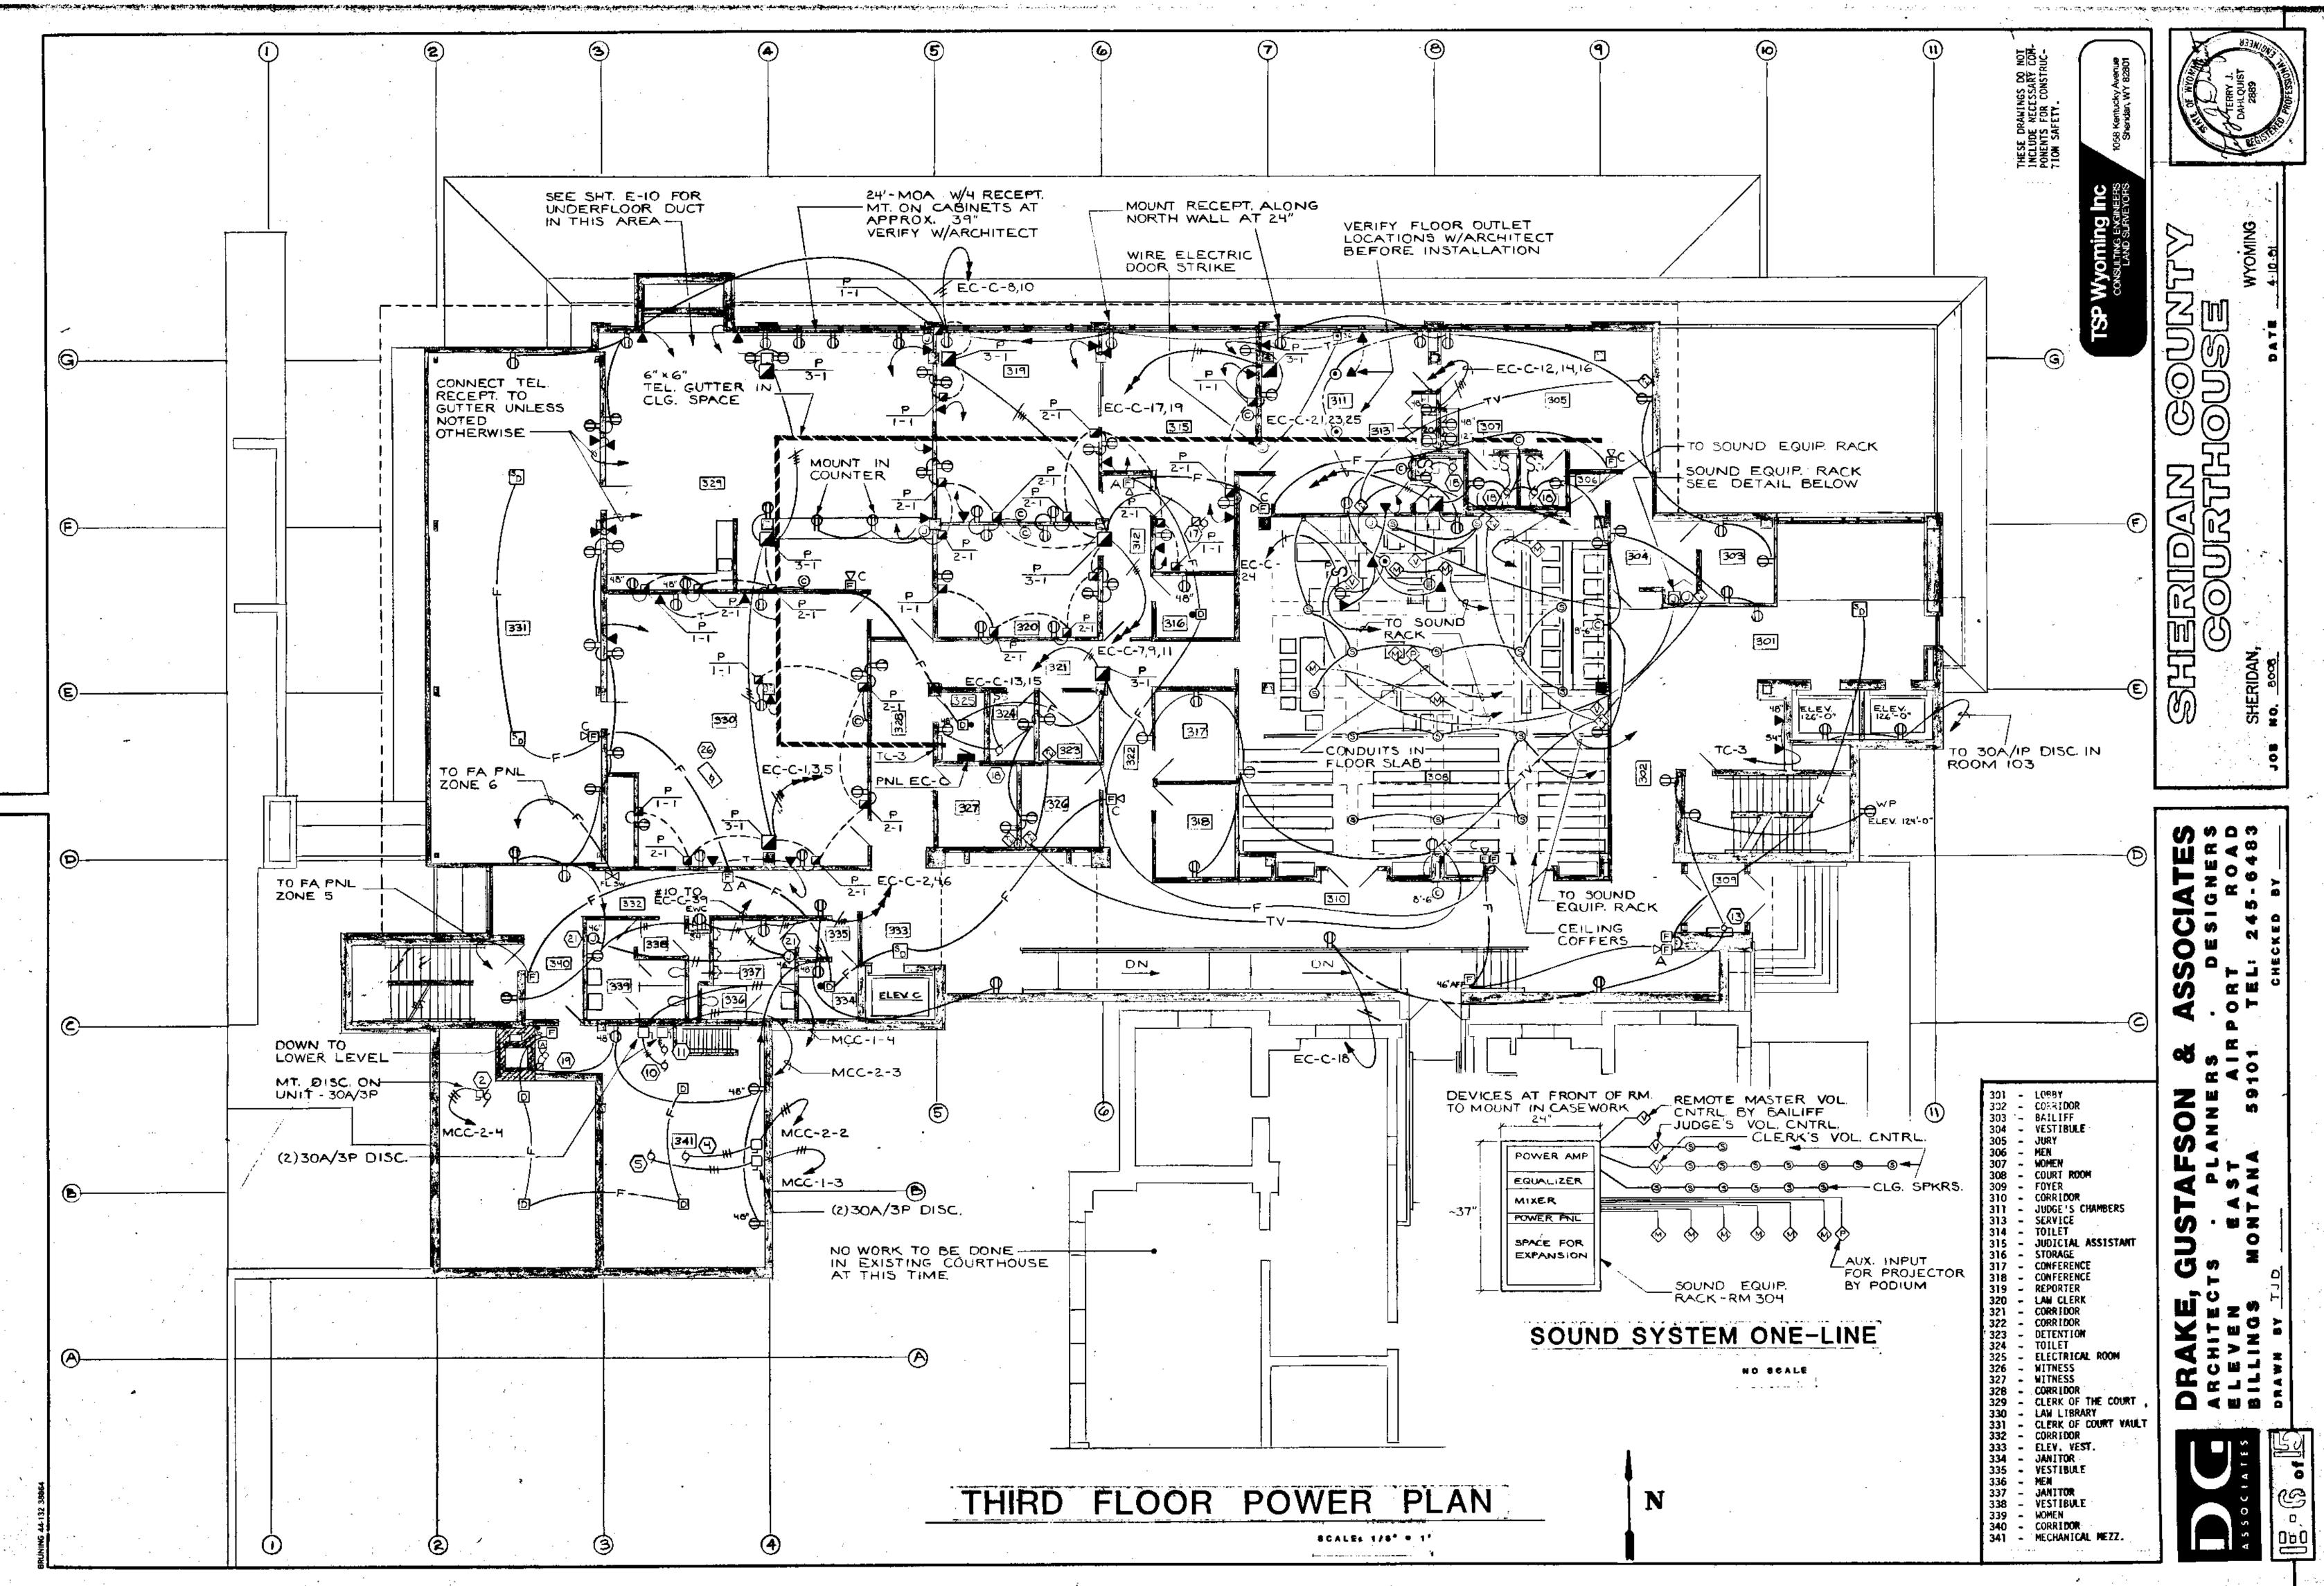


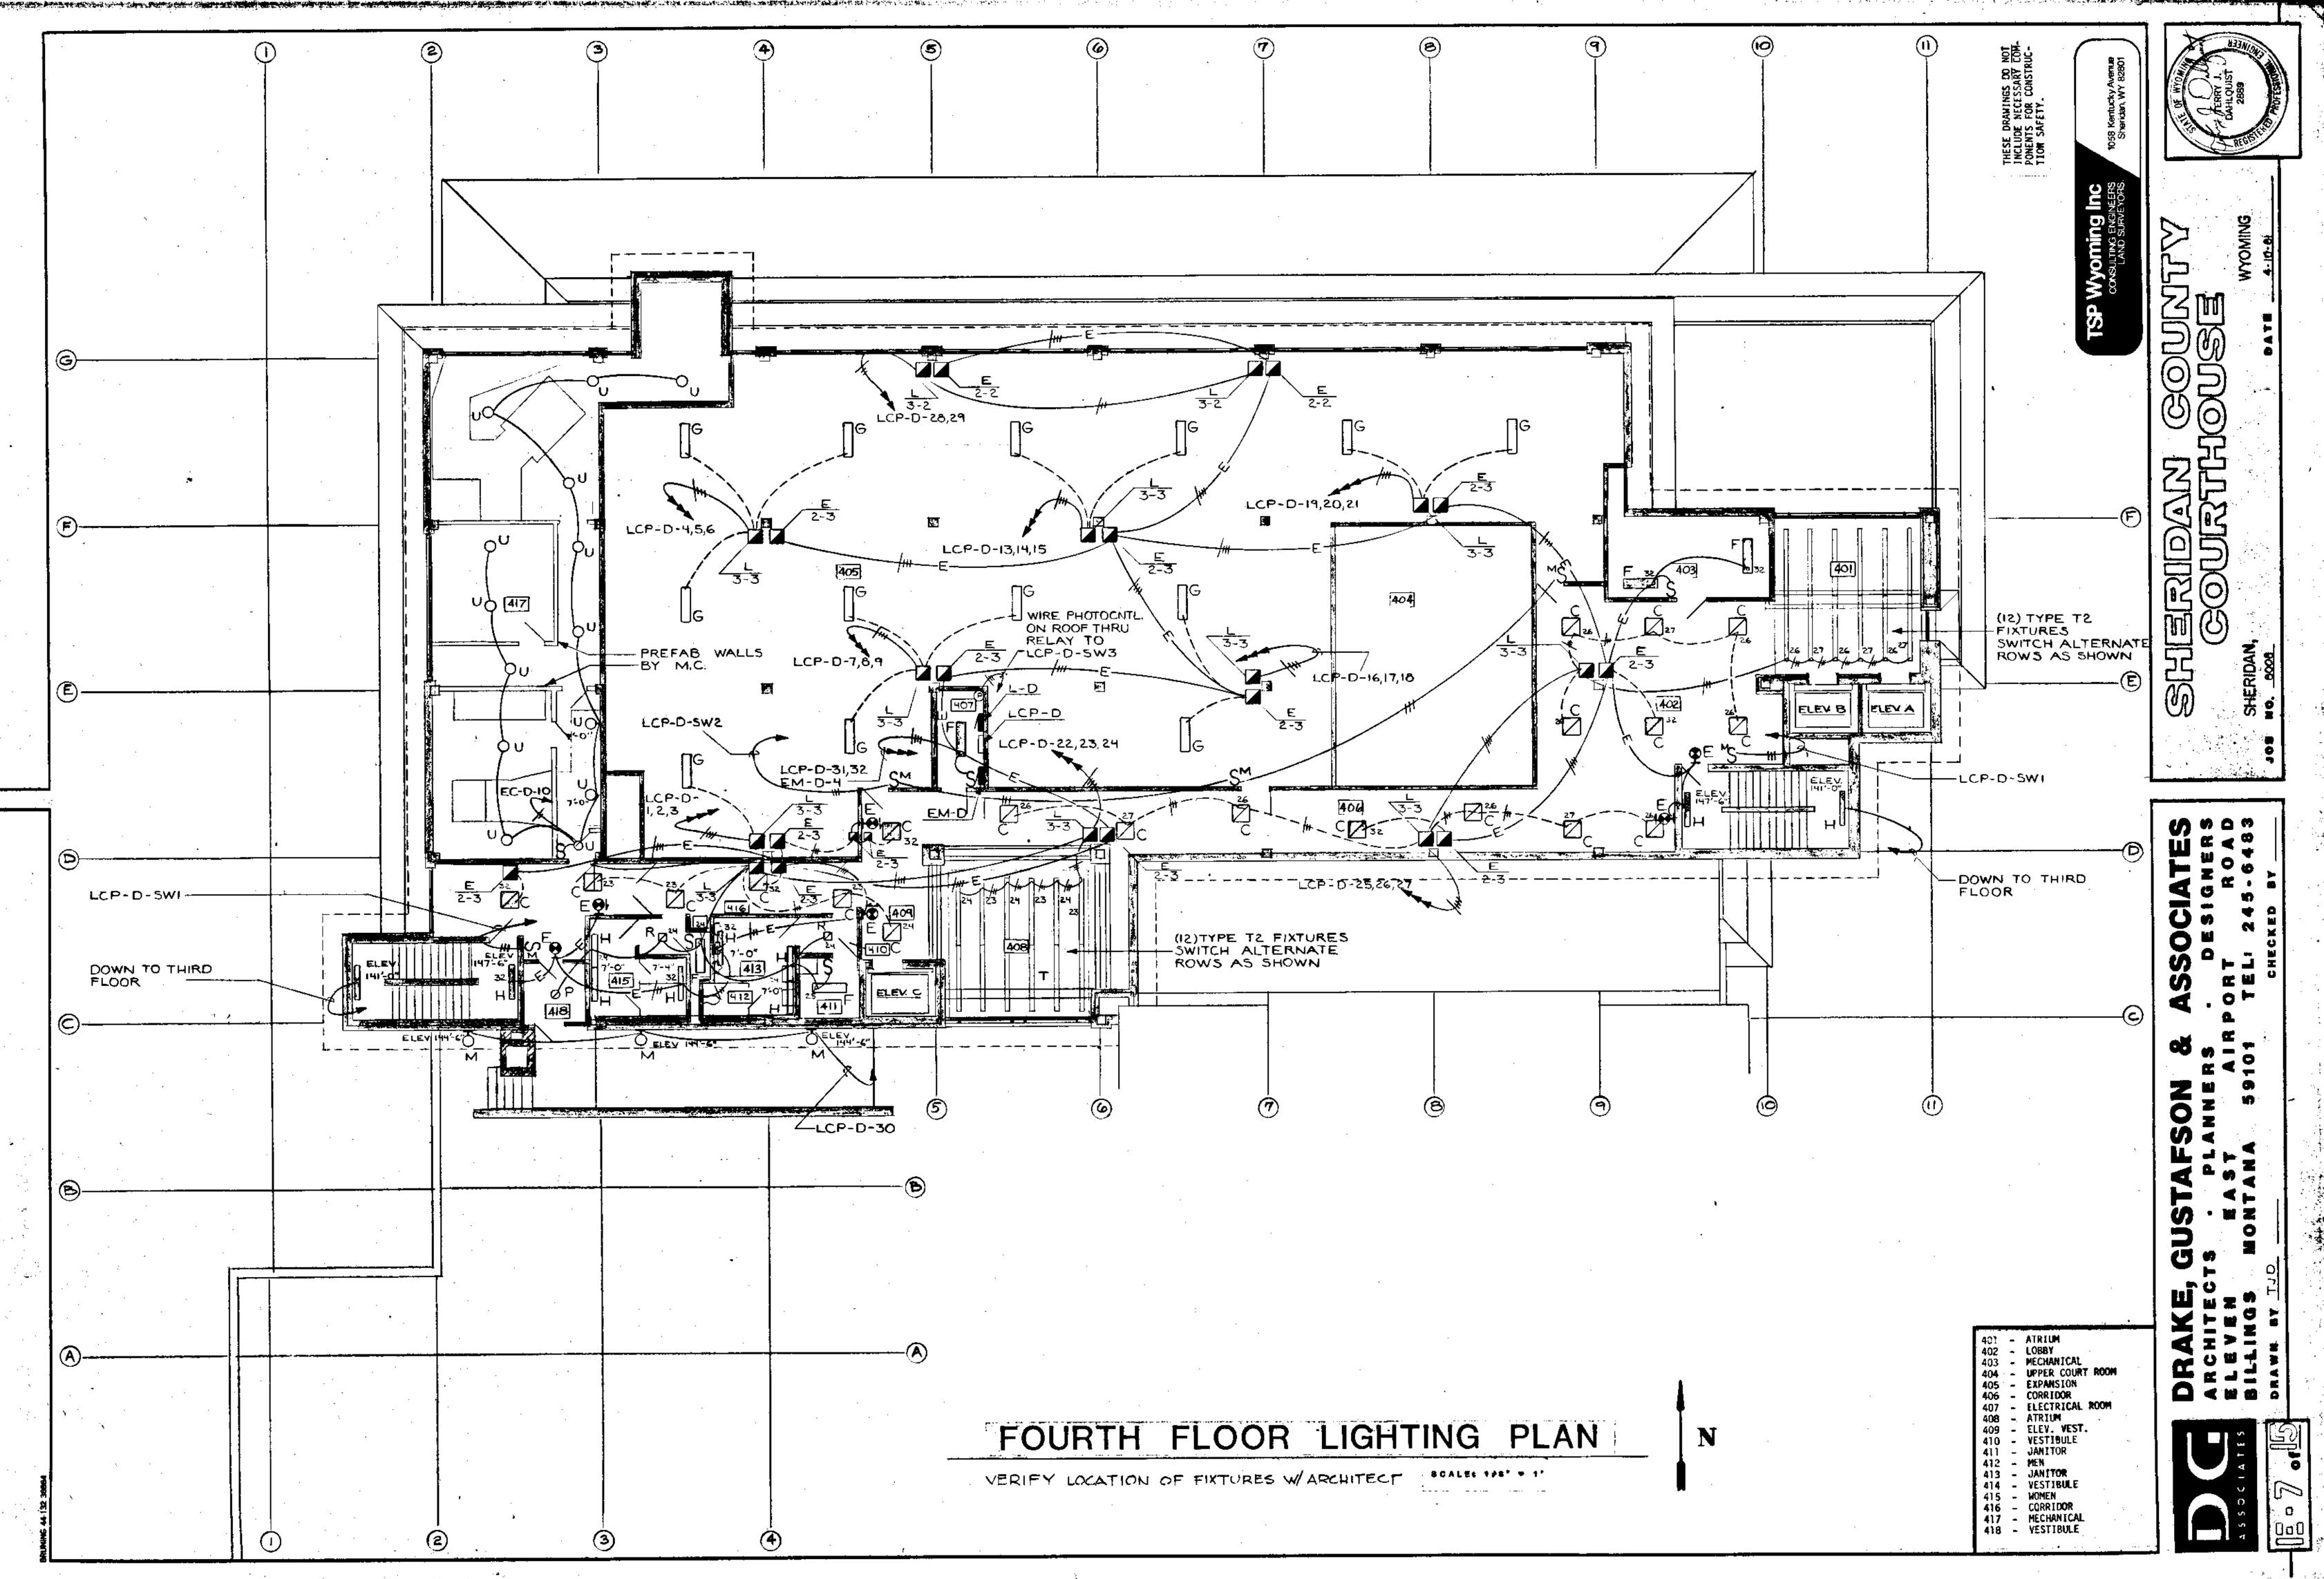


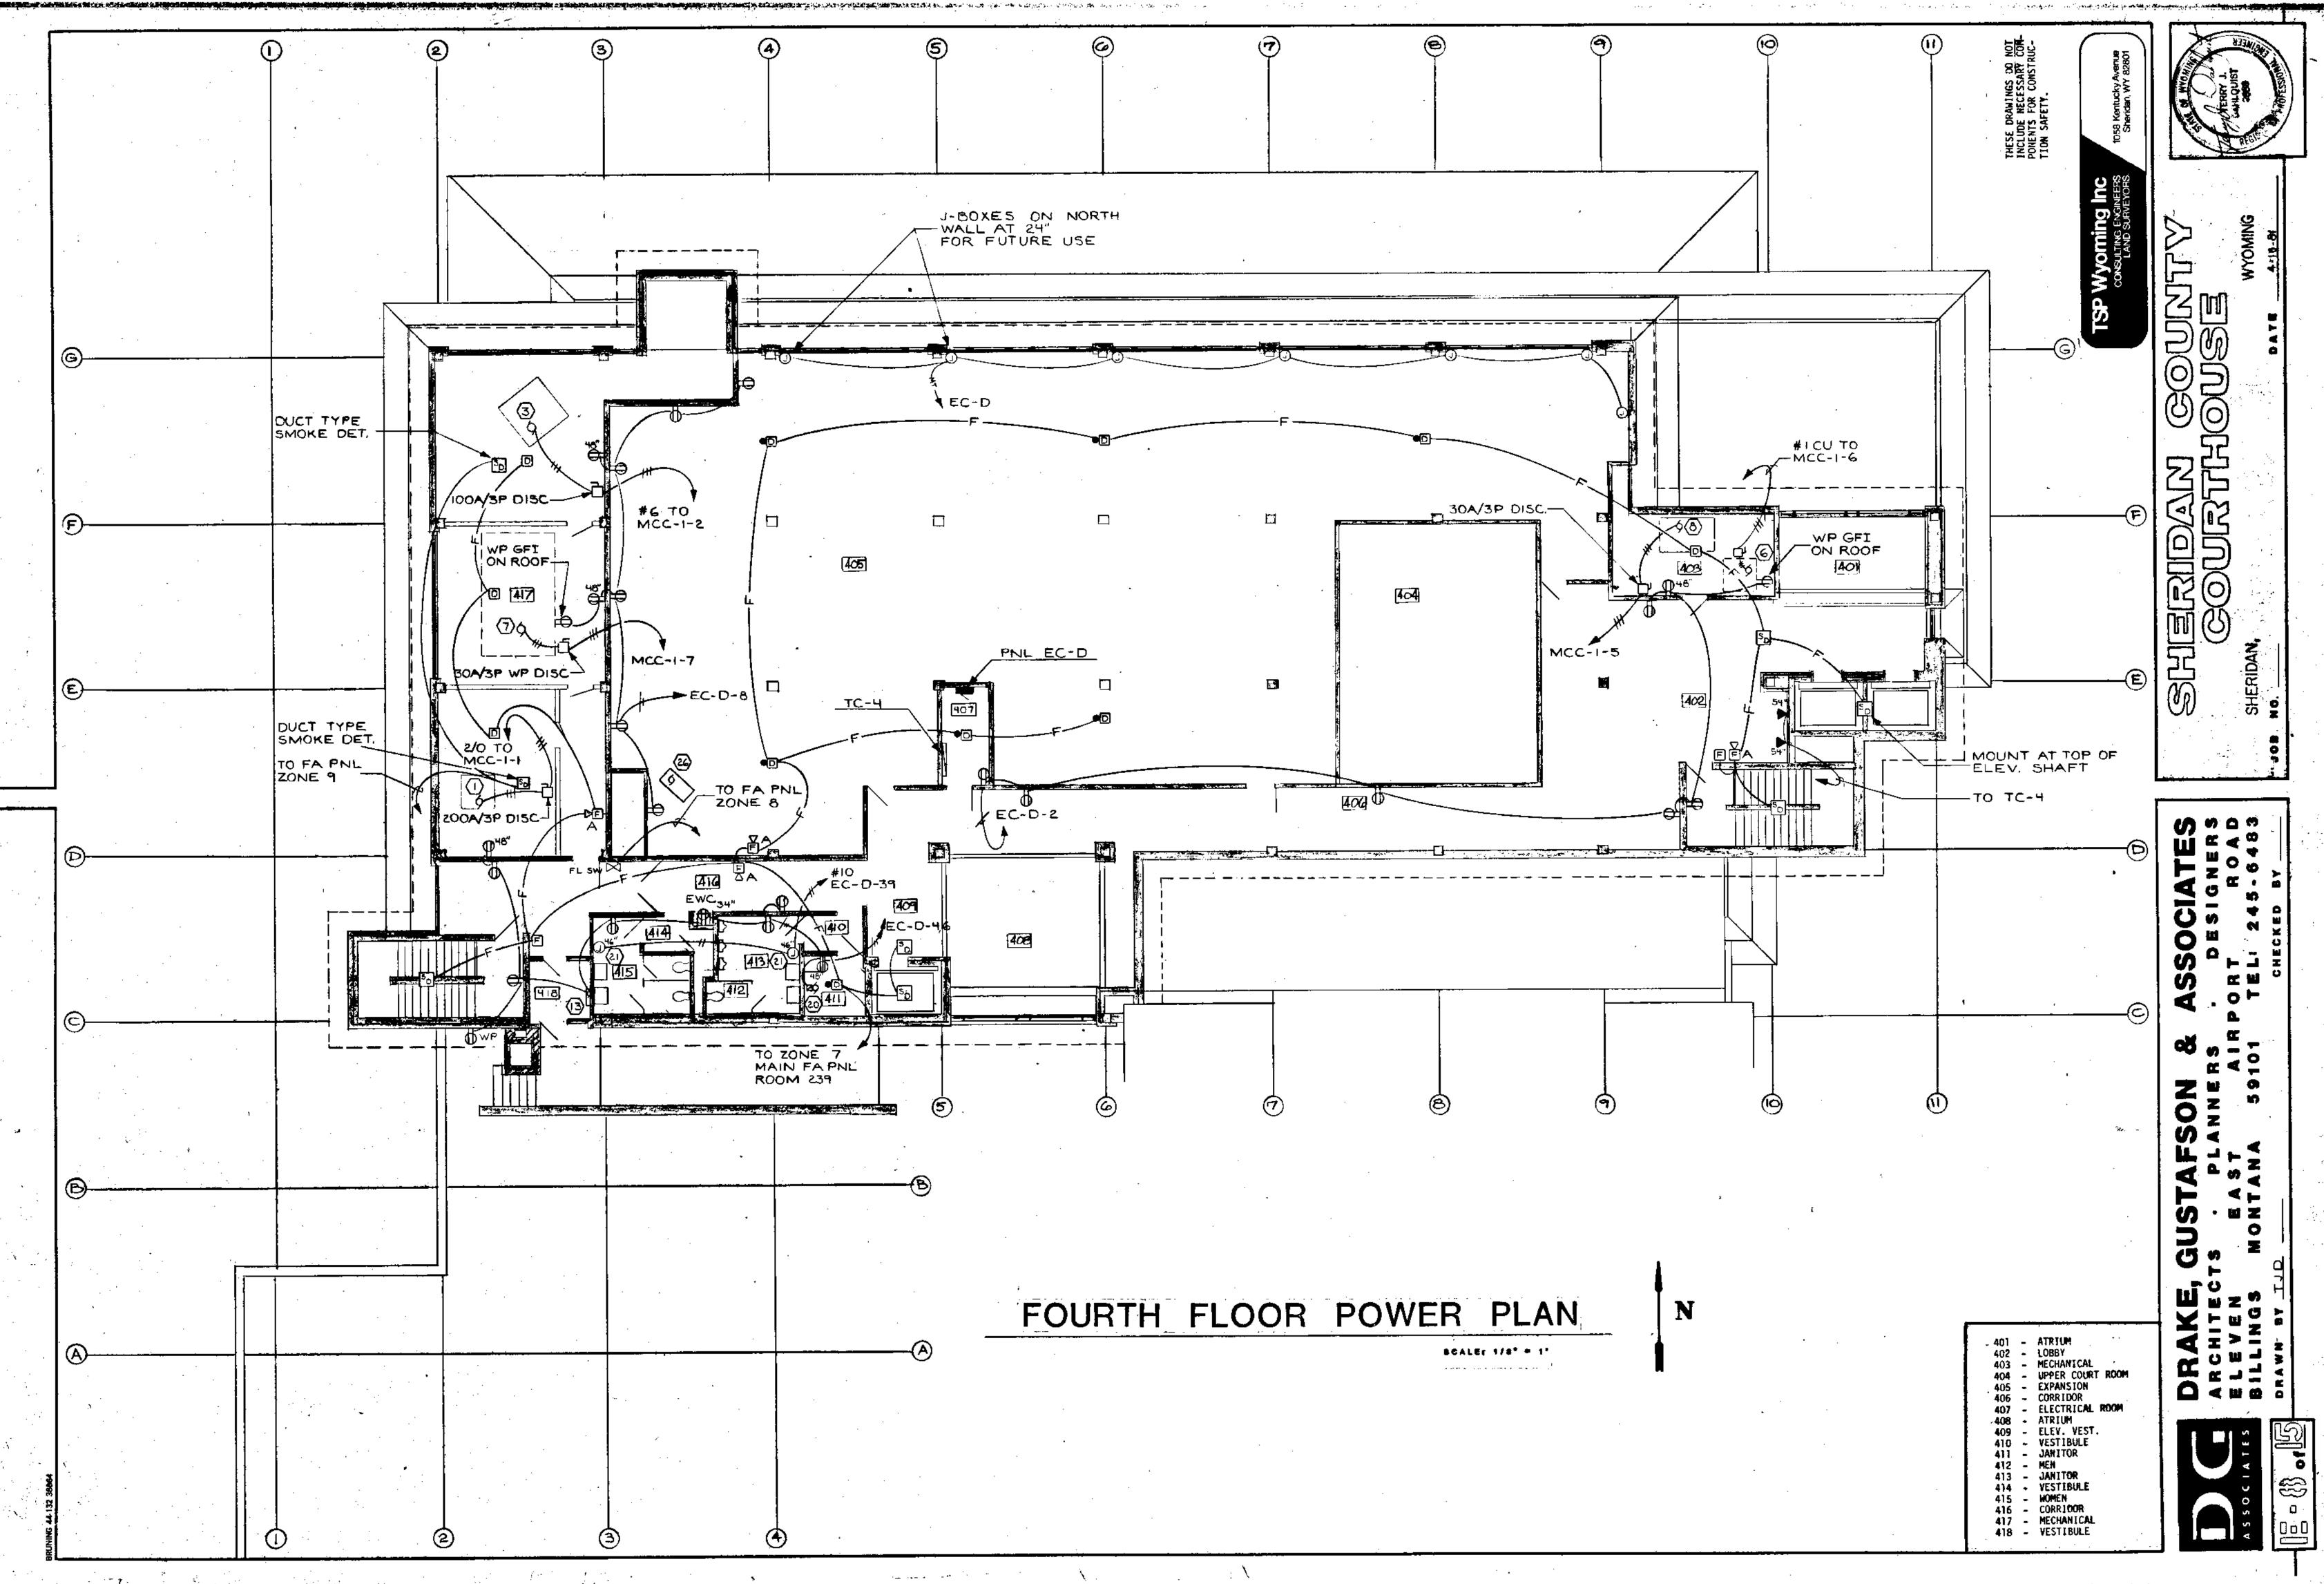


| 97 - 2010 2010 2010 2010 | | | | A | 0 |
|---|---|--------|--|--|---------------------------------------|
| | | Ψ | උ | Y | Y |
| X | | | | | |
| | | | | | |
| | | | | | |
| | | | | | F |
| | | | | | |
| | | | | 5' | |
| | | | | | |
| | | | | | |
| | | | | | |
| | | | | | . 4 |
| San La Harana Marina Marina | | | | | · · |
| • | | | | | 1 |
| | 6 | | | | · · · · · · · · · · · · · · · · · · · |
| • | | | | | <u></u> |
| | | | | | |
| n : | | | | | <u> </u> |
| | | | | | |
| | | | | | |
| | | | | | · · · · · · · · · · · · · · · · · · · |
| | Ē | | | | L . |
| | | | TYPICAL | | |
| | | | | 6 | |
| 1 | | | TYPICAL DUCT SPACING OFF OF COLUMNS | | <u> </u> |
| | | | | G | |
| - | | | | | |
| | | | | | |
| · | E | | | → ×····· □] | |
| | | | | • | |
| | | | | | PANE |
| | | | | andra an an tha an | |
| 1 1 1 1 1 1 1 1 1 1 1 1 1 1 1 1 1 1 1 | | | | | * |
| · · · · · · · · · · · · · · · · · · · | | | al an an an a' All an Antara an Anna. An Anna an Anna | | |
| | | | | | • |
| | 0 | | | | " <u>Ц</u> |
| | | | | | |
| | | | | | JT |
| •••• | | ┍╇╽╟╴ | | | ╠━━━┤ |
| | | | | | |
| | | | | | ╽┎╤┛┛╸╸╴ |
| | | | | | |
| | C | | | | |
| | | | | | |
| | | | | | |
| | | | | | |

S. 200 - 465

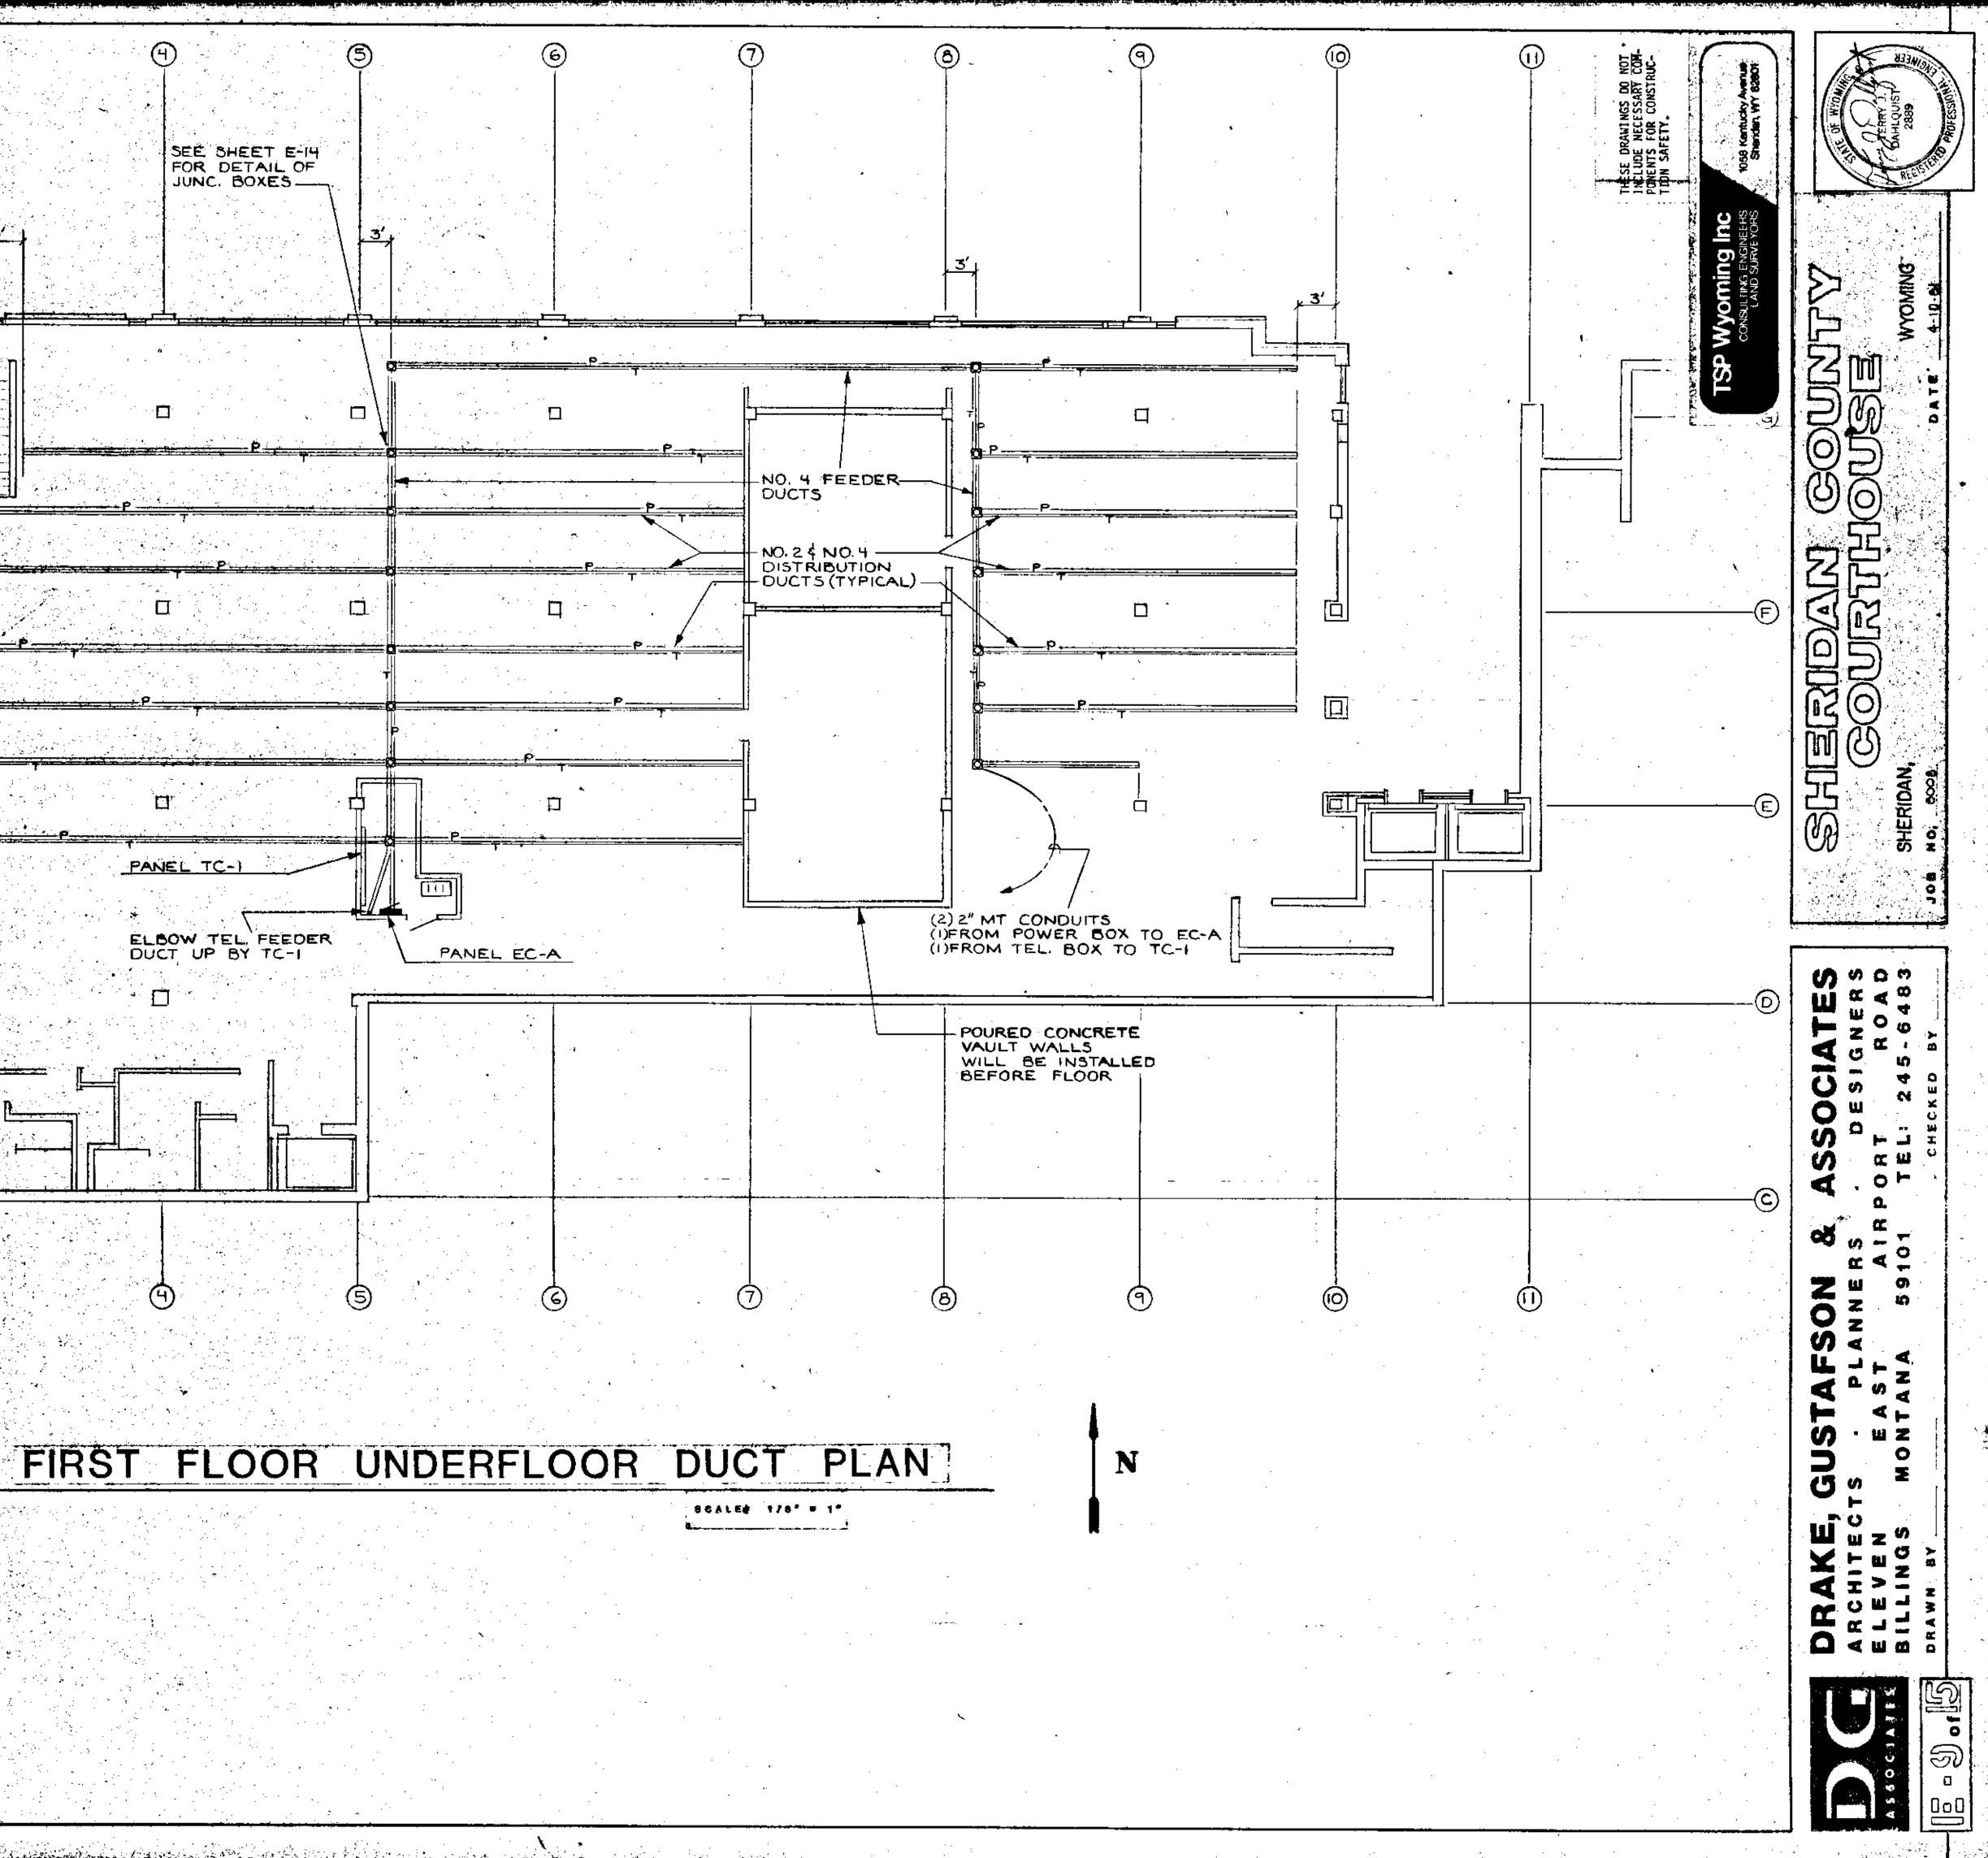

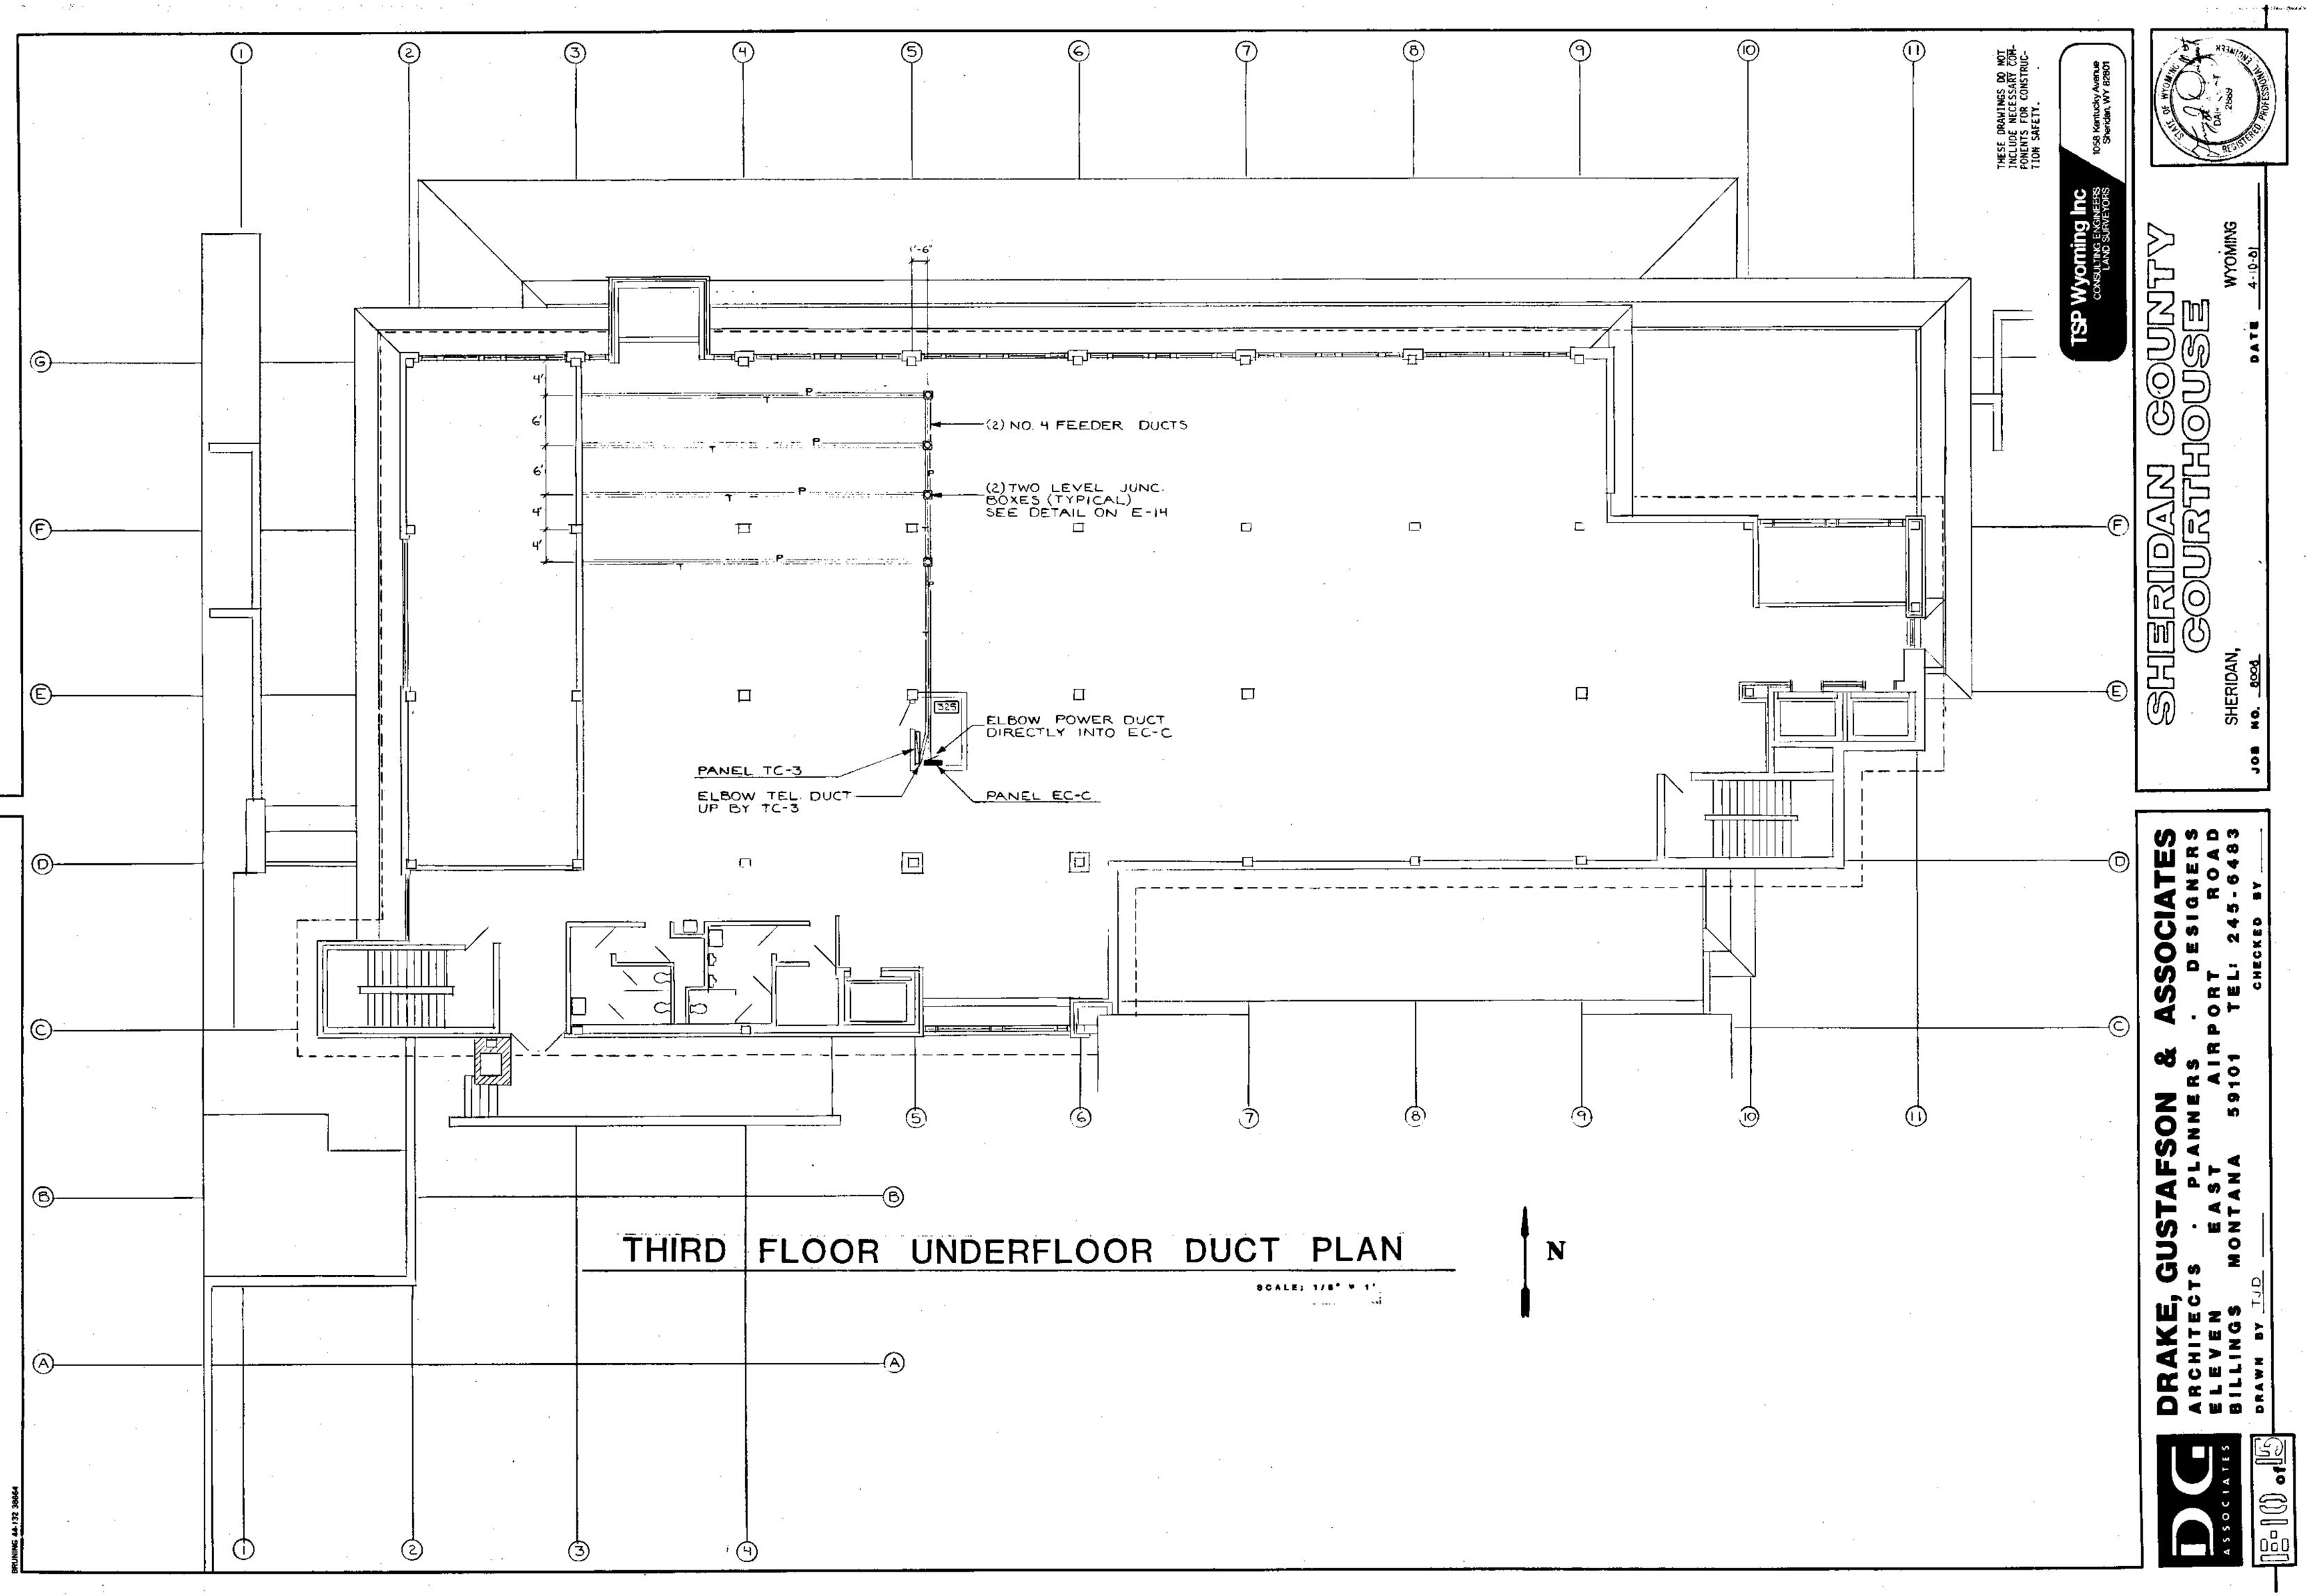

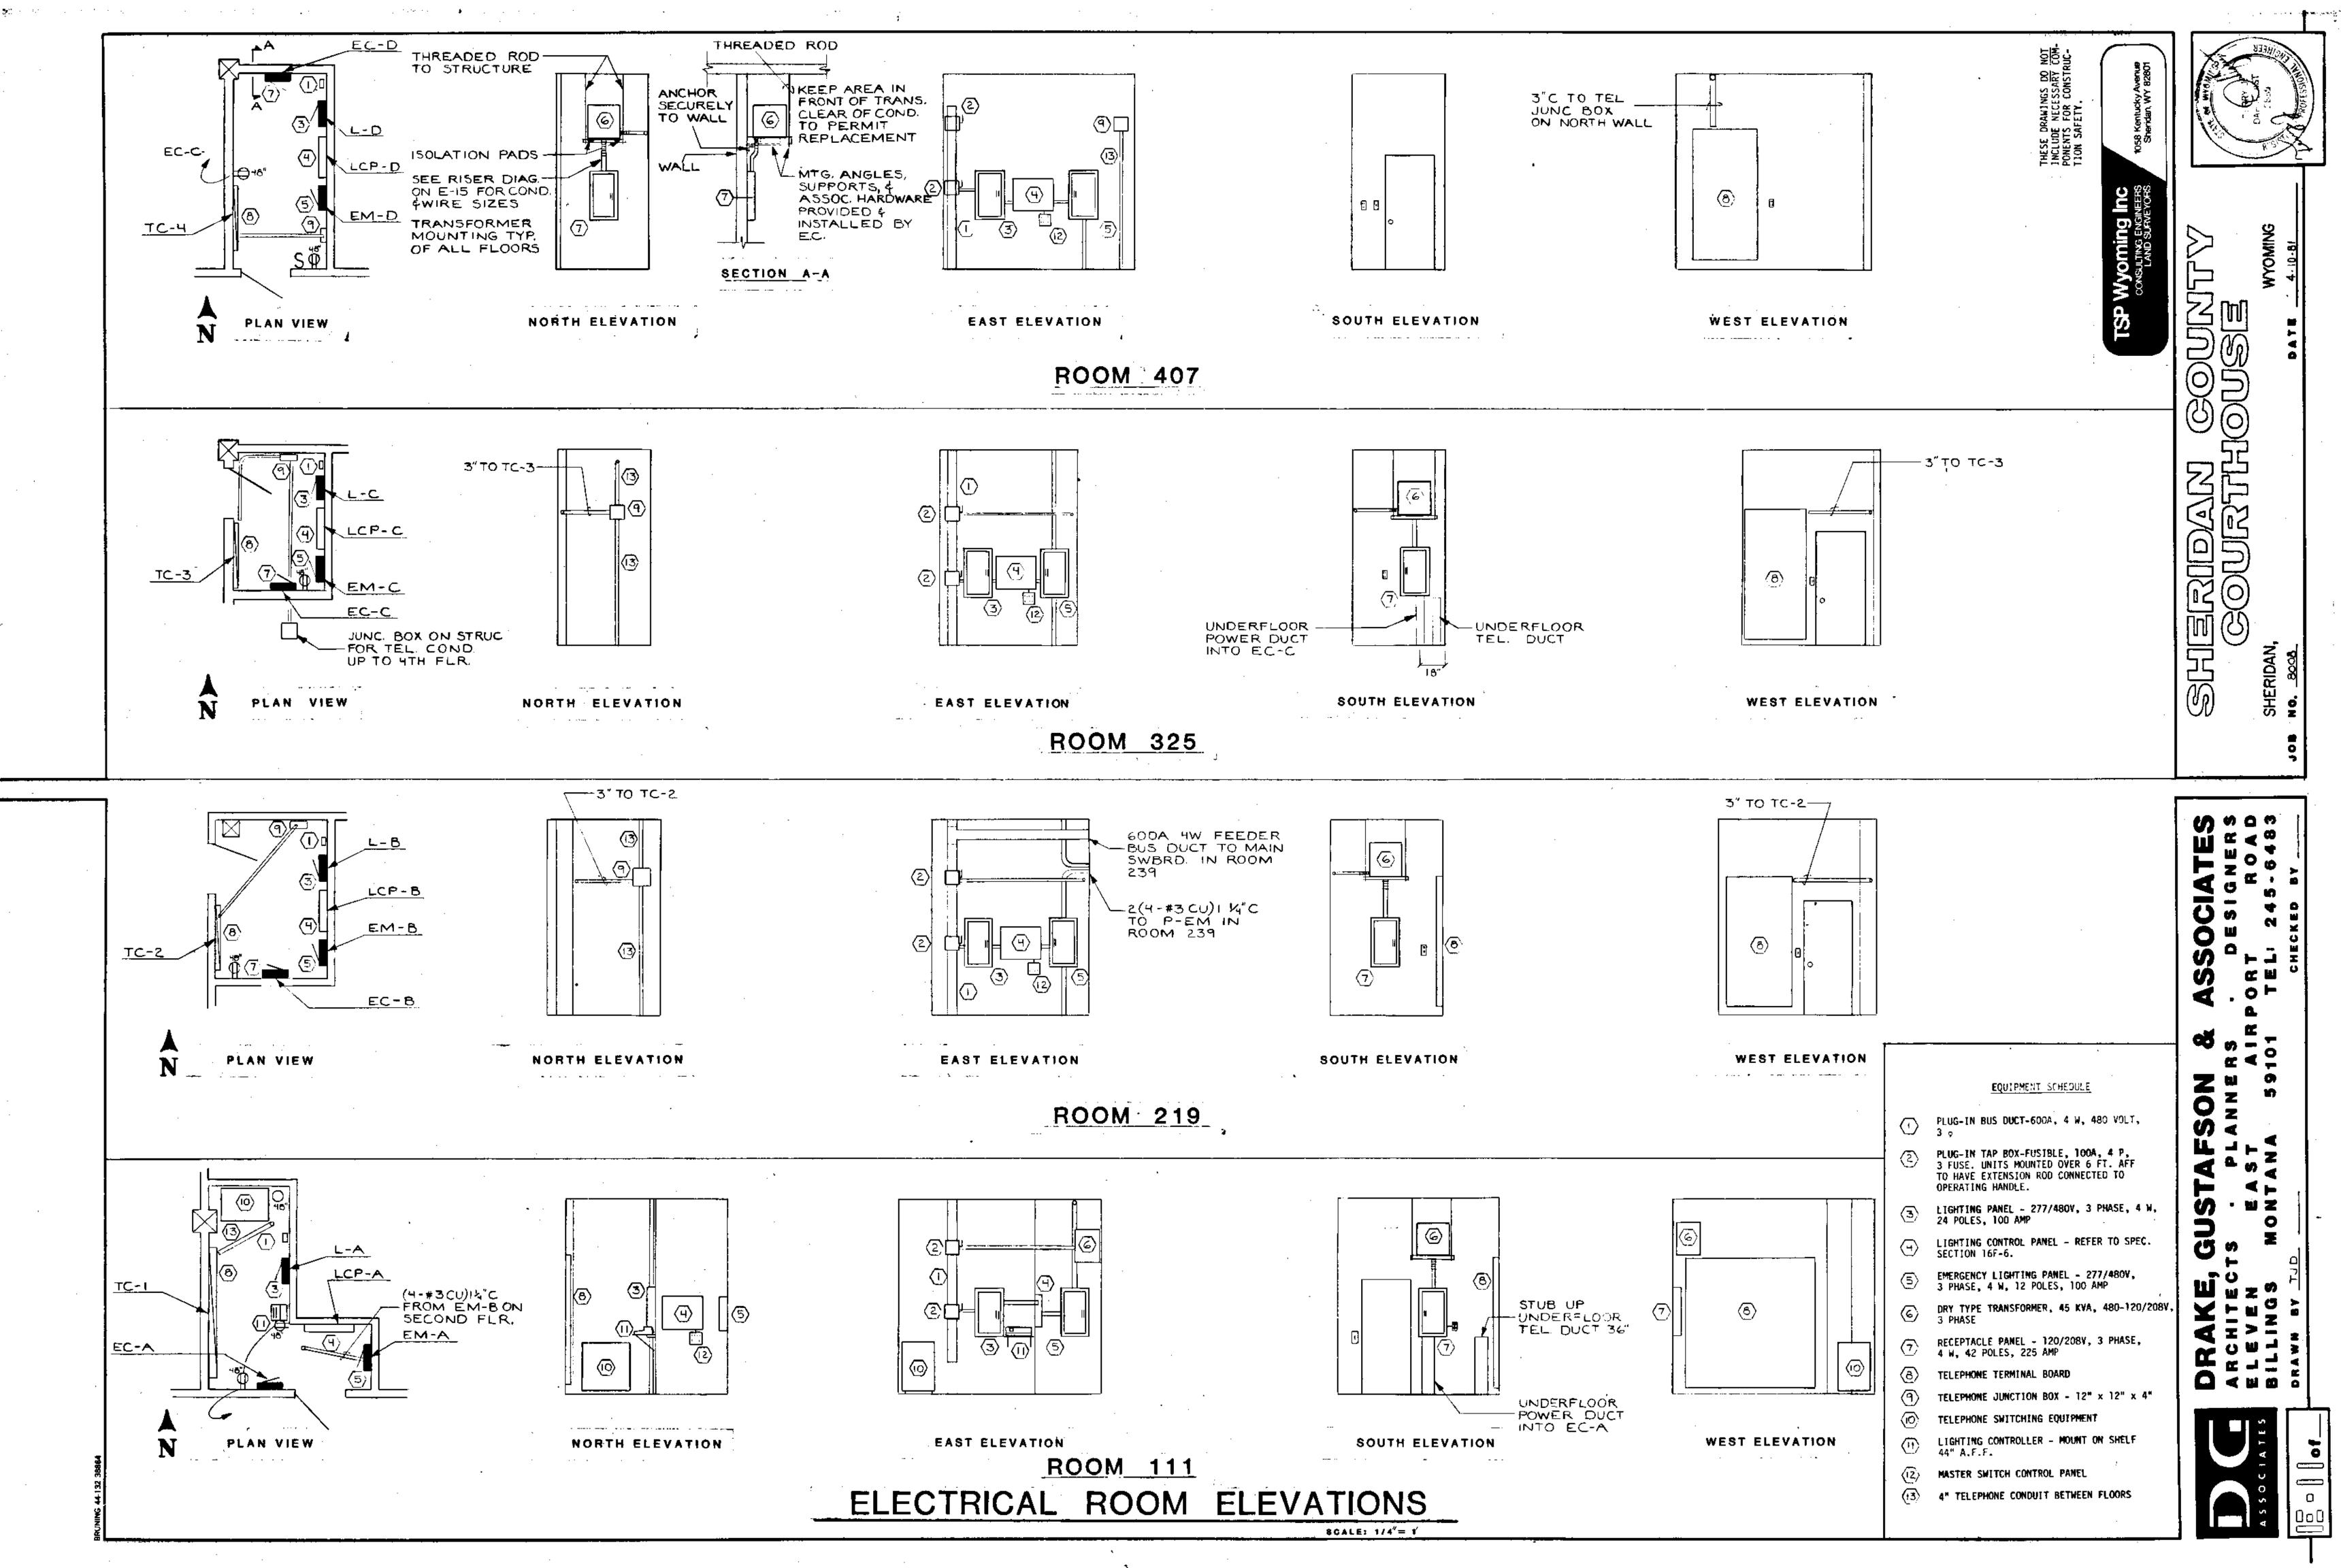

| | | | · . | | | | | | ···· | |
|--|---|--|--|----------------------------|--|---------------------------------|--------------|---|---|--|
| FANEL EC-D | | 2087/12 | | | | _WIRE) CU)2 | | | NTY 225 AMPER | RES |
| CÉT. NO. NO. | D | CHITMBUTION WATTS | · 문학 | CUIT AKEE | | CIBCUI MIEAKI Frame Pales | ᄨᆖᅴᄪᆋᇥ | | TÊ M fin d | CCT NO |
| I SPARE | | | 20 | | A | <u> 9</u> 01 | 80 18 | 1600 | ROOMS 402,406 | 2 |
| 3 4 | | | | 4 | в | 44 | 43 | 800 | 4 410-41Z | 4 |
| 5 | | | | | С | | i . | 1000 | 414-418 | 6 |
| 7 | | | | | <u> </u> | | 1 | 1000 | AC+5,417 | Ú. |
| 9 | | | | ЦП | в | μП | 12 | 1400 | ROOM 417 | <u>،ر</u> |
| u l | | | | | C | | | | SPARE | 10 |
| 3 | | | | | <u> </u> | | | <u> </u> | | 14 |
| 5 | | | | | р С | | | | | 14 |
| 7 | | | | | | | | | | <u>י</u> פ |
| | | | | | <u>A</u> | ╽╽╎ | ┆╷╷┥╴╸ | | | <u> </u> 3 |
| 21 | | | | | | | ┝┼┼┷┈ | | · • • • • • • • • • • • • • • • • • • • | S |
| 23 | | | | | <u> </u> | | | · | | 121 |
| 25 | | | │ │ ┆│ | ┊╻╷ | <u> </u> | ╽╷╷ | ╞╞┨╌ | + | | 120 |
| 27 | | | ┟ ──╞╌╝╞ | ╞╌╞┈╎ | - | ┟┊┊┊ | ┝╋╋ | · · · | · · · · · · · · · · · · · · · · · · · | 3 |
| ≥ ∽ | | | ┟╺┟╷┠ | <u>i</u> I → I | | │ ! ! | | ļ | · · · · · · · · · · · · · · · · · · · | - 3 |
| 3/ | ,. , | •• | ┟╴┟╺┟ | | <u> </u> | | | | · · · · · · · · · · · · · · · · · · · | 1 |
| 75 | | · | ╃╌╴ ╿╺┊╿ | | - B | | | · | · · · · · · · · · · · · · · · · · · · | + |
| <u>35 (</u> | | | | ЦЦ | <u> </u> | ┠┼┼┊ | | 4 | | 3 |
| 37 SPARE | | 1.1/0.0 | 20 | | <u>A</u> | ┞┽┼╈ | ┝┥╋ | · · · · · · · · · · · · · · · · · · · | • • • • • • • • • • • • • • • • • • • | - |
| 19 HAND DR | | 4600 | 10 30 3 | 2 00 | B | | | | SPARE | 4 |
| I ROOMS | <u></u> | .1 | | | <u>)))</u> | <u> </u> | in e | BKR. | 200A KA | <u> </u> |
| | | | | | | | | | | |
| PANEL EC-C | | 208 Y/120 | | | | | 4 "C | _MAIN CAPAC | ECTION MAIN BKR | æs |
| CT. man 78 | | DUTROUTION WATTS | | | - D - | CIRCUI | | | ITEM PED | C(1 |
| | | | | \rightarrow | | Frame Foles | | | · | |
| KOOMa 3 | | 400 | 16. 20 | 00 | | QOL | 20 12 | | RUGWIS | 2 |
| <u>' </u> | | 900 | 44 | | Ð | 44 | 44 | 1600 | 330,361 | 4 |
| | <i></i> | 900 | ╽╽╽╽ | | 0 | | | 1600 | 319,529 | 6 |
| | 5,320 | 1000 | | ЩЛ | Ā | | | 1600 | 30% <u>30%</u> 10% | s e |
| 7 | <i>a 1</i> | 1000 | ╞╪┼┊┸ | | В | μ | | 600 | 302 | 11 |
| | <u>"] .</u> | 1600 | | | C | μ | | 1000 | 50 | - |
| | 23,327 | | | iЦЦ | <u>A</u> | | ┝┥┨╽ | 1000 | 305 | ·4 |
| 5 | | 1000 | ╽╢╽╽║ | | ъ | | | 1500 | 305,311 | 14 |
| 7 3 | 11, 315 | 400 | | ╷╷╷╷ | Ç. | ┝╅┈╁╽┙ | ┝┼┼┧ | 1600 | 303, 311 | I٤ |
| * | 0 71 | 200 | . * | | A | | | 1600 | 7 " " | - 20 |
| ROOMS | 0 11 | _ | ╞╴╞╏┠ | | <u>b</u> | ╎┽┽┥ | :< | 1600 | ROOMS " " | 27 |
| 3 SPARE | | | <u>↓ </u> ∤ ↓ ↓ | | <u>~</u> | ┟┼╶┞╽ | ┝┿╋╌┈ | . | 5PARE | 2 |
| 5 (| | | ╷╷╽ | | | ┟┽┼╁ | | | 4 | 50 |
| 7 | | ļ | ╞╼╌┟╺┟╽ | ╎┼╌┟┤ | <u>B</u> | <u> </u> | | | | Se |
| 4 | | | | | <u>ت</u> | | | | | × |
| .1 | | | ┟╾╼┠╍┊┠┄ | | <u> </u> | ┝╺┟╺╽ | ╷╷ | . | | 31 |
| 13 | | | ┟╶┟┪╎ | | Ð | | | | | 12 |
| 5 | | | P | 7 7 | C · | | | | | 34 |
| 7 SPARE | | | 20 | | A | | | ļ | | 34 |
| HAND DR | · · · · · · · · · · · · · · · · · · · | | 10 30 | 2 Q0 | в | 17 | | · | . 7 | 40 |
| I ROOMS 2 | 36,339 | | | | <u> </u> | QO I MA | in e | .KR - 20 | OA KA | 47 |
| | | | | | .,, | | | | | |
| | | 2061/120 | | 3 | | _wire | 4 | MAIN CAPA | | RES |
| PANEL EC-A | | - SURFA | | | | ດດາມ | <u> </u> | _MAIN CONN | ECTION MAIN BKR. | _ |
| EC-A | | IG SURFA | | | | | | | | |
| EC-A | MOUNTIN | | | CUIT | -8- | CIRCU MEAKI | | Ţ | TT ## 7.90 | |
| EC-A | MOUNTIN | DISTEMUTION WAITS | CR BEE S S Annpa Po | CUIT AKER Ide Frame | | CIRCU BREAKI Fromas Poles | Ampa | DISTRIBUTION WATTS | | ╺╈╼ |
| EC-A | MOUNTIN | DISTEMUTION WAITS | Amps Pr | CUIT AKER Ibe France | | CIRCU BREAKI Franse Poles | | | ROUMS H2 IIH | 2 |
| EC-A ROOM 112 | | HISTERIUMON WAITS 400 | CR BEE S S Annpa Po | CUIT AKER Ibe France | NEUTRAL A B | CIRCU BREAKI Fromas Poles | Ampa | | ROUMS HE IIH | <u>ک</u> |
| EC-A ROOM 112 | | HISTERIUMON WAITS 400 | Amps Pr | CUIT AKER Ibe France | | CIRCU BREAKI Fromas Poles | Ampa | 0:51110/11:0N WATTS 1600 1400 600 | ROUMO H2 IIH 2 IIC IIB | ک ۲ |
| EC-A ROOM 112 110, | | DISTENSATION 400 800 900 | Amps Pr | CUIT AKER Ibe France | | CIRCU BREAKI Fromas Poles | Ampa | CHARMANTICAN WATTS 1600 1400 600 1600 | ROUMO H2 IIH 2 IIC IIB IO6 | с Ч 6 |
| EC-A ROOM 112 110, 110, 110, | | HISTERIUMON WAITS 400 | | CUIT AKER Ibe France | | CIRCU BREAKI Proma Polar | | 01371110U/TICON WAITS 1600 1400 1600 1600 | ROUMO H2 IIH 2 H2 113 106 110 H2 | 2 4 6 8 6/ |
| EC-A ROOM 112 110 110 110 | MOUNTIN 0 112 112 | DISTEMUTION WAITS 400 800 900 400 | | CUIT AKER Ibe France | | CIRCU BREAKI Fromas Poles | | 0437000/11600 WATTS 1600 1400 600 1600 1000 800 | ROUMO H& II4 2 112 113 106 110 112 114 | 2 4 6 8 7 2 |
| EC-A ROOM 112 110, 110, 110, 110, 110, 110, 110, 1 | MOUNTIN 0 112 112 | ризтавиллон <u>400</u> <u></u> 800 <u>900</u> <u>400</u> <u>400</u> | | CUIT AKER Ibe France | | CIRCU BREAKI Proma Polar | | 01571110/11/00 1600 1400 600 1600 1000 800 800 | ROUMO H2 IIH (IIC II3 IO6 II0 II2 (II0 II2 II0 II0 | 2 H 6 8 10 2 H |
| EC-A ROOM 112 110 110 110 110 104 104 104 104 | MOUNTIN 0 112 112 | DISTIBUTION WATTS 400 800 900 400 900 400 500 | I 2 0 I 2 2 0 I 2 2 0 I 2 1 0 I 2 1 0 I 2 1 0 I 1 1 0 I 1 1 0 I 1 1 0 I 1 1 0 | CUIT AKER Ibe France | | | | CHARMANTICAN WATTS 1600 1400 1600 1600 1600 1600 800 1600 1000 | ROUMO H& IIH 113 106 1012 1012 114 107,108 | ч 6 8 10 i2 i4 16 |
| EC-A ROOM 112 110 110 110 104 104 ROOM 104 104 ROOM 104 104 | MOUNTIN 0 112 112 | ризтавиллон <u>400</u> <u></u> 800 <u>900</u> <u>400</u> <u>400</u> | | CUIT AKER Ibe France | | | | 041100/1100 WATTS 1600 1400 1600 1600 1600 1600 1600 1600 | ROUMO H& IIH < IIC II3 IO6 II0 II2 II14 IIC IO7, IO8 IO2, IO9 | 2 4 6 8 7 7 7 7 7 7 7 7 7 7 7 7 7 7 7 7 7 7 |
| EC-A ROOM 112 110 110 110 104 104 104 104 104 | MOUNTIN 0 112 112 | DISTIBUTION WATTS 400 800 900 400 900 400 500 | I 2 0 I 2 2 0 I 2 2 0 I 2 1 0 I 2 1 0 I 2 1 0 I 1 1 0 I 1 1 0 I 1 1 0 I 1 1 0 | CUIT AKER Ibe France | | | | 0411100/1100 WATTS 1600 1400 1600 1600 1600 1600 1600 1600 | ROUMO H& II4 (IIC II3 IO6 II0 II2 II0 IO7, IO8 IO2, IO9 II8-126 | 2 4 6 7 7 7 7 7 7 7 7 7 7 7 7 7 7 7 7 7 7 |
| EC-A ROOM 112 110, 110, 110, 110, 104 104 104 104 104 104 104 104 | MOUNTIN 0 112 112 | DISTIBUTION WATTS 400 800 900 400 900 400 500 | I 2 0 I 2 2 0 I 2 2 0 I 2 1 0 I 2 1 0 I 2 1 0 I 1 1 0 I 1 1 0 I 1 1 0 I 1 1 0 | CUIT AKER Ibe France | φ ≩ < [∞] ∪ [α ∞ ∞ ∞ ∞ < [∞] | | | 0457000/1000 1600 1400 1000 800 1000 800 1400 1400 1200 1400 1400 | ROUMO H2 II4 (IIC II3 IO6 II0 II2 II0 IO7, IO8 IO2, IO9 II05, IO8 | 2 4 6 8 17 12 14 16 20 22 |
| EC-A ROOM 112 110 110 110 110 104 104 104 104 | MOUNTIN 0 112 112 | DISTIBUTION WATTS 400 800 900 400 900 400 500 | I 2 0 I 2 2 0 I 2 2 0 I 2 1 0 I 2 1 0 I 2 1 0 I 1 1 0 I 1 1 0 I 1 1 0 I 1 1 0 | CUIT AKER Ibe France | $\Box = \left[\begin{array}{c} \Delta \\ \bullet \end{array} \right] = \left[\begin{array}{c} \Delta \\ \end{array}] = \left[\begin{array}{c} \Delta \\ \bullet \end{array} \right] = \left[\begin{array}{c} \Delta \\ \bullet \end{array} \right] = \left[\begin{array}{c} \Delta \\ \bullet \end{array} \right] = \left[\begin{array}{c} \Delta \\ \end{array}] = \left[\begin{array}{c} \Delta \end{array} \right] = \left[\begin{array}{c} \end{array} \\ \end{array}] = \left[\begin{array}{c} \end{array} \\ = \left[\begin{array}{c} \end{array} \end{array} \right] =$ | | | 0:31100/1000 1600 1400 1000 800 1400 1200 1400 1200 1400 1200 | ROUMO H& II4 (IIC II3 IO6 II0 II2 II0 IO7, IO8 IO2, IO9 II8-126 IO5, IO8 IO6, IO7 | 2 4 6 8 77 72 14 16 22 22 24 |
| EC-A ROOM 112 110 110 110 104 104 104 104 104 | MOUNTIN 112 112 112 112 112 | DISTIBUTION WATTS 400 800 900 400 900 400 500 | I 2 0 I 2 2 0 I 2 2 0 I 2 1 0 I 2 1 0 I 2 1 0 I 1 1 0 I 1 1 0 I 1 1 0 I 1 1 0 | CUIT AKER Ibe France | $\frac{1}{2} \sum_{n=1}^{\infty} \sigma \sigma$ | | | 0:31100/0000 1600 1400 1600 1600 1600 1600 1600 1600 1600 1600 1600 1600 1600 1600 1000 1400 1200 1400 1000 | ROUMO H& II4 (IIC II3 IO6 II0 II2 II14 II0 IO7, IO8 IO2, IO9 II02, IO9 II05, IO8 IO5, IO8 IO6, IO7 ROOM IO5 | 2 4 6 8 7 7 2 2 4 2 2 2 4 2 2 2 4 2 2 4 2 2 4 2 2 4 2 2 4 2 2 4 2 2 4 2 2 4 2 2 4 2 2 4 2 2 4 2 2 4 2 2 4 2 4 5 7 5 7 5 7 5 7 5 7 5 7 5 7 5 7 7 7 7 |
| EC-A ROOM 112 ROOM 112 110 110 110 110 110 104 104 104 | MOUNTIN 112 112 112 112 112 | DISTIBUTION WATTS 400 800 900 400 900 400 500 | I 2 0 I 2 2 0 I 2 2 0 I 2 1 0 I 2 1 0 I 2 1 0 I 1 1 0 I 1 1 0 I 1 1 0 I 1 1 0 | CUIT AKER Ibe France | $\frac{1}{2} \sum_{n=1}^{\infty} \sigma \sigma \sigma \sigma \sigma \sigma \sigma \sigma \sigma \sigma$ | | | 0:31100/1000 1600 1400 1000 800 1400 1200 1400 1200 1400 1200 | ROUMO H& II4 (IIC II3 IO6 II0 II2 II0 IO7, IO8 IO2, IO9 II8-126 IO5, IO8 IO6, IO7 | 2 4 6 7 7 7 7 7 7 7 7 7 7 7 7 7 7 7 7 7 7 |
| EC-A ROOM 112 ROOM 112 110 110 110 110 110 104 104 104 | MOUNTIN 112 112 112 112 112 | DISTRUMON WATTS 400 800 900 400 400 400 500 1350 1350 4 | I 2 0 I 2 2 0 I 2 2 0 I 2 1 0 I 2 1 0 I 2 1 0 I 1 1 0 I 1 1 0 I 1 1 0 I 1 1 0 | CUIT AKER Ibe France | $\mathbf{D}_{\mathbf{A}}^{\mathbf{A}} = \mathbf{C}[\mathbf{D}] \mathbf{C}[\mathbf{A}] \mathbf{D} \mathbf{C}[\mathbf{A}] \mathbf{D} \mathbf{C} \mathbf{C} \mathbf{C} \mathbf{C} \mathbf{C} \mathbf{C} \mathbf{C} C$ | | | 0:31100/1000 1600 1400 1000 800 1400 1200 1400 1200 1400 1200 | ROUMO H& II4 (IIC II3 IO6 II0 II2 II14 II0 IO7, IO8 IO2, IO9 II02, IO9 II05, IO8 IO5, IO8 IO6, IO7 ROOM IO5 | 2 4 6 8 77 12 14 16 20 22 24 24 28 30 |
| EC-A ROOM 112 ROOM 112 110 110 110 110 110 104 104 104 | MOUNTIN 0 112 112 112 112 112 112 112 | DISTRUMINON WAITS 400 800 900 400 400 400 500 1350 1350 | I 2.0 I 2.0 I 4 I 2.0 I 4 I 1.0 I < | CUIT AKER Ibe France | $\frac{1}{2} \sum_{n=1}^{\infty} \alpha = \alpha$ | | | 0:31100/1000 1600 1400 1000 800 1400 1200 1400 1200 1400 1200 | ROUMO H& II4 (IIC II3 IO6 II0 II2 II14 II0 IO7, IO8 IO2, IO9 II02, IO9 II05, IO8 IO5, IO8 IO6, IO7 ROOM IO5 | 2 4 6 8 77 12 14 16 20 22 24 26 28 28 30 32 |
| EC-A ROOM 112 ROOM 112 110 110 110 110 110 104 104 104 | MOUNTIN 0 112 112 112 112 112 112 112 | DISTREMUNION WAITS 400 800 900 400 900 400 900 400 900 400 900 400 900 400 500 1350 4 1350 1350 | | | $\frac{1}{2} = \frac{1}{2} = \frac{1}$ | | | CHIMMATTS 1600 1400 1600 1600 1600 1600 1600 1600 1600 1000 1400 1400 1400 1200 1400 1200 1200 | ROUMO H& II4 (IIC II3 IO6 II0 II2 II14 II0 IO7, IO8 IO2, IO9 II02, IO9 II05, IO8 IO5, IO8 IO6, IO7 ROOM IO5 | 2 4 6 7 12 14 16 20 22 24 26 26 26 30 30 30 30 30 |
| EC-A ROOM 112 ROOM 112 110 110 110 110 110 104 104 104 | MOUNTIN 0 112 112 112 112 112 112 112 | DISTRUMINON WAITS 400 800 900 400 400 400 500 1350 1350 | | | $\mathbf{\Phi}_{\mathbf{x}}^{\mathbf{z}} < [\mathbf{\omega}] \cup] < [\mathbf{\omega}] \cup [\mathbf{\omega}] \cup] < [\mathbf{\omega}] \cup [\mathbf{\omega}] \cup [\mathbf{\omega}] \cup [\mathbf{\omega}] \cup] < [\mathbf{\omega}] \cup $ | | | CHIMMATTS 1600 1400 1600 1600 1600 1600 1600 1600 1600 1000 1400 1400 1400 1200 1400 1200 1200 | ROUMO H& II4 (IIC II3 IO6 II0 II2 II14 II0 IO7, IO8 IO2, IO9 II02, IO9 II05, IO8 IO5, IO8 IO6, IO7 ROOM IO5 | 2 4 6 7 7 7 7 7 7 7 7 7 7 7 7 7 7 7 7 7 7 |
| EC-A ROOM 112 ROOM 112 ROOM 112 110 110 110 110 104 104 104 104 | MOUNTIN 0 112 112 112 112 112 112 112 | DISTRUMENTS 400 800 900 400 900 400 900 400 900 400 900 400 900 400 500 1350 4 1350 1350 1350 | I 2.0 I 2.0 I 2.0 I 4 I 4 I 4 I 1 <t< td=""><td></td><td>$\mathbf{\Phi}_{\mathbf{x}}^{\mathbf{z}} < [\mathbf{\omega}] \cup] < [\mathbf{\omega}] \cup [\mathbf{\omega}] \cup] < [\mathbf{\omega}] \cup [\mathbf{\omega}] \cup [\mathbf{\omega}] \cup [\mathbf{\omega}] \cup] < [\mathbf{\omega}] \cup$</td><td></td><td></td><td>CHIMMATTS 1600 1400 1600 1600 1600 1600 1600 1600 1600 1000 1400 1400 1400 1200 1400 1200 1200</td><td>ROUMO H& II4 (IIC II3 IO6 II0 II2 II14 II0 IO7, IO8 IO2, IO9 II02, IO9 II05, IO8 IO5, IO8 IO6, IO7 ROOM IO5</td><td>2 4 6 8 77 12 14 16 20 22 24 26 30 32 32 34 35 35</td></t<> | | $\mathbf{\Phi}_{\mathbf{x}}^{\mathbf{z}} < [\mathbf{\omega}] \cup] < [\mathbf{\omega}] \cup [\mathbf{\omega}] \cup] < [\mathbf{\omega}] \cup [\mathbf{\omega}] \cup [\mathbf{\omega}] \cup [\mathbf{\omega}] \cup] < [\mathbf{\omega}] \cup $ | | | CHIMMATTS 1600 1400 1600 1600 1600 1600 1600 1600 1600 1000 1400 1400 1400 1200 1400 1200 1200 | ROUMO H& II4 (IIC II3 IO6 II0 II2 II14 II0 IO7, IO8 IO2, IO9 II02, IO9 II05, IO8 IO5, IO8 IO6, IO7 ROOM IO5 | 2 4 6 8 77 12 14 16 20 22 24 26 30 32 32 34 35 35 |
| EC-A ROOM 112 ROOM 112 110 110 110 110 110 104 104 104 | MOUNTIN 0 112 112 112 112 112 112 112 | DISTRUMINON WAITS 400 800 900 400 400 400 500 1350 1350 | | | $\mathbf{\Phi}_{\mathbf{A}}^{\mathbf{A}} \propto \mathbf{\omega} \cup \mathbf{A} \mathbf{\omega} \mathbf{\omega} \times \mathbf{\omega} \mathbf{\omega} \mathbf{\omega} \times \mathbf{\omega} \omega$ | | | CHIMMATTS 1600 1400 1600 1600 1600 1600 1600 1600 1600 1000 1400 1400 1400 1200 1400 1200 1200 | ROUMO H& II4 (IIC II3 IO6 II0 II2 II14 II0 IO7, IO8 IO2, IO9 II02, IO9 II05, IO8 IO5, IO8 IO6, IO7 ROOM IO5 | 2 4 6 7 7 7 7 7 7 7 7 7 7 7 7 7 7 7 7 7 7 |


and the second second

a second commence and a second s

| | ANEL L-D | | 180 Y/27 | | _PHA: | | | 3 | _WIR | | ч «"г | | MAIN CAPA | | AMPERES |
|----|------------------|-------|----------|-------------|-------|---------|-----------|-----|---------------------|---------------|----------------|------------|-----------------------------------|-------------------|---------|
| J. | | | | WME SIZE | | CIRCU | оп — | -8- | | CIACU REAK | 17 52 | MIN 152 | MAIN CONN DISTRIUTION WATTS | | |
| | LCF-0-1,2 | ,3 | 100 | 12 | 20 | Ī | Eн | A | Ен | ī | 20 | | | SPARE | 2 |
| | <u>८</u> म.च, | 6 | 300 | 4 | 4 | 4 | 4 | Ē. | 4 | 4 | 4 | | | 4 | |
| j | 70 | 9 | 300 | | | | | c | - • ! | | • • | | | <u> </u> 1 | 6 |
| | ي کار مينان م | 2.1 m | 1 | | | . | | 4 | , , | | • • - | | | | 18 |
| _ | <u> </u> | | | , <u> </u> | | , . | | | | ╸╼╌ ╵╴╷ | | - | | | 10 |
| | 16,1 | 7,18 | 200 | | | | | C | | | | | | | 12 |
| 5 | 19,2 | .0,21 | 200 | | | | | A | · · | | | | | i | 14 |
| 5 | 22.2 | 3,24 | 2500 | 7 | | | - | ₿ | •• • ! | | | | · - · · | | 16 |
| ' | LCP- D- 25,2 | 26,27 | 2300 | 12 | | | | C | | 4 | | | | | 81 |
| | SPARE | - | | | | | | A | | ! | | | | | 20 |
| 1 | SPARE | | · | | 7 | 5 | 7 | Б | 7 | 7 | $\overline{7}$ | | | ``` | |
| 5 | SPARE | | | | ZΟ | 1 | EH | C | Ę٢ | ! | 20 | | | SPARE | 24 |


. .

21 23

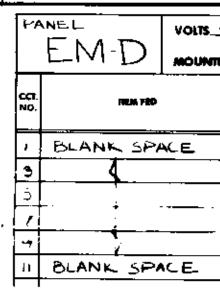


FOURTH FLOOR PANEL SCHEDULES

| 7 | NEL | volts_ <u>4</u> ਠੇ | 0 Y/277 | | PHAS | SE | 3 | | WIR | E | 4 | | MAIN CAPAC | <u>ססי א</u> ייג | AMPE | RES |
|----|----------------|--------------------|------------|---------------------|------|----------------|-------------|------------|--------|--------------|-------|---------------|-------------|------------------|--------------|---------------|
| | L-C | MOUNTING | SURFAC | E | FEED | er s | ZE (| 4-#3 | CU, |)12 | ′4`C | | MAIN CONN | IECTION MA | IN LUGS | |
| I. | INUM FED | | DITINUTION | w NE Size | | CIECU IREAK | | -8- | | HECU HEAK | | W IRE Size | OISTERUTION | | EM / FED | |
| | | | WATTS | 3 2 | Amps | Poles | Freese | | France | Poles | Amps | IN ES | WATTS | " | | NO. |
| | LCP-C-I,2 | ,3 | 2000 | 12 | 20 | 1 | Ен | A | ЕH | 1 | 20 | 12 | 3200 | ROOM | 100 | 2 |
| ' | . <u>(</u> 4,5 | 5, 6 | 2000 | 4 | 4 | 4 | 4 | В | 4 | 4 | Ú. | ۲ | 1000 | ć – | 103-305 | 4 |
| | 7 6 | 4 | 1800 | ļ , | | 1 | | | | ļ | [' ' | | 1000 | | | 6 |
| ì | • | | | · · | i | | | A | | | | | •_C | KODM 5 | 199 B - 1942 | -+ -4 24 |
| í | | | . • | | | | | • <u>-</u> | | | • | | | 1 4 1 9 | | |
| | <u></u> і Ч, | 15 | 2000 | 1 | | | | C | | | : | | | 4 | | 12 |
| 5 | LCP-C-17, | 8 | 1600 | 12 | | | | A | | | | | | | ·· | 14 |
| | SPARE | | | | | | | в | | | | | | | | 16 |
| Ι | 4 | | | | | | | C | | | ', | | | ·j | | 18 |
| | | | | | | | | A | | | | | | | | 20 |
| T | 7 | | | | 7 | 5 | 7 | B | 5 | 5 | 7 | | | | | |
| 5 | SPARE | | | | 20 | 1 | Eн | c | £н | I | 20 | | - | SPARE | | 24 |

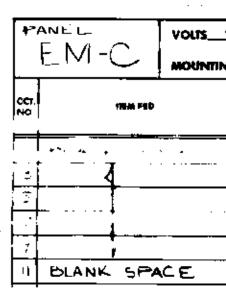

THIRD FLOOR PANEL SCHEDULES

| Ρ/ | L-A | VOLTS 480 Y/17 | | PHAS | | | 3 4~#30 | _ wiri 20) i | | т, 'С | | MAIN CAPAC | ECTION MAIN LUGS | APERES |
|---------|---------------------------------------|----------------|----------|------|---------------|-------|------------|------------------------|--------------|----------|-------------|--------------|------------------|-----------|
| б 23 | ITEM FED | DISTRIBUTION | N N | | CIRCU Reak | | -0- | | INCU IEAK | | WIE Stre | DISTRIBUTION | item PED | |
| NQ, | | WATTS | 3 10 | Атре | Poles | Frame | | Frome | Palee | Ampt | * 2 | WATTS | | CCI NO |
| Ι | LCP-A-17 | Les C | i2 | 20 | ŧ | Ē- | Α | Ė٢ | I | 26 | 12 | 1500 | LCP-A-29 | |
| 3 | <u>, (</u> 16 | けても | , . 1 | [{ | 3 | 4 | β | 1 | 5 | 4 | 12 | 1500 | LCP-A-30 | 4 |
| 5 | | | | | | | ; | | | | | - | SPARE | 6 |
| 7 | - Ghas | Pro Congra | | | | _ | A | | | | | | | 0 |
| ۰. | · · · · · · · · · · · · · · · · · · · | 1.0 | | | | | •.* | | | | | | , | IC. |
| П | 2 2 | HCC | • | | | | | | | ; ; | | | | 12 |
| ۶÷ | 23 | | | | | | A | | | - | | | | |
| ıħ. | ÷ــــــــــــــــــــــــــــــــــــ | 700 | | | | | в | | | | | | · · · · · | 16 |
| 7 | 25 | 1510 | | | ; | | С | ; | | | | | | 16 |
| I٩ | 26 | 15.00 | | | - | | A | | ; | | | | | ZC |
| 21 | 7 27 | 1400 | 1 | | 7 | 7 | B | 7 | 7 | 7 | - | | | 22 |
| 23 | LCP-A- 28 | 200 | 12 | 20 | 1 | Ē | c | ۲. | i | zo | | | SPARE | 24 |

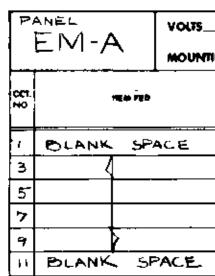

FIRST FLOOR PANEL SCHEDULES

| | | | | | | | | | | | | | 1 | |
|---------------|----------------------|----------------------|---------------|----------------|-----------------|--------------|------------------------|-----------|--------------|--|----------------|--|---|------------------------|
| | 807/27 | | PHASE | | | WIRE | | | MAIN CAPA | | AMPERES | \frown | | NON THE |
| INTINI | <u>g SURFA</u> | <u>CE</u> | | | <u>(</u> 4-#3 | 3CU) | <u>) אי</u> מ | 2 | MAIN CONI | ECTION FEED-THR | <u>u lug</u> s | 88 | 1/36 | Real I |
| | DISTERNINON WATTS | W IM | | ACUIT EAKER | -8- | C N | MCUIT IEAKER | | DISTRIBUTION | TIM F50 | | y Ave Y B2 | | A DE LES CONTRACTOR |
| | | ≷ ≍ | A-14 | oles Frans | NEUTRAL | France | P-31- Arm | | WATTS | | OCT. NO. | atuck Jan, V | OF WY | <u>ا آھا</u> آ |
| | | | ┨┻┥ | + | <u>A</u> | | 1 20 | 212 | 1770 | LCP (1-31,32 | | 1058 Kentucky Avenue Sheridan, WY 82801 | El# | |
| | | + | ┝╼╴╿ | | <u>ඩ</u> උ | | 14 | 51 | 100 | EXIT LTS. | 4 (6) | 20 ² | II Ja | 1213 |
| | · | ╃ ↓ | <u></u> | · + | | | · ┼┼ ┼ | ┤─┤ | | 1 | 8 | | | |
| | | · | ╷╶╼╸ ┞╶╾┽ | | D B | Σ | 17 | | | | ю | S S S S S S S S S S S S S S S S S S S | | |
| | | - | | | _ <u>_</u> | Ен | 1 50 | <u> </u> | • | SPARE | li2 | . D Nor Nor Nor Nor Nor Nor Nor Nor Nor Nor | | اا و |
| | | | | | | | | | | | | лі Збала | | 4-10-81 |
| | | | | | | | | | | | | | ľr š | 4 10.MIN |
| | | | | | | | | | | | | Wy | | ≥ ` |
| | | | | | | | | | | | | | ותראל | I] |
| | | | | | | | | | | | | ₽ ₽ | | |
| | | | | | | | | | | | | | し (字) | < 0 |
| | | | | | | | | | | | | | 65 | |
| | | | | | | | | | | | | NOT CON- | ミジル | |
| | | | | | | | | | | | | E DRAMINGS DO NOT UDE NECESSARY COM- NTS FOR CONSTRUC- SAFETY. | (ů) (í) | |
| | | | | | | | | | | | | LINGS CESSI CESSI COL | | |
| | | | | | | | | | | | | DRAM. FOF | | |
| | | | | | | | | | | | | THESE DR Include Ponents Tion Saf | | |
| | | | | | | | | | | | | THE | | |
| | | | | | | | | | | | | | | н., |
| s_4 | 809127 | 7 | PHASE | ق | | WIRE | 4 | | | | AMPERES | , . | | |
| NTING | SULFAC | | | | <u>4-</u> #3 | | | | | ECTION FEED THRU | | | 「辺辺 | |
| [| DISTRIBUTION | | C# | | -0- | | RCUIT Eaker | | | | | | {oZ (O) | |
| | WATTS | 뽛눥 | A | Hes Frame | NEUTRAL | frame | oles Amp | T | WATTS | 118.00 PBD | CCT. NO. | | | |
| | | | | | <u>A</u> | <u>-</u> | 1 20 | , L. | . 400 | J.C.P. 6, 31 32 | સ | • | | - 1 |
| - | · | ┞─┨ | 1 | • 4 : 1 | ••• | | ۲ 4 | + + | _100 | EXIT LTS. | 4 | | 52 | SHEKIUAN, |
| ∔ ا | | ↓ ! ↓ | | | <u> </u> | + : | | | | 4 | 8 | | | ۲ a |
| | | · - 1 | | +-1 | <u> </u> | | 47 | <u> </u> | | | P | | | Б́е́ |
| | | | | | <u> </u> | ΕH | 1 20 | 4 | | SPARE | 12 | | | - |
| | • | | | | | | | | | | | | | |
| | | | | | | | | | | | | | | 0 |
| | | | | | | | | | | | | | | Ŷ |
| | | | | | | | | | | | | | | 0 |
| | | | | | | | | | | | | | 10 % 0 % | 9 |
| | | | | | | | | | | | | | | 9 |
| | | | | | | | | | | | | | | 9 |
| | | | | | | | | | | | | | | 9 |
| | | | | | | | | | | | | | GNER ROAR | |
| | | | | | | | | | | | | | CIATES SIGNER ROA | |
| | | | | | | | | | | · | | | OCIATES ESIGNER ROA | |
| | | | | | | | | | | | ¥ | | SOCIATES DESIGNER | |
| | | | | | , | | | | | | ı | | OCIATES ESIGNER ROA | HECKED BY |
| | | | | | , | | | | | | Ľ | | SSOCIATES DESIGNER | HECKED BY |
| | | | | | , | | | | | · · · | | | SSOCIATES DESIGNER | HECKED BY |
| 4£ | NO 1/ 27 | 7 p | NASE_ | 3 | | | 4- | A | | τγυω | , MPERES | | SSOCIATES DESIGNER | HECKED BY |
| | 50 1/ 27 | | HASE_ | | | | | | | τγυοΑ • CTION FEED-THRU | | | N & ASSOCIATES | CHECKED BY |
| MING. | SURFACE | EF | | SIZE | <u> </u> | 30 | | <u>"C</u> | | | | | RS - DESIGNER AIRPORT ROA | CHECKED BY |
| MING. | SURFACE | <u>E_</u> F ₩ | CIIC Servi | | 4 - # | 3 C. Biti | ע) א נייד בייד | | | | | | N & ASSOCIATE | CHECKED BY |
| MING. | SURFACE | <u>E_</u> F ₩ | CIIC Servi | | 4 -# | 3 C. Biti | u) ነ ኣ ፡፡፡ | | | TEM FEED-THRU TEM FEO | | | N & ASSOCIATE | CHECKED BY |
| MING. | SURFACE | <u>E_</u> F ₩ | CIIC Servi | | | 3 C. Biti | ע) א נייד בייד | | | | | | N & ASSOCIATE | CHECKED BY |
| MING. | SURFACE | <u>E_</u> F ₩ | CIIC Servi | | | 3 C. Biti | ע) א נייד בייד | | | THE TON FEED-THRU THE TO LCP-C-31,32 EXIT LTS. TELE. EQUIP. SPARE | | | N & ASSOCIATE | CHECKED BY |
| MING. | SURFACE | <u>E_</u> F ₩ | CIIC Servi | | | | | 12 12 | | TELE. EQUIP. SPARE | | | N & ASSOCIATE | |
| MING. | SURFACE | <u>E_</u> F ₩ | CIIC Servi | | | | | 12 12 | | THE TON FEED-THRU THE TO LCP-C-31,32 EXIT LTS. TELE. EQUIP. SPARE | | | USTAFSON & ASSOCIATES PLANNERS DESIGNER EAST AIRPORT ROA | |
| MING. | SURFACE | <u>E_</u> F ₩ | CIIC Servi | | | | | 12 12 | | TELE. EQUIP. SPARE | | | STAFSON & ASSOCIATES PLANNERS DESIGNER E A ST AIRPORT ROA | |
| MING. | SURFACE | <u>E_</u> F ₩ | CIIC Servi | | | | | 12 12 | | TELE. EQUIP. SPARE | | | USTAFSON & ASSOCIATES PLANNERS DESIGNER EAST AIRPORT ROA | |
| MING. | SURFACE | <u>E_</u> F ₩ | CIIC Servi | | | | | 12 12 | | TELE. EQUIP. SPARE | | | AKE, GUSTAFSON & ASSOCIATES HITECTS PLANNERS DESIGNER VEN EAST AIRPORT ROAD | |
| MING. | SURFACE | <u>E_</u> F ₩ | CIIC Servi | | | | | 12 12 | | TELE. EQUIP. SPARE | | | USTAFSON & ASSOCIATES PLANNERS DESIGNER EAST AIRPORT ROA | RAWN BY TUD CHECKED BY |
| MING. | SURFACE | <u>E_</u> F ₩ | CIIC Servi | | | | | 12 12 | | TELE. EQUIP. SPARE | | | AKE, GUSTAFSON & ASSOCIATES HITECTS PLANNERS DESIGNER VEN EAST AIRPORT ROAD | |
| MING. | SURFACE | <u>E_</u> F ₩ | CIIC Servi | | | | | 12 12 | | TELE. EQUIP. SPARE | | | AKE, GUSTAFSON & ASSOCIATES HITECTS PLANNERS DESIGNER VEN EAST AIRPORT ROAD | RAWN BY TUD CHECKED BY |

| i | | | <u></u> | · · · · · · · · · · · · · · · · · · · | | | * | | | | 1 . | | | | | | |
|---|--|-----------------|--|---------------------------------------|--------------------------|--------------|-------------------|------------------------------|-------------------|---------------|----------|------------------------|-------------|---|--------------------------|---|--|
| | | NEL EC- | в | | <u>eo/eoe</u> G_surfa | | _PHAS | | 3 | 4 - 1 | _wire_ | | | WAIN CAPAC | | | AMPERES |
| | cer. | | | | | Т | T s | ER SIZI LIRCUIT REAKER | | | | :UIT | T T | DISTRIBUTION | ECTION T | MAIN BKR | |
| | NO. | | nem PED | | WATTS | , i | Amps | Poles Fr | anar NE | | frame Pa | | žů. | WATTS | | MEM PED | CCT. NO. |
| | 3 | ROOM | 15 22 | <u>0-88.6</u> // | 1600 | 12 | 20 | | | A b | | <u>50</u> | 12 | 1400 | ROOM | 15 235,224 236,23 | |
| | 5 | _ | | ti . | 500 | ╉ | | | ₽ - - | | | | | 1300 | | 552,53 | |
| | 7 | | | 0,213,214 | | \prod | | | ╂-┩ - | A | | | | 1400 | | 210,217 | · · · · · · |
| | 9 | -+ | 2 13 | 4 5 216 | 1400 | + | | | • - | <u>ь</u> С | | | ┝╂┽ | - 750 - 400 | | 207211,21 219:216 | |
| | 13 | | | | 1000 | | | | + | Ā | | | | 1400 | | | |
| | 15 | | | ॥ ४,२०२ | 1200 | ┼┿ | + | | ↓ - | <u>ь</u> С | | | 12 | 600 | ROOM SPA | <u> 15 //</u> | Ĵ Ĉ |
| | 19 | | | | 800 | ╉╋ | | ┝╋╋ | ╉┥╺ | <u> </u> | | ++ | 16 | | 4 | | to |
| | 21 | _ | | 11 | | | | | . _ | Ð, | | | | | | | 28 |
| | 23 25 | | 204 | 4,207,211 11 | 1200 | ++ | ╞┣┥ | ┊╉╋╴ | | | | | | | | | 24 |
| | 27 | | | | epo | | | | <u>∔</u> -1 _ | 6 | | | | | | | 26 |
| | 6.1 12. | | | | 500 | + + | | . | } | ⊆ | ╌ᆃᆛᆡ | ┝┥╉╷ | | | | · - | 30 |
| | | • | . 4 | <i>i</i> | | 15 | | Ħ | ∳ -, – | • | | | | | · | ·*_ ·- · · | 32 34 |
| | | RCCH SPAR | · · · · · · · · · · · · · · · · · · · | 5 | +O/ O | 12 | | | 니 _ | | | | | | | | مەد ھەد |
| | | | - С.А.УВ | ERS | | | 20 36 | | | A B | | | | | | | 38 40 |
| | 41 | ROOM | 15 23 | 1,233 | | \checkmark | | | | (| ί nγ | 50 | | | SPAR | λE | 42 |
| | | | | | | | | | .).; |)-) | | M | | BKR | 2 | 200A K | A |
| | | | | | | | | | | | | | | | | | |
| | | | | | | | | | | | | | | | | | |
| 4 | | . . | | | th i | | · - | | | •••••• | | • • | | | · . | | |
| | | NOTOF | CON | TROL C | ENTER | МĊ | <u>c -</u> | <u> </u> | | | | | | | JOE | NO 804 | <u>s</u> |
| | | TC 2 | 77 /40 | 0 | IACT | 2 | | 100 | | <u>م</u> | | ND 1 70N | | 8US <u>6</u> C | | <u> </u> | |
| | | | | | | | | | | | | | | NEM | | AN | |
| : | | MTR. | | | | HP | | | INNECT | | ITCH | | | MAGNET | IC STA | RTER DATA | |
| | | NO. | EŲL | JIPMENT F | •ED | | amps | | DLES | FUS | E AL | 1X.)NT | NEM/ SIZ | | AUX. CONT. | CONTROL | PILOT LIGHTS |
| | 1 | | | #1 | | 40 | 100 | 5 | 3 | 7 | 0 | | 3 | | | | R /0 |
| | 2 3 | 3 | | #1 | <u>م لك</u> | 15 3 | <u>-</u> | ╧╋╌ | 4- | _ | 6 | | 2 | MAG MAG | | • | <u>_</u> R∕ 0 R∕0 |
| : | 4 | 2 10 | | COMP | _ | 3 | | + | + | - | .6 | | | | - | | |
| | 5 | 8 | AHU | | | 3 | | | — | 5. | -+- | | 0 | MAG | I N .O | ноа | R/0 |
| | 6 | | | ER(FU | TURE) UTURE) | 10 10 | | | + | + - | _ | _ | | - MAG | — I N.O. | HOA | 1≥/0 |
| | 8 | 6 | ACC | u#1 | | Š V | 6 | 0 | > | + | 10 | — | | | | | |
| | 9 10 | 7 | ACC SPA | <u>u#2</u> CE | | * • | 20 | | 3 | 20 | <u>0</u> | | | - | | | R.10 |
| | 11 | | SPA | | | | | | | | | | | | | | |
| | 12 | ↓ ↓ | SPA | | | | | | • | ļ | | CONTR | KOL TYPI | _ | ····· | AUXILIARIE | |
| | <u>star</u> | TER TYPE | | ABBREV | STARTER CO | | | - | | | | THERM PR. S FLT. | 4. SN. 1 | = [h ermostat Pressure swit(Float switch | - | RUN RU OFF OF | - NNING PILOT I F PILOT 116H ⁻ NNING AND OFF |
| | MSS SSU MAG | SWITCH MAGNE | STARTER SM H & FUSE UN TIC STARTER | | SEL. SW. HQA | ON-OF | DFF-AUT | TOR SW | ITCH Select | OR SW1 | TCH | FLW. ADUA T.C. | SW. | LOW SWITCH AQUASTAT | | X-N.O. AU (N | XILIARY NORM UMBER AS IND XILIARY NORM |
| | CS/C | NITH B COMBI | NATION STAP FUSED DISCO NATION STAP CIRCUIT BRE | NNECT RTER | | | | | TOR SWI Switch | | | PE N.O. | CONT. | PNEUMATIC ELEC WORMALLY-OPEN WORMALLY-CLOSI | CONTACT | | UMBER AS IND. |
| | CS/M | CP COMBIT | NATION STAP | ITER It Protector | | | | | | | | MANUA OTHER | 4L I | ANUAL BY OTHERS | | | |
| | ₽ ∧ | NEL | | VOLTS | 277/480 | 2 | PHAS | SE | 3 | | | 4 | | | ЛҮ | 552 | AMPERES |
| 1 | | <u> </u> | Ζ | | <u>g syr</u> fa | | | et siz | | (4- | # 3/c | | Υ | | | MAIN LUC | |
| | | | TTEM PEO | , | DISTRIBUTION | | | CIRCUIT | | . | | | M M M | | | ITEM FED | ccr. |
| | | | | | #A//3 | 37 | " Amps | Poise Fi | | EURAL | | Ard Amps | ┟╴╉ | WATTS | | | NO. |
| - | | BLAN | IK SF | ACE | | + | + | ┝┅┠ | | A B | | 1 20 | 12 | 1400 | ROC 5PA | DMIS 238 | .239 2 4 |
| | 3 | | | | | | | | | <u>c</u> | | | | | 4 | | 6 |
| | 5 | | | • | | 1 | | \square | | A B | | ╽╷┰ | | | | | 8 |
| | 5 | | | • . | | +- | <u>+</u> | | 1 | 0 | ┢┥┦ | | ╏╴╾╡ | | | | · · · - |
| | 5 | | | | | + | | | | C | | | 1 1 | | | | 10 |
| | 5 7 9 11 13 | | | · · · | | | | | | C A | ┝┼┼ | | | | | | 12 |
| | 5791 | | | · . | | | | | | | | | | | | ······ | 12 |
| | 5 7 9 11 13 15 17 19 | | | · · · | | | | | | A Đ | | | | | | ······································ | 12 |
| | 5 7 9 11 13 15 17 19 21 | | | · · · | | | | | | ADCA | | | | | | | 12 14 16 18 20 22 |
| | 5 7 9 11 13 15 17 19 21 23 | | | · · · · · · · · · · · · · · · · · · · | | | | | | | μ | 20 | | | | | 12 14 16 18 20 24 |
| | 5 7 9 11 13 15 17 19 21 23 25 27 | | | | | | | | | ADCA | | <u>, i</u> | | | | ARE NK SPAC | 12 14 16 18 20 24 24 24 |
| | 5 7 9 11 13 15 17 19 21 23 23 27 24 | | | | | | | | | | μ | <u>, i</u> | | | | | 12 14 16 18 20 24 24 24 24 24 30 |
| | 5 7 9 11 13 15 17 19 21 23 25 27 24 31 | BLAN | | | | | | | | | μ | <u>, i</u> | | | BLA | | 12 14 16 18 20 24 24 24 24 30 30 32 |
| | 5 7 9 11 13 15 17 19 21 23 25 27 24 31 33 35 | SNOV | ~ | | 5000 | | 40 | | | | μ | 1 20 | | 5000 | BLA | NK SPAC | 12 14 16 18 20 24 24 24 24 24 24 30 30 30 32 32 34 |
| | 5 7 9 11 13 15 17 19 21 23 25 27 31 33 35 37 | | V FING | | 5000 | | $\mathbf{\nabla}$ | 2 | | | EH | 2 40 | 6 | 5000 | BLA | NK SPAC | 12 14 16 18 20 24 24 24 24 24 24 24 24 30 30 32 30 32 34 36 38 |
| | 5 7 9 11 13 15 17 19 21 23 25 27 31 33 35 37 39 | SNOV Meli | | | 5000 | ò | $\mathbf{\nabla}$ | | | | EH | 2 40 | 6 | 5000 | BLA BLA SNO MEL | NK SPAC | 12 14 16 18 20 24 24 24 24 24 24 30 30 30 32 32 34 |

| Pf | L-B | | 97/480 | | | | ; iZE_(| | | | <u>4</u> . C | | _MAIN CAPAC _MAIN CONN | | 00 AMP | RES |
|--------------|-----------|-----------|---------------------|-----|------|-------|------------|----------|-------|--------|-----------------|-----|---------------------------|------|-----------|----------|
| с а. | nem fed | | DISTRIBUTION | 24 | | CIRCU | | - | | CHECH | | | DISTRUTION | | | |
| CCT. NO. | INC. INC. | | WATTS | 봋볁 | Amps | Pole | Freme | | Franc | • | Ampi | žă | WATTS | | ITEM, PED | NO. |
| 1 | LUP-B-I | e.;s | 2400 | 12 | 20 | ۱ | EH | A | EΗ | 1 | 20 | · < | 1700 | ROOM | 5 238 239 | 8 |
| ų | 4 - 4 | 5,6 | 2300 | 1 | 4 | 4 | 4 | В | 4 | 4 | 4 | | | | Ē | 4 |
| 5 | - 7, | 8,9 | 1 600 |]] | | | | <u> </u> | | T¦. | | | | 4 | | 6 |
| 7 | - IQ | 11,12 | 5500 | Π | | | Π | A | | | | | | | | |
| £ | - (3 | ,14,15 | 900 | | | | Π | 8 | | ļ | | | | - + | | <u>.</u> |
| \mathbf{n} | - 16 | i, in 18- | 1 800 · | | Π | | T | Ċ | | Ī | | | | | | 12 |
| i) | + , - | 1,20,21 | t G sur⊘ | | | 1.1 | | A | | | | | | | | 14 |
| 15 | 7 - 5 | 23.24 | 1600 | | | Π | | B | | | | | | | | 14 |
| 17 | LCP-B-S | 5,26,27 | 1500 | 15 | | | | C | | į. | | | | | | Jus |
| je j | SPARE | | | | | | | A | , | t t | | | | | | 50 |
| | SPARE | | | | 7 | 1 | 1 | Ð | 7 | 15 | 7 | | | 7 | | 22 |
| 53 | SPARE | | | | 2O | 1 | ЕH | C | EH | i i | 20 | | [| SPAR | E | 24 |

.

.

.

| | E'M-B | | 277/480 | | PHAS | | <u>3</u> ZE_ | (4-+ | _wir | | | | MAIN CAPA | | EED-THRU LU | GS_ |
|-----|---------|--------|--------------|-----|----------|-------|-----------------|--------|---------------|----------|------|------|-----------|------|--------------------|-------------|
| хτ. | | EN 110 | DISTRIBUTION | | | CHICU | | Ð | | CHICU | | | | | | 1 |
| ND. | | | WAITS | ž Ü | Атерн | Polas | frame | | Freene | Poles | Amps | V ME | WAITS | | TEM FED | CCT. NO. |
| 1 | BLANK S | PACE | | | | | | A | ЕH | 1 | ٤٥ | 12 | 1600 | EXIT | LIGHTS | ર |
| З | | | | | | | | Ð | ₹ | K | K | 15 | 100 | LCP | -8-31,32 | 4 |
| 5 | | | | | I — | | | C | | Π | | | | SPAF | RE | 6 |
| 7 | | | | | | | | A | | | | | | | | - 8 |
| 9 | | | } | | | | | ъ | $\Box \Sigma$ | T | | | | | | -10 |
| 11 | BLANK S | SPALE | | | [| | | С С | EH | 1 | 20 | | | SPAR | रह. १ <u>ह.</u> | 12 |


| | - 14 16 | | | | | | | | | . • • • • | | | | | | |
|---------------------------------------|------------|--------------|-------------|-----------------------------------|---------------|------------|-------------|---|--------------|---------------|------------------------------|-----|--------------|-----------|--------------|--|
| > | 22 22 | | | ELECI | RIC MOTOR SCI | HEDU | <u>LE</u> | | | | | | | | | JOB NO |
| RE | 24 | | MTR. NO. | LOC. | DESCRIPTION | HP | v | ø | Түре | S T A SIZE | R T E R CONTROL DEVICE | BY | CONT TYPE | ROL BY | WIRE SIZE | REMARKS |
| | | | 1 | 417 | SA∓ #1 | 40 | 460 | 3 | MAG | 3 | MCC-1 | EC. | PE | MC | .++ | FA FAN UNUTDUWN Phase Falure Prote |
| | | | 2 | 838 | SAF #2 | З | 4 | ₹ | 1 | 0 | Mcc-e | 1 | PE | 1 | #12 | INTERLOCKED WITH |
| | | | 3 | 417 | RAF #1 | 15 | | | | 12 | MCC-I | | PE | | #10 | EA EAN SHUTDOWN |
| | | | 4 | 341 | CIRC, PUMP#I | 3 | | Π | | 0 | MCC-2 | | ΡE | | # 12 | |
| | | | 5 | 341 | CIRC, PUMP #2 | 3 | | | MAG | 0 | MCC-I | | PE | | \$12 | 4 |
| | | | 6 | £00₽ | ACC 4 41 | 26 FLA | | | F.D. | 60A | MCC-1 | | PE | | #8 | |
| | | • | 7 | ₽.coF | ACC4 #2 | 133 FLA | | | F.D. | 200 A | Mec-I | | PE | | 3/0 | |
| . | | | в | 403 | Анц | 3 | | | MAG | 0 | MCC-1 | | PE | | #12 | P . |
| | | | ٩ | 238 | BOILER | S | | | | - | MCC-2 | | PR | | 4 | EC TO WIRE PE |
| | | 7 | 10 | 341 | T. C. COMP | З | | 5 | - | - | Mec-1 | | FR SW | | | |
| NO <u>804</u> | <u>+</u> | | 11 | 341 | T.C. COMP | З | 480 | 3 | - | - | MCC-2 | EC | FR SW | | | 1 |
| AM | IPERE | ļ | 12. | 341 | AIR DRYER | ¥4 | 115 | 1 | - | - | NONE | | OTHERS | | | |
| | | | 13 | 113, 117 236, 309 413 | CYH | 1/20 | 1 | 1 | - | - | | | PE | | | EC TO WIRE PE SW |
| CONTROL | PILOT | | 14 | 101 | CUH | 10 | | | | | · | | 4 | | | EC TO WILL TO PE SWITCH |
| · · · · · · · · · · · · · · · · · · · | LIGHTS | i : 1 | 15 | 214 208 | INDUCTION | 1/3 | | | M 55 | FRAC | NONE | ĒC | | | | |
| HOA | R/0 | ľ | 16 | 208 | н н | 1/2 | | | мээ | FRAL | NONE. | EC | | 5 | | 2 UNITS |
| HOA | RUN R/O | | 17 | 315 | <i>// 0</i> | Y4 | | | M \$5 | FRAC | NONE | EC | PE | MC | | EC TO WIRE PE SW |
| | - | | 18 | (G) LOCATIONS | EXH, FAN | Ys0 | | | — | — | 5. P. | EC | MAN | ЕC | | |
| | ļ | | 19 | , 3 9 1 | CIRC. PUMP #3 | 1,0 | | | MSS | FRAC | NONE | ËĊ | AQUA | ΜÇ | | EC TO WIRE STA |
| | | | 20 | ROOF | PRV | 1/2 | 115 | 4 | M55 | FRAC | NONE | EC | ΡE | ΣĊ | #12 | WIRE MOTORIZ ED |
| | | | ءا | 18) Loc 47/<i>I</i>ML S | HAND DRYERS | 2.3 K | <i>20</i> 9 | I | — | - | - · | | | | #10 | INSTALLED BY GC EC TO WILE |
| | | | 22 | 103 | ELEV A | 30 | 480 | 3 | FÐ | 200A | NONE | EC | OTHERS | GC | 1/0 | |
| | | | 23 | 103 | ELEV "B" | 30 | 480 | З | FD | 200 A | NONE | £C | OTHERS | GC | 1/0 | · · |
| | | - 1 | 24 | 120 | ELEV.'C" | 25 | 480 | 3 | FD | 200A | NONE | EĊ | OTHER | GC | 1/0 | |
| | | | 25 | 112 | DUMBWAITEZ | ٤ | 460 | З | FD | 30A | NONE | EC | OTHERS | GC | #12 | |
| | AMPERES | 1 | 26 | (4) UNITS | B4H | ٧6 | 150 | 1 | | | | | THECM | MC | #12 | WIRE C BEMOVE - FOR TEM |
| EALER | | | | | | | | | | | | | | | | |
| | | · | | | | · · · · · | | | | | | | | | | · ···································· |
| | |] > | | | | | ⊢. <u> </u> | | ⊢ | ⊢−−−1 | ⊢−−−−┩ | | | | . | ł |

| | : 277/480 PHASE: | | | | | | | | |
|------------|--------------------|------|----------------------|-----------------|--------------|----------------------|------------------------|--------------------|---------------------------------------|
| TEM NO. | EQUIPMENT FED | AMPS | <u>SWIT</u> POLES | | WIRE SIZE | LOAD D PH.A KW |)ISTRIBU PH.B KW | TION Ph.C Kw | ENGRAVED NAMEPLATE |
| ł. | BUS DUCT | 600 | 3 | BOLTED PRESS | 500 | 64.0 | 64.0 | 64.O | BUS DUCT MAIN |
| 2 | DISTRIBUTION SEC | 800 | 4 | DOLTED PRESS | 500 | 98.2 | 98.2 | 98, 1 | DISTRIBUTION SECTION MAIN |
| 3 | MCC-I | 400 | | LA | 500 | 50.0 | 50 .0 | 50 .0 | LENTER -I |
| 4 | ELEVATOR A | 150 | | KA | Vo | 10 0 | 10.0 | 10.0 | ELEVATOR A |
| 5 | ELEVATOR B | 150 | | KA | 1/0 | 10.0 | 10.0 | 10.0 | ELEVATOR B |
| 6 | ELEVATOR C | 150 | | KA | 1/0 | 8.3 | 8,3 | 8.3 | ELEVATOR C |
| 7 | PANEL L-Z | 200 | 7 | KA | 3/0 | 13.3 | 13.3 | 13.3 | PANEL L-Z |
| ð | ATS | 100 | 3 | KA | #3 | 6.6 | 6,6 | 6.5 | PANEL P-EM |
| ۴ . | SPACE FOR 20 BKRS. | | 3 | Ş | | | | | |
| | | | | | | | | | |
| | | | | | | <u> </u> | | | • |
| | | | | | | | | | · · · · · · · · · · · · · · · · · · · |

| • | IOTO | R CONTROL CENTER | MC | <u> 6</u> | <u>></u> | | | • | • | JOE | B NO <u>80</u> | 4´= |
|---|-------------|------------------|-----|-------------|-------------------|-------|---------|--------------|----------------------------|--------------------------|----------------|----------|
| | | .77/480 PHASE 3 | | NIN A OC | | 5 | HORIZON | | s <u>60</u> Ne <i>n</i> | | · / | AMPERE |
| | MTR. NO. | EQUIPMENT FED | НP | | SCONNECT POLES | Тенее | AUX. | NEMA SIZE | MAGNE TYPE | TIC STA AUX. CONT. | RTER DATA | PILOT |
| 1 | G | DOILER #1 | 5 | 30 | 3 | 15 | | | — — | | | - |
| 2 | 4 | CIRC. PUMP #1 | 3 | | | 5.6 | | 0 | MAG | 1 N.O | ноа | R/C |
| 3 | 11 | TEMP CONT COMP | 3 | 6 | | 5.6 | | — | _ | | — | RUI |
| ų | 2 | 5AF #2 | 3 | 30 | 3 | 5.6 | | Ö | MAG | I N.O. | HOA | R/C |
| 5 | | SPACE | - [| | | | | | — | - | | |
| 6 | | SPACE | - | | | | | | | | | — |


| | TS: <u>277/480</u> PHASE DER STEE (4 - 3/0 C. (| | | WIRE: , | 4 | | | | AIN BREAKER |
|-----|---|------|-------|--------------------------|-----------|------------------|------------|-------------|-------------|
| | | | | | | LOAD DISTINUTION | | ON | |
| NO. | | AMPS | POLES | FUS e Size | WIRE SIZE | РН. А КМ | PH.0 KW | PH. C KW | |
| - | EM-A,B | 00 | М | ĸA | #3 | 1.3 | 1.3 | 1.3 | |
| 2 | EM-C,D | 100 | 3 | KA | #3 | 1.4 | ιŻ | ۱.೭ | |
| 3 | MCC -2 | 100 | 3 | FH | #3 | 4.0 | 40 | ч.О | |
| 4 | FIRE ALARM PNL. | 50 | I | FH | #12 | . | | - | |
| 5 | FIRE ALARM PNL. | 50 | 1 | FH | #12_ | — | . I | | |
| 6 | PROV FOR 4 BKRS | - 30 | 3 | FH | | | | | |
| 7 | MAIN BKR | 100 | 3 | KA | #3 | 6.6 | 66 | 6.5 | |


SECOND FLOOR PANEL SCHEDULES

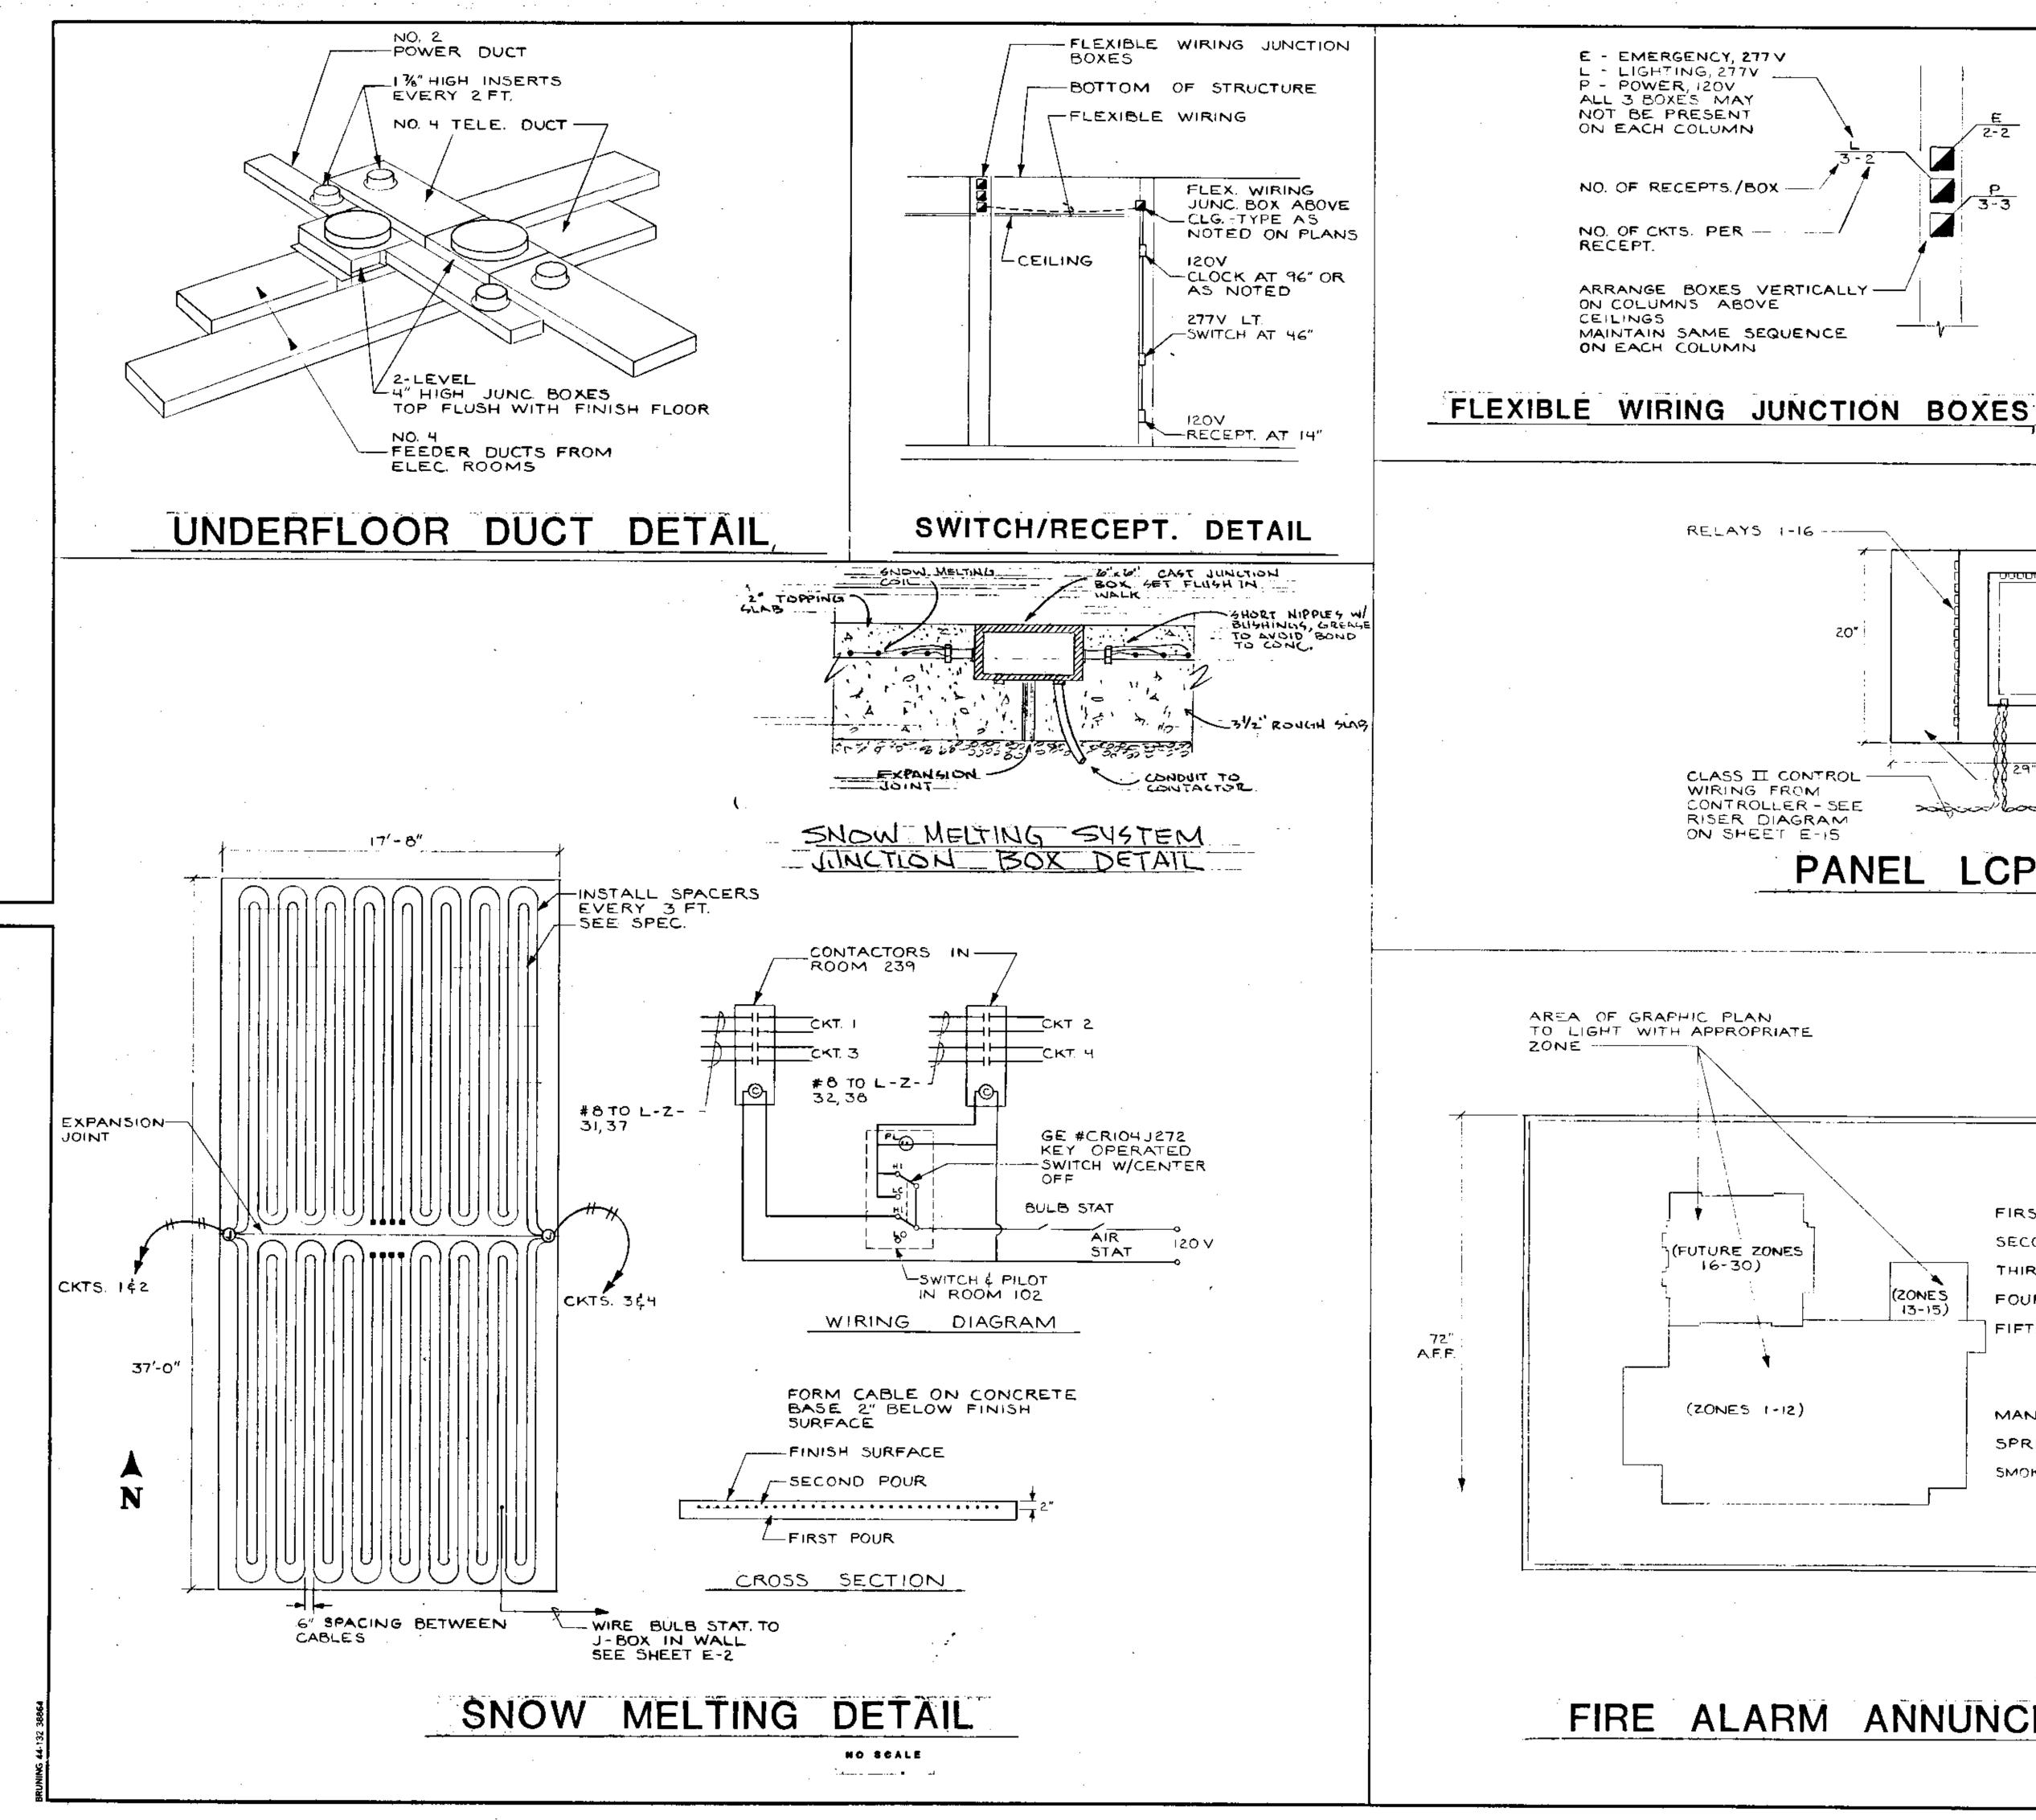

.

ABBREVIATIONS A STADAR A ca Af AMPERE ARCHITECT AND ENGINEER Above Finished Fildor Air Handling Unit LIGHTING NECHANICAL CONTINCTOR MOTOR CONTROL CENTER THOUSAND CIRCULAR NIL MOUNTED ALLMINUM Above counter NGRAALLY CLOSED NATIONAL ELECTRICAL CODE NATIONAL ELECTRICAL NATIONAL ELECTRICAL NATIONAL ELECTRICAL 2-2 BLAST UNIT HEATER COMDUIT CIRCUIT COMD on C CEILING CONNECTION COPPER CAUTNET UNIT NEATER NEUTRAL Normally open **Pushbutton** Phase 3-3 BI SCONNECT Down PANEL Primer Roof Ventilator Plastic Conduit ELECTRICAL CONTRACTOR Emergency RECEPTACLE EL OR RECEPT EQUIPMENT Electric Water Codler Explosion Proof ÉDUIP SOLID NEUTINI. Spitch TEMPERATURE CONTROL Telephone Thansformer Typical FIRE ALART Full load apperes Fluckescent FLA Fluó ō UNDERGROUND SERENAL CONTRACTOR UNIT HEATER 了 GROUND FAULT INTERNUTTER GROUND UNIT VENTILATOR 610 on 6885 NOOOH NOOOE VOLT Volt Appenes GALVANIZED AIGID STEEL HORSEPONER Heater Hertz HATT M**eatherproof** Without Water INTERRUPTING CURRENT Internediate metal tubing WE CONNECTED J8 on J-90X JUNCTICS BOX DELTA CONVECTED KILOVOLT Kilovolt **Anpere**s Kilovatt KVA. PHASE SWITCH INPUTS SWI-SWA 5 نے لے -RELAYS 17-32 JOS JOS \Box TRANSCEIVER BOARD -TO BE SHIPPED MOUNTED IN CABINET & PRE-WIRED SHERIDAN 129" 277 V WIRING COMPARTMENTS 0000 0000 >ಂದಿರ್ಭ MASTER SWITCH PANEL WIRE TO INPUTS SWI-SW8 PANEL LCP DETAIL NO SCALE Ω ທ 4 I B S APPROFRIATE LEVEL TO LIGHT IN ADDITION TO GRAPHIC PLAN CC III ທ 0 -4 AREA FIRST FLOOR 95 SECOND FLOOR THIRD FLOOR (ZONES 13-15) FOURTH FLOOR Ο Z () a FIFTH FLOOR MANUAL STATION ິ шZ 0 D SPRINKLER (J " SMOKE DETECTOR APPROPRIATE INITIATING DEVICE TO LIGHT INDICATING ALARM SOURCE FIRE ALARM ANNUNCIATOR PANEL NO SCALE • • • • • • • • •

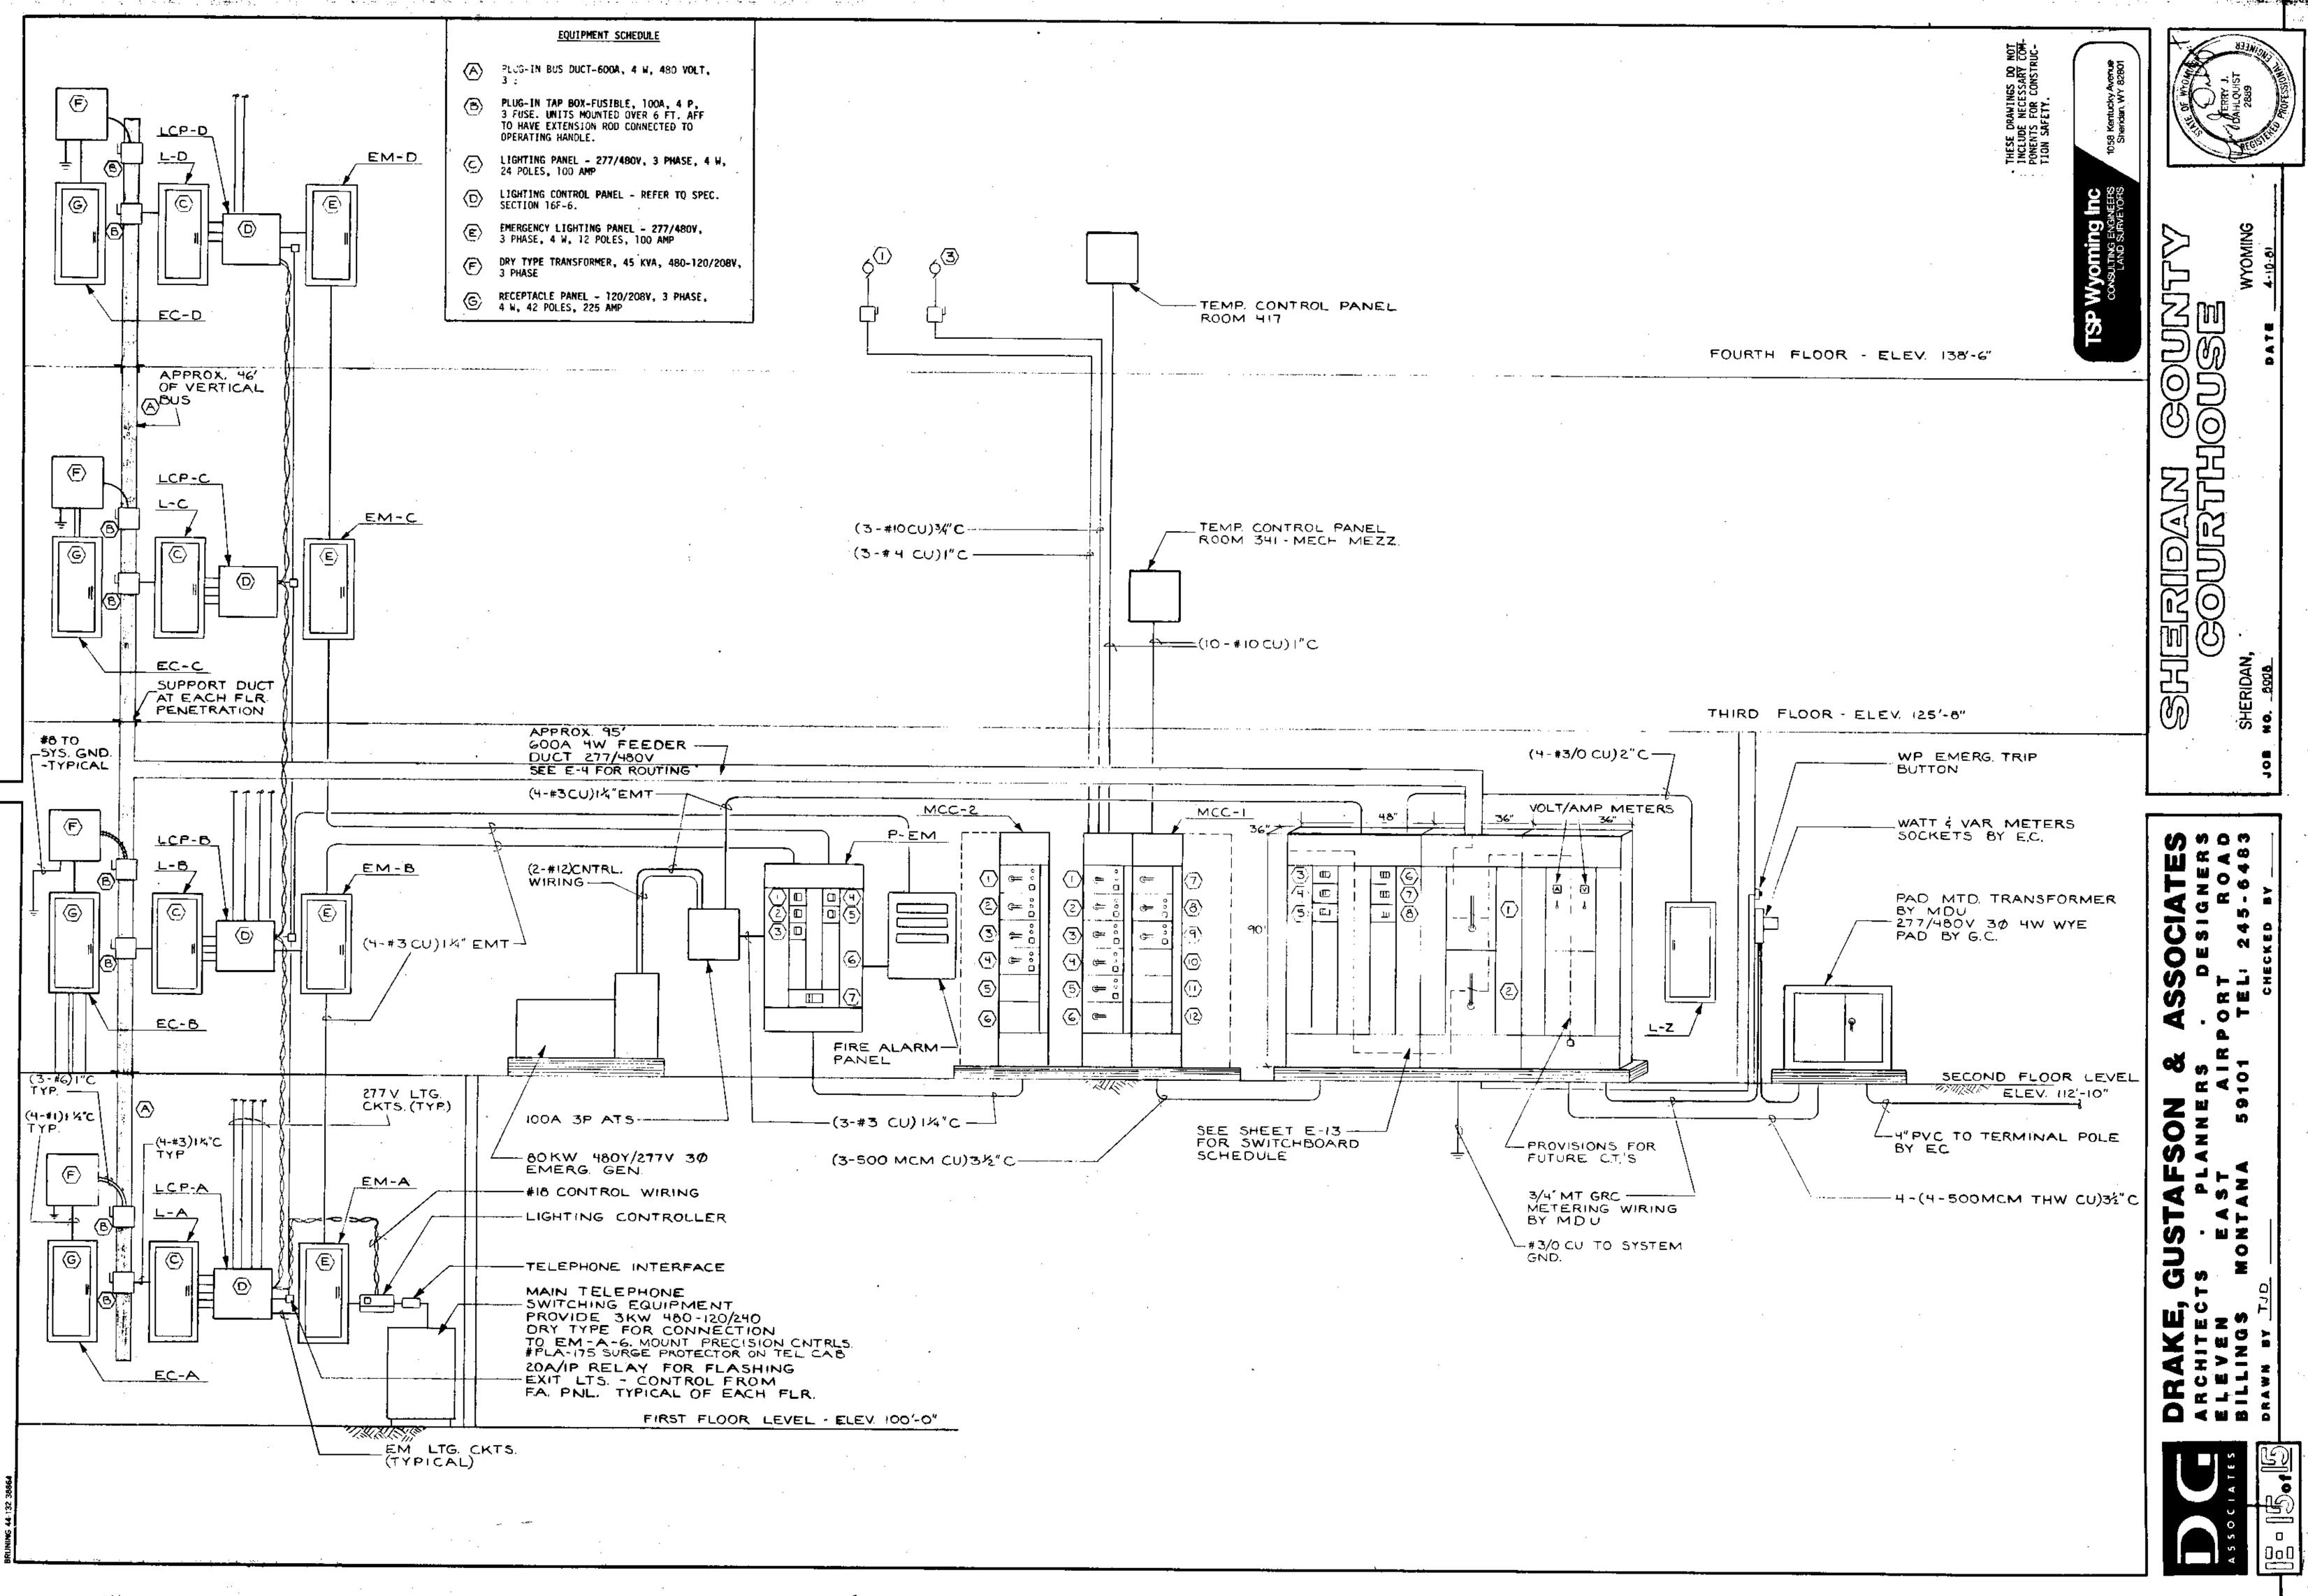

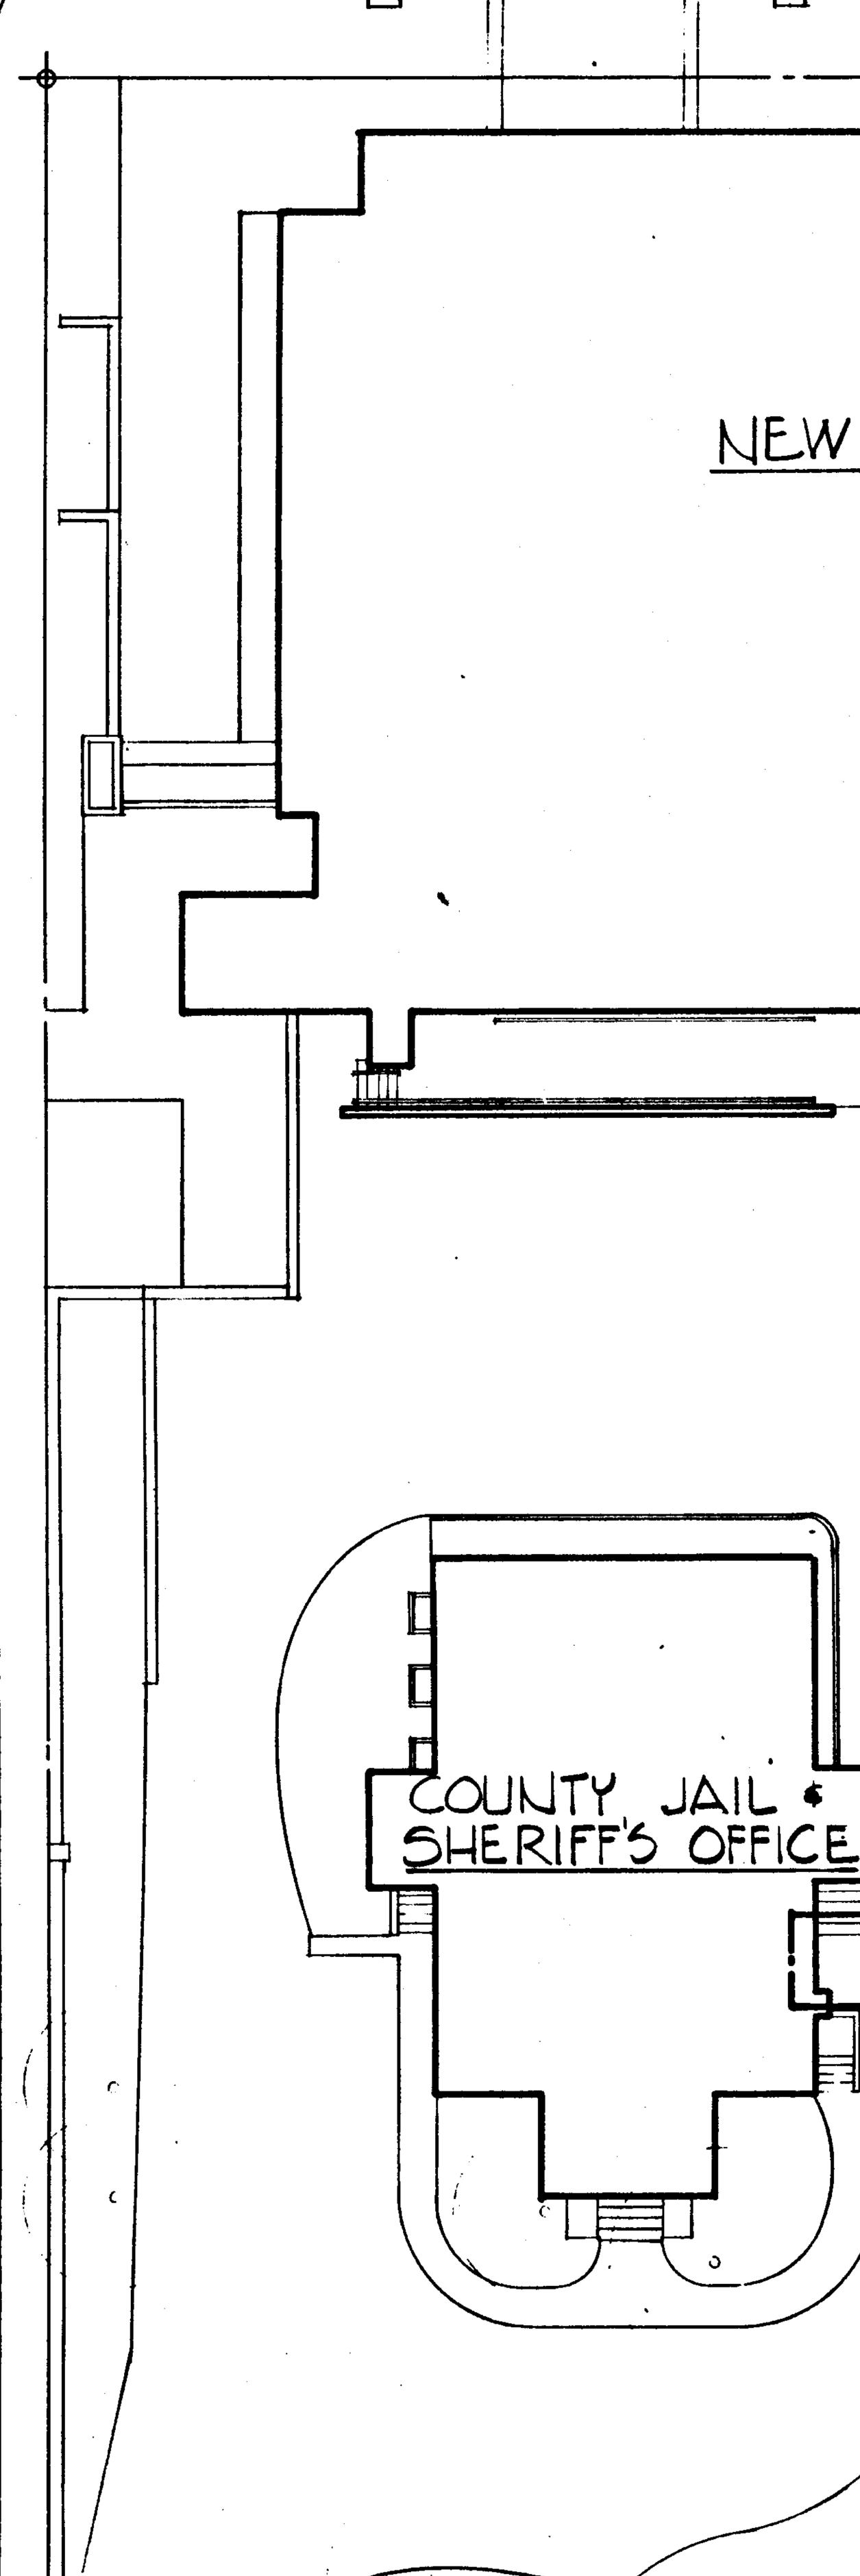



SITE PLAN

| 20 -

 
レーノ







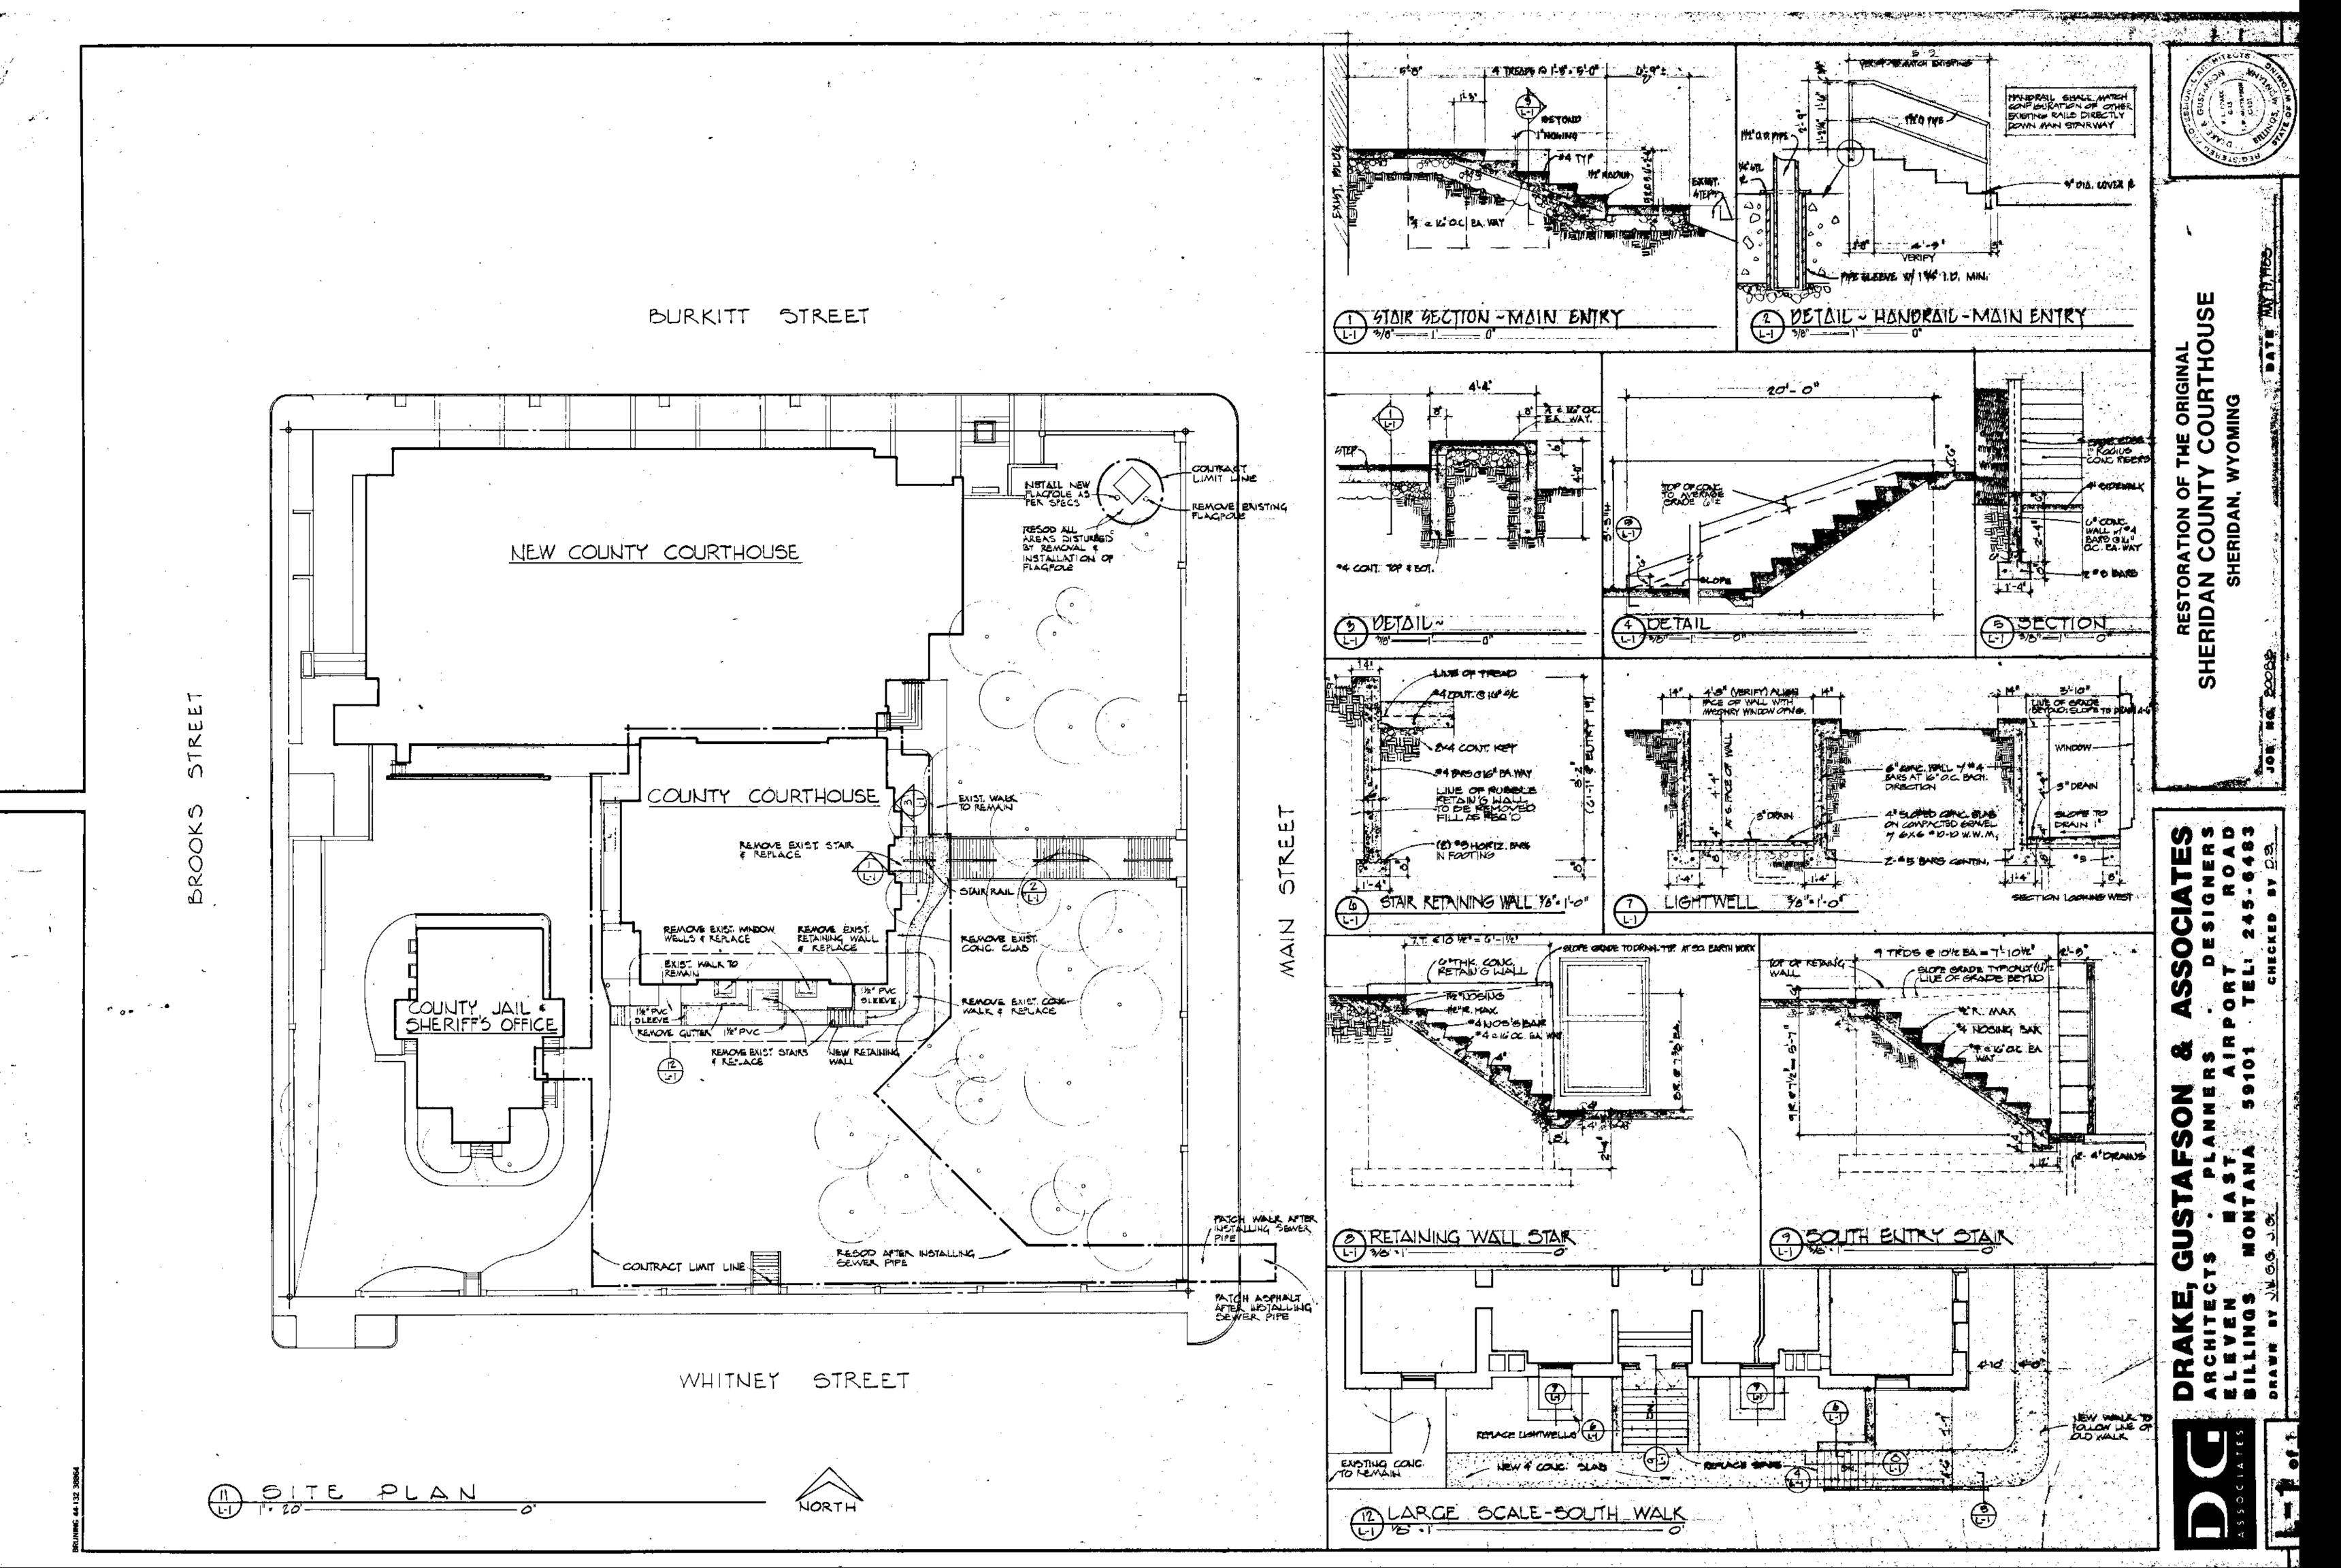




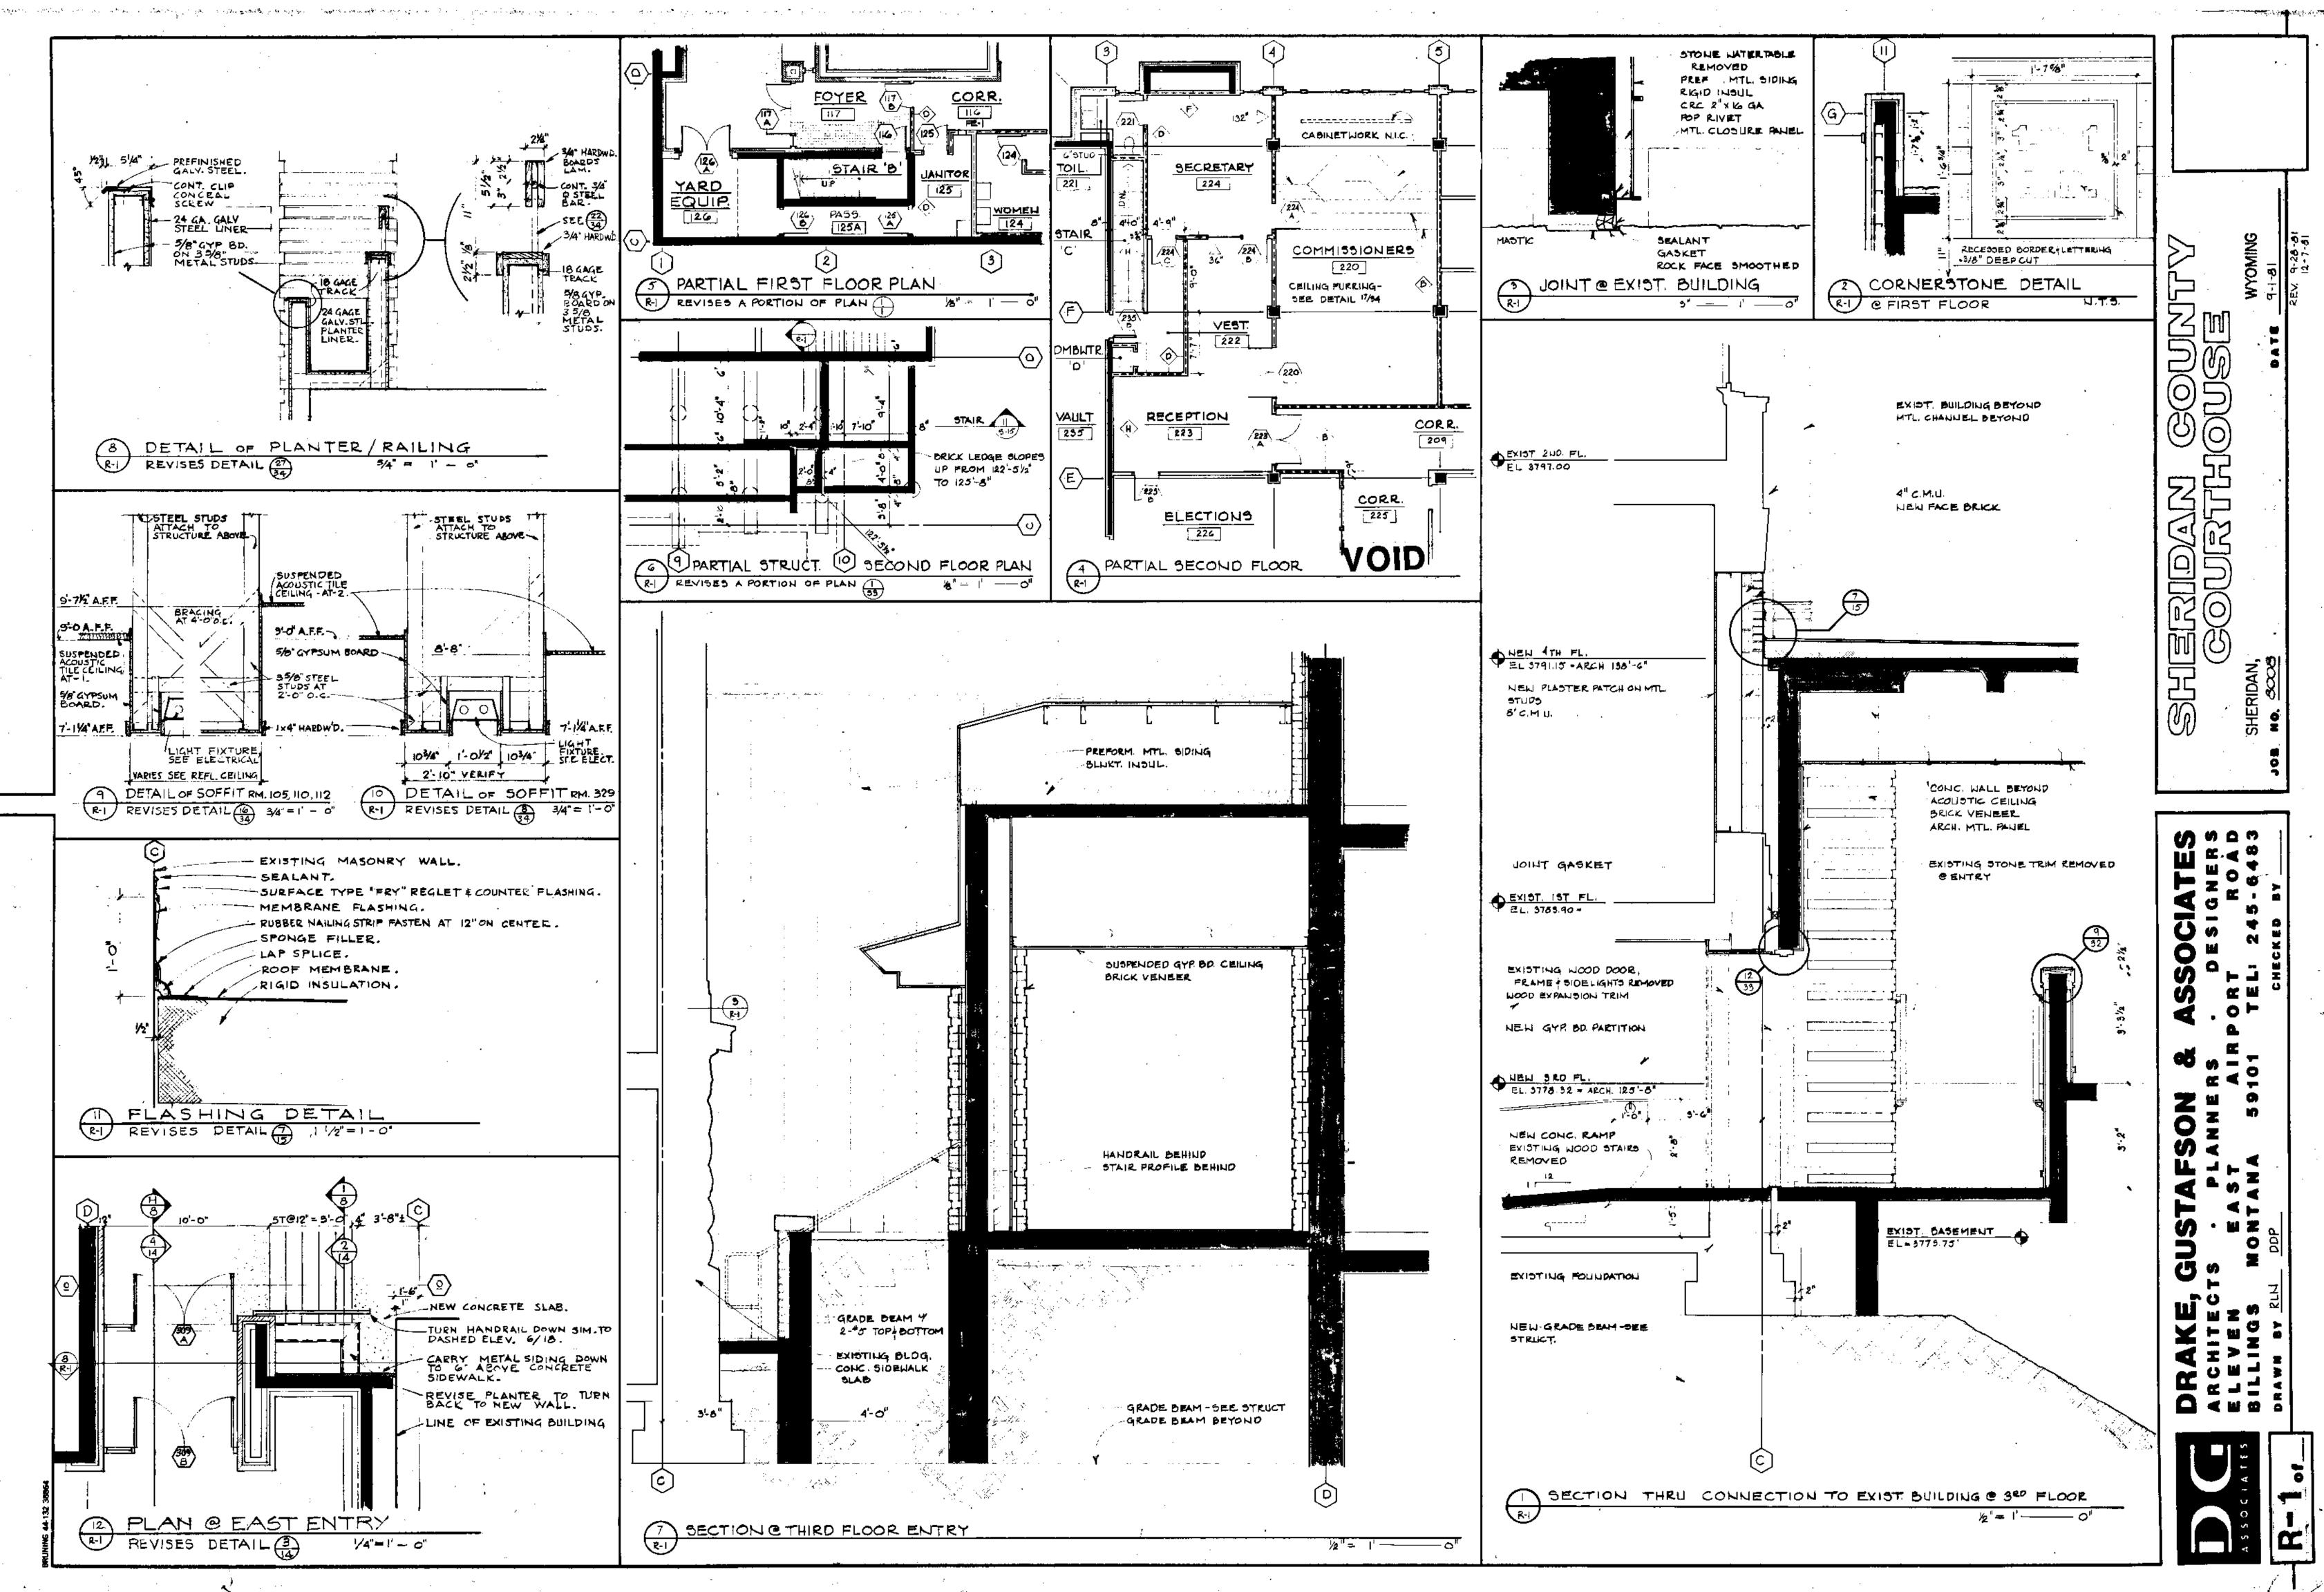


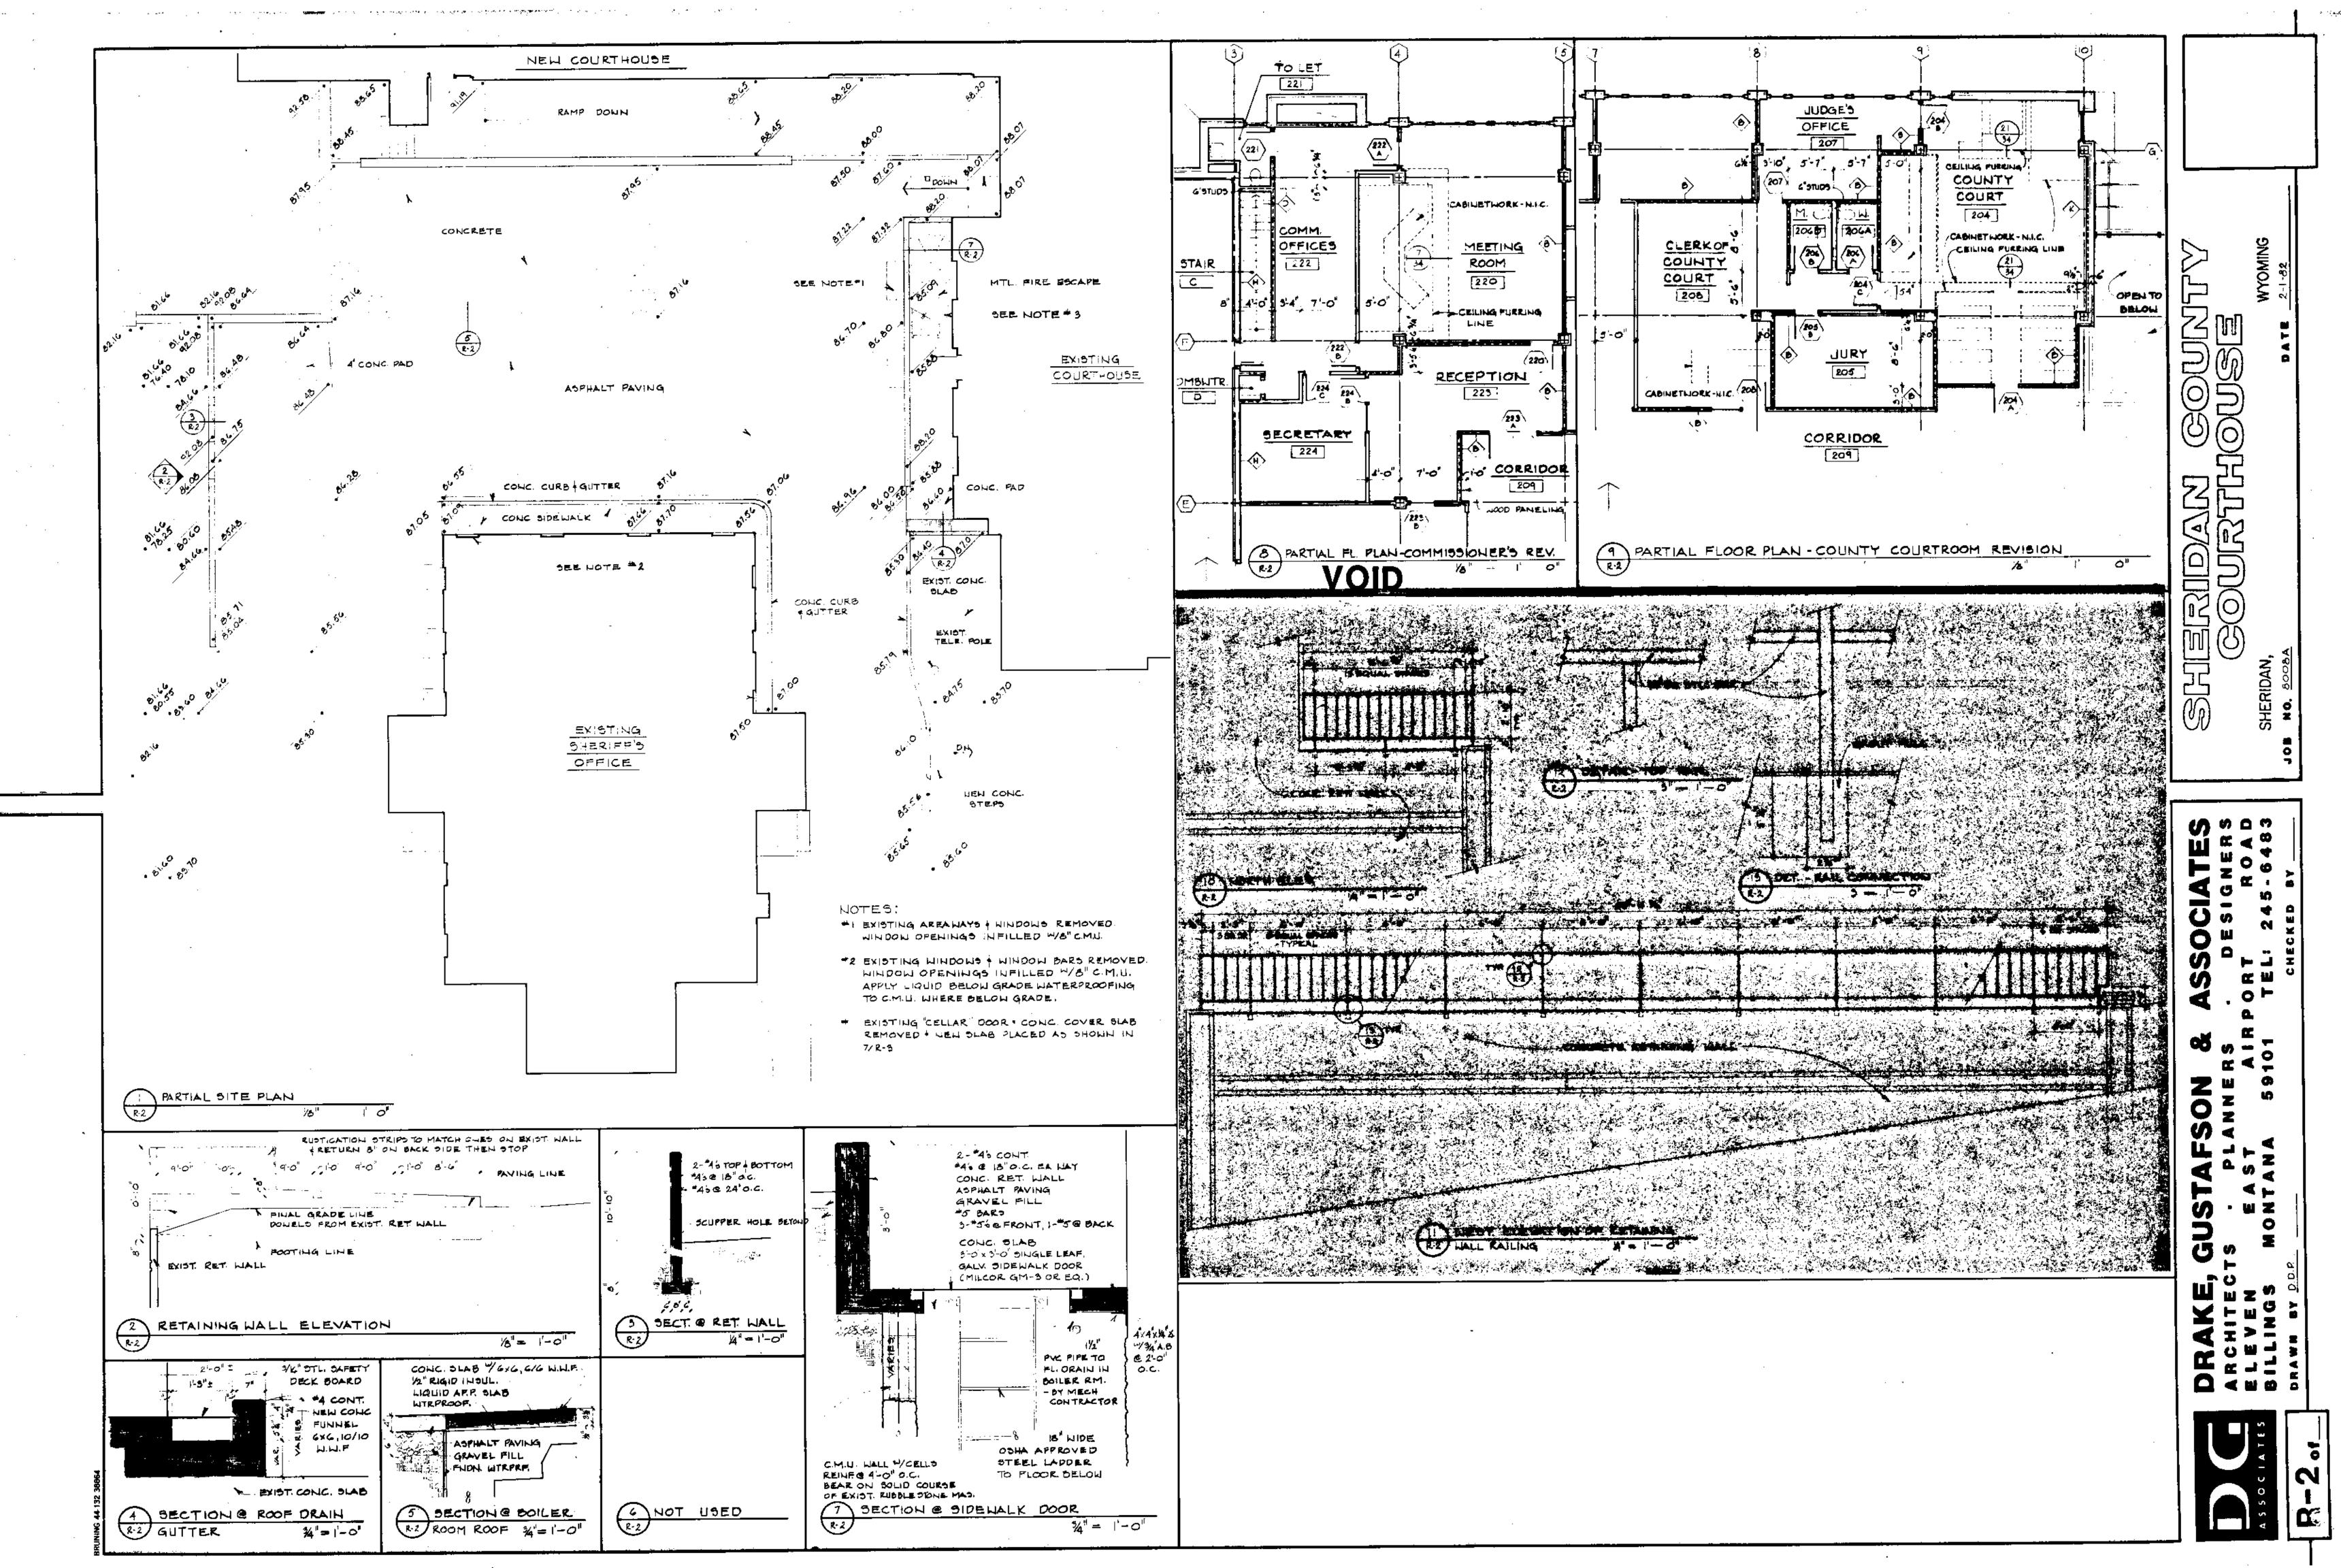

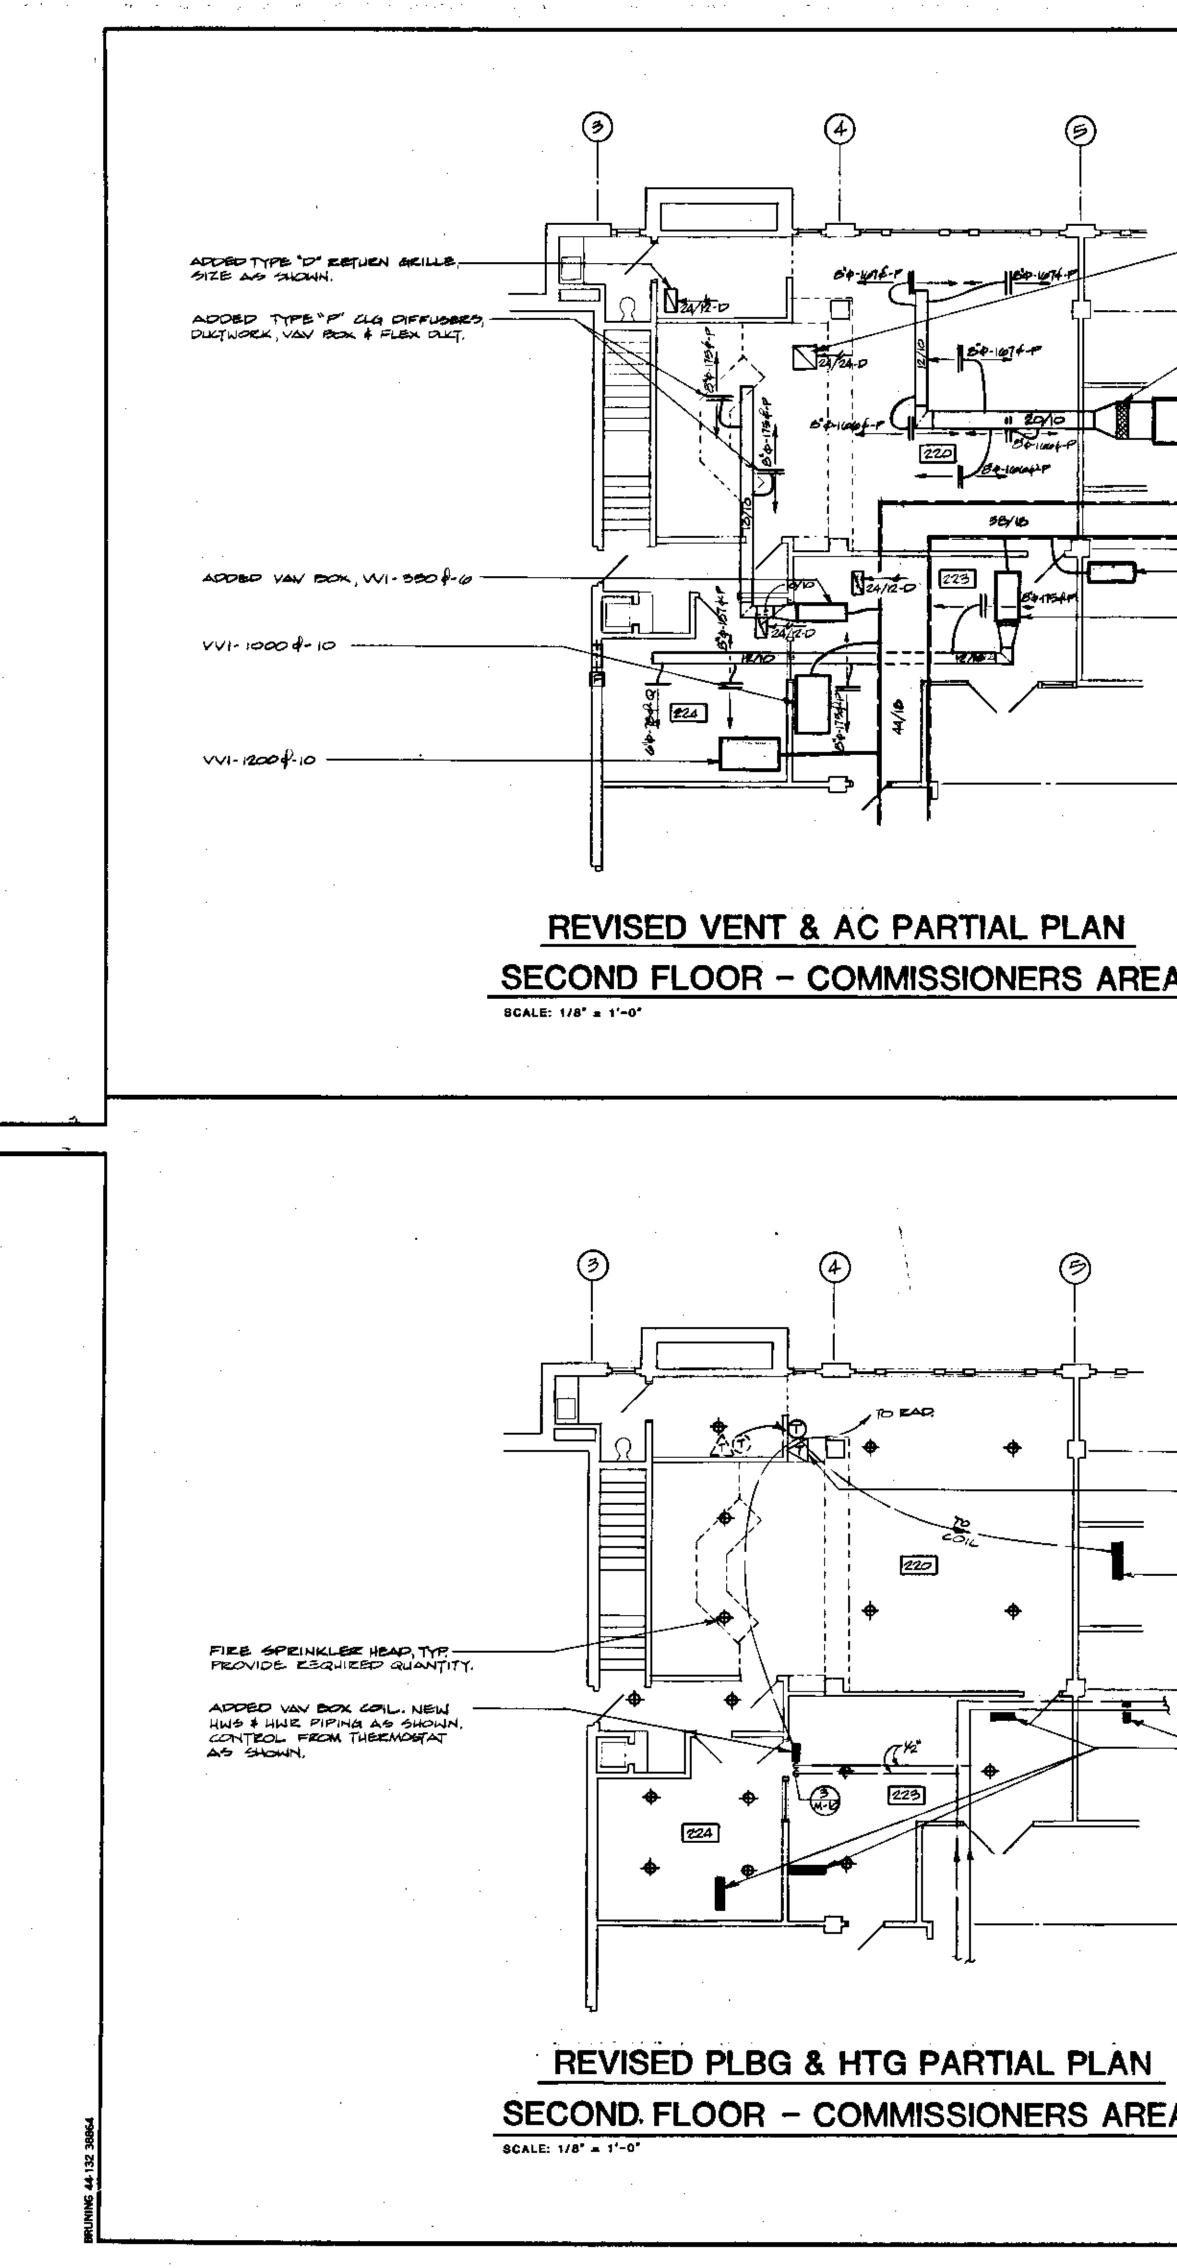

| · · · · · · · · · · · · · · · · · · · | | | · | | |
|---------------------------------------|------------------------------------|--|--|---------------------------------------|--------------------------------|
| | 1 | | | | |
| | | | _ | | ~ |
| | | eelocated type "d" return | |) | B |
| | | grille. | | | |
| - | | added type "f" register Gze ag shown. | | | + |
| REJURN GRI | MPE'0" E | | ╼╾╼╌╼╍╼┽ ╗ | | ╵ ╴╶╸╉ ┇ ╶┐┍╼┯═┯┯─┤ф |
| ख | | CONNECT (2) 12/7 EXH. FAN | | ·\ | |
| | ating coil | BOTTOM OF FAN, | | | ₫掌 ∏ |
| TYPE "R" | | APPED TYPE "B" BXH. REGISTER SIZE & CFM AS SHOWN (2-THUS) | | 1/10 | |
| FP1-1000-1/4 | · 8 | |] | | |
| | | VVI-1200\$-10 | | | |
| | | | | | |
| · | | ADDED VAN BOK, $VVI-3954-0$ | لي محمد مسجد | | |
| =) ∨∨I-450₽-0 | , | | | /14 BA-1472-P | |
| | Besie | ADDED VAV BOX, VVI- 925 ¢-K | ······································ | | |
| EX167, BOX. REGET TO 5 | Bóx TO BE BE LFM | FPI-2000-1/2(2)-14 | ••• | | |
| FROM ORIGIN | NAL 700 CFM. | | | | |
| | | heating coll type"r" | | 24/12.0 | 425 8 0 |
| | | added type "d" eetuen gell Size as shown | £ | • • • / | / |
|) | | ADDED TYPE "B" EXH. EEAIST SIZE & CFM AS SHOWN. | 2 . | | _/ |
| | | | | | |
| | | | | | |
| | | | | | - |
| | NOTES: | | | REVISED | VENT& |
| | 1. CULTWORK & BOR | DED. ADDED OZ ZELOKAJED | | SECOND FL | <u> 00r - 0</u> |
| 2 | LOEBN COOK-GA YAL H.P., 925 RPM | 2419 15 NOT SHADED. EMINI (0-10, 428 CFM, 125' 5.P., 1, 4.1 50NES, 120/00/1 OR | <u></u> | 8CALE: 1/8" = 1'-0" | |
| | EQUAL SUBMIT | SHOP DRAWINGS. ACCESSORIES IAL SPECIFICATIONS. CONTEOL ITCH W/ PILOT LIGHT. | | | |
| - 1 | NOTES: | | | | - |
| | CONTRACTOR TO | os ghown are relocated. Proute Piping ag | | | |
| | NECESSARY. | | | | |
| | | | | | |
| , | | | (T) | ť | B |
| | | | | · · · · · · · · · · · · · · · · · · · | Ť |
| | | | | | |
| | · | • | | | |
| | | | ╶╺╍╼╼╼╼╼╶╝╧╌╸ ╎╎ | | |
| 1. | | EXIST. 1/2 VENT | | | 1 (1 ¹⁴ 20 |
| Thezmostati | TIMER 4 AS SHOWN. | Relocated <u>P4</u> Hater Close | ۲ 4 (۲) | | □ |
| THERMOSTAT TWO VAV BOX | TO CONTROL | <u>F27</u> LOW. NEW 21/2° VENT. | | \vdash | |
| in paralle | ь. Рівох Соіь, | ADDED 4" WASTE IN FIRST FL CLG. SPACE, CONNECT TO 4" | æ/ | | |
| | | Waste Stack at Column as Shown. | · | | |
| | | OBIGINAL VOV BOX COLL | | | 2% |
|) | | ADDED VAN BOX COLL NEW HWR PIPING AS SHOWN, | HWS \$ | 3/6 208 | |
| | | OEIGINAL HUG\$ HWE MAINS - | | | |
| OF IGINAL VO | N BOX COLS | NEW 21/2 V UP. INCREASE VE | NT | | Fat |
| | | BIZE TO CONNECTION POINT ON 3 ED FLOOR, | l | | |
| | | ariginal fr box coil | | | |
| | | eelocateo thermostat a Shown. | > | | ╵╲ <u>╷╙──</u> ┤──── ╱┨ |
| | | original him the mains - | | | |
| | | | | | |
| | | | | | |
| | | | | | |
| - | | | | REVISED P | RG & L |
| HLENON | | | | | |
| 2 | | | | SECOND FL | <u>-00R -</u> |
| | | | | 8CALE: 1/8" - 1'-0" | |
| | | | | | |
| | 4 | | | | |

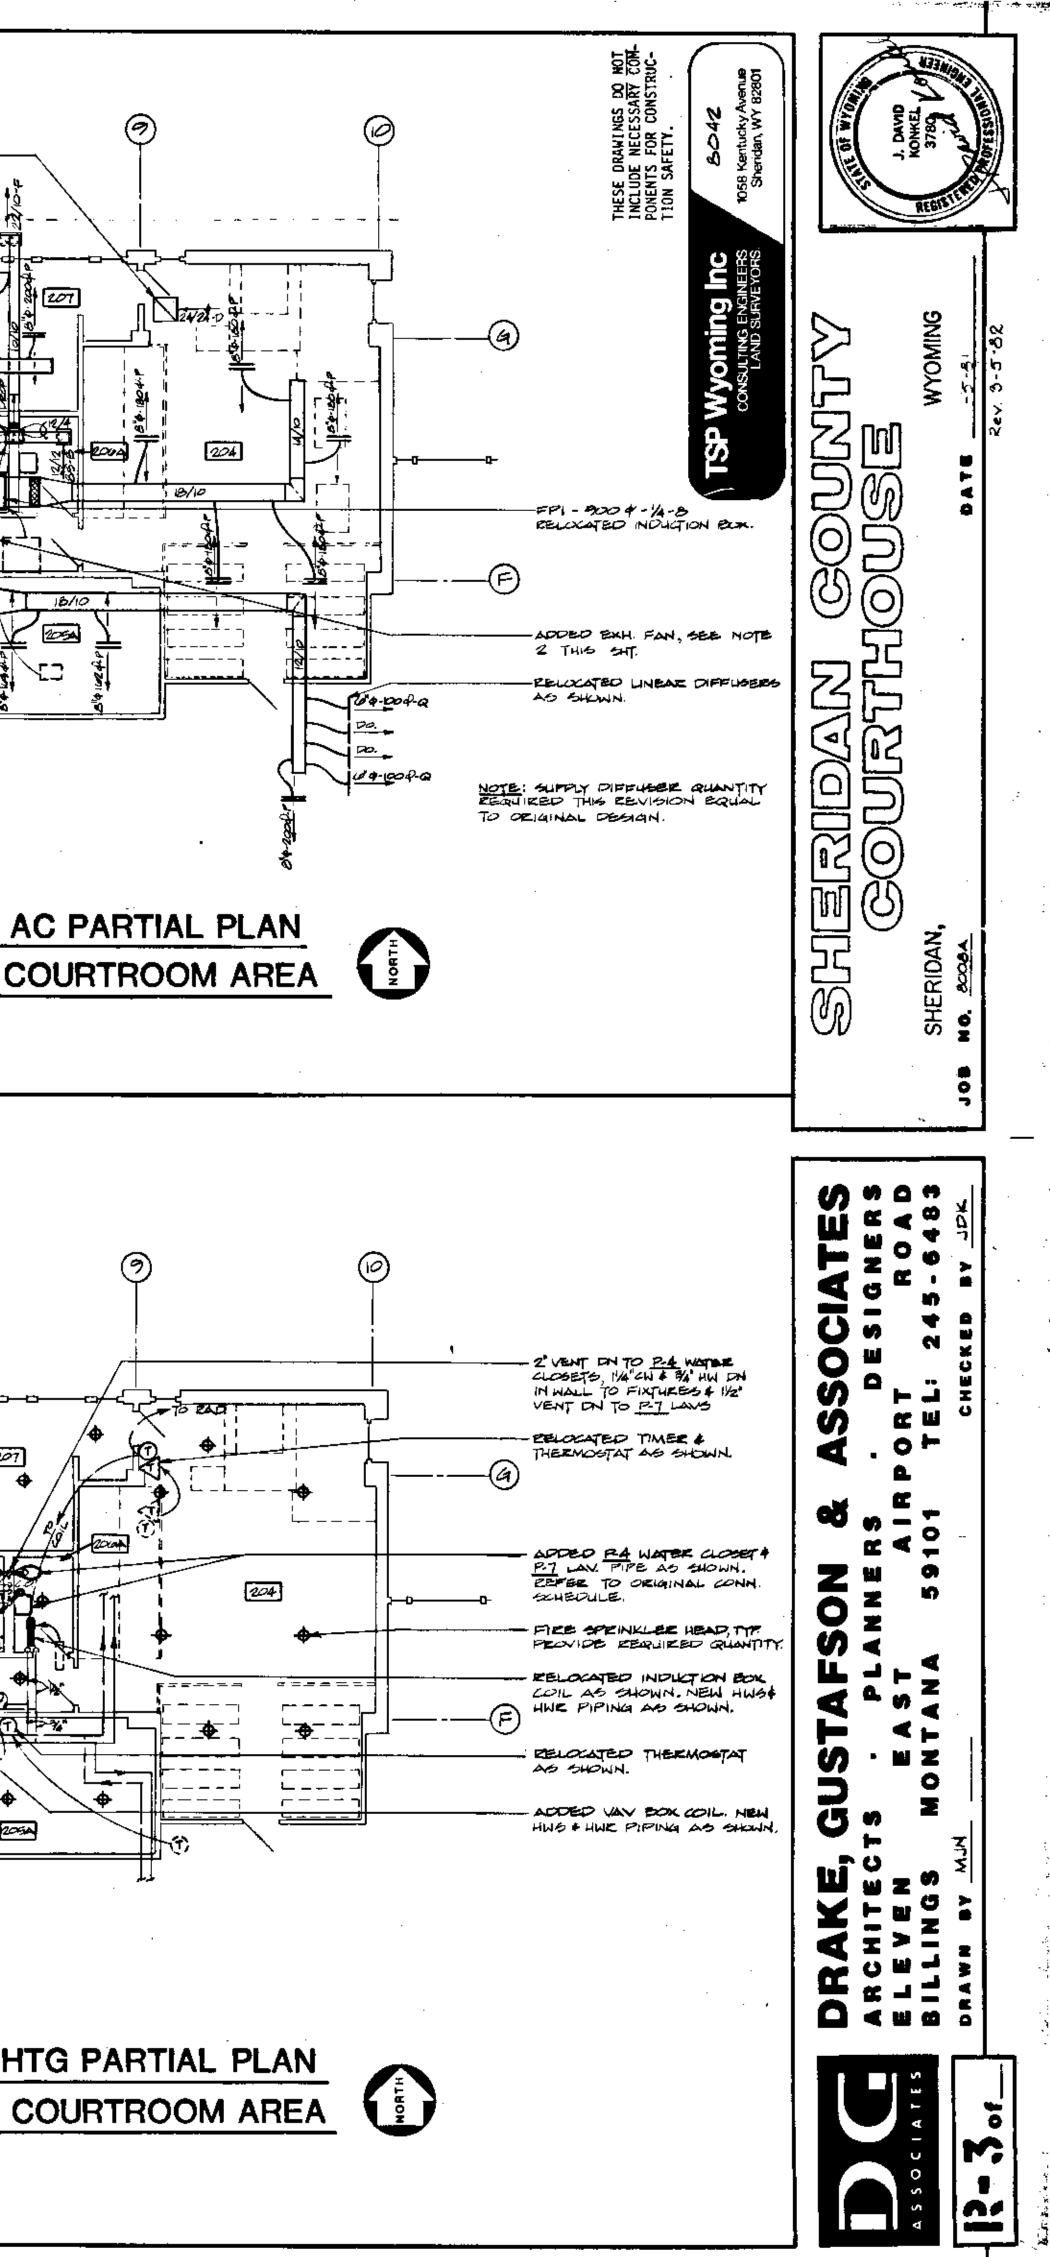


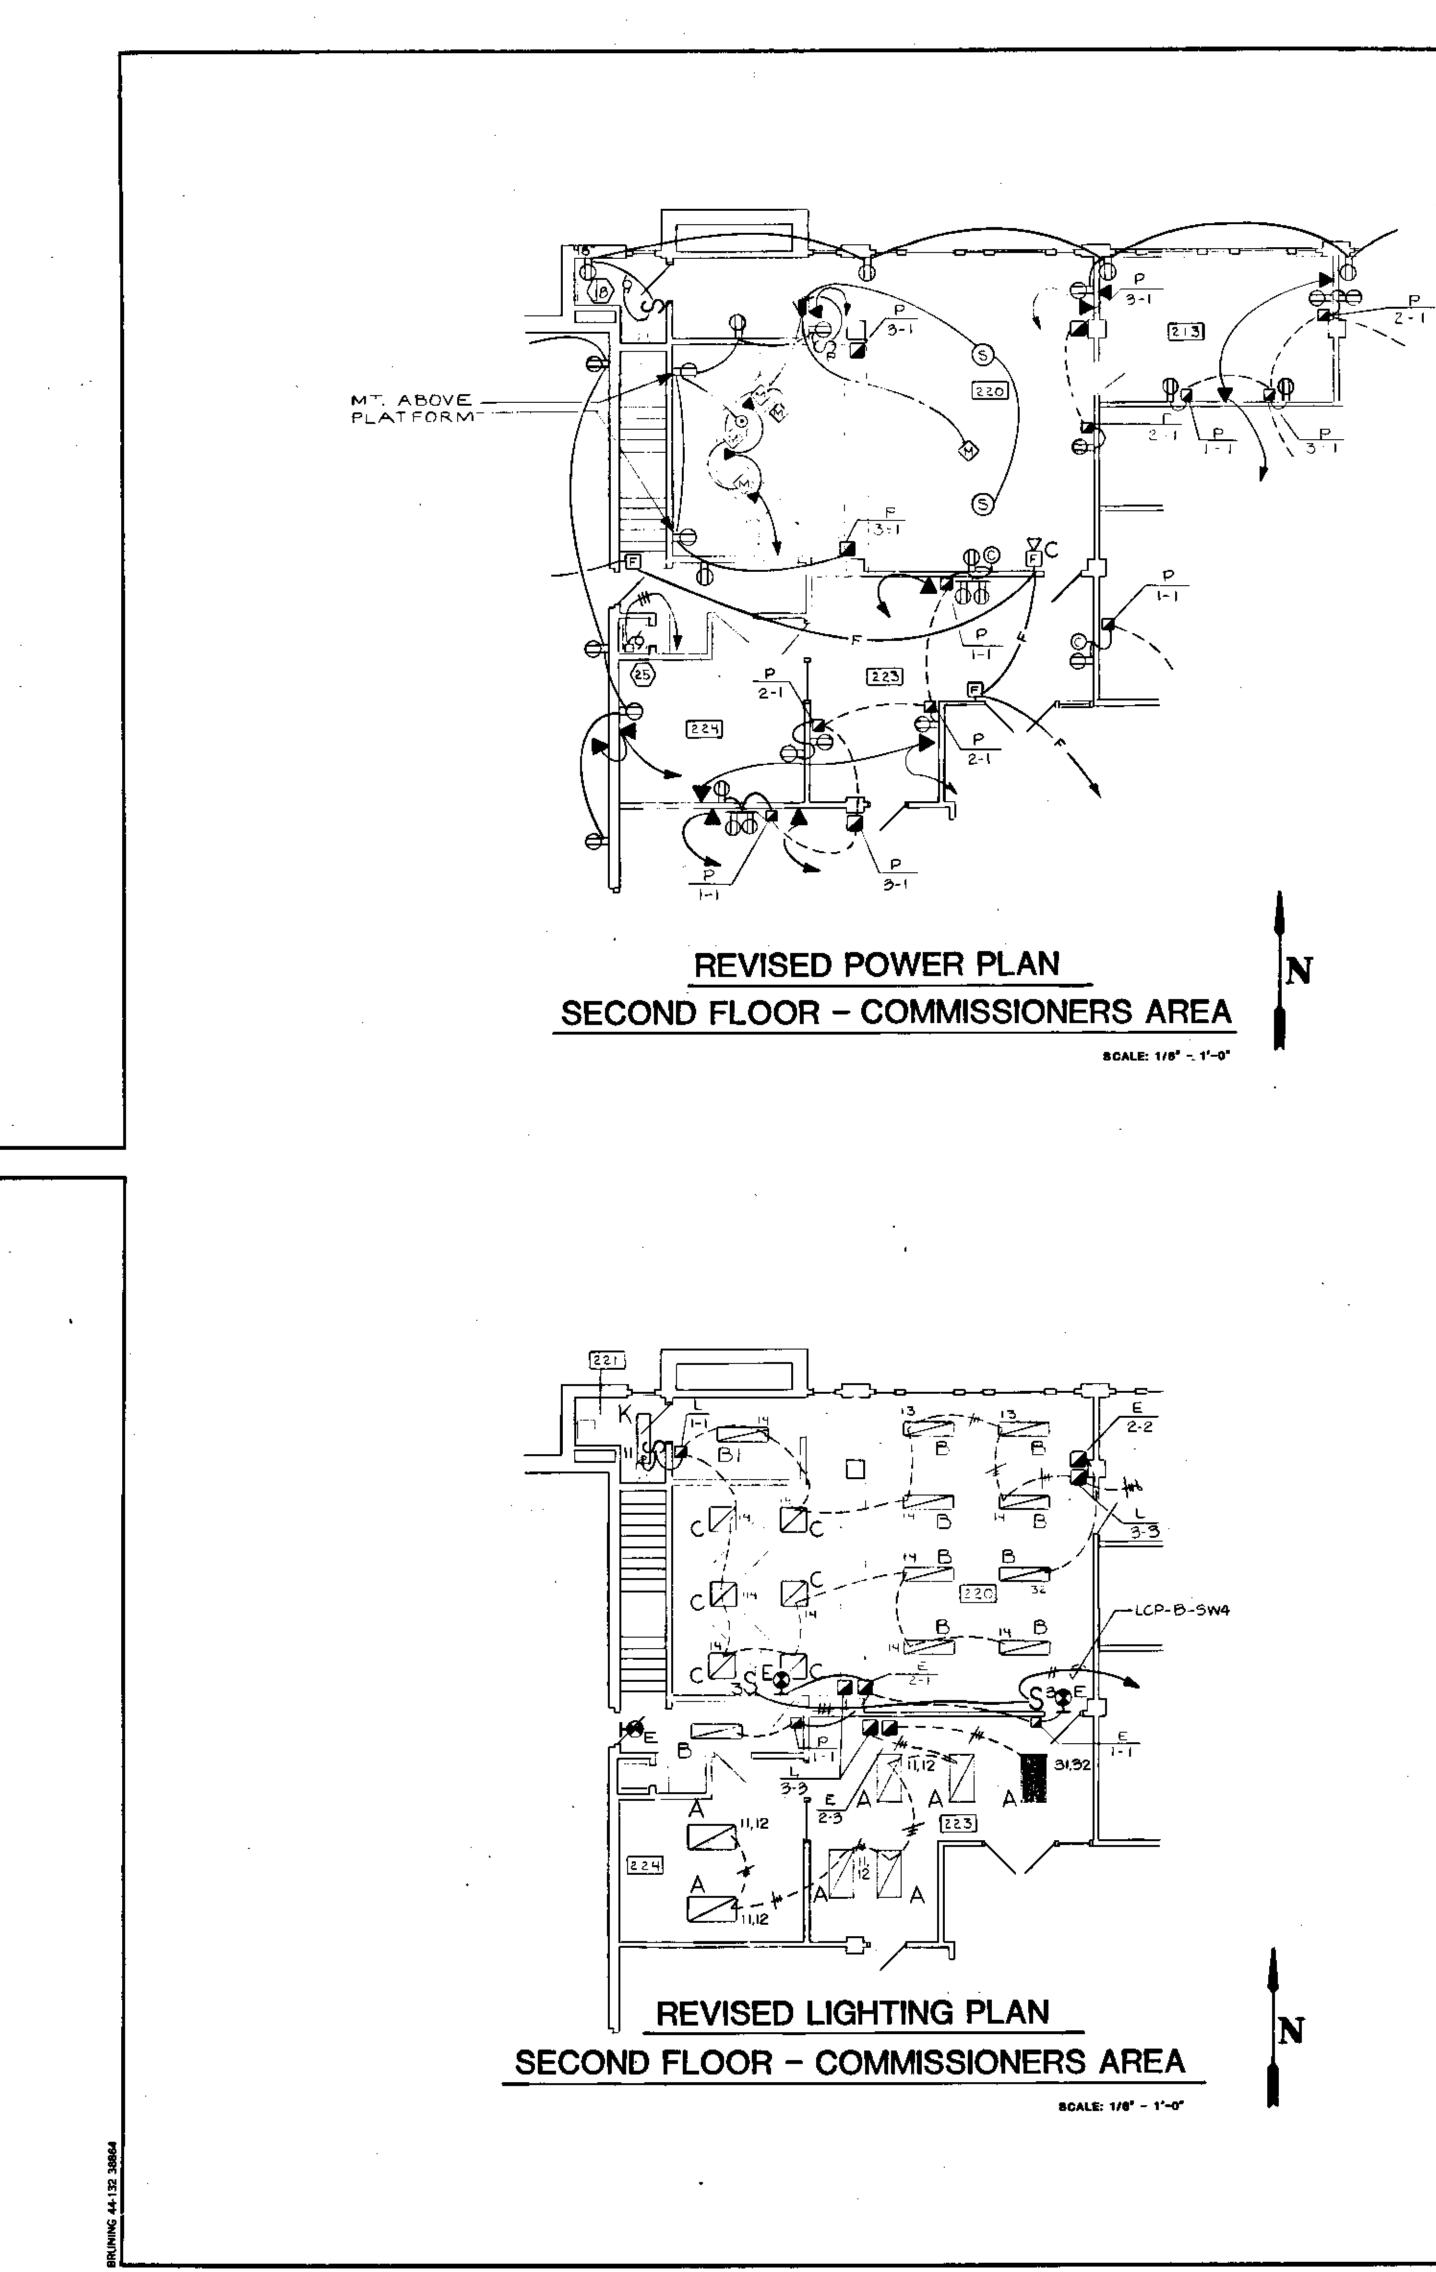


2-1

LCP-B-9W2-120/277V REL ABOVE CLG LCP-B-SW4

REVISED LIGHTING PLAN SECOND FLOOR - COURTROOM AREA

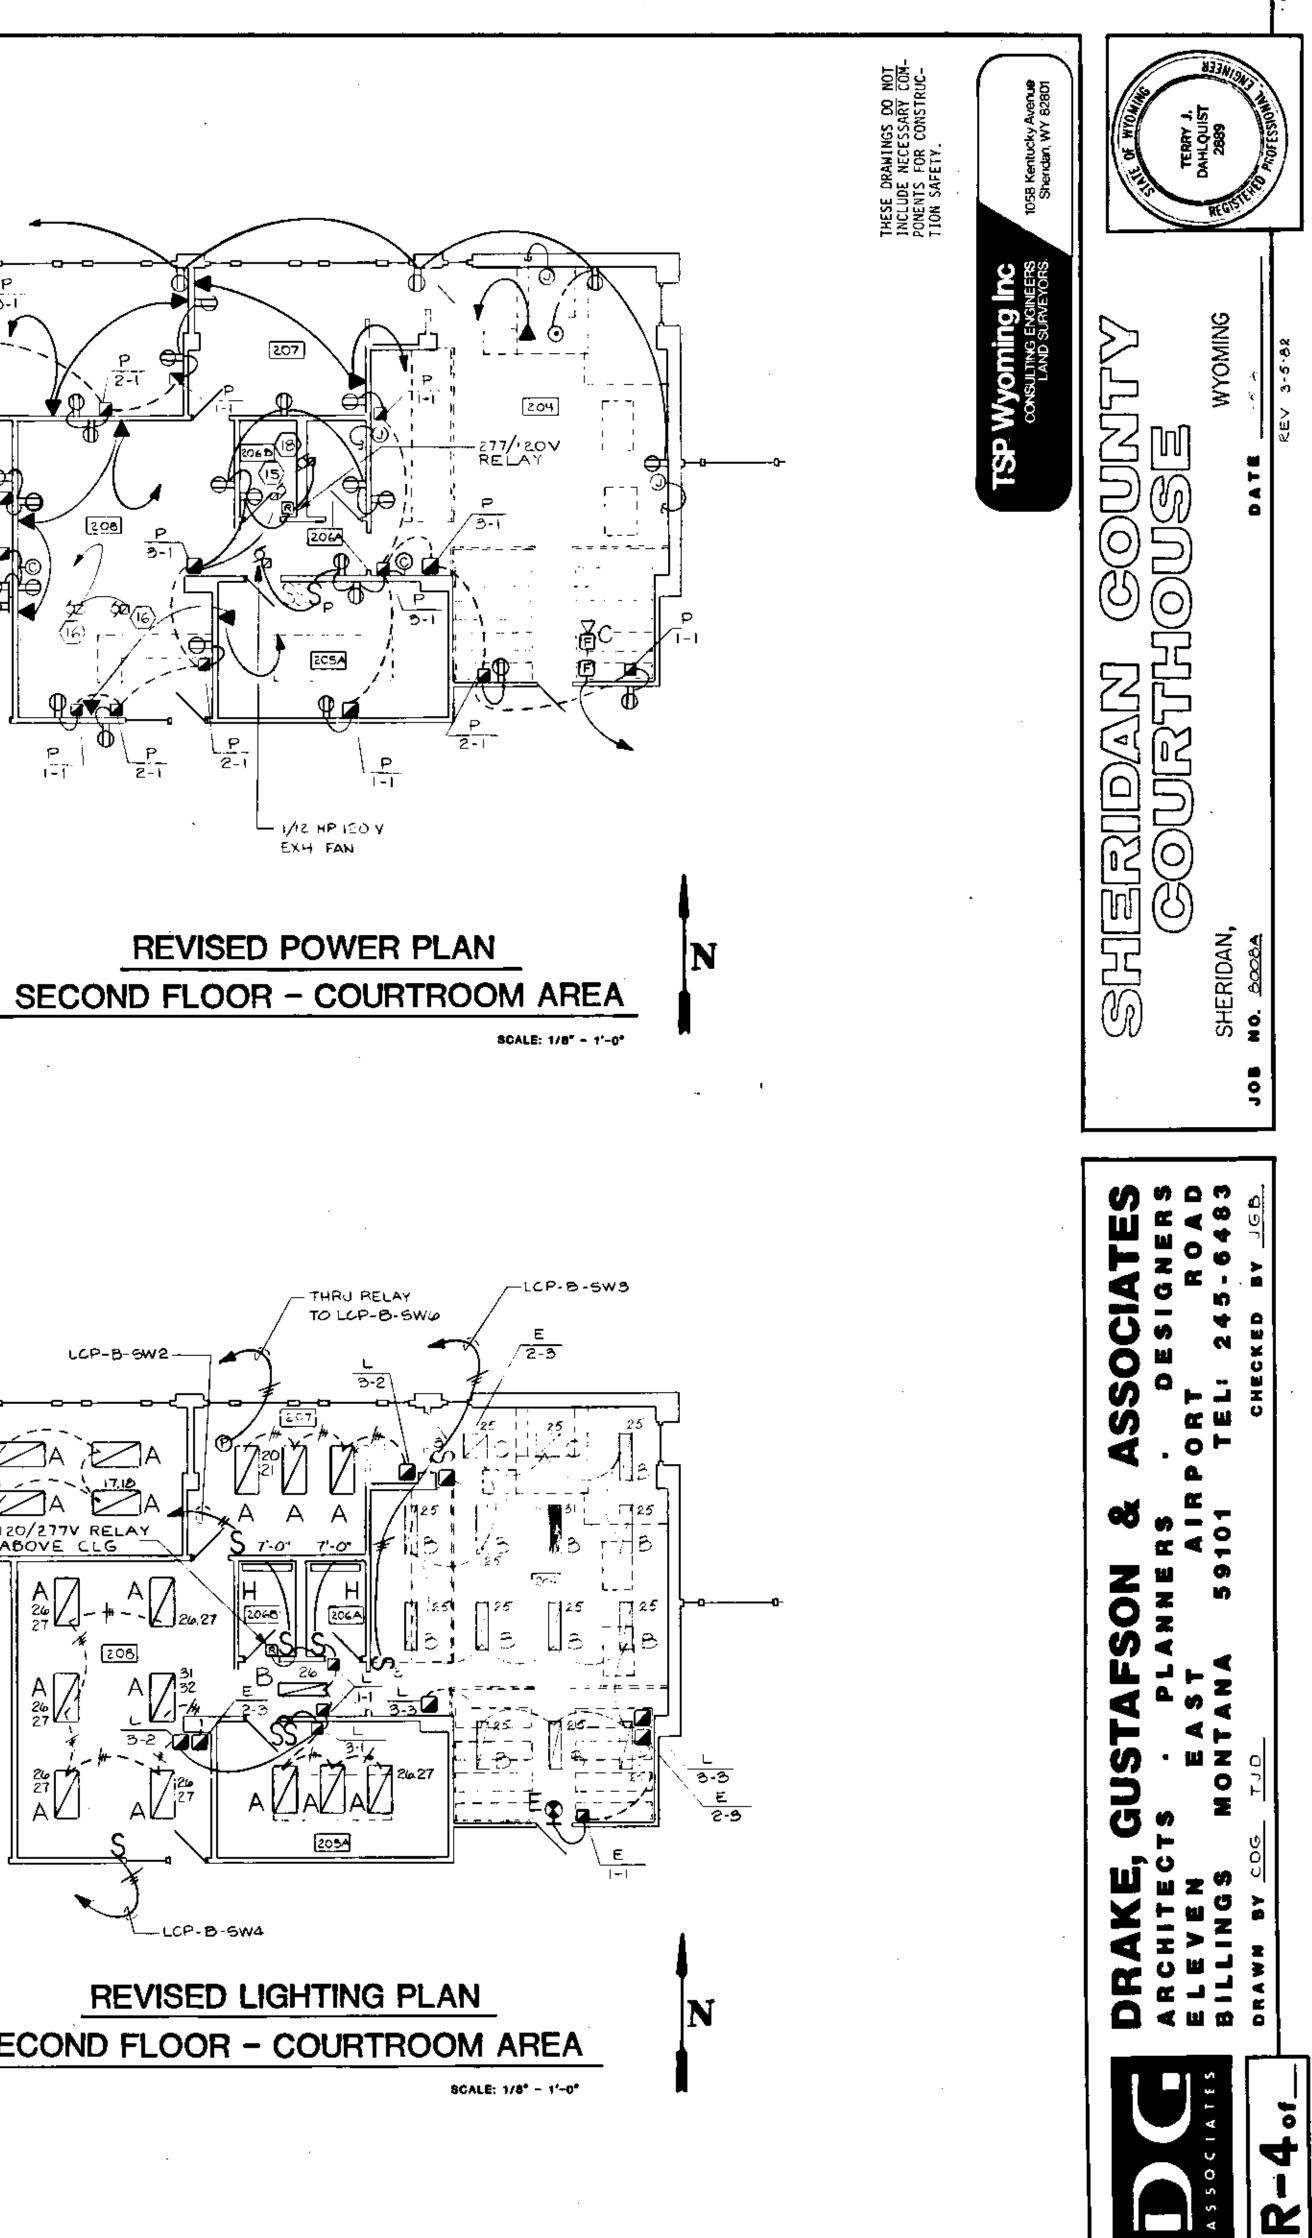

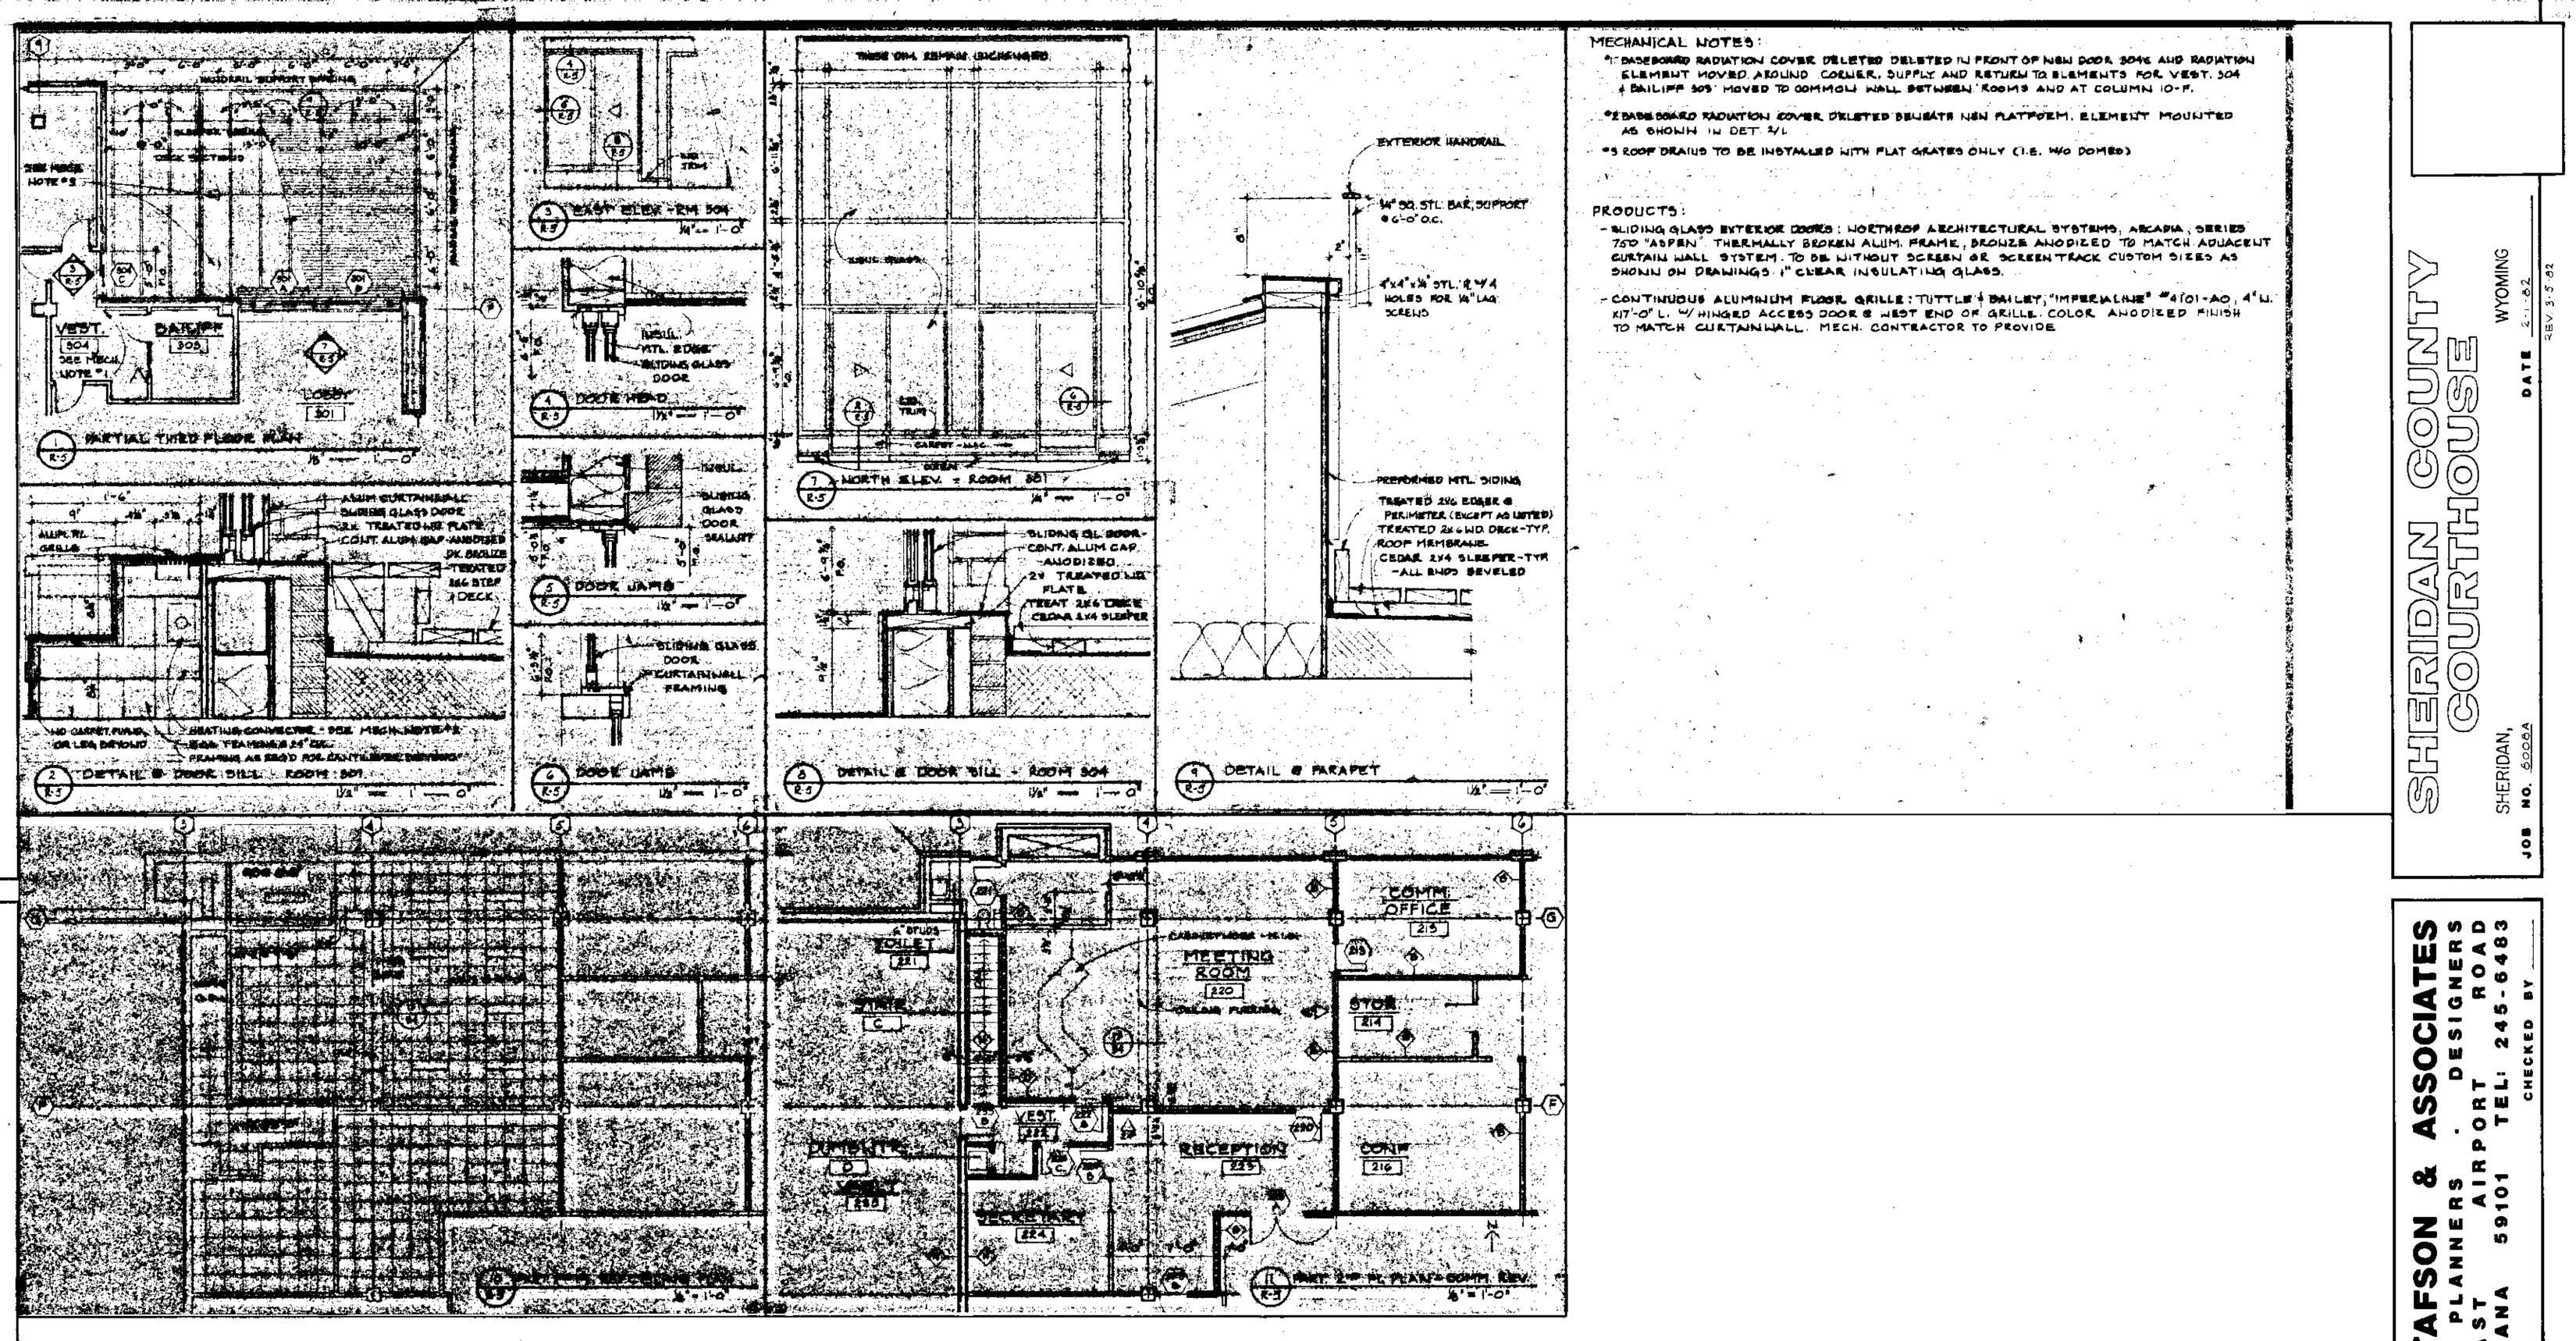

化乙酰基乙基化乙基乙基乙基化乙基化氨基乙基化乙基化乙基 法法法法 化乙基乙基